

8-10-01
LARRY TUCK 10AM
8-15-01 10AM
LARRY TUCK

8/17/01
ASAP Final
8/23/01 - Anytime

05-433371

ISSUE DATE: 8-9-2001

PERMIT

P 515080

APPROVAL DATE: 8/24/01

A 47961

INDEXED

ON-SITE SEWAGE DISPOSAL SYSTEM HOWARD COUNTY HEALTH DEPARTMENT BUREAU OF ENVIRONMENTAL HEALTH

Larry Tuck IS PERMITTED TO INSTALL ☒ ALTER ☐

ADDRESS: 936 Parkey Road, Gambrills PHONE NUMBER: 410-551-8579

SUBDIVISION: Malcolm Property LOT NUMBER: 11

ADDRESS: 11930 Queen Street PROPERTY OWNER: Joseph Lucado

SEPTIC TANK CAPACITY (GALLONS): 1250 (TOPSEAM)

PUMP CHAMBER CAPACITY (GALLONS): N/A

NUMBER OF BEDROOMS: 4

SQUARE FEET PER BEDROOM: 180

LINEAR FEET OF TRENCH REQUIRED: 240

TRENCHES:	Trench to be 3.0 feet wide. Inlet 2.5 feet below original grade. Bottom maximum depth 4.5 feet below original grade. Effective area begins at 2.5 feet below original grade. 2.0 feet of stone below distribution pipe.
LOCATION:	Starting from the lot corner closest to the house, place the distribution box 135' down the 487.30' lot line and 165' off this same lot line. Run (4) trenches on contour in both directions as shown on plan.
NOTES:	

PLANS APPROVED: MER ON SRU 6/13/01 DATE: 6/7/01

- NOTE: PERMIT VOID AFTER 2 YEARS
- NOTE: CONTRACTOR RESPONSIBLE FOR SCHEDULING A PRE-CONSTRUCTION INSPECTION FOR ALL INSTALLATIONS
- NOTE: WATERTIGHT SEPTIC TANKS REQUIRED
- NOTE: ALL PARTS OF SEPTIC SYSTEM SHALL BE 100 FEET FROM ANY WATER WELL
- NOTE: MANHOLE RISERS REQUIRED ON ALL SEPTIC TANKS AND PUMP CHAMBERS


NEITHER THE HOWARD COUNTY COUNCIL NOR THE HEALTH DEPARTMENT IS
RESPONSIBLE FOR THE SUCCESSFUL OPERATION OF ANY SYSTEM
BUILDING PERMITS SIGNED
PERMITTEE RESPONSIBLE FOR OBTAINING FINAL APPROVAL ON THIS PERMIT
AND RETURNED ALL 410-313-2640 FOR INSPECTION OF SEPTIC SYSTEM

8-28-03 800 143 847-IG POD L

P515080

NOT TO SCALE

INDEXED

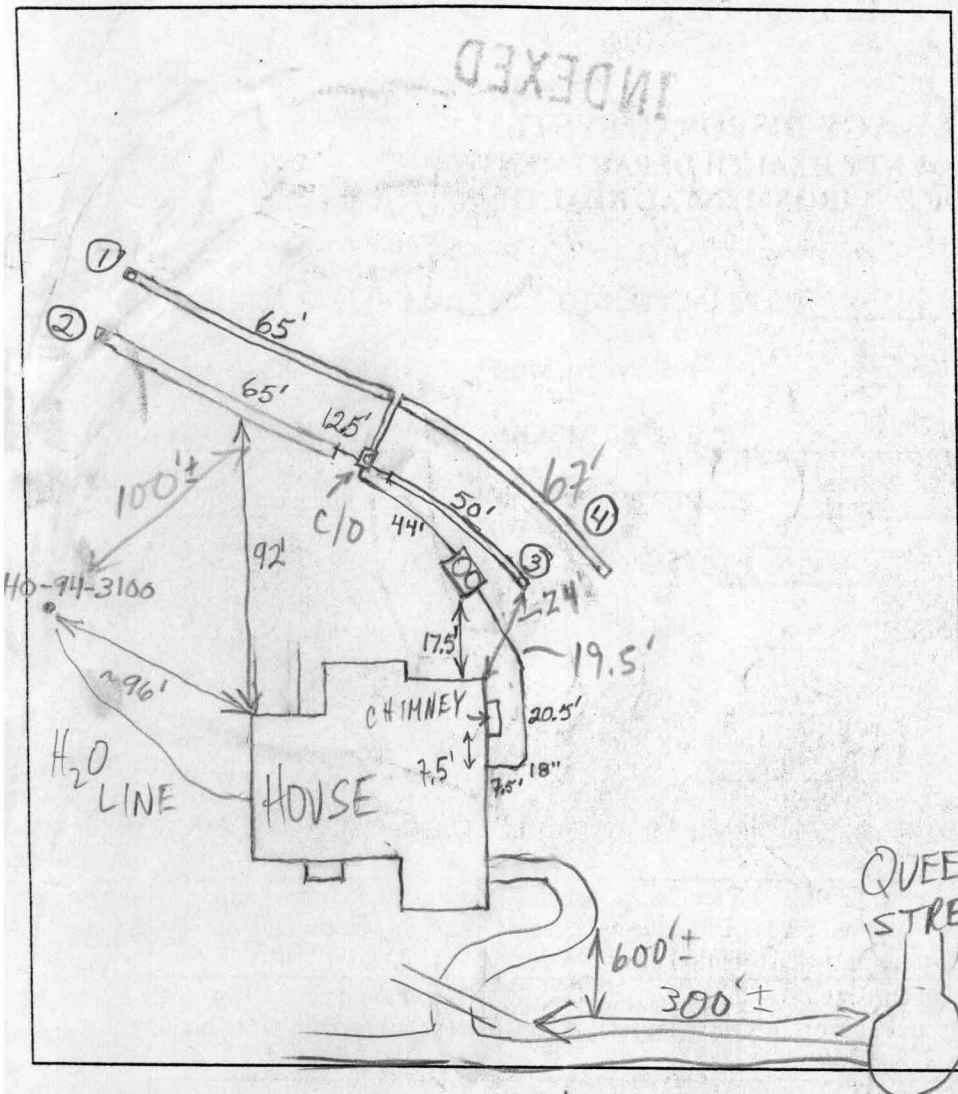

TRENCH DATA

TRENCH WIDTH 3'
TRENCH INLET DEPTH 2.5'
TRENCH BOTTOM DEPTH 4.5'
DEPTH OF STONE 2'
NUMBER OF TRENCHES 4
TOTAL TRENCH LENGTH 247
ABSORBENT AREA 741
DISTRIBUTION BOX LEVEL Yes
BAFFLE IN DISTRIBUTION BOX No - O.K.

SEPTIC TANK DATA

SEPTIC TANK 1500 ^{2-Compartment} GALLONS
MANHOLE RISER Yes - 2
6 INCH INSPECTION PORT No

PUMP CHAMBER DATA N/A

PUMP CHAMBER GALLONS _____
MANHOLE RISER _____
ALARM _____
PUMP PERFORMANCE TEST _____

PRE-CONSTRUCTION INSPECTION: 8/13/01 Easement staked. To install as per B.P. plan. (BB)

INSPECTION COMMENTS: 8/13/01 No house connection. Trenches 1+2 are done. Trench 3 50% done. Cleanout on distribution box and at ends of trenches. O.K. to cover everything except start and end of trench 3 and 4. Installer asked if he could leave baffle out of distribution box so that he could clean lines easier - told him O.K. (BB)

8/14/01 OK TO COVER TRENCHES, HOLD FOR HOUSE CONN. (MR)

8/24/01 HOUSE CONN OK (MR)

INSPECTOR M. Rifkin

DATE SYSTEM APPROVED 8/24/01

WPI AFTER-THE-FACT = 2-PC CAP REQ'D; GROUT NOT OBS'D; WELL LINE

2 1/2' - 4' B.G.; OK UPON NOTIFICATION OF 2-PC CAP INSTALLATION & WPI FORM (MR)

PI BP: 410-789-2711 4/09/27 - 5704