

1/24/01 Layout  
ASAP  
4/25/01 - Final 11am

**PERMIT**  
**SEWAGE DISPOSAL SYSTEM**  
HOWARD COUNTY HEALTH DEPARTMENT  
BUREAU OF ENVIRONMENTAL HEALTH  
410-313-2640

05-433341

P 514 982-B

A 47964

ISSUE DATE 3/15/2001

APPROVAL DATE 4/25/01

INDEXED

\_\_\_\_\_Jack Fyock Septic Service\_\_\_\_\_ IS PERMITTED TO INSTALL X ALTER \_\_\_\_\_  
ADDRESS P.O. Box 89, Glenelg, MD 21737 PHONE 410-988-9270  
SUBDIVISION Malcolm Property LOT NUMBER 7 ADDRESS 11962 Queen Street  
PROPERTY OWNER Mark Schwartz PROPERTY OWNER'S ADDRESS 609 Hollywood Avenue  
SEPTIC TANK CAPACITY 1250 GALLONS \* WATERTIGHT SEPTIC TANK REQUIRED \* 20904  
PUMP CHAMBER CAPACITY \_\_\_\_\_ GALLONS  
NUMBER OF BEDROOMS 4  
SQUARE FEET PER BEDROOM 210  
LINEAR FEET OF TRENCH REQUIRED 280

TRENCHES: Trenches to be 3 feet wide. Inlet, 4 feet below original grade. Bottom maximum depth  
6 feet below original grade. 2 feet of stone below distribution ~~box~~ pipe.  
LOCATION: Beginning from the intersection of the 193.51 and 158.56 lot lines, begin trenches  
150 feet down the 193.51 lot line and 65 feet off that same lot line. Run trenches on  
contour in both directions. 2/12/01 OK BB

PLANS APPROVED Amy McMillen DATE 2/7/2001

- PERMIT VOID AFTER 2 YEARS
- NOTE: CONTRACTOR RESPONSIBLE FOR SCHEDULING A PRE-CONSTRUCTION INSPECTION FOR ALL INSTALLATIONS
- NOTE: TOP OF SEPTIC TANKS ARE TO BE NO DEEPER THAN 3.0 FEET BELOW FINISH GRADE
- NOTE: WATERTIGHT SEPTIC TANKS REQUIRED
- NOTE: CLEANOUT REQUIRED EVERY 70 FEET OF SEWER LINE AND/OR AT 90° SWEEPS IN LINES FROM HOUSE TO DRAIN FIELDS, 90° ELBOWS ARE NOT ACCEPTABLE
- NOTE: ALL PARTS OF SEPTIC SYSTEMS (I.E. TANK, DISTRIBUTION BOX, DRAINFIELDS) TO BE 100 FEET FROM ANY WATER WELL UNLESS OTHERWISE SPECIFICALLY AUTHORIZED
- NOTE: NO ABSORPTION TRENCH TO EXCEED 100 FEET IN LENGTH UNLESS SPECIFICALLY AUTHORIZED
- NOTE: ALL PIPE FROM HOUSE TO SEPTIC TANK MUST BE CAST IRON OR SCHEDULE 35/40 PVC OR ABS
- NOTE: MANHOLE RISERS REQUIRED ON ALL SEPTIC TANKS AND PUMP CHAMBERS
- NOTE: DISTRIBUTION BOXES MUST HAVE BAFFLES
- NOTE: IF PUMPED SEPTIC SYSTEM REQUIRED, (1) SEPTIC PUMP DETAIL TO BE PROVIDED BY INSTALLER PRIOR TO ISSUANCE OF SEPTIC PERMIT (2) PUMP PERFORMANCE TEST IS NECESSARY PRIOR TO HEALTH DEPARTMENT APPROVAL OF SEPTIC PERMIT


BLDG. PERMIT SIGNED  
AND RETURNED 2/7/2001  
B00128193  
3 CAR DETACHED GARAGE

BLDG. PERMIT SIGNED  
AND RETURNED 6/18/2001  
B00130618 PROPANE TANK

NEITHER THE HOWARD COUNTY COUNCIL NOR THE HEALTH DEPARTMENT IS RESPONSIBLE FOR THE  
SUCCESSFUL OPERATION OF ANY SYSTEM  
PERMITTEE RESPONSIBLE FOR OBTAINING FINAL APPROVAL ON THIS PERMIT  
CALL 410-313-2640 FOR INSPECTION OF SEPTIC SYSTEM

514982-B

NOT TO SCALE

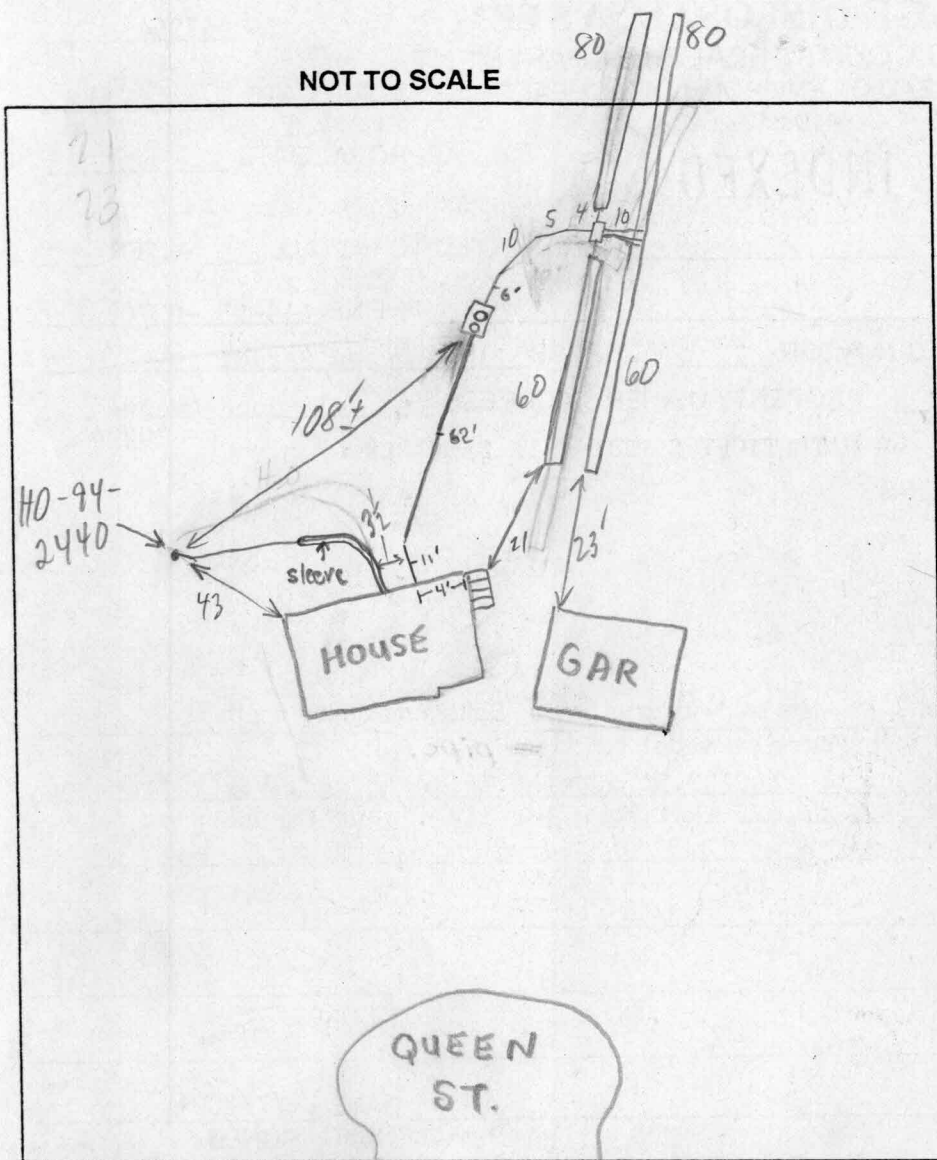

### TRENCH DATA

TRENCH WIDTH 3  
 TRENCH INLET DEPTH 4  
 TRENCH BOTTOM DEPTH 6  
 DEPTH OF STONE 2  
 NUMBER OF TRENCHES 4  
 TOTAL TRENCH LENGTH 280  
 ABSORBENT AREA 840  
 DISTRIBUTION BOX LEVEL ☒  
 BAFFLE IN DISTRIBUTION BOX ☒

### SEPTIC TANK DATA

SEPTIC TANK 1250 TS GALLONS  
 BAFFLES INV on center  
 MANHOLE RISER on front  
 6 INCH INSPECTION PORT on front

### PUMP CHAMBER DATA

PUMP CHAMBER GALLONS                       
 MANHOLE RISER                       
 ALARM                       
 PUMP PERFORMANCE TEST                     

PRE-CONSTRUCTION INSPECTION: 4/24/01-MET INSTALLER FOR LAYOUT, OK TO RUN 2-80' TRENCH  
AND TWO 60' TRENCHES. INSTALLER TO ADD MANHOLE RISER AND OK TO COVER FROM  
HOUSE TO TANK-SRM  
 INSPECTION COMMENTS: 4/25/01 OK TO COVER ALL (MR)

4/25/01 WPI=2-PC CAP, PITLESS, GROUT & TAG OK; NOT INSTALLED NOT APPROVED  
 CONDUIT, SLEEVE @ HOUSE (MR)  
 INSPECTOR M. Rifkin DATE SYSTEM APPROVED 4/25/01