

Howard County Health Department


see Detailed Sand Mound Construction Plan by S/E Engineering.

Ronald [Signature]
Signature

5/3/02
Date



DRIVEWAY SECTION
NOT TO SCALE

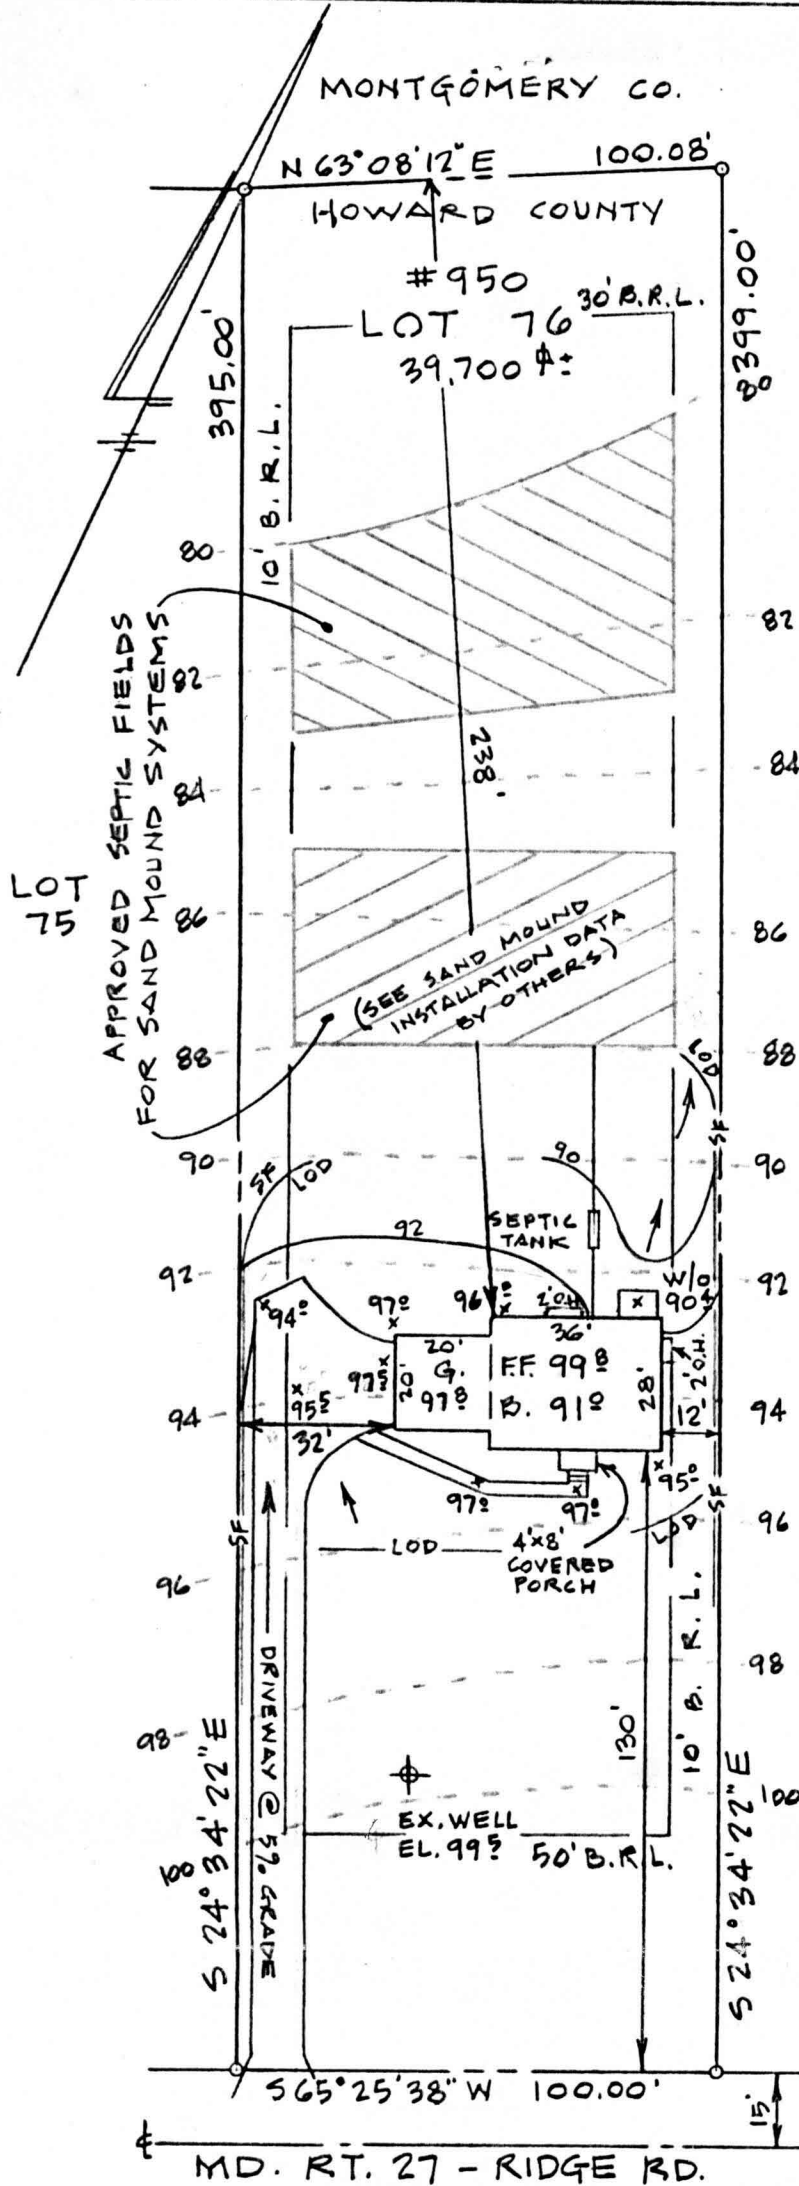

SEPTIC DATA

HOUSE FIN. FL.	99.8
" BSM'T	91.2
" SEWER INV	89.2
SEPTIC INV. IN	88.5
TANK INV. OUT	88.2
" FIN. GR.	91.2

NOTE: THIS LOT TO UTILIZE SAND MOUND SEPTIC SYSTEM TO BE DESIGNED BY OTHERS.

WATER EX. GR	99.5
WELL FIN. "	99.5

NOTE:

1. HOUSE TYPE: 2 STORY FRAME WITH FULL BASEMENT.
2. TOPOGRAPHY SHOWN TAKEN FROM PERCOLATION CERTIFICATION PLAN DEPICTING FIELD-RUN GRADES BASED ON ASSUMED DATUM.
3. PROPERTY ADDRESS: 950 RIDGE ROAD (RT. 27) MT. AIRY, MD. 21771

— OWNER / BUILDER —
BENCHMARK HOMES
8450 SAVAGE GUILFORD RD.
SAVAGE, MD. 20763
410-792-0900

— ENGINEER —
JOHN L. SCHNEIDER, PE
100 H. ROLLING ROAD
CATONSVILLE, MD. 21228
410 744 1945


GRADING STUDY PLAN

LOT 76 "RIDGEVILLE HEIGHTS" PROPERTY
PARCEL 8 TAX MAP 6


4th ELECTION DISTRICT
HOWARD COUNTY, MD.

SCALE: 1" = 40'

DATE: MARCH 8, 2002

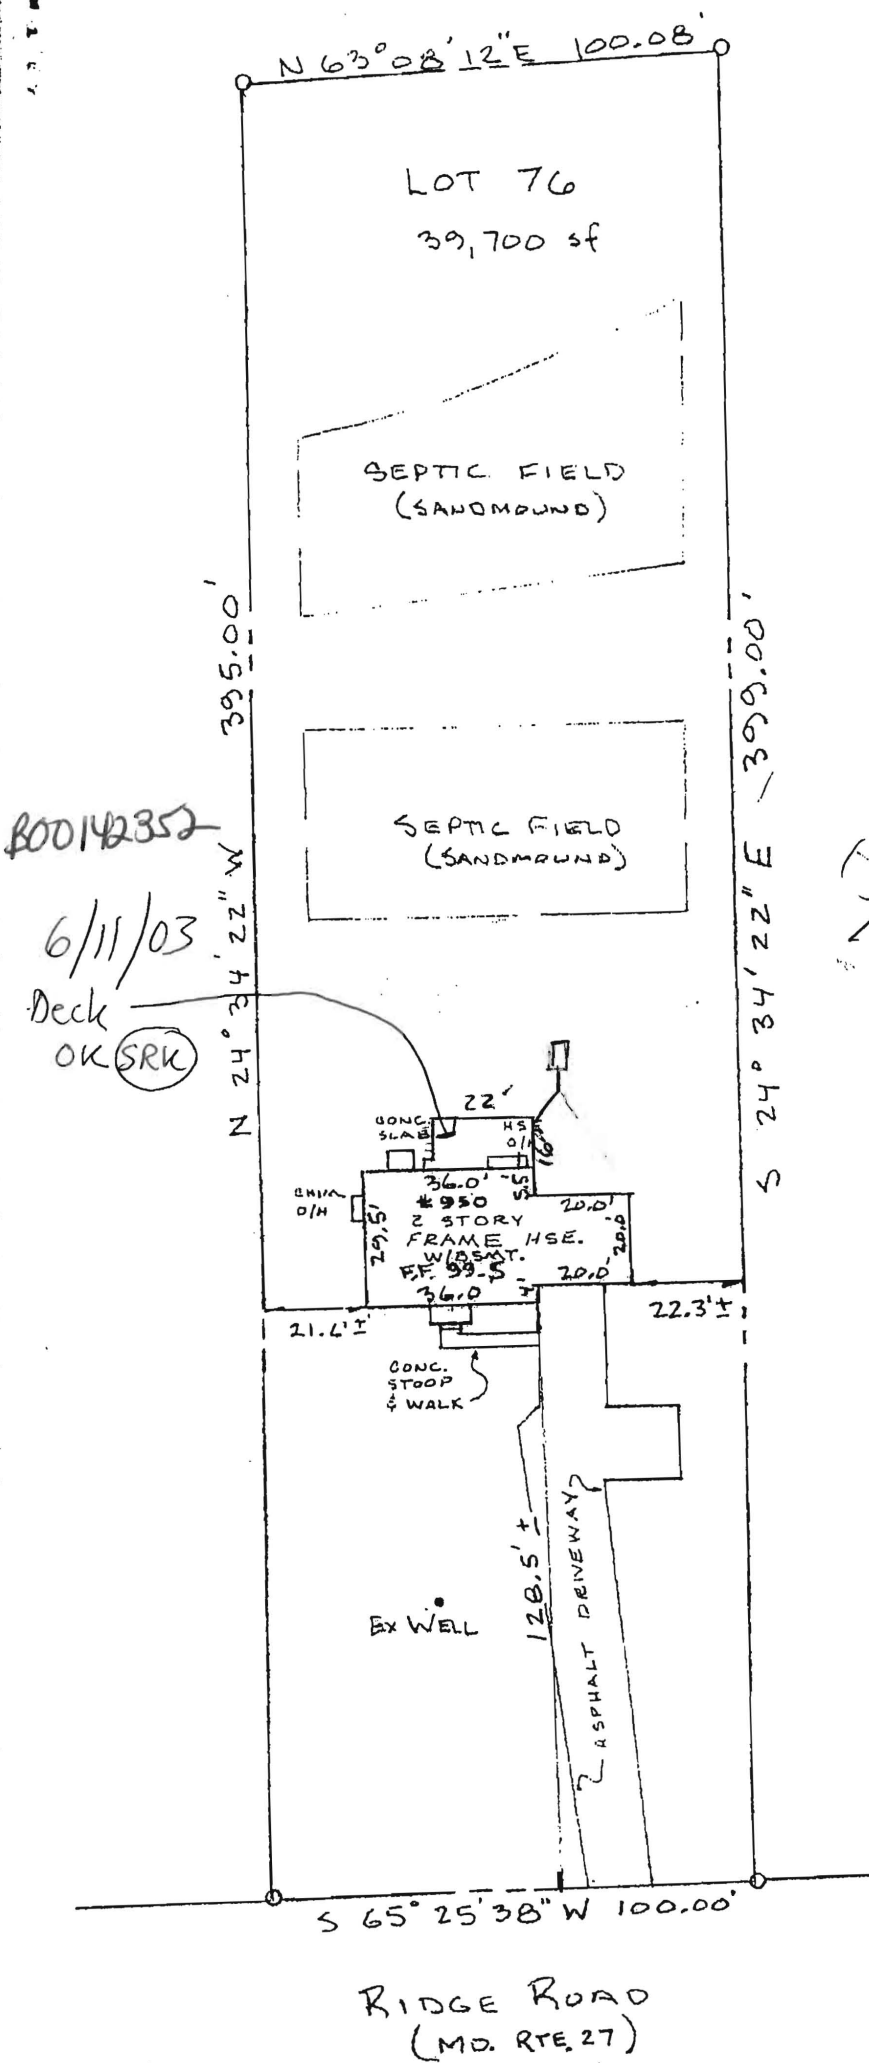

Jaimet Aseth
Att. Hls

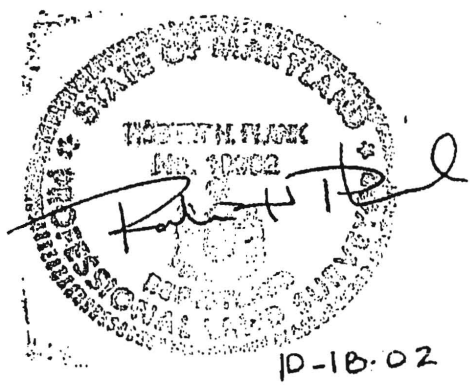

FINAL LOCATION SURVEY
LOT 76 RIDGEVILLE HEIGHTS
4TH ELECTION DISTRICT
HOWARD COUNTY MARYLAND
SCALE: 1" = 40' OCT, 2002

I CERTIFY THIS PLAT TO BE CORRECT; IT IS THE RESULT OF AN ACTUAL FIELD SURVEY BASED ON DATA FOUND AMONG THE LAND RECORDS OF HOWARD COUNTY, MARYLAND, AS REFERENCED HEREON.

REFERENCE	JOB NO.
-----------	---------

NASSAUX-HEMSLEY, INC.
204 S. MAIN STREET
MOUNT AIRY, MARYLAND 21771