

APPLICATION

SEWAGE DISPOSAL TESTING

STATE OF MARYLAND - DEPARTMENT OF HEALTH AND MENTAL HYGIENE

HOWARD COUNTY HEALTH DEPARTMENT
ENVIRONMENTAL HEALTH SERVICES

P. O. BOX 473 ELLICOTT CITY, MARYLAND 21043
TELEPHONE: 992-2330

A 33214

P _____

DISTRICT 4th

DATE 10/2/83

CONTRACT BUYER

BILL W. CURTIS

24620 RIDGE RD.

DAMASCUS, MD. 20822

HOME: 301-253-4226

WORK: 301-795-1390

TO: THE COUNTY HEALTH OFFICER
ELLICOTT CITY, MARYLAND

I, HEREBY, APPLY FOR THE NECESSARY TEST IN ORDER TO CONSTRUCT (OR RECONSTRUCT) A SEWAGE DISPOSAL SYSTEM.

PROPERTY OWNER MARY ANN TOLKER - CHARA L. SHIPLE - WILLIAM STANLEY PEARSON

ADDRESS _____ PHONE _____

PROPERTY LOCATION:

SUBDIVISION RIDGEVILLE HGTS LOT NO. 76

ROAD AND DESCRIPTION RT 27 RIDGE ROAD - WEST SIDE OF RT 27

1.1 MILES SO. OF INTERSTATE 70.

SIZE OF LOT 100' X 410' TYPE BLDG. 3 OR 4

(NUMBER OF BEDROOMS)

THE SYSTEM INSTALLED UNDER THIS APPLICATION IS ACCEPTABLE ONLY UNTIL PUBLIC FACILITIES BECOME AVAILABLE. I FULLY UNDERSTAND THE

FEE CONNECTED WITH THE FILING OF THIS PERC TEST APPLICATION IS NON-REFUNDABLE UNDER ANY CIRCUMSTANCES. I ALSO AGREE TO COMPLY

WITH ALL M.O.S.H.A. REQUIREMENTS IN TESTING THIS LOT. BILL W. CURTIS

(SIGNATURE OF APPLICANT)

APPROVED BY Frank Skinn FOR Tilefield DATE 7/19/84

REJECTED BY C. Williams FOR NOY DATE _____



HOLD PENDING FURTHER TESTS C. Williams DATE 12-12-83

REASONS FOR REJECTION OR HOLDING CERTIFIED HOLES NEEDED FOR COMBINED LOTS.

C. Williams

THIS IS NOT A PERMIT

ALL HOLES

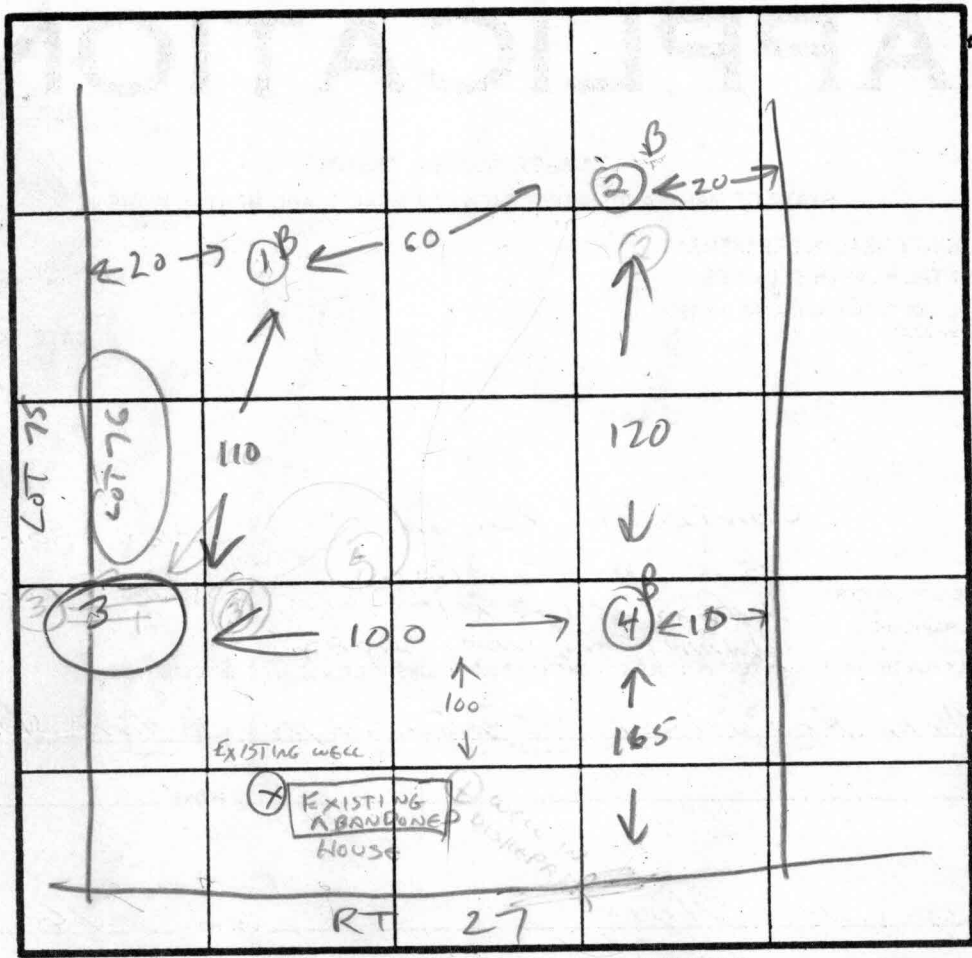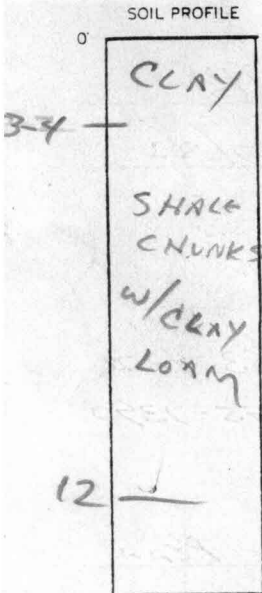

#344
ARE
HIGH
HOLES

INDICATE NORTH - NAME ADJOINING ROADWAY AS BASE LINE.

DATE	TEST NO.	DEPTH	PRE-WET		TEST - 1" DROP		TIME
			START	STOP	START	STOP	
11-14-83	1 B	4	12:52	12:55	12:55	1:00	5 MIN
		8	12:51	12:52:40	12:52:40	12:56	3 MIN 20 SEC
		12					
	2 B	4	1:20:30	1:51	STOPPED		
		8	1:18	1:23	1:23	1:32	9 MIN
		12	RETESTED AT 5' - ON 12-9-83 - 5 MIN / INCH OK				
	3	4	SEE A				26 4 1/2
		12	FOR DETAILS				
	4 B	4	ROCKY	TOO	HARD TO CONTINUE		
		8			DIGGING PAST 8 FEET		
		12					

TEST HOLE 3
IS SAME
HOLE ON
BOTH LOTS

OK

OK

REMARKS EXISTING WELL MUST BE REPAIRED OR REPLACED

TYPE OF SOIL SHALEY w/ CLAY LOAM

TESTED BY C. Waller

ALSO PRESENT BUD ARNOLD'S CREW

FORD SURVEYS

BLADY TOWN, MD. 21717

N56°51'34"E

100.03'

stone

N63°08'12"E 100.08'

PARCEL No. 8

TAX MAP No. 6

ZONING MAP No. 6

4th Election District

Census Tract 6040

Near Mt. Airy, Md.

(2)

75

76

50.00'

77

N24°34'22"W

397.50'

395.00'

410.00' S24°34'22"E

399.00'

S24°34'22"E

100.00'

100.00'

S65°25'38"W

MD. RT# 27

RIDGE ROAD

PLAT OF SURVEY RIDGEVILLE HEIGHTS
HOWARD COUNTY, MARYLAND

RECORDED IN PLAT BOOK

PLAT

SCALE 1" = 50'

concrete monument on
the Howard Co. and
Montgomery Co. Line.

I hereby certify that the position of all the existing improvements on the above described property has been established by a transit tape measurement and that unless otherwise shown there are no encroachments.

By

William L. Ford, Jr.

William L. Ford, Jr.
Maryland No. 9008
Registered Land Surveyor

10/30/79

11/14/83
9:30 A.M.

APPLICATION

SEWAGE DISPOSAL TESTING

STATE OF MARYLAND - DEPARTMENT OF HEALTH AND MENTAL HYGIENE

HOWARD COUNTY HEALTH DEPARTMENT
ENVIRONMENTAL HEALTH SERVICES

P. O. BOX 476 ELLICOTT CITY, MARYLAND 21043
TELEPHONE: 992-2330

A 33213

P _____

DISTRICT 4TH

DATE 10/7/83

CONTRACT BUYER

TO: THE COUNTY HEALTH OFFICER
ELLICOTT CITY, MARYLAND

Billy W. Curtis
2420 Ridge Rd
DAMASCUS, MD 20872

Home 301-253-7226

Work 301-798-1390

I, HEREBY, APPLY FOR THE NECESSARY TEST IN ORDER TO CONSTRUCT (OR RECONSTRUCT) A SEWAGE DISPOSAL SYSTEM.

PROPERTY OWNER Mary Ann Tolker - Clara L. Shipe - William Stanley Penn

ADDRESS _____ PHONE Unknown

PROPERTY LOCATION:

SUBDIVISION Ridgeville Hgts LOT NO. 75

ROAD AND DESCRIPTION RT. 27 - Ridge Road - West Side of RT 27

1.1 miles S. of Interstate 70

SIZE OF LOT 100' X 397.50 TYPE BLDG. 3 or 4
(NUMBER OF BEDROOMS)

THE SYSTEM INSTALLED UNDER THIS APPLICATION IS ACCEPTABLE ONLY UNTIL PUBLIC FACILITIES BECOME AVAILABLE. I FULLY UNDERSTAND THE FEE CONNECTED WITH THE FILING OF THIS PERC TEST APPLICATION IS NON-REFUNDABLE UNDER ANY CIRCUMSTANCES. I ALSO AGREE TO COMPLY WITH ALL M.O.S.H.A. REQUIREMENTS IN TESTING THIS LOT.

Billy W. Curtis
(SIGNATURE OF APPLICANT)

APPROVED BY _____ FOR _____ DATE _____

REJECTED BY _____ FOR _____ DATE _____



HOLD PENDING FURTHER TESTS _____ DATE _____

REASONS FOR REJECTION OR HOLDING _____

THIS IS NOT A PERMIT

ALL HOLES

SOIL PROFILE

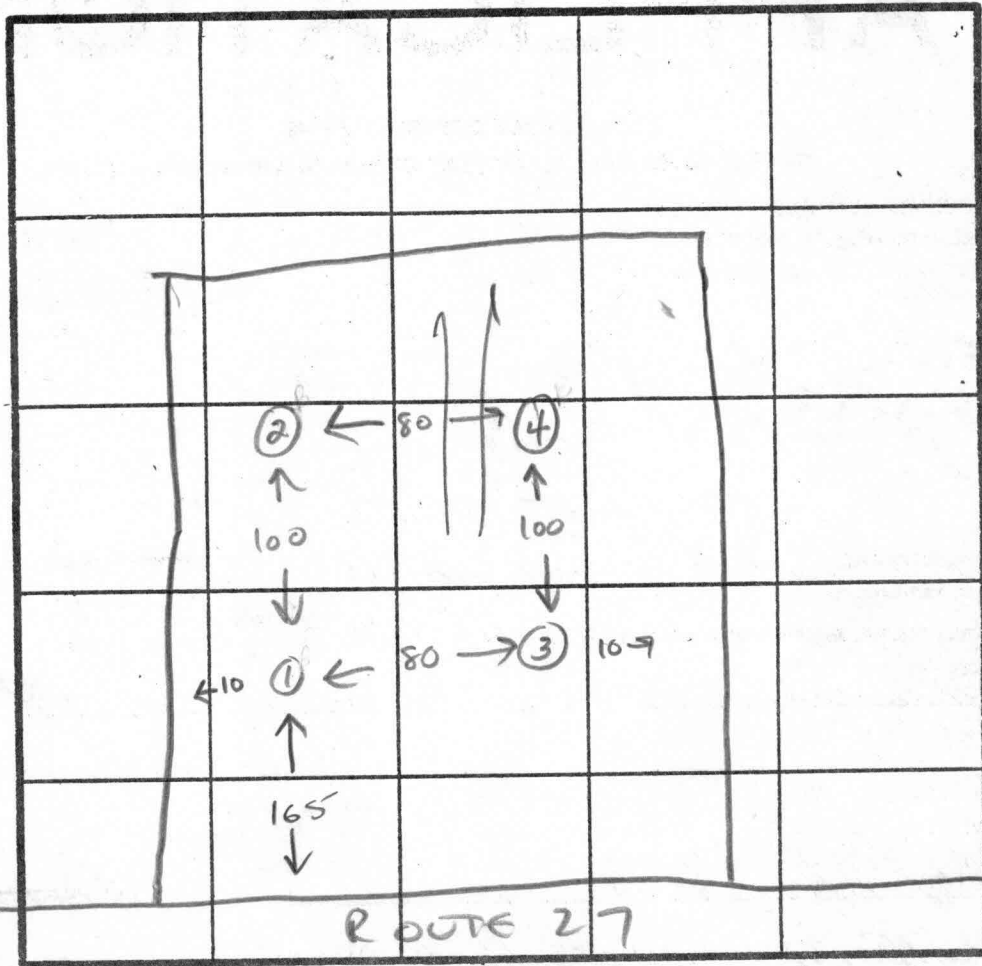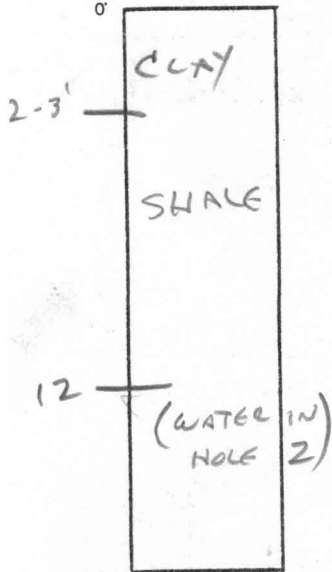

INDICATE NORTH - NAME ADJOINING ROADWAY AS BASE LINE.

DATE	TEST NO.	DEPTH	PRE-WET		TEST - 1" DROP		TIME
			START	STOP	START	STOP	
11-14-83	1B	3	10:25	10:37	10:37	11:27	50 MIN
		7	10:19:25	10:20:02	10:20:02	10:20:40	38 SEC
		12	VERY SHALEY				
	2B	4					
		8	SHALEY NOT TESTED				
		12	WATER AT 12				
	3	3	TOO	SLOW	AT 3 FT		SLOW
		8	10:45	11:03	11:03	11:29	26 MIN
			10:40:50	10:43:45	10:43:45	10:48:15	4 1/2 MIN
		12	POURED 5 GAL INTO WATER		BOTTOM OF TRENCH REMAINED FOR 10 MIN		
	4B	6	TOO SHALEY TO CONTINUE DIGGING				

(TOO FAST) - (TOO SLOW)

REMARKS FAILS - SHALE - CLAY & WATER

TYPE OF SOIL VERY SHALEY w/ LITTLE CLAY LOAM

TESTED BY C. Wilton ALSO PRESENT BUD ARNOLD'S CREW

Rockville Hill
PETITION OF BILLY W AND PAULINE R. CURTIS *Lot 76*
75

Existing Zoning - R

Property fronts on Rt. 27 South
of Mt. Airy, Maryland

Is located on West side of Rt. 27
1.1 Miles South of Interstate 70.
And 2.4 Miles North of Rt. 80
(Montgomery County)

Present Owners:

Mary Ann Tolker
3108 McComas Avenue
Kensington, Maryland 20795

Clara L. Shipe
5912 Muncaster Mill Road
Rockville, Maryland

William Stanley Penn
626 Lincoln Street
Rockville, Maryland 20855

Petitioners:

Billy W. and Pauline R. Curtis
24620 Ridge Road
Damascus, Maryland 20750

Attorney:

Gordon M. Cooley
9863 Main Street
Damascus, Maryland 20750

Parcel No. 8

Tax Map No. 6

Zoning Map No. 6

Election District:

No. 4

Local Community:

Census Tract 6040

Near Mt. Airy

FORD SURVEYS

N 66° 51' 34" E

100.03'

stone

N 63° 08' 12" E 100.08'

PARCEL No. 8

TAX MAP No. 6

ZONING MAP No. 6

4th Election District

Census Tract 6040

Near Mt. Airy, Md.

(2)

75

76

77

50.00'

N 24° 34' 22" W

397.50'

395.00'

410.00' S 24° 34' 22" E

399.00'

S 24° 34' 22" E

100.00'

100.00'

S 65° 25' 38" W

MONUMENT

RIDGE ROAD
PLAT OF SURVEY RIDGEVILLE HEIGHTS
HOWARD COUNTY, MARYLAND

ENCLOSED IN PLAT BOOK

SCALE 1" = 50'

concrete monument on
Howard Co. and
Montgomery Co. Line.

I hereby certify that the position of all the existing improvements on the above described property has been established by a transit tape measurement and that unless otherwise shown there are no other boundaries.

By

William L. Ford, Jr.

William L. Ford, Jr.
Maryland No. 9008

30/79

FORD SURVEYS

N56°51'34"E

100.03'

N63°08'12"E 100.08'

BACK 100.00' 100.00'

PARCEL No. 8

TAX MAP No. 6

ZONING MAP No. 6

4th Election District

Census Tract 6040

Near Mt. Airy, Md.

#7 IS 125' TO C. ROAD
+ 100' TO L. LOT LINE

#5 IS 175' TO C. ROAD
+ 140' TO L. LOT LINE

#7 IS HIGH HOLE
#5 IS SECOND HIGH HOLE

#75

#76

#77

N 24°34'22"W

397.50'

100'

90'

100.00'

110'

24°34'22"E

398.00'

100.00'

125'

TO CENTER OF ROAD

40'

100.00'

S 65°25'38"W

125'

60'

30'

30'

60'

30'

30'

50.00'

50.00'

BLK 27

PLAT OF SURVEY RIDGE ROAD
RIDGEVILLE HEIGHTS
HOWARD COUNTY, MARYLAND

RECORDED IN PLAT BOOK

PLAT

SCALE 1" = 50'

concrete monument on
Howard Co. and
Montgomery Co. Line.

I hereby certify that the position of all the existing improvements on the above described property has been established by a recent map made and that unless otherwise shown thereon, no other improvements are shown.

By *Willard L. Ford, Jr.*

Willard L. Ford, Jr.
Maryland No. 9008
Registered Land Surveyor