
PERMIT NUMBER
700134536 DEPARTMENT OF INSPECTIONS, LICENSES AND PERMITS
3430 COURT HOUSE DRIVE
ELLICOTT CITY, MD 21043
PERMITS (410)313-2455 INSPECTIONS (410)313-1810
AUTOMATED INFORMATION (410) 313-3800 HOWARD COUNTY PERMIT APPLICATION Property Owner's Name PATRICK JOSEPH GOSHAN Building Address _ 610 RIVER Address OLO - RIVER RO 21784 SYKESVILLE mo State MD Zip Code 21784 City SYKESVILLE SDP/WP/Petition #: Suite/Apt. # Home Phone443-277- 1784 Work Phone410-418-9166 Subdivision Census Tract Applicant's Name & Mailing Address, (if other than stated hereon): Section Tax Map Phone Lot size Map Coordinates Zoning MECANCA Contractor Company Postive Existing Use DUELLING Proposed Use DWELLING Contact Person CHRIS 1900,00 Estimated Construction Cost \$ Address 104 TENHYSON Description of Work TASTALL 1000 GALLON State no Zip Code 21009 City SALVER SPRING UNDERGROUND PROPANE TANK AND LINE License No. Phone 143-677-156 TO HOUSE STUB Engineer or Architect Company Occupant or Tenant 5 RME Contact Person _ Contact Name Address Address Zip Code State City Zip Code State City Fax Phone Phone BUILDING DESCRIPTION - RESIDENTIAL BUILDING DESCRIPTION - COMMERCIAL **Utilities Building Characteristics Utilities Building Characteristics** Water Supply: SF Dwelling □ SF Townhouse □ Water Supply: Height: Public Private Width Depth Public Private Sewage Disposal: No. of stories: 2nd floor: Sewage Disposal: Public Private Public Basement: Gross area, sq. ft. per floor: Private Finished Basement Unfinished Basement Slab on Grade No. of Bedrooms Electric Yes □ No □ 0, Yes No 🗆 Electric Yes □ No □ Yes □ No □ Gas Use group: Multi-family dwellings Heating System: No of efficiency units: Electric Oil O Heating System: No. of 1 BR units: Natural Gas Electric
Oil Construction type: No. of 2 BR units: Propane Gas Natural Gas □ No. of 3 BR units: Reinforced Concrete Propane Gas Structural Steel Other Structure: Sprinkler system: N/A □ NFPA #13D Masonry Sprinkler system: N/A □ Wood Frame NFPA #13R Footings: Full Other: Partial State Certified Modular Other Suppression State Certified Modular Manufactured Home # of Heads THE UNDERSIGNED HEREBY CERTIFIES AND AGREES AS FOLLOWS: (1) THAT HE/SHE IS AUTHORIZED TO MAKE THIS APPLICATION; (2) THAT THE SPORMATION IS CORRECT, (1) THAT HE/SHE WILL COMPLY WITH ALL REGULATIONS OF HOWARD COUNTY WHICH ARE APPLICATION; (3) THAT HE/SHE WILL PERFORM NO WORK ON THE ABOVE REFERENCED PROPERTY NOT SPECIFICALLY DESCRIBED IN THIS APPLICATION; (5) THAT HE/SHE GRANTS COUNTY OFFICIALS THE RIGHT TO ENTER ONLY THE PURPOSE OF INSPECTING THE WORK PERMITTED AND POSTING NOTICES. CHRIS KOLB Print Name Applicant's Signature 2-21-02 MELANKS PasitivE Title/Company Checks payable to: DIRECTOR OF FINANCE OF HOWARD COUNTY ** PLEASE WRITE NEATLY AND LEGIBLY. ** FOR OFFICE USE ONLY-PROPERTY ID# DPZ SETBACK INFORMATION SIGNATURE APPROVAL DATE AGENCY Filing fee Front: 4 Land Development, DPZ Permit fee State Highways Excise tax Side: Building Official Add'l per, fee Side St.: Dev. Engineering, DPZ TOTAL FEES All minimum setbacks met? 4calth -Sub-total paid YES INO I Fire Protection Balance due Is Entrance Permit required? is Sediment Control approval required prior to issuance? Check YES INO I YES | NO | Validation Historic District? YES D NO D CONTINGENCY CONSTRUCTION START: Lot Coverage for NewTown Zone ONE STOP SHOP: SDP/Red-line approval date_ Gold: SHA Pink: Health Yellow: DED, DPZ Green: LDD, DPZ White: Building Official Distribution of Copies-Rev. 5/17/00

T:\forms\PFRMIT FRM



PERMIT NUMBER DEPARTMENT OF INSPECTIONS, LICENSES AND PERMITS
3430 COURT HOUSE DRIVE
ELLICOTT CITY, MD 21043
PERMITS (410)313-2455 INSPECTIONS (410)313-1810
AUTOMATED INFORMATION (410) 313-3800 HOWARD COUNTY B D0132 916 PERMIT APPLICATION Property Owner's Name Patrick GOODGEN ives Climson C+ Address 8127 State MDZip Code 21122 SDP/WP/Petition #: Suite/Apt. Home Phone 10-3 0-77 Work Phone 13-277
Applicant's Name & Mailing Address, (if other than stated hereo Work Phone 43-277-1784 Cenşus Tract 10260 Subdivision Phone Lot size Zoning O Nap Coordinates Contractor Company Sonas cerouate State MD Zip Code 21120 City Hasa Laundy E License No. Phone 443 Engineer or Architect Company oundation Contact Name OWNER Contact Person Address Address Zip Code State City Zip Code State City Fax Phone Phone BUILDING DESCRIPTION - RESIDENTIAL BUILDING DESCRIPTION - COMMERCIAL **Utilities Building Characteristics Building Characteristics** Water Supply: SF Dwelling □ SF Townhouse □ Private Water Supply: Width Height: Depth Public Private 1st floor Sewage Disposal:
Public
Private No. of stories: 2nd floor: Sewage Dispos Basement: Finished Basement Unfinished Basement Slab on Grade No. of Bedrooms Priva Gross area, sq. ft. per floor: Electric Yes Yes 🗷 No 🗆 Electric Yes No □
Gas Yes No □ Multi-family dwellings: Heating System: Use group: No. of efficiency units Heating System: Electric □ Oil Natural Gas No. of 2 BR units: Propane Gas Construction type:
_____ Reinforced Concrete Natural Gas No. of 3 BR units: Propane Gas Sprinkler system: Structural Steel Other Structure: NFPA #13D Dimensions: Masonry Sprinkler system: N/A □ NFPA #13R Footings: Wood Frame Other: Full Partial State Certified Modular Other Suppression State Certified Modular THE UNDERSIONED HEREBY CERTIFIES AND AGREES AS FOLLOWS: (1) THAT HE/SHE IS AUTHORIZED TO MAKE THIS APPLICATION; (2) THAT HE/SHE WILL COMPLY WITH ALL REQULATIONS OF HOWARD CONTY, WHICH ARE APPLICATION; (3) THAT HE/SHE WILL FERFORM NO WORK ON THE ABOVE REFERENCED PROPERTY NOT SPECIFICALLY DESCRIBED IN THIS ASSET FOR THE PROPERTY FOR THE PROPOSE OF INSPECTING THE WORK PERMITTED AND POSTING NOTICES. Print Name runer Date Checks payable to: DIRECTOR OF FINANCE OF HOWARD COUNTY

** PLEASE WRITE NEATLY AND LEGIBLY. ** Title/Company FOR OFFICE USE ONLY PROPERTY ID DPZ SETBACK INFORMATION SIGNATURE APPROVAL Filing fee AGENCY Permit fee Land Development, DPZ State Highways Excise tax Building Official Add'I per fee Side Sta-TOTAL FEES All minimum setbacks met? Sub-total paid YES□ NO□ Fire Protection Balance due Is Entrance Permit required? Is Sediment Control approval required prior to issuance? Check YES | NO | YES D NO D Validation Historic District? YES D NO D CONTINGENCY CONSTRUCTION START: Lot Coverage for NewTown Zone_ ONE STOP SHOP: SDP/Red-line approval date Yellow: DED, DPZ Pink: Health Distribution of Copies White: Building Official Green, LDD, DPZ \$100 investig har fee pd. 1024.01

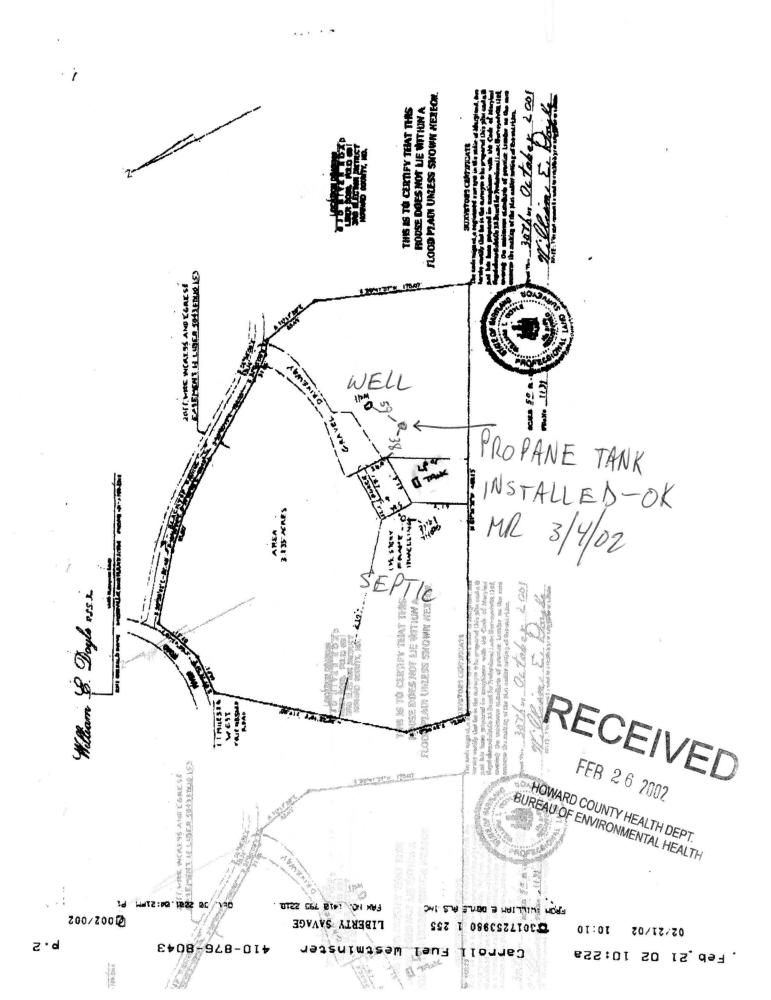