
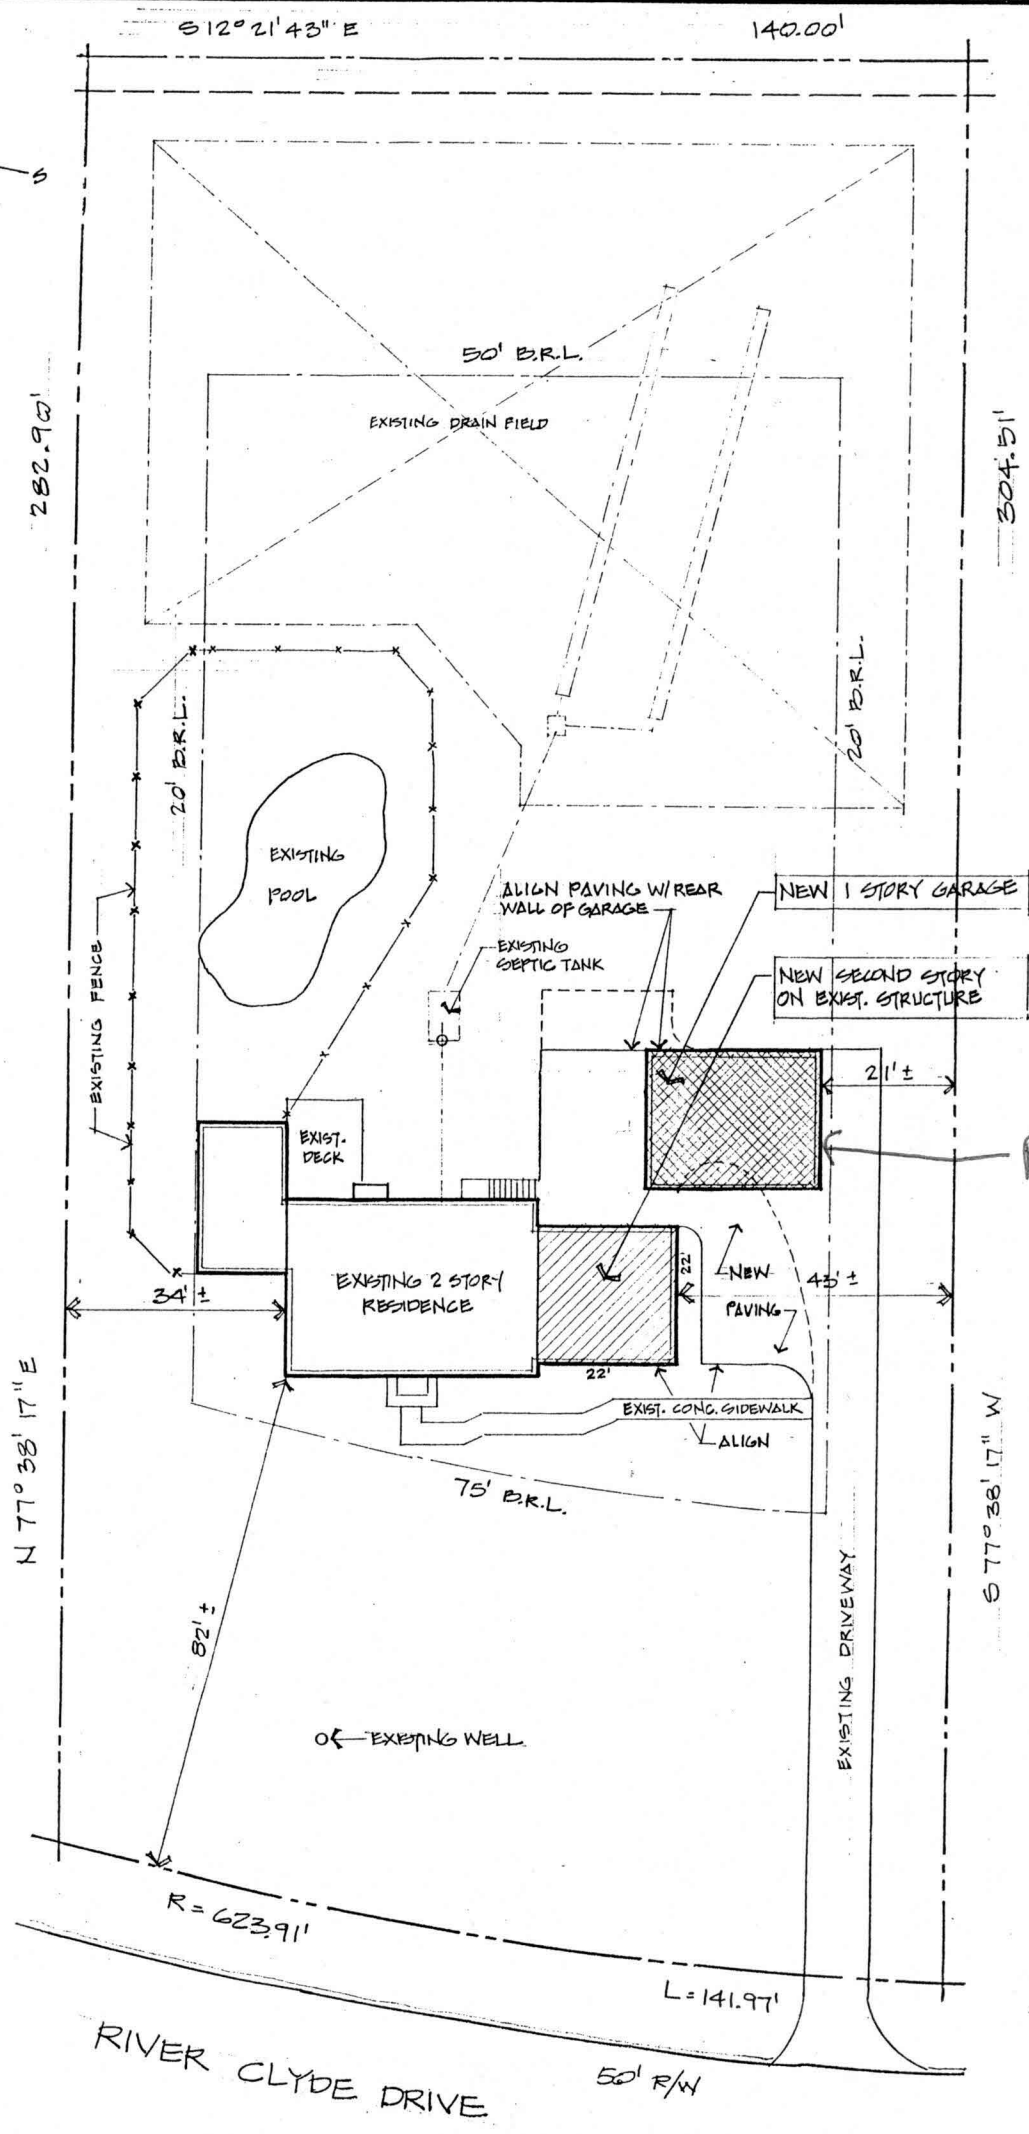


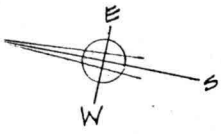

$1 = 30' \pm$

11/8/00
proposed
garage has
no impact to
well or
septic
OK SRU

SITH
SCALE 1

5/6/98
 EXISTING PAV
 APPROVED
 PATIO TO
 BE REPAIRED &
 ENCLOSED
 NO IMPACT
 TO WELL OR
 SEPTIC.
gld jw

Lot 7B

U77°38'17"E

282.90'

S12°21'43"E

5' Utility Easement

144.00'

50' B.R.L.

20' B.R.L.

20' B.R.L.

321.51'

Lot 77

Lot 76

20'
 24'
 32'

14' + 10'
 SCREENED PORCH
 DECK
 T
 40.3'

SEPTIC

Mac Paving

28.2'
 2 Sty Frame
 #6563
 40.3'

22'
 1 Sty Frame
 22.2'
 32'

CELFARM

WALK

15' B.R.L.

Drive

82 1/2' O WELL

Macadam

S77°38'17"W

R=623.91'

Mac Bern


RIVER

50' R/W
 CLYDE


22 1/2' Mac Paving
 DRIVE

DRIVE

L=141.97'

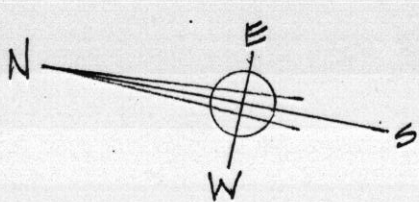

282.90'

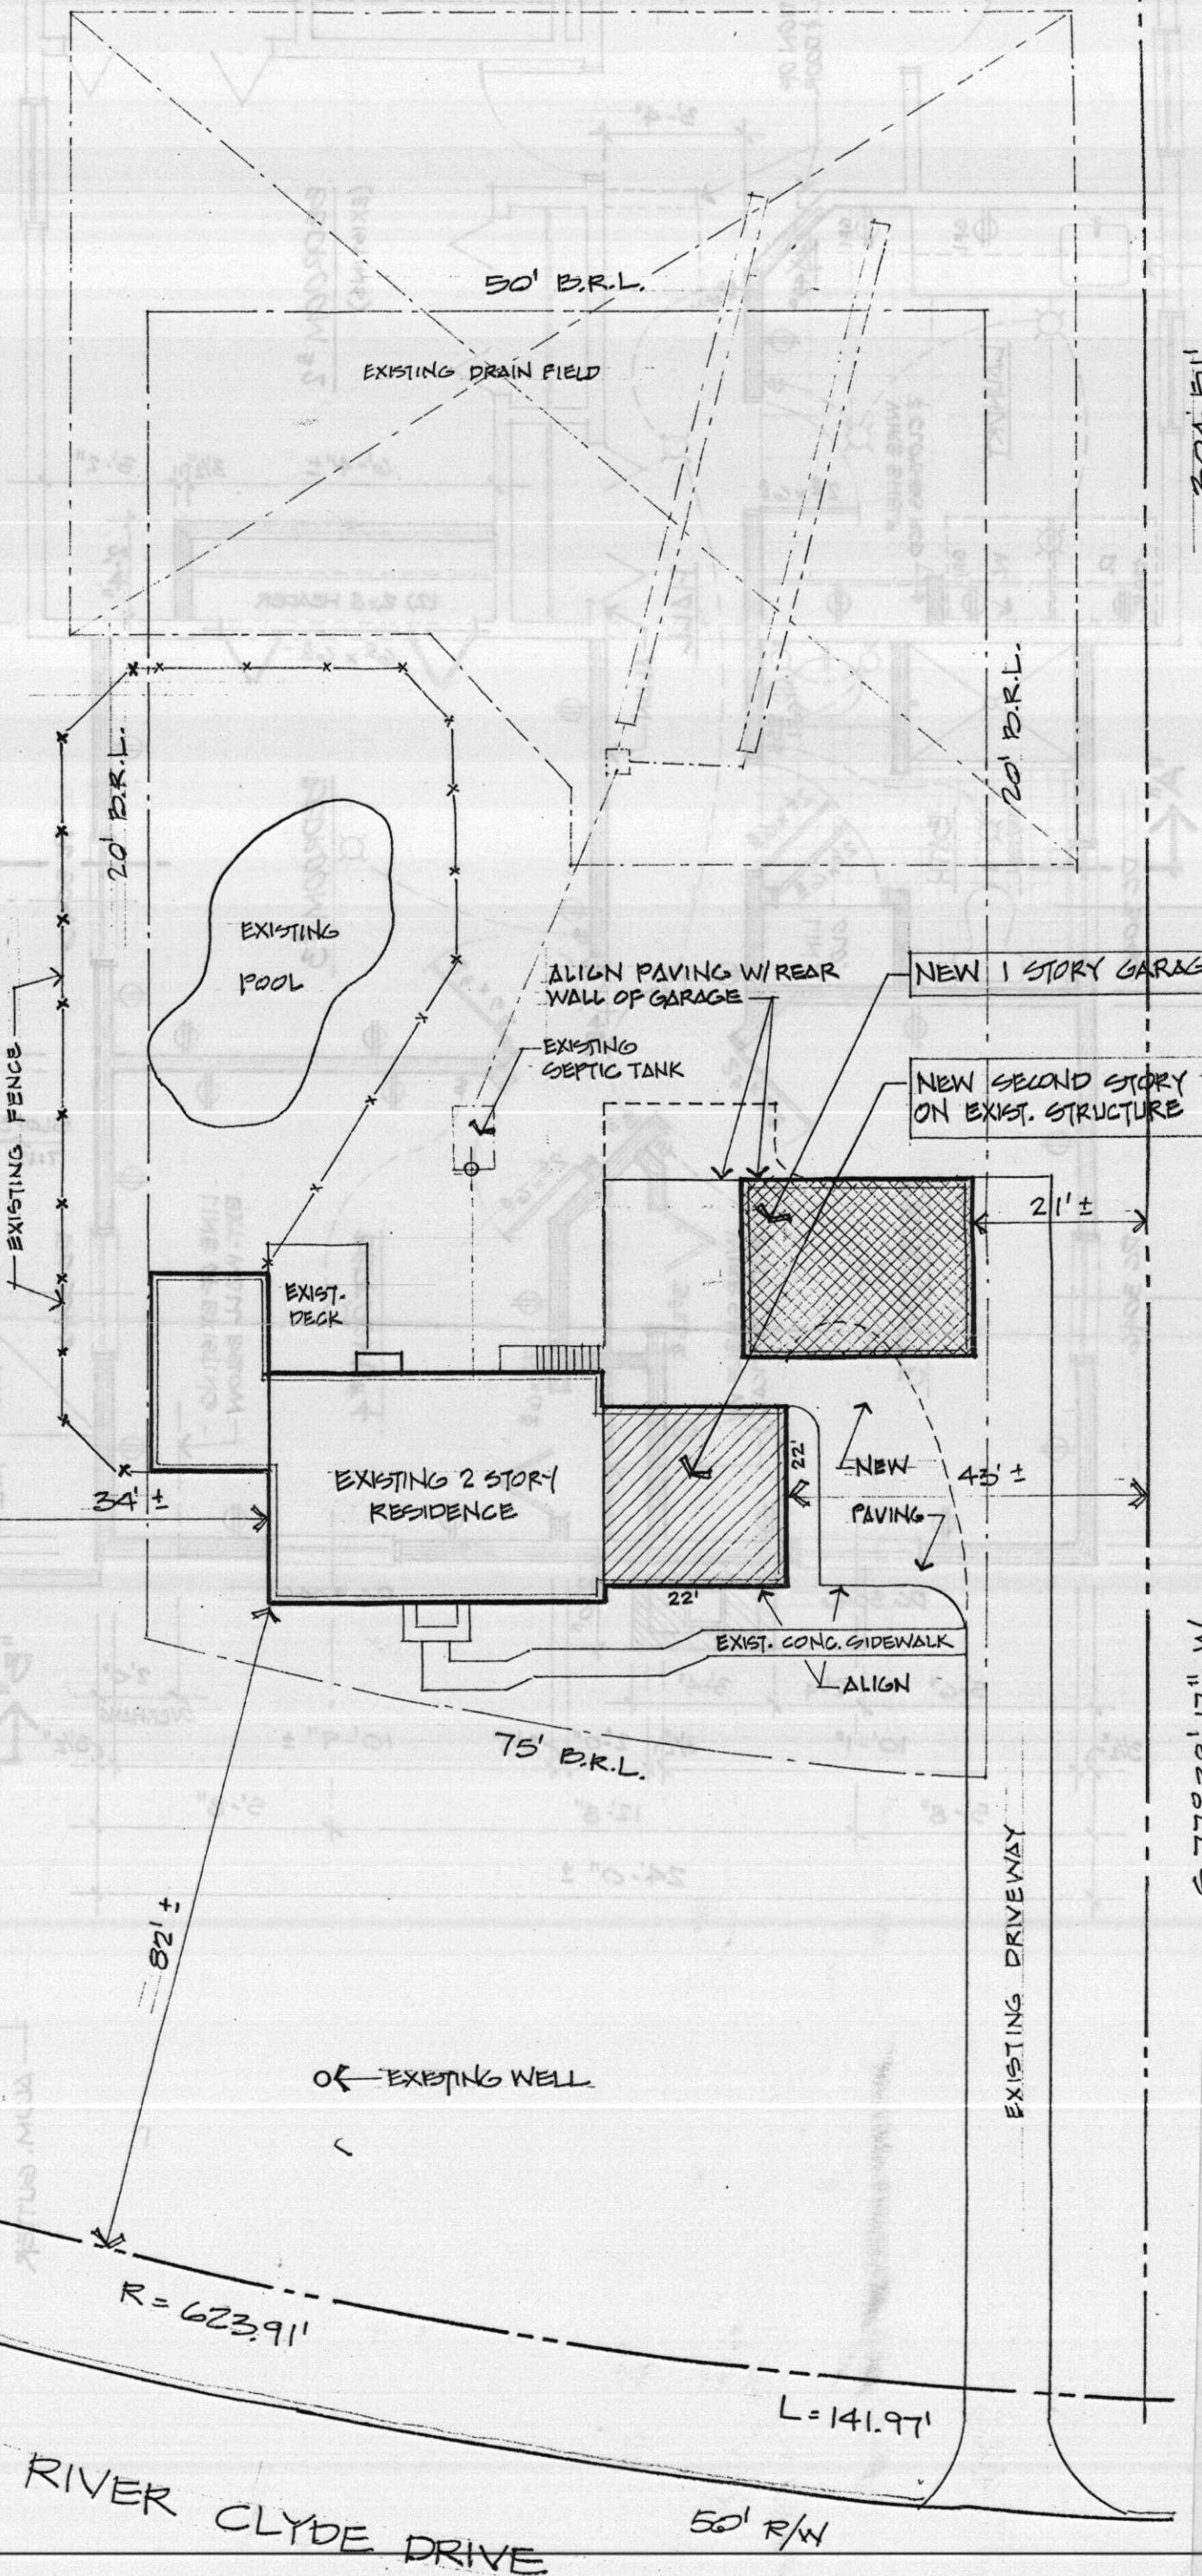

Diane

301-854-3893 (home)

301-928-0096 (cell)

B0013/565

6563 River Clyde Dr.

Highland Lake Lot 97

BP on Hold-upgrading a 4 Bdrm House to a 5 Bdrm c limited SDA (Reduced by prior Swim Pool Addn)

They Need to Bring in a Revised site

Plan Showing they can add 495 LF

More Septic Trench in acceptable area

(SDA+). And They need to make application


for a Septic Repair Permit to add a

second 1000 gal Septic Tank (or replace existing

with a 1500 gal ST) and add 45 LF

More Trench (8' Bottom, inlet @ 4', 2' wide).

RPP 7/18/01

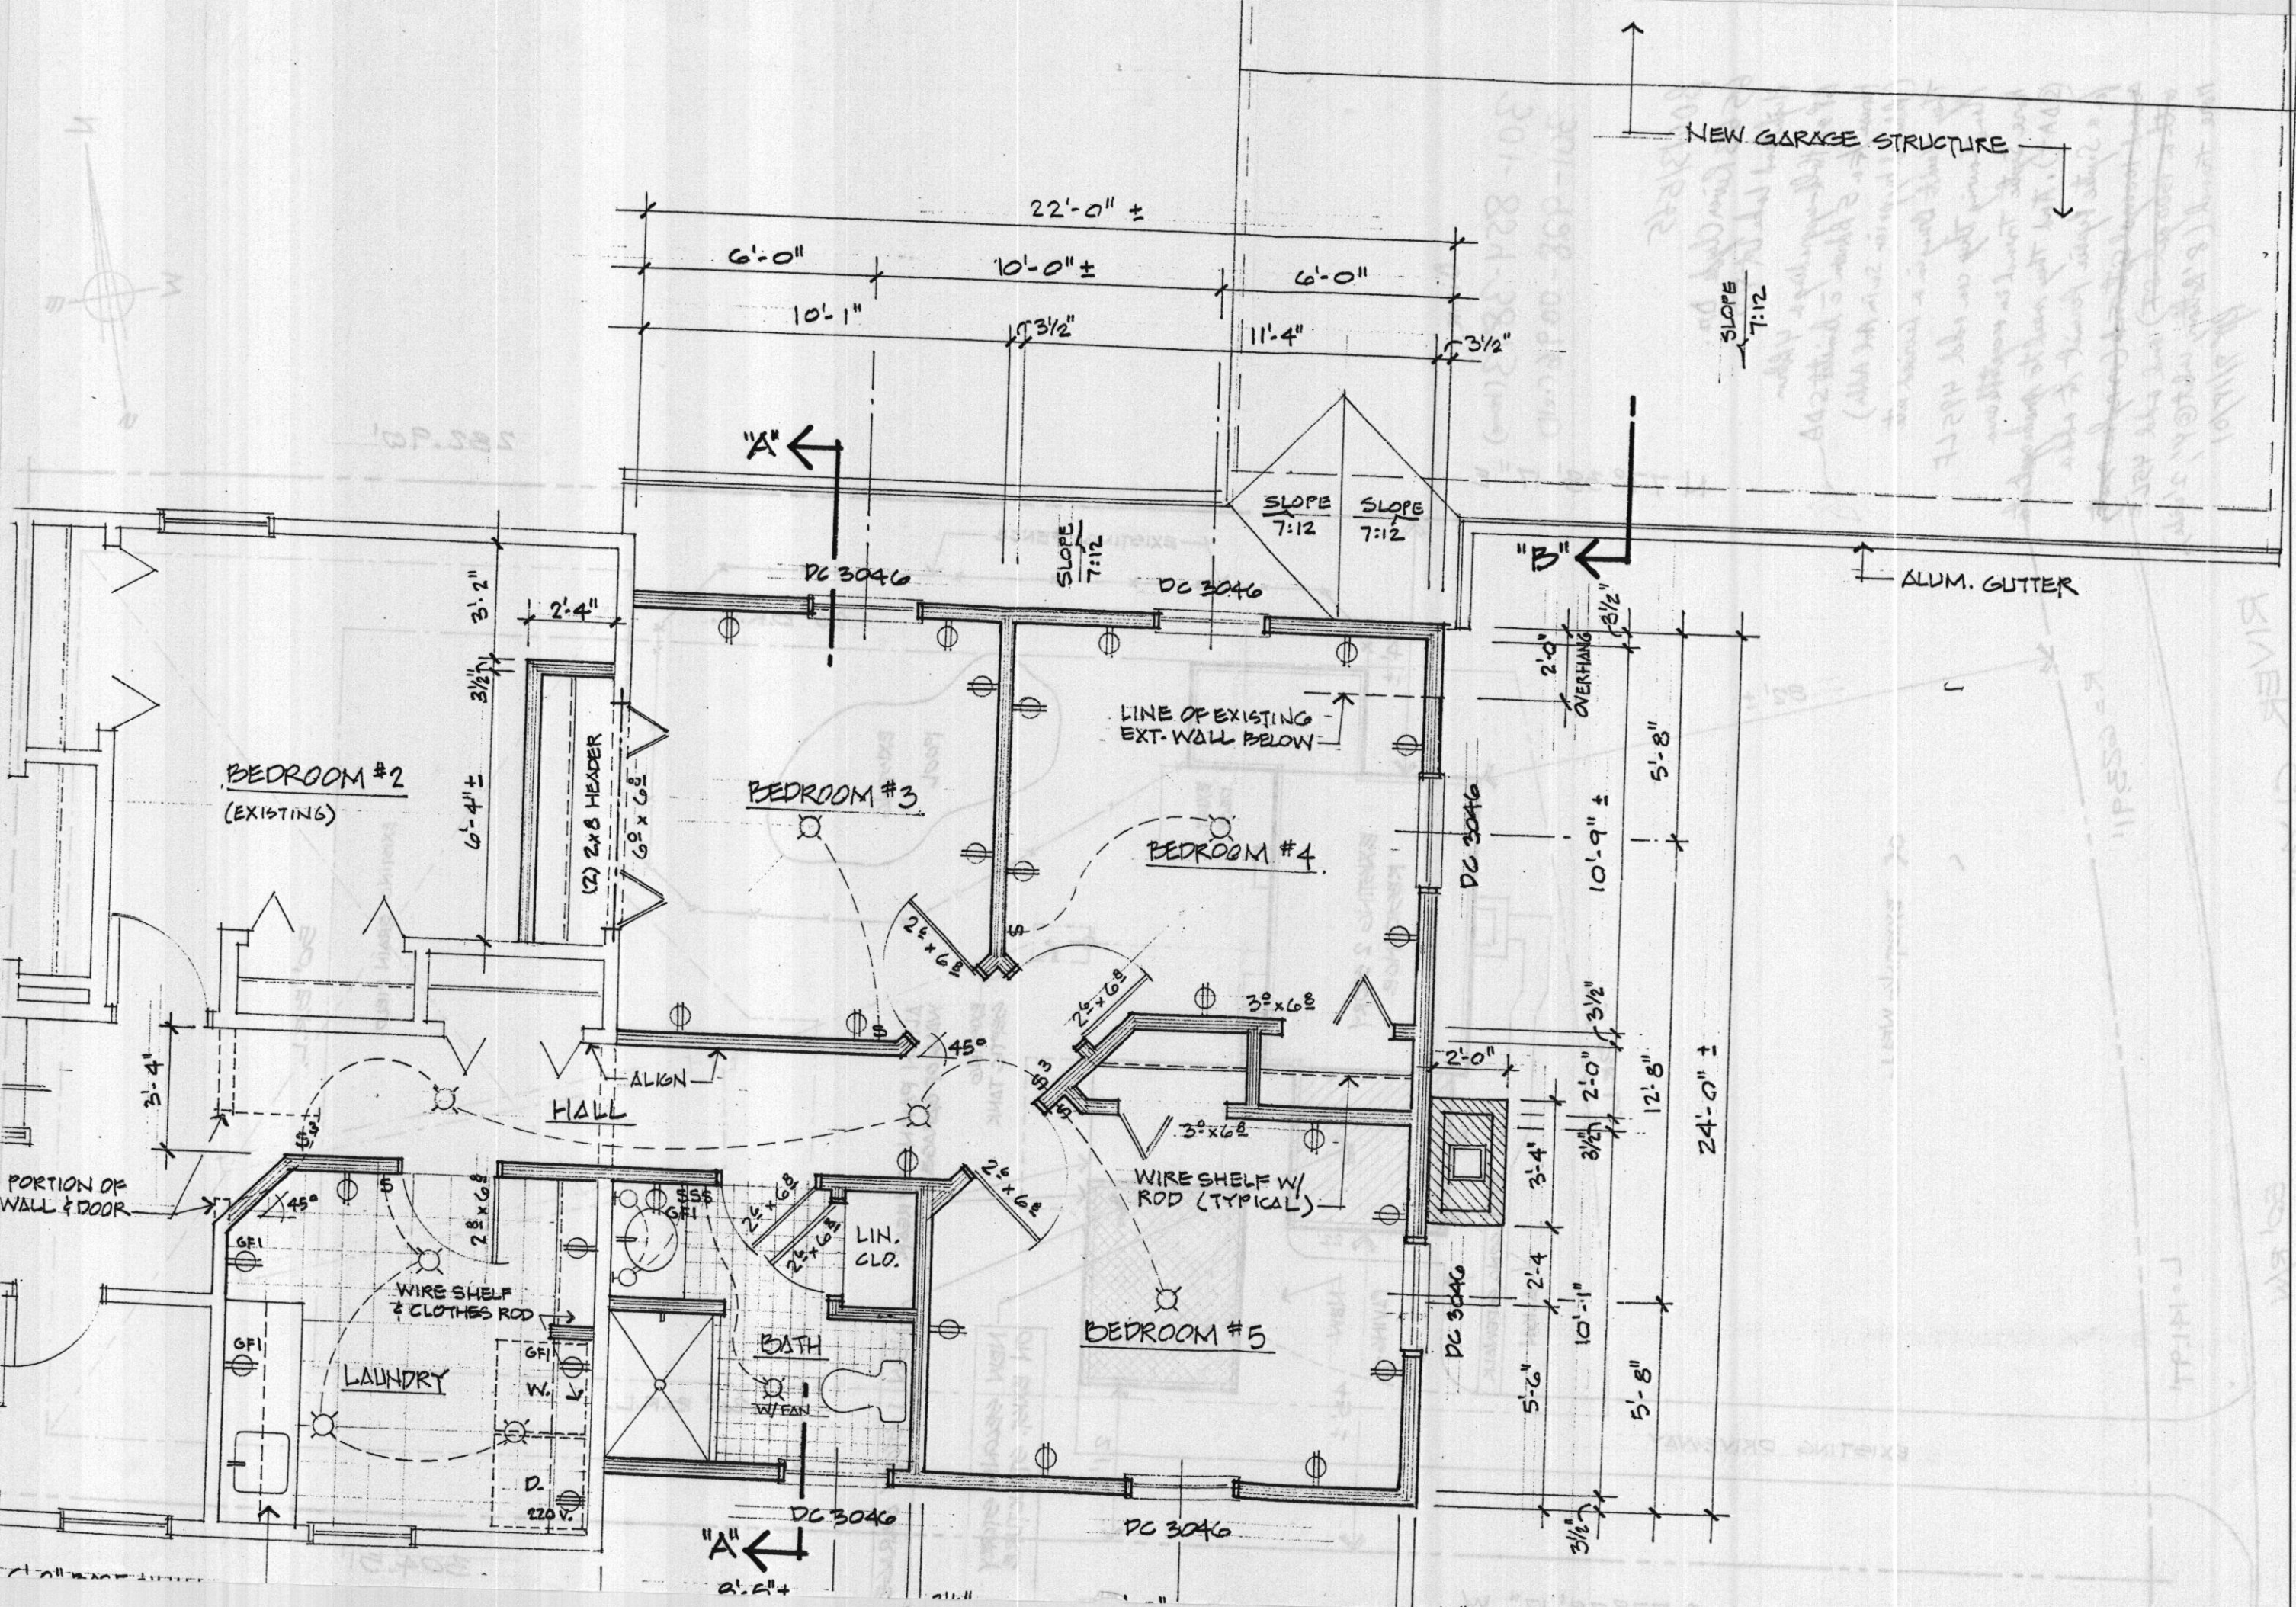

DATAPRINT CORP. 700 SO. CLAREMONT ST. SAN MATEO CA. 94402

OF 6 SHEETS