

# PERMIT

SEWAGE DISPOSAL SYSTEM

MARYLAND STATE DEPARTMENT OF HEALTH

P 33631

A 22 24069

HOWARD COUNTY

BUREAU OF ENVIRONMENTAL HEALTH  
992-2330

ELLICOTT CITY

DISTRICT 5th

DATE 3/8/84

INDEXED

{ I.C.O.P.  
Time expired }

William H. Smith, Jr.

IS PERMITTED TO INSTALL X ALTER       

ADDRESS P. O. Box 38, Darlington, Maryland 21034 PHONE 457-5570

SUBDIVISION Highland Lake ROAD 6563 River Clyde Drive LOT 77, Sec. 2

PROPERTY OWNER Price and Shelly, Inc. MAX & DIANE PETERSON

ADDRESS 529 Gilford Lane, Monkton, Maryland 21111 Phone: 252-3030

IF GARBAGE GRINDER IS USED INCREASE SEPTIC TANK CAPACITY BY 50% AND ABSORPTION AREA BY 22%.

GARBAGE GRINDER? YES        NO       

SEPTIC TANK CAPACITY 1250 GALLONS NUMBER OF BEDROOMS 4

## TRENCHES

TRENCHES - 158 sq. ft. per bedroom. Trench to be 2 ft. wide. Inlet 4-5 ft. below original grade. Bottom maximum depth 9 feet below original grade. Effective area begins at ~~4~~ 4-5 feet below original grade. 4-5 feet of stone below distribution pipe. Locate trench #1 parallel to the right side line and between 20 and 120 feet from the rear lot line. If a 2nd trench is needed space it 10-12 feet away from the 1st trench.

NOTE: IF GARBAGE GRINDER IS INSTALLED SEPTIC TANK CAPACITY MUST BE INCREASED BY 50% AND ABSORPTION AREA MUST BE INCREASED BY 22%.

BLDG. PERMIT SIGNED

AND RETURNED 5-6-98

Serial # B10111536 - deck

PLANS APPROVED BY Frank A. Skinner

DATE 1/25/84

COVER NO WORK UNTIL INSPECTED AND APPROVED.

NEITHER THE HOWARD COUNTY COUNCIL NOR THE HEALTH DEPARTMENT IS RESPONSIBLE FOR THE SUCCESSFUL OPERATION OF ANY SYSTEM.

NOTE: IF TRENCH IS USED CALL FOR INSPECTION BEFORE AND AFTER PLACING GRAVEL IN TRENCH.

NOTE: NO DRY WELL SHALL EXCEED 15 FOOT IN DIAMETER. NO ABSORPTION TRENCH TO EXCEED 100 FEET IN LENGTH.

NOTE: ALL PIPE FROM HOUSE TO SEPTIC TANK MUST BE CAST IRON OR SCHEDULE 40 PVC OR ABS.

PERMIT VOID AFTER THREE YEARS.

NOTE: INSTALL STAND PIPE ON SEPTIC TANK AND DRY WELL. STAND PIPES MUST BE 6 INCHES IN DIAMETER CAST IRON, CONCRETE OR TERRA COTTA, OR PVC OR ABS ACCEPTED. IF TOP OF SEPTIC TANK IS DEEPER THAN 3 FEET MANHOLE TO GRADE REQUIRED.

BLDG. PERMIT SIGNED

AND RETURNED 11/3/00

Garage B0027332

BLDG. PERMIT SIGNED

AND RETURNED 11/30/93

Serial # 57637


Pool

\*INSTALLER IS RESPONSIBLE FOR OBTAINING FINAL APROVAL ON THIS PERMIT

\*CALL 992-2330 FOR INSPECTION OF SEPTIC SYSTEMS.

EH - 2-1082

① Old outlet + hole cemented

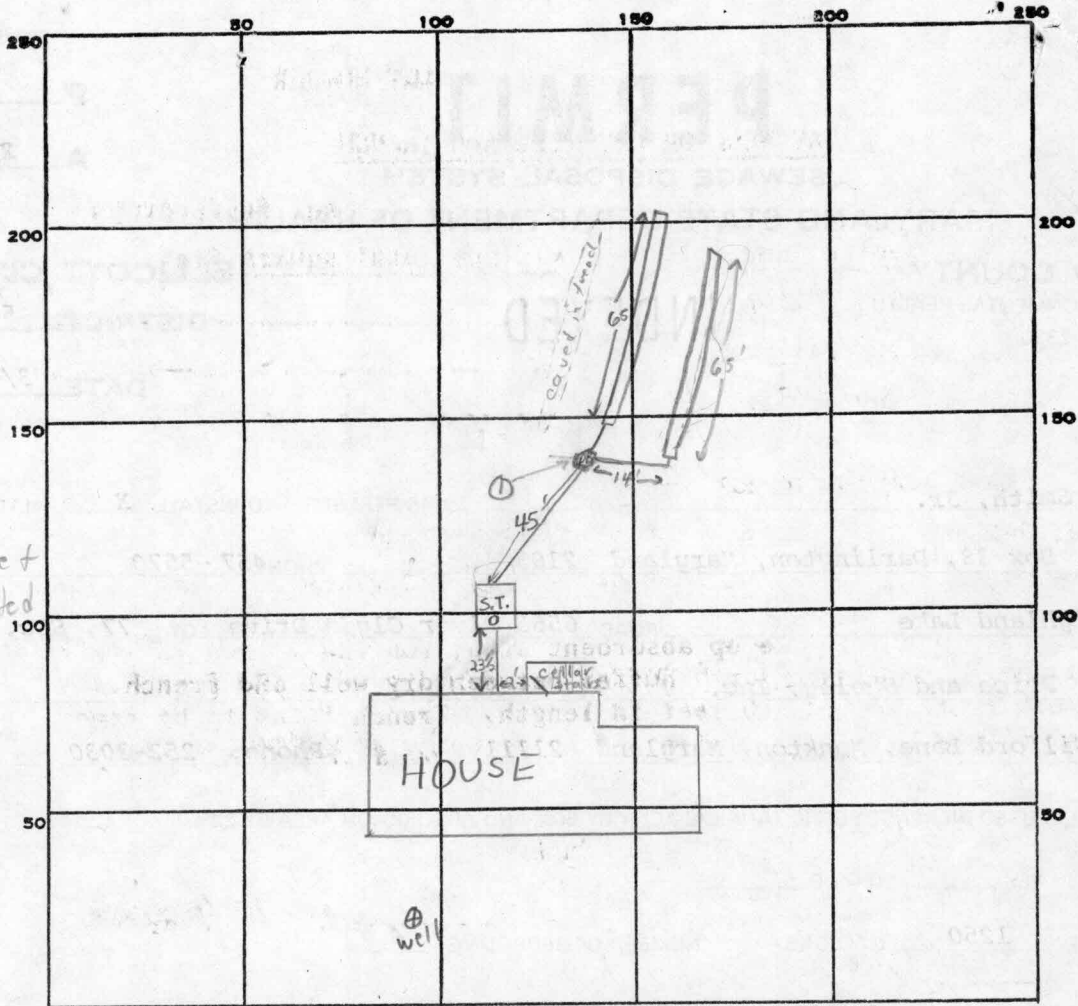

INDICATE NORTH. - NAME ADJOINING ROADWAY AS BASE LINE.

River Clyde Dr.

PERMIT CARD \_\_\_\_\_

SEPTIC TANK, LEVEL ✓ 1500 gallon

CLEANOUTS OK trench n.a.

DISTRIBUTION BOX, LEVEL ✓

TILE FIELD, DEPTH 9-11 FT. TRENCH WIDTH 2 FT.

GRAVEL DEPTH 5 FT. TOTAL LENGTH 130 FT.

NUMBER OF TRENCHES 2 ONE SIDEWALL TOTAL BOTTOM AREA ±650

SEEPAGE PITS, INSIDE DIAMETER \_\_\_\_\_ FT. DEPTH BELOW INLET 5 FT.

ABSORBENT AREA ±650 SQ. FT.

REMARKS 3/19/84 Trench coring, gas OK to dig new lower trench & gravel as trench in dug. F.S.

3/19/84 Trench #1 complete OK to continue F.S.

3/20/84

F. Skinner