

Total linear feet of trench
required 240 feet

Width of trench(es) 3.0 feet

Depth of trench 5.0 feet


Depth of stone required below
distribution pipe 2.0 feet

Approved Septic System Plan
Howard County Health Department

Signature

Date

* Maintain 1-2% fall in
septic line 10 feet
prior to septic
tank *

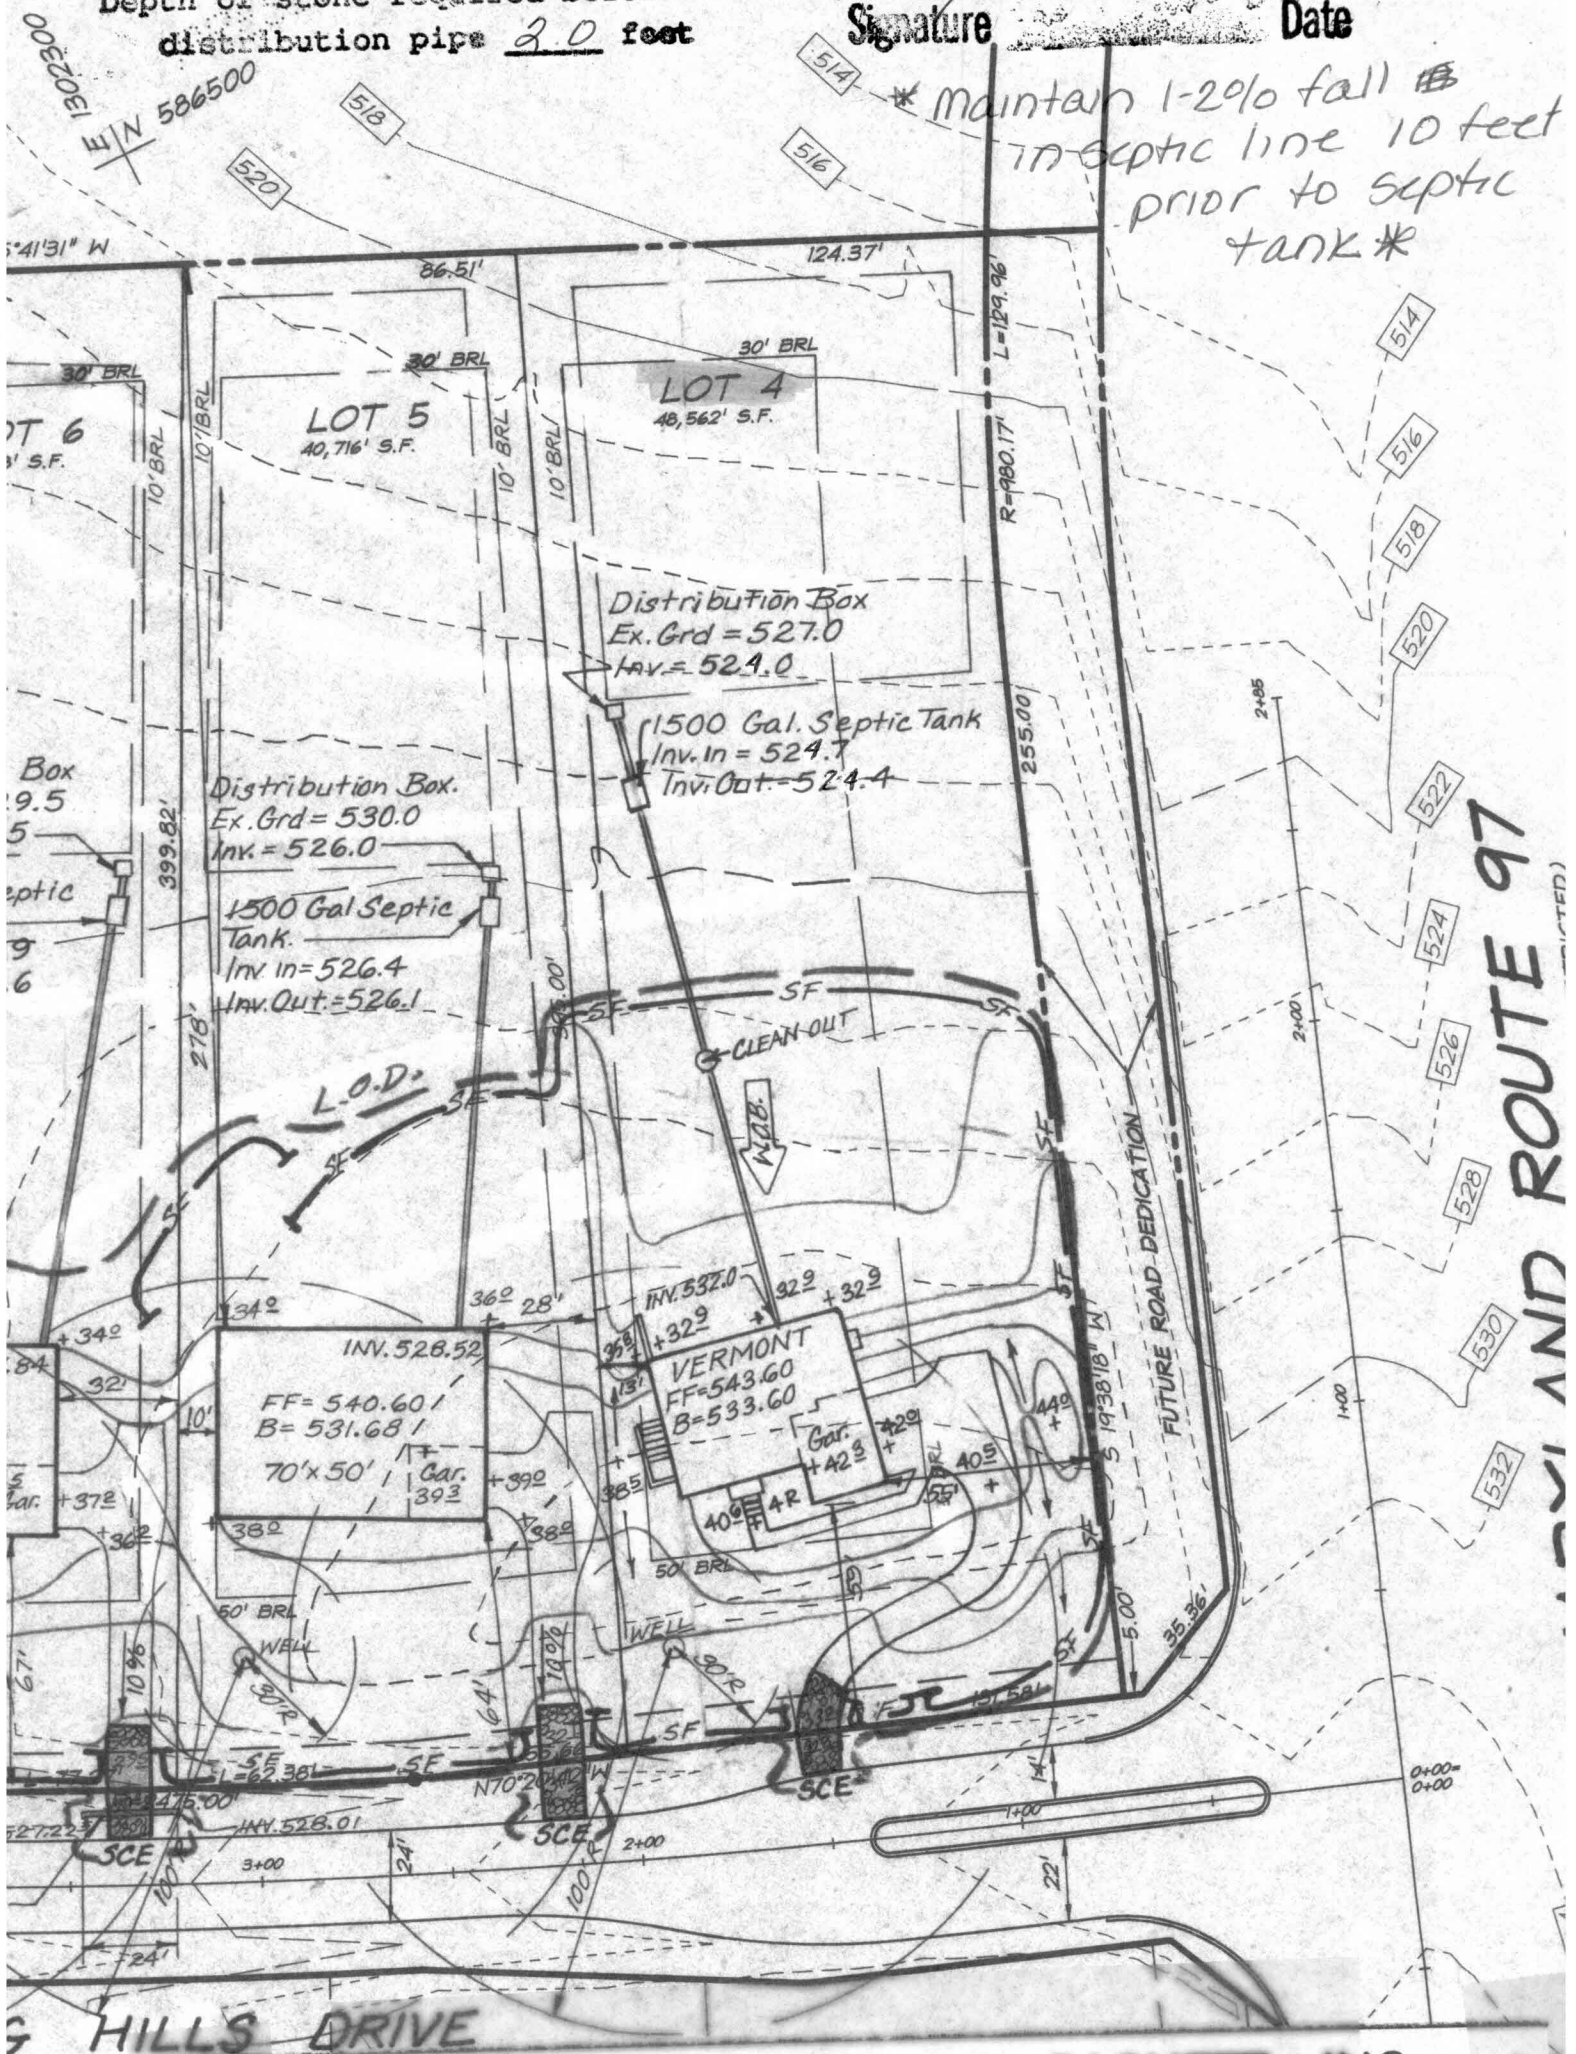

CLARK • FINEFROCK & SACKETT, INC.
ENGINEERS • PLANNERS • SURVEYORS

7135 MINSTREL WAY • COLUMBIA, MD 21045 • (410) 381-7500 BALT. • (301) 621-8100 WASH.