

4/7/01 layout 10:00

5/1/01 Final pm & WPI

01-364252

PERMIT
SEWAGE DISPOSAL SYSTEM
HOWARD COUNTY HEALTH DEPARTMENT
BUREAU OF ENVIRONMENTAL HEALTH
410-313-2640

P 514988-F
A 58993-D
ISSUE DATE 3/19/2001
APPROVAL DATE 5/1/01

INDEXED

Hatfields Equipment IS PERMITTED TO INSTALL X ALTER

ADDRESS 13785 Burntwoods Road, Glenelg, MD 21737 PHONE 301-854-6172
SUBDIVISION Cattail Ridge LOT NUMBER 4 ADDRESS 15004 Rolling Hills Drive
PROPERTY OWNER Syndacom Property PROPERTY OWNER'S ADDRESS 8808 Center Park Drive
SEPTIC TANK CAPACITY 1250 GALLONS Columbia, MD 21045
PUMP CHAMBER CAPACITY N/A GALLONS
NUMBER OF BEDROOMS 4
SQUARE FEET PER BEDROOM 210
LINEAR FEET OF TRENCH REQUIRED ~~230~~ 210'

TRENCHES: Trenches to be 2.0' feet wide. Inlet 3.0 feet below original grade. Bottom maximum depth
7.0' 5.0' feet below original grade. 2.0 feet of stone below distribution box.
LOCATION: Begin trenches 295 feet off the front lot line and 15 feet off the left lot
line as seen when facing the lot from Rolling Hills Drive. Run trenches on
contour toward Route 97.

PLANS APPROVED Amy Mc Millen OK SRK 12/22/00 DATE 6/9/00


PERMIT VOID AFTER 2 YEARS

- NOTE: CONTRACTOR RESPONSIBLE FOR SCHEDULING A PRE-CONSTRUCTION INSPECTION FOR ALL INSTALLATIONS
- NOTE: TOP OF SEPTIC TANKS ARE TO BE NO DEEPER THAN 3.0 FEET BELOW FINISH GRADE
- NOTE: WATERTIGHT SEPTIC TANKS REQUIRED
- NOTE: CLEANOUT REQUIRED EVERY 70 FEET OF SEWER LINE AND/OR AT 90° SWEEPS IN LINES FROM HOUSE TO DRAIN FIELDS, 90° ELBOWS ARE NOT ACCEPTABLE
- NOTE: ALL PARTS OF SEPTIC SYSTEMS (I.E. TANK, DISTRIBUTION BOX, DRAINFIELDS) TO BE 100 FEET FROM ANY WATER WELL UNLESS OTHERWISE SPECIFICALLY AUTHORIZED
- NOTE: NO ABSORPTION TRENCH TO EXCEED 100 FEET IN LENGTH UNLESS SPECIFICALLY AUTHORIZED
- NOTE: ALL PIPE FROM HOUSE TO SEPTIC TANK MUST BE CAST IRON OR SCHEDULE 35/40 PVC OR ABS
- NOTE: MANHOLE RISERS REQUIRED ON ALL SEPTIC TANKS AND PUMP CHAMBERS
- NOTE: DISTRIBUTION BOXES MUST HAVE BAFFLES
- NOTE: IF PUMPED SEPTIC SYSTEM REQUIRED, (1) SEPTIC PUMP DETAIL TO BE PROVIDED BY INSTALLER PRIOR TO ISSUANCE OF SEPTIC PERMIT (2) PUMP PERFORMANCE TEST IS NECESSARY PRIOR TO HEALTH DEPARTMENT APPROVAL OF SEPTIC PERMIT

BUILDING PERMIT SIGNED AND RETURNED
6/29/02
BOOK 130701
LO PICKET FENCE
BOOK 137202 - DECK
1-001108-1

NEITHER THE HOWARD COUNTY COUNCIL NOR THE HEALTH DEPARTMENT IS RESPONSIBLE FOR THE
SUCCESSFUL OPERATION OF ANY SYSTEM
PERMITTEE RESPONSIBLE FOR OBTAINING FINAL APPROVAL ON THIS PERMIT
CALL 410-313-2640 FOR INSPECTION OF SEPTIC SYSTEM

NOT TO SCALE

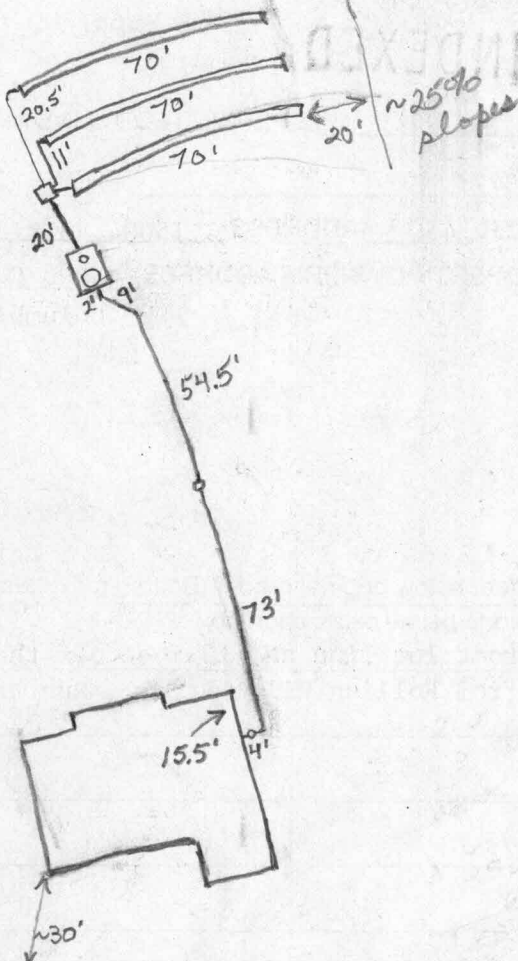

TRENCH DATA

TRENCH WIDTH 2'
TRENCH INLET DEPTH 3'
TRENCH BOTTOM DEPTH 7'
DEPTH OF STONE 4'
NUMBER OF TRENCHES 3
TOTAL TRENCH LENGTH 210'
ABSORBENT AREA 840 sq ft
DISTRIBUTION BOX LEVEL Yes
BAFFLE IN DISTRIBUTION BOX Yes

SEPTIC TANK DATA

SEPTIC TANK 1500 TS GALLONS
MANHOLE RISER Yes
6 INCH INSPECTION PORT Yes

PUMP CHAMBER DATA

PUMP CHAMBER GALLONS N/A
MANHOLE RISER N/A
ALARM N/A
PUMP PERFORMANCE TEST N/A

PRE-CONSTRUCTION INSPECTION:

Rolling Hills Drive

4/30/01 To install 3-70' trenches. Keep 25' from dropoff. Inlet 3', bottom 7', trenches 2' wide. (BB)

INSPECTION COMMENTS: 5/1/01 System satisfactory. O.K. to cover. Because trenches shortened closest trench is around 20' from 25% slope. With future repairs trenches may be put closer to slope as it diminishes the further downhill you go. (BB)

INSPECTOR

B. Baker

DATE SYSTEM APPROVED

5/1/01