

LAYOUT _____ INSP 4 _____
INSP 2 _____ INSP 5 _____
INSP 3 _____ INSP 6 _____

ISSUE DATE: 2/23/05

APPROVAL DATE: 3/4/05

P 522001

A 520098

PERMIT

INDEXED

TAX ID #03-284980

**ON-SITE SEWAGE DISPOSAL SYSTEM
HOWARD COUNTY HEALTH DEPARTMENT
BUREAU OF ENVIRONMENTAL HEALTH**

Jenkins Bros. Septic Svc Inc. IS PERMITTED TO INSTALL ☒ ALTER ☐

ADDRESS: 7670 Smith's Private Rd., Sykesville 21784 PHONE NUMBER: 410-461-9282

SUBDIVISION: _____ LOT NUMBER: _____

ADDRESS: 14110 Rover Mill Road PROPERTY OWNER: Victor Screbracmy

SEPTIC TANK CAPACITY (GALLONS): 1250 OUTLET BAFFLE FILTER REQUIRED ☐

PUMP CHAMBER CAPACITY (GALLONS): _____ COMPARTMENTED TANK REQUIRED ☒

NUMBER OF BEDROOMS: 4

SQUARE FEET PER BEDROOM: _____

LINEAR FEET OF TRENCH REQUIRED: _____ HOUSE SERVED BY PUBLIC WATER ☐

TRENCHES:	
LOCATION:	Septic tank to be upgraded to 1250 gallon tank, pump and collapse old tank.
NOTES:	Purpose of this permit is to support a building permit B00152258

PLANS APPROVED: Kevin J. Bell Reviewed by: _____ DATE: _____

NOTES: PERMIT VOID AFTER 2 YEARS
CONTRACTOR IS RESPONSIBLE FOR SCHEDULING A PRE-CONSTRUCTION INSPECTION FOR ALL INSTALLATIONS
WATERTIGHT SEPTIC TANKS REQUIRED
ALL PARTS OF SEPTIC SYSTEM SHALL BE 100 FEET FROM ANY WATER WELL UNLESS SPECIFICALLY AUTHORIZED
MANHOLE RISERS REQUIRED ON ALL SEPTIC TANKS AND PUMP CHAMBERS UNLESS SPECIFICALLY AUTHORIZED
CONTRACTOR RESPONSIBLE FOR COMPLIANCE WITH APPLICABLE REGULATIONS, GUIDELINES AND THE TERMS OF THIS PERMIT

**NEITHER THE HOWARD COUNTY COUNCIL NOR THE HEALTH DEPARTMENT IS
RESPONSIBLE FOR THE SUCCESSFUL OPERATION OF ANY SYSTEM
PERMITTEE RESPONSIBLE FOR OBTAINING FINAL APPROVAL ON THIS PERMIT
ALL 410-313-2640 FOR INSPECTION OF SEPTIC SYSTEM**


BUILDING PERMIT SIGNED

AND RETURNED

3/4/05 B00152258 IN-LAW APARTMENT
9/29/05 B00156267-IGPOOL

520098

NOT TO SCALE

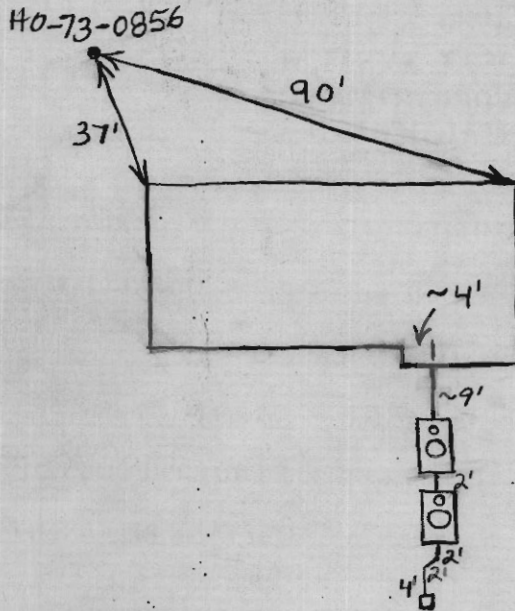

Rover Mill Road

ROAD

TRENCH/DRAINFIELD DATA

WIDTH INLET BOTTOM

NUMBER OF TRENCHES

TOTAL LENGTH

ABSORPTION AREA

DISTRIBUTION BOX LEVEL

DISTRIBUTION BOX BAFFLE

DISTRIBUTION BOX PORT

SEPTIC TANK DATA

SEPTIC TANK 1 LEVEL Yes

CAPACITY Top GAL

SEAM LOC Top

TANK LID DEPTH 1'-1.5'

BAFFLES Yes

BAFFLE FILTER No

MANHOLE LOC Middle

6" PORT LOC Front

WATERTIGHT TEST No

SEPTIC TANK 2 LEVEL

CAPACITY GAL

SEAM LOC

TANK LID DEPTH

BAFFLES

BAFFLE FILTER

MANHOLE LOC

6" PORT LOC

WATERTIGHT TEST

PRE-CONSTRUCTION

INSTALLATION 3/4/05 1250 gallon septic tank connected to existing 1000 gallon concrete tank BB

FINAL INSPECTOR B. Baker

DATE OF APPROVAL 3/4/05