

out in triplicate.
Make \$15.00 check payable to
Howard County Health Dept. - Sanitation

APPLICATION

SEWAGE DISPOSAL TESTING

MARYLAND STATE DEPARTMENT OF HEALTH

HOWARD COUNTY

ELLICOTT CITY

DISTRICT

DATE 8/8/69

Septic Tank - 750 gal.
Dry Well - 300 sq ft absorbent sidewalk area
to begin below the first 4 ft of
original soil. Maximum depth
permitted for dry well is 11 ft below original grade.
Locate dry 249 ft. from rear property line and
43 ft from left side line as seen from
Roxbury Road.

TO: THE COUNTY HEALTH OFFICER
ELLICOTT CITY, MARYLAND

I, HEREBY, APPLY FOR THE NECESSARY TESTS IN ORDER TO CONSTRUCT (OR RECONSTRUCT) A SEWAGE DISPOSAL SYSTEM.

PROPERTY OWNER Ruth Despopoulos (to be conveyed to Mr. and Mrs. Ronald Newman)
Wheaton, Md.)

ADDRESS 2926 La Camila N.E. Albuquerque, New Mexico
AGENTS Breckinridge and Hanna, Realtors PHONE 465-2544

PROPERTY LOCATION:

SUBDIVISION Glenelg LOT NO. Liber #364/523

ROAD AND DESCRIPTION South side of Roxbury Road nr. Triadelphia Rd.

A five acre lot with a frontage on the road of 200' clear, rolling

OCCUPANT none PHONE _____

PERSON TO CONSTRUCT SYSTEM _____

ADDRESS _____ PHONE _____

SIZE OF LOT five acres TYPE BLDG. three bedrooms
one story with basement
NUMBER OF BEDROOMS _____

IF NOT SINGLE RESIDENCE DESCRIBE _____

SIGNATURE OF APPLICANT Constance D. Scholl


APPROVED BY R. Tane FOR Dry Well DATE 9/29/69
(KIND OF SYSTEM)

REJECTED BY _____ FOR _____ DATE _____
(KIND OF SYSTEM)

HOLD PENDING FURTHER TESTS _____ DATE _____

REASONS FOR REJECTION OR HOLDING _____

THIS IS NOT A PERMIT

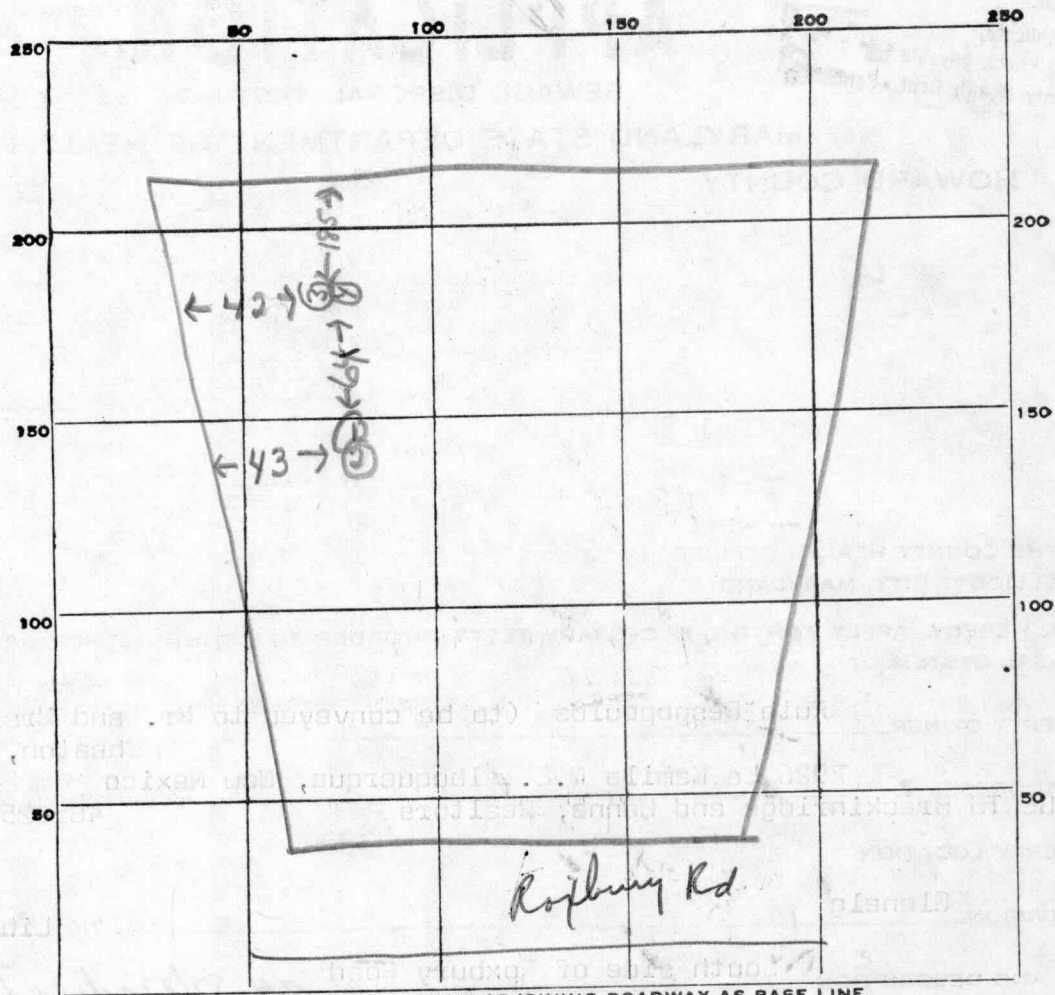

DATE	TEST NO.	DEPTH	PRE-WET		TEST - 1" DROP		TIME
			START	STOP	START	STOP	
9/24/69	1	10 ft.	945	948	948	955	7 min
	2	4 ft.	949	954	954	1005	11 min
	3	9 1/2 ft.	955	957	957	1101	4 min
	4	4 ft.	956	1003	1003	1018	15 min
8/22/78	5	13	VISUAL				

PROFILE
 4' - CLAY-SAND
 4' - 13'
 CLAY, MICA
 SAND

SOIL AUGER FINDING _____

TESTED BY B. Tone

REMARKS _____

JS
 8/22/78

APPLICATION

SEWAGE DISPOSAL TESTING

MARYLAND STATE DEPARTMENT OF HEALTH

HOWARD COUNTY

ELLICOTT CITY

DISTRICT

DATE 8/8/69

400 Septic Tank - 450 gal
Dry Well - 300 sq ft. absorbent sidewall area

to begin below the first 4 ft of original soil. Maximum depth permitted for dry well is 11 ft. below original grade. Locate dry 24 ft. from rear property line and 43 ft from left side line as seen from Roxbury Road.

TO: THE COUNTY HEALTH OFFICER
ELLICOTT CITY, MARYLAND

I, HEREBY, APPLY FOR THE NECESSARY TESTS IN ORDER TO CONSTRUCT (OR RECONSTRUCT) A SEWAGE DISPOSAL SYSTEM.

PROPERTY OWNER Ruth Despopoulos (to be conveyed to Mr. and Mrs. Ronald Newman)
Wheaton, Md.)

ADDRESS 2926 La Camila N.E. Albuquerque, New Mexico
AGENTS Breckinridge and Hanna, Realtors PHONE 465-2544

PROPERTY LOCATION:

SUBDIVISION Glenelg LOT NO. Liber #364/523

ROAD AND DESCRIPTION South side of Roxbury Road vs. Philadelphia Rd.

A five acre lot with a frontage on the road of 200' clear, rolling

OCCUPANT none PHONE

PERSON TO CONSTRUCT SYSTEM

ADDRESS PHONE

SIZE OF LOT five acres TYPE BLDG. three bedrooms
one story with basement

IF NOT SINGLE RESIDENCE DESCRIBE

SIGNATURE OF APPLICANT Constance D. Schell


APPROVED BY R. Tane FOR Dry Well DATE 9/29/69

REJECTED BY FOR DATE

HOLD PENDING FURTHER TESTS DATE

REASONS FOR REJECTION OR HOLDING

THIS IS NOT A PERMIT

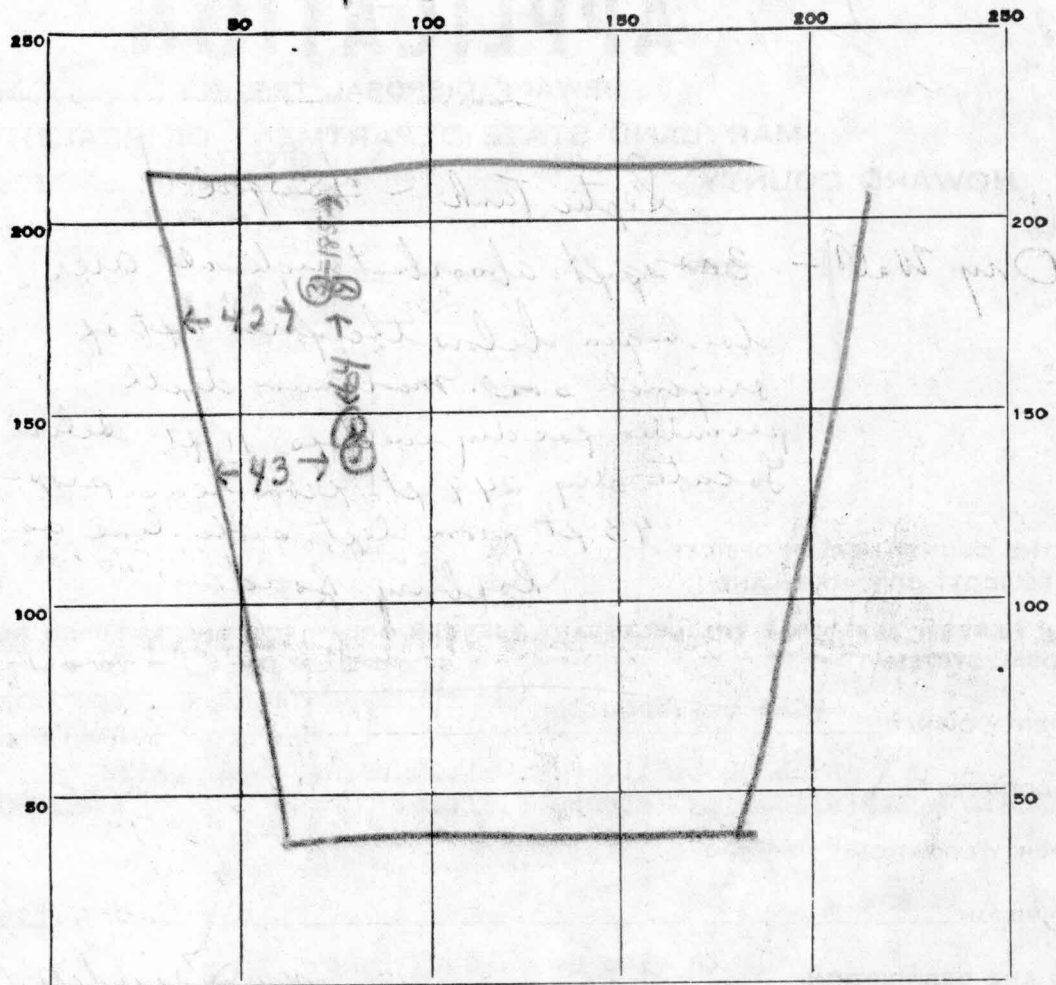

INDICATE NORTH. - NAME ADJOINING ROADWAY AS BASE LINE.

DATE	TEST NO.	DEPTH	PRE-WET		TEST - 1" DROP		TIME
			START	STOP	START	STOP	
9/27/69	1	10 ft	9 ⁴⁵	9 ⁴⁸	9 ⁴⁸	9 ⁵⁵	7 min
	2	4 ft	9 ⁴⁹	9 ⁵⁴	9 ⁵⁷	10 ⁰⁵	11 min
	3	9 1/2 ft	9 ⁵⁵	9 ⁵⁷	9 ⁵⁷	11 ⁰¹	4 min
	4	4 ft	9 ⁵⁶	10 ⁰³	10 ⁰³	10 ¹⁸	15 min


SOIL AUGER FINDING

TESTED BY

P. Toner

REMARKS

Roxbury Rd.

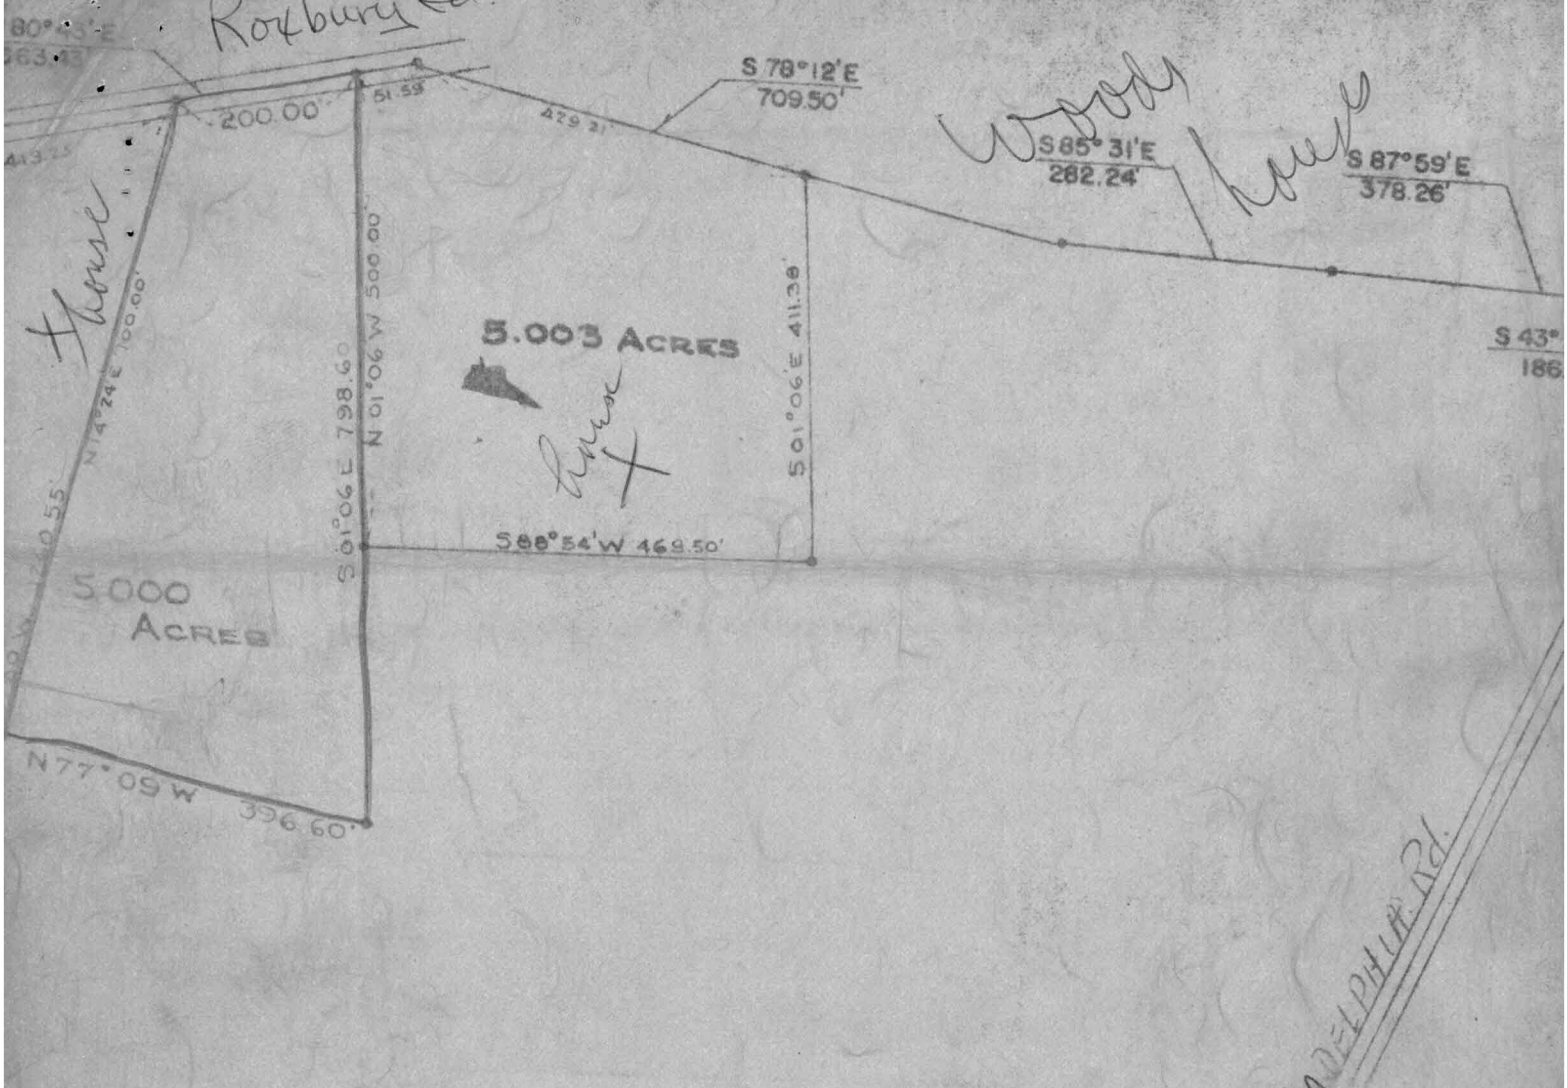

PLAT OF SURVEY
OF
JAMES J. CONROY FARM
GLENWOOD, MARYLAND
SCALE: 1 IN. = 200 FT. JULY 1956

Claude M. Skinner, Jr.
CLAUDE M. SKINNER JR. REG. ENGINEER NO. 2237

Guy C. Sykes
GUY C. SYKES REG. ENGINEER AND LAND SURVEYOR NO. 1273

REVISION NOTE
Plat revised to show land conveyed out
or under contract of sale.

Claude M. Skinner, Jr.

REVISION NOTE
Plat revised to show 10.714 Acre Lot &
J Young's 10 Acre lot. 2/4/58

Claude M. Skinner, Jr.

FILE NO.