

C1 0170 SEQUENCE NO. (MDE USE ONLY)

STATE OF MARYLAND
WELL COMPLETION REPORT
FILL IN THIS FORM COMPLETELY
PLEASE TYPE

THIS REPORT MUST BE SUBMITTED WITHIN
45 DAYS AFTER WELL IS COMPLETED.

COUNTY NUMBER 13 A 517904

1 2 3 6
(THIS NUMBER IS TO BE PUNCHED
IN COLS. 3-6 ON ALL CARDS)

ST/CO USE ONLY

DATE Received
MM DD YY

DATE WELL COMPLETED

MM DD YY
02 08 06

Depth of Well

22 150 26
(TO NEAREST FOOT)

PERMIT NO.
FROM "PERMIT TO DRILL WELL"

H0 - 95 - 0199
28 29 30 31 32 33 34 35 36 37

OWNER Selfridge Builders
STREET OR RFD Roxbury Meadow Drive first name TOWN Glenelg
SUBDIVISION Clarks Meadow SECTION LOT 18

WELL LOG

Not required for driven wells

STATE THE KIND OF FORMATIONS PENETRATED, THEIR
COLOR, DEPTH, THICKNESS AND IF WATER BEARING

DESCRIPTION (Use additional sheets if needed)	FEET		check if water bearing
	FROM	TO	
Top Soil	0	2	
Sandy	2	50	✓
Sand Stone	50	55	
MICKA	55	90	
Sand Stone	90	95	✓
MICKA	95	180	

GROUTING RECORD

yes no

WELL HAS BEEN GROUTED
(Circle Appropriate Box)

Y N
44 44

TYPE OF GROUTING MATERIAL (Circle one)

CEMENT CM BENTONITE CLAY BC

NO. OF BAGS 16 NO. OF POUNDS 1600

GALLONS OF WATER 96

DEPTH OF GROUT SEAL (to nearest foot)

from 0 ft. to 30 ft.
48 TOP 52 ft. 54 BOTTOM 58 ft.
(enter 0 if from surface)

CASING RECORD

casing
types
insert
appropriate
code
below

ST
STEEL

CO
CONCRETE

PL
PLASTIC

OT
OTHER

MAIN CASING TYPE PL
Nominal diameter top (main) casing (nearest inch) 6
Total depth of main casing (nearest foot) 65
60 61 63 64 66 70

OTHER CASING (if used)
EACH CASING diameter inch depth (feet) from to

SCREEN RECORD

screen type
or open hole
insert
appropriate
code
below

ST
STEEL

BR
BRASS

HO
OPEN HOLE

PL
PLASTIC

OT
OTHER

C 2 DEPTH (nearest ft.)

1 2
H0 63 180
E 1 8 9 11 15 17 21
A 2 23 24 26 30 32 36
C 3 38 39 41 45 47 51
R
E
N
SLOT SIZE 1 2 3

DIAMETER OF SCREEN (NEAREST INCH)
56 60
from to

GRAVEL PACK IF WELL DRILLED WAS FLOWING WELL INSERT F IN BOX 68 66

MDE USE ONLY (NOT TO BE FILLED IN BY DRILLER)

T (E.R.O.S.) W Q

70 72 74 75 76
TELESCOPE CASING LOG INDICATOR OTHER DATA

C 3

1 2

PUMPING TEST

HOURS PUMPED (nearest hour) 3

PUMPING RATE (gal. per min.) 8.5

METHOD USED TO MEASURE PUMPING RATE Bucket

WATER LEVEL (distance from land surface)

BEFORE PUMPING 15 ft.

WHEN PUMPING 44 ft.

TYPE OF PUMP USED (for test)

A air P piston T turbine

C centrifugal R rotary O other (describe below)

J jet S submersible

PUMP INSTALLED

DRILLER INSTALLED PUMP (CIRCLE) (YES OR NO) YES NO

IF DRILLER INSTALLS PUMP, THIS SECTION
MUST BE COMPLETED FOR ALL WELLS.

TYPE OF PUMP INSTALLED
PLACE (A,C,J,P,R,S,T,O)
IN BOX 29. 29

CAPACITY:
GALLONS PER MINUTE
(to nearest gallon) 31 35

PUMP HORSE POWER 37 41

PUMP COLUMN LENGTH (nearest ft.) 43 47

CASING HEIGHT (circle appropriate box and enter casing height)


+ above

LAND SURFACE

- below 2 (nearest foot)

49 50 51

LOCATION OF WELL ON LOT
SHOW PERMANENT STRUCTURE SUCH AS
BUILDING, SEPTIC TANKS, AND /OR
LANDMARKS AND INDICATE NOT LESS
THAN TWO DISTANCES
(MEASUREMENTS TO WELL)

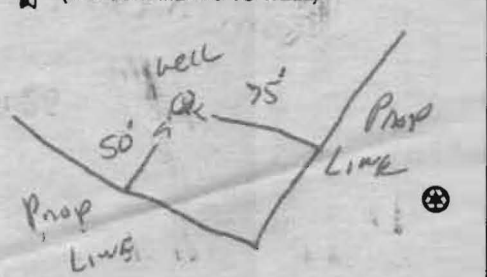

NUMBER OF UNSUCCESSFUL WELLS: 0

WELL HYDROFRACTURED yes no
Y N

CIRCLE APPROPRIATE LETTER

- A A WELL WAS ABANDONED AND SEALED WHEN THIS WELL WAS COMPLETED
- E ELECTRIC LOG OBTAINED
- P TEST WELL CONVERTED TO PRODUCTION WELL



I HEREBY CERTIFY THAT THIS WELL HAS BEEN CONSTRUCTED IN
ACCORDANCE WITH COMAR 26.04.04 "WELL CONSTRUCTION" AND
IN CONFORMANCE WITH ALL CONDITIONS STATED IN THE ABOVE
CAPTIONED PERMIT, AND THAT THE INFORMATION PRESENTED
HEREIN IS ACCURATE AND COMPLETE TO THE BEST OF MY
KNOWLEDGE.

DRILLERS LIC. NO. 1 M S D 117

DRILLERS SIGNATURE
(MUST MATCH SIGNATURE ON APPLICATION)

LIC. NO. 1 D

SITE SUPERVISOR (sign. of driller or journeyman
responsible for sitework if different from permittee)

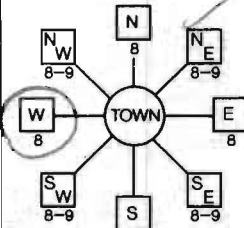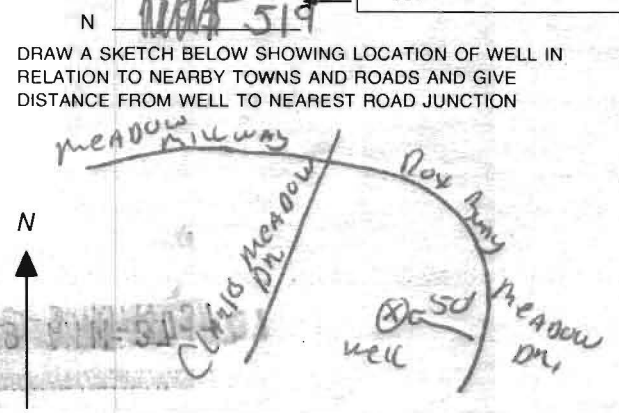B 1 1 2 3 6	0908	SEQUENCE NO. (MDE USE ONLY)	STATE OF MARYLAND APPLICATION FOR PERMIT TO DRILL WELL 523626 please type	STATE PERMIT NUMBER HO-95-0199 70 fill in this form completely 79
Date Received (APA) 11/9/05 8 MM DD YY 13 Selfridge Builders 15 Last Name Owner First Name 34 14045 GARED DRIVE 36 Street or RFD 55 Glenwood MD 21738 57 Town 70 State 72 Zip 76		B 3 LOCATION OF WELL 8 COUNTY Howard 21 clarks meadow 23 SUBDIVISION 42 SECTION 18 LOT 18 44 46 48 50 Glenelg 52 NEAREST TOWN 71 MILES FROM TOWN (enter 0 if in town) 1 M I 73 76 77 78		
DRILLER INFORMATION Ralph E. MAYNE M S D 117 Driller's Name 76 License No. 81 Ralph E. Mayne INC. Firm Name 17024 Hardy Rd. Mt. Airy MD. 21771 Address 234 E. V. Meyer 11-7-05 Signature Date		B 4 1 2 DIRECTION OF WELL FROM TOWN (CIRCLE BOX)  Roxbury meadow Dr. 11 NEAR WHAT ROAD 30 ON WHICH SIDE OF ROAD (CIRCLE APPROPRIATE BOX) NORTH ☒ WEST ☐ EAST ☐ SOUTH ☐ 34 50 37 DISTANCE FROM ROAD ft ENTER FT OR MI 38 39 TAX MAP: 21 BLK: 17 PARCEL 222		
B 2 WELL INFORMATION 1 2 APPROX. PUMPING RATE 5 (GAL. PER MIN.) 8 12 AVERAGE DAILY QUANTITY NEEDED 500 (GAL. PER DAY) 14 20		NOT TO BE FILLED IN BY DRILLER HEALTH DEPARTMENT APPROVAL HOWARD (13) A 517904 COUNTY NAME COUNTY NO. STATE SIGNATURE INSERT S → 41 DATE ISSUED 1/4/06 Salim A. Gughton 1/5/07 43 MM DD YY 48 CO SIGNATURE EXP. DATE NORTH GRID 519 0 0 0 EAST GRID 796 0 0 0 50 55 57 63		
USE FOR WATER (CIRCLE APPROPRIATE BOX) ☒ DOMESTIC POTABLE SUPPLY & RESIDENTIAL IRRIGATION ☐ FARMING (LIVESTOCK WATERING & AGRICULTURAL IRRIGATION) ☐ INDUSTRIAL, COMMERCIAL, DEWATERING ☐ PUBLIC WATER SUPPLY WELL ☐ TEST, OBSERVATION, MONITORING ☐ GEO-THERMAL		SHOW MAJOR FEATURES OF BOX & LOCATE WELL WITH AN X SOURCES OF DRILLING WATER 1. well 2. 3. WRITE THE BOX NUMBER FROM THE MAP HERE E 796 N 519 000 000		
APPROXIMATE DEPTH OF WELL 150' FEET 24 28 APPROXIMATE DIAMETER OF WELL 6" INCH NEAREST INCH		METHOD OF DRILLING (circle one) BORED (or Augered) JETTED Jetted & DRIVEN 30 AIR-ROTary AIR-PERCussion ROTARY (Hydraulic Rotary) 37 CABLE REVERSE-ROTary Drive-POINT other		
REPLACEMENT OR DEEPEMED WELLS (CIRCLE APPROPRIATE BOX) ☒ THIS WELL WILL NOT REPLACE AN EXISTING WELL ☐ THIS WELL WILL REPLACE A WELL THAT WILL BE ABANDONED AND SEALED 39 ☐ THIS WELL WILL REPLACE A WELL THAT WILL BE USED AS A STANDBY-CONTACT LOCAL APPROVING AUTHORITY FOR POLICY ON STANDBY WELLS ☐ THIS WELL WILL DEEPEAN AN EXISTING WELL PERMIT NUMBER OF WELL TO BE REPLACED OR DEEPEMED (IF AVAILABLE) 41 52		DRAW A SKETCH BELOW SHOWING LOCATION OF WELL IN RELATION TO NEARBY TOWNS AND ROADS AND GIVE DISTANCE FROM WELL TO NEAREST ROAD JUNCTION 		
Not to be filled in by driller (MDE OR COUNTY USE ONLY) APPROP. PERMIT NUMBER H 02003G016(01) PERMIT No. HO-95-0199 70 71 72 73 74 75 76 77 78 79				
SPECIAL CONDITIONS NOTE - APPROVING AUTHORITIES SHOULD USE SEPARATE SHEET IF NEEDED -				

FIELD DATA SHEET
HOWARD COUNTY WELL YIELD TEST

Well Permit No. HO - 95-0199
Location of property (road) Roxbury Meadow Drive (Off Dorsey Mill)
Subdivision Clarks Meadow Lot 18 Block Plat Sec.
Well Driller RALPH MAYNE Owner Selfridge

Depth of well 180
Distance of measuring point (M.P.) above ground 2 ft
Static water level (S.W.L.) below M.P. 15

I. High rate pumping -- reservoir drawdown

Time pump started 8:30 Pumping rate 15 GPM
Total time 15 min to reach pumping water level 44 ft. below M.P.

II. Recovery pump test data - observations to be recorded every 15 minutes

[illegible]

**HOWARD COUNTY HEALTH DEPARTMENT
BUREAU OF ENVIRONMENTAL HEALTH
WATER AND SEWERAGE PROGRAM
TEL: (410)313-2640 FAX: (410)313-2648**

Information Form for the Installation of the Well Pump, Pitless Adapter, and Supply Piping

NOTE: The installer is responsible for requesting an inspection prior to 9 am on the day of the desired inspection. No work is to be covered until approved by the Health Department. All installations must comply with the National Standard Plumbing Code (NSPC, as amended locally) and COMAR 26.04.04 (MD Well Construction Regulations). Submission of a complete form is required prior to Use and Occupancy approval.

Company Name: Burgemeister-Bell Inc. Telephone #: 410-363-0080
Address: 10731 South Delfield Road
Overlows Mills MD 21117

(Must circle one) Licensed Plumber Licensed Well Driller Licensed Well Pump Installer
License # and name of individual responsible for the field installation:

Name (Print): Roland H. Mann Jr. License# 6592

*A licensed individual must perform the actual installation. Apprentices must be under the direct supervision of a licensed journeyman or master plumber, pump installer or well driller. Licenses may be subjected to field verification.

Name of Property Owner: Douglas Homes Inc. Telephone #: 410-740-0522
Subdivision: Clarks Meadow Lot #: 18 Well Tag #: HO-93-0199
Site Address: 14314 Roxbury Meadow Drive
Glenwood MD 21738

<u>Submersible Pump Data</u>	<u>Pitless Adapter</u>	<u>Well Cap and Electric Conduit</u>
Make: <u>Goulds</u>	Make: <u>Campbell</u>	Two piece watertight cap: ☒
Model #: <u>5TB05422C</u>	Model #: <u>PA1806KI</u>	Screened, vented well cap: ☐
Pump Capacity: <u>5</u> GPM	Depth: <u>36"</u> (36" min)	Cap secured to casing: ☐
Well Yield: <u>8.5</u> GPM	NSF approved: ☒	Conduit min 18" B.G.: ☐

Depth of well encountered at time of pump installation: 180 (feet) Conduit secured to well cap: ☐

If pump capacity exceeds well yield, a low water cut off switch is required by NSPC 1990 Section 17.8.4

Torque arrestors or Cable guards are required - Must circle one

Safety rope, if used, attached to inside of well casing with eye bolt ☐

Piping to house

Type: 1" Poly
PSI: 200 (160 psi min)
Depth of supply line: ☒ (36" min)

House Connection

PVC sleeved to undisturbed soil at wall penetration: ☒
Approximate length of sleeve: 5
Sleeve caulked and sealed properly: ☒

The water supply line is required to be at least ten feet from the septic tank, pump chamber, sewage piping, distribution box, drainfields, and sewage reserve area. If this cannot be accomplished, contact this office for approval prior to installation.


Signature of company representative responsible for installation
Roland H. Mann Jr.




6.16.11
date

For Health Department Use Only - Not to be completed by Installer


Date Insp. Requested: 8/12/11 Date Insp. Approved: 8/12/11
Inspection Data: Pitless adapter and water supply line at least 36" below grade ☒
Two piece cap installed and attached to casing securely ☒
Elec. conduit extends at least 18" below grade/attached to cap properly ☒
Safety rope installed inside of well casing ☒
Correct well tag attached properly and casing 8" above finished grade ☒
Water supply line sleeved adequately at house connection ☒
Adequate grout observed below pitless adapter ☒

70" 6' from top of casing to pitless adapter down to start of grout
* 10' from top of pump well to sleeve

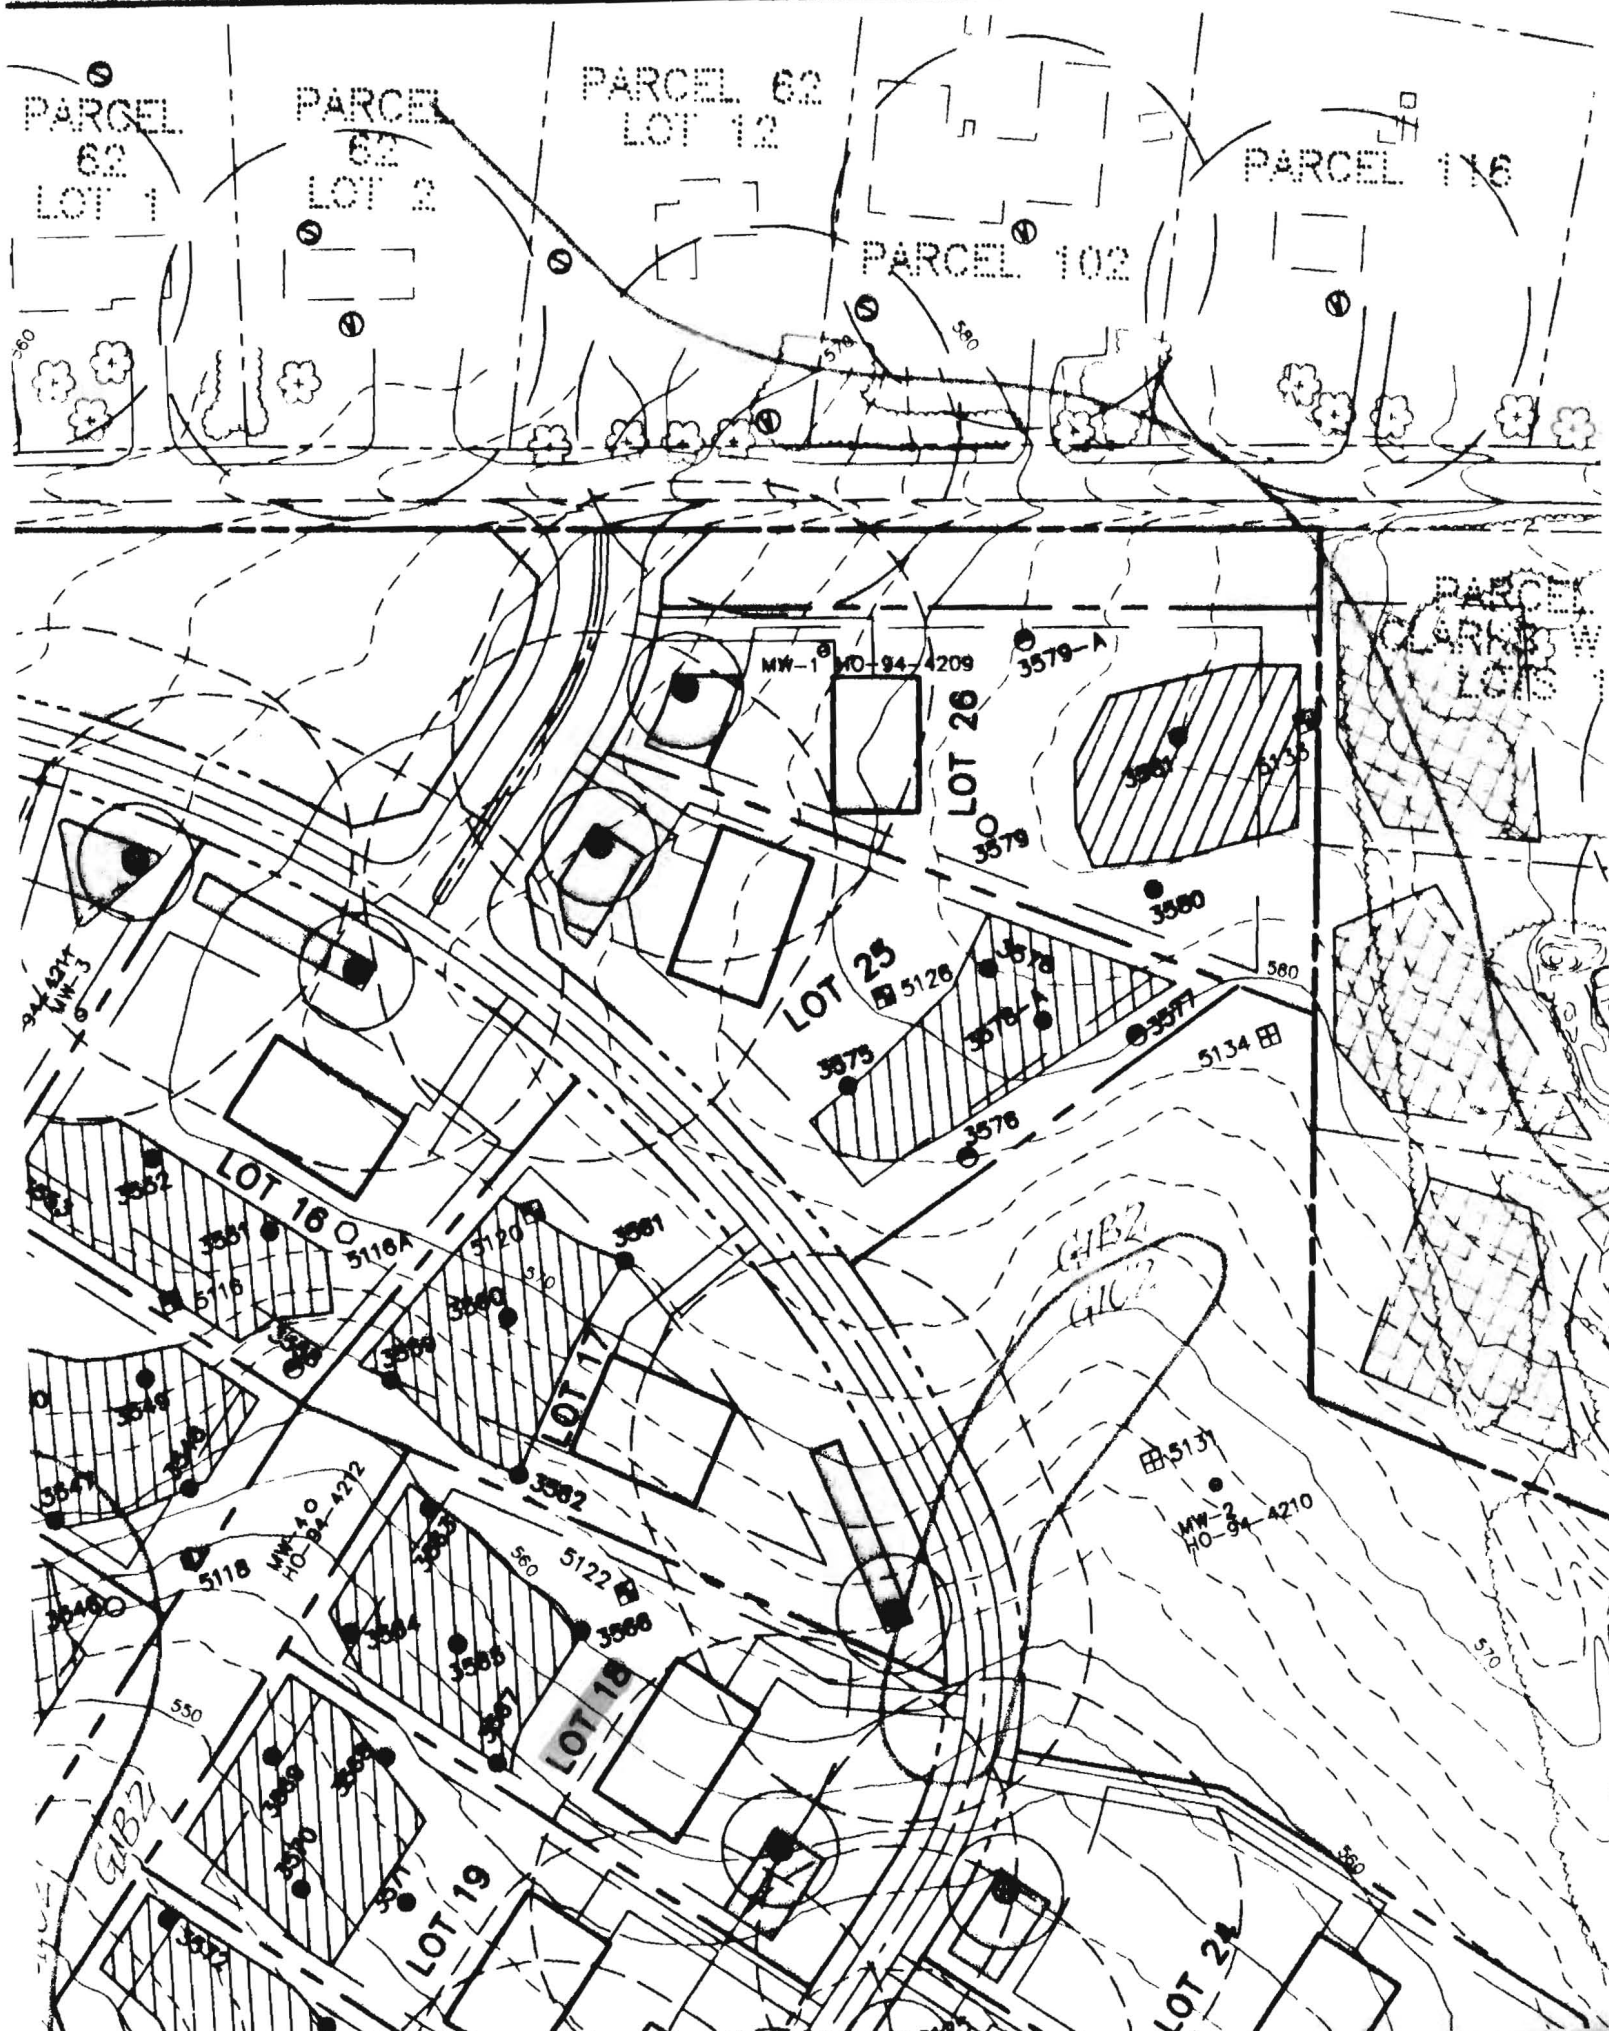

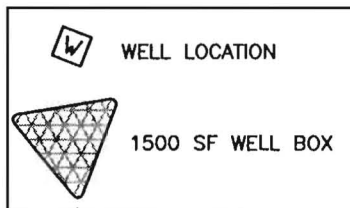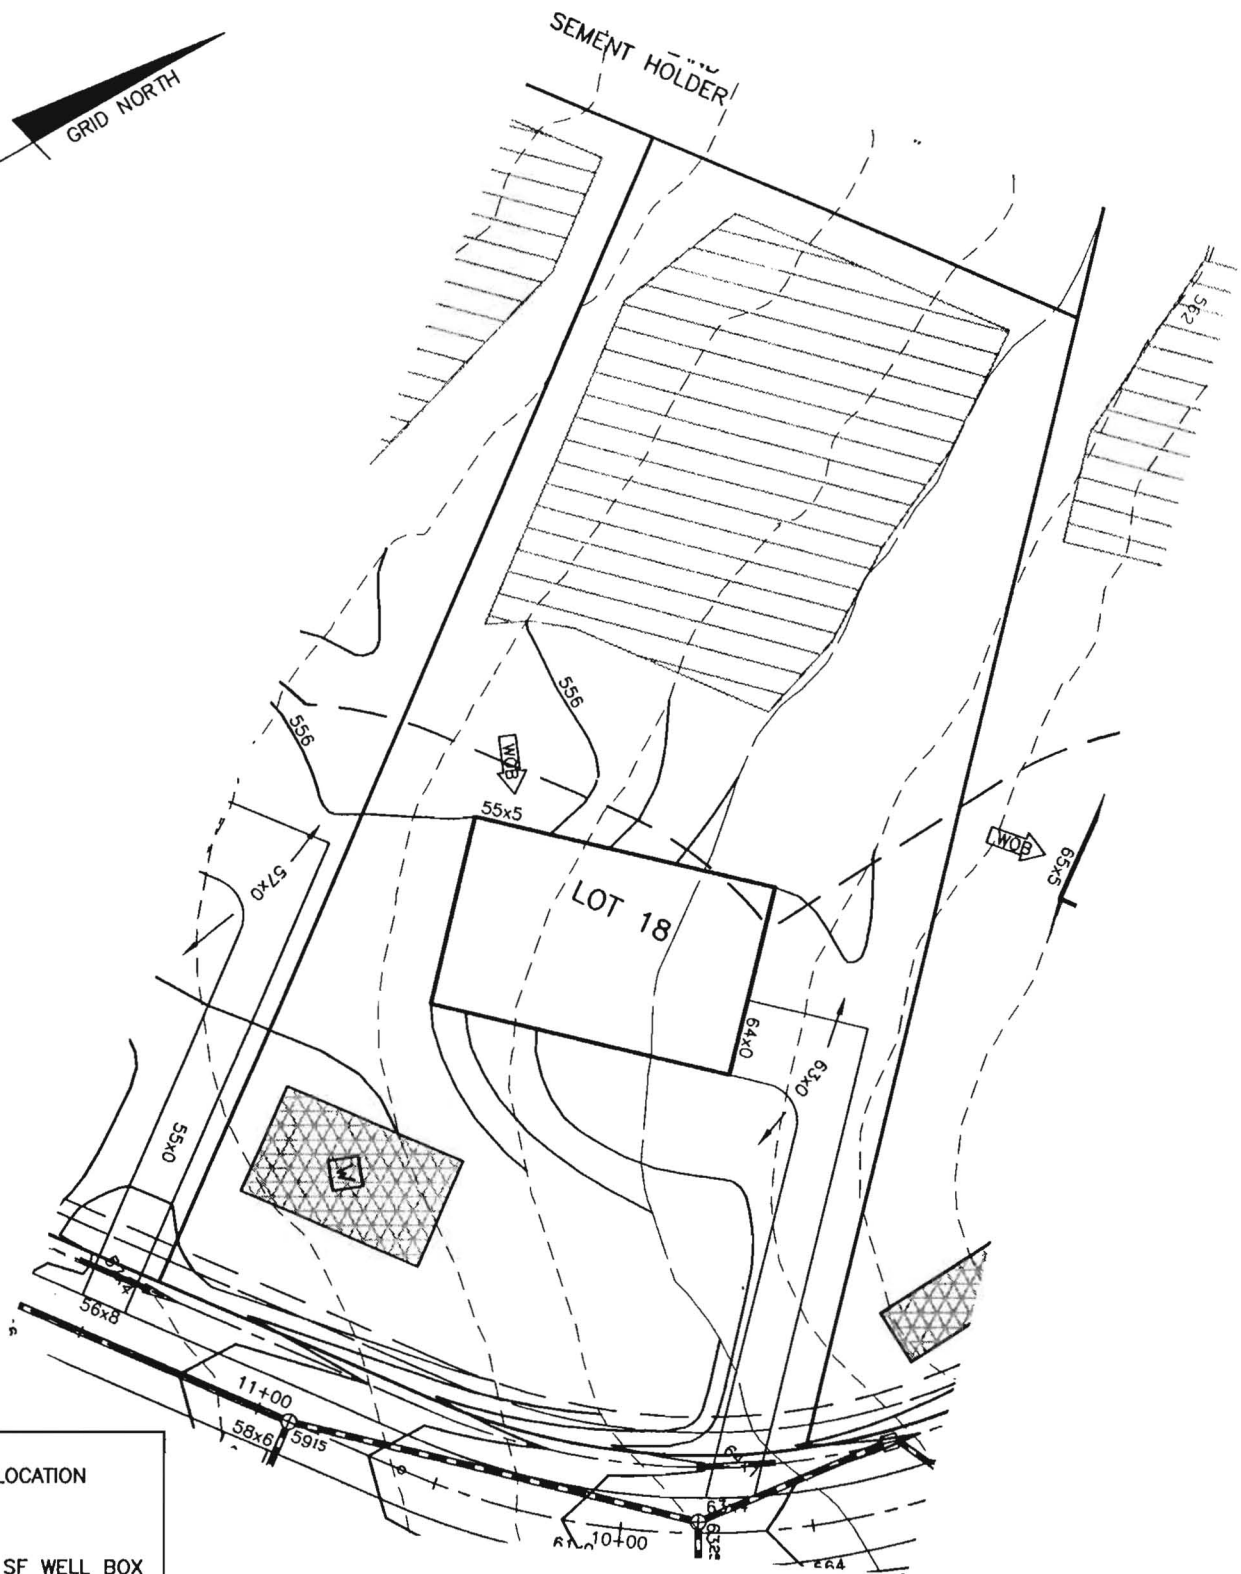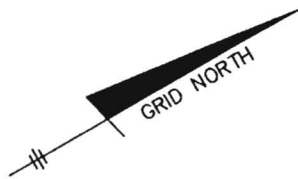

BENCHMARK

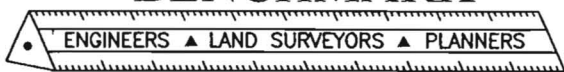

ENGINEERING, INC.

8480 BALTIMORE NATIONAL PIKE ▲ SUITE 418

ELLICOTT CITY, MARYLAND 21043

PHONE: 410-465-6105

FAX: 410-465-6644

P:\1736 Clark's Meadow\dwg\70 well permits.dwg, 10/24/2005 6:11:12 PM

CLARKS MEADOW


LOT 18

F-06-029

WELL PERMIT EXHIBIT

SCALE: 1" = 50'

DATE: 10-24-05

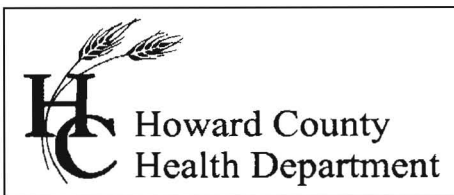

Bureau of Environmental Health
7178 Gateway Drive Columbia, MD 21046
(410) 313-2640 Fax (410) 313-2648
TDD (410) 313-2323 Toll Free 1-866-313-6300
website: www.hchealth.org

Peter L. Beilenson, M.D., M.P.H., Health Officer

INTERIM CERTIFICATE OF POTABILITY

Expiration Date – July 17th, 2012

January 17th, 2012

Homeowner
14314 Roxbury Meadow Dr.
Glenwood, MD 21738

**RE: Clarks Meadow, Lot 18
14314 Roxbury Meadow Dr.
Building Permit: B10003697
Well Permit: HO-95-0199**

Dear Homeowner:

This is to advise you that the septic system installation and water well construction for the above referenced property have been inspected and approved. Final approval of the septic system was granted on **8/12/11**. Final approval of the well line connection to the dwelling was granted on **8/12/11**. The well construction was completed on **2/8/06**. Water samples were collected on **1/11/12**.

The water sample results indicate that the water samples submitted for testing were free of coliform and fecal coliform bacteria at the time of sampling and are bacteriologically safe for drinking. This certifies that the initial sampling requirements of COMAR 26.04.04 "Well Regulations" have been met for the water supply system installed under well permit HO-95-0199. Although the submitted sample results are in compliance with COMAR standards, the Health Department does not guarantee water supplies.

This Interim Certificate of Potability will expire **six months** from the date of issuance. Submission of a second bacteriological test indicating the water is free of coliform and fecal coliform bacteria is required prior to the expiration date, after which time a Final Certificate of Potability will be issued. **Failure to submit an additional sample and obtain a Final Certificate of Potability will result in a Notice of Violation and is punishable as a misdemeanor under the Annotated Code of Maryland, Environment Article, 9-1311, subject to a fine of up to \$500 or imprisonment not to exceed three months.**

Please contact (410) 313-1773 to schedule a final water sample appointment or contact a Maryland certified water laboratory to schedule a water sample. A list of laboratories certified by the state of Maryland may be found at the following website:

<http://www.mde.state.md.us/assets/document/WSP-Labs-2010apr16.pdf>

Approving Authority,

Heidi Scott, R.S.
Environmental Sanitarian
Well & Septic Program

cc: Howard County Dept. of Inspections, Licenses, and Permits
Community Hygiene Program
File

Water Testing Laboratories

P.O. Box 712
Stevensville, MD 21666
410-643-7711

of Maryland, Inc.

Douglas Homes
5034 Dorsey Hall Drive
Suite 102
Ellicott City, MD 21042

Reporting Date: 1/13/2012
Report #: K7970

Submitted Sample Address: Clarks Meadow
14314 Roxbury Meadow Drive, Lot 18
Glenwood, MD 21738
Submitted Sample Source: Holding tank
Date / Time Collected: 1/11/2012 8:40 AM
Sample Type: Drinking Water
Sampler/Company: D. Pitts 4322DP, WTL of MD
Field Record: Chlorine residual: Absent Clear when drawn
Well #: HO-95-0199
Permit #: B10003697


Analytical Results

Parameter	Result	Units	Report Limit	MCL	Analytical Method
Total Coliforms	Absent	Coliforms/100 ml	Present/Absent	Present	SM 9223B
<i>E. Coli</i>	Absent	Coliforms/100 ml	Present/Absent	Present	SM 9223B
Nitrates + Nitrites	9.6	mg/L	1.0	10	EPA 353.2
Sand	Absent	P/A	Present/Absent	Present	Visual
Turbidity	1.2	NTU	0.5	10	SM 2130B
pH	6.5	SU	0.1	6.5-8.5 (SMCL)	SM 4500 H ⁺ B

Notes:

1. Bacteriological analysis of this sample indicates this water is for human consumption.
2. MCL is EPA's maximum contaminant level under primary drinking water regulations. SMCL is secondary maximum contaminant level and is the aesthetic quality only. If your result is above any MCL or SMCL, you may want to consider a water treatment system or a new well. Please check your local regulations for any restrictions or additional limits.
3. ND - Not Detected.
4. Sample received and examined within EPA's recommended holding time
5. Analyzed by Lab 214.
6. SM - Greenberg, Clesceri and Eaton, *Standard Methods for the Examination of Water and Wastewater*, 21st Ed.

Reported by,

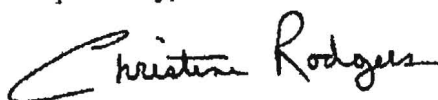

C. Rodgers, Customer Service Representative

Reviewed by: _____