

APPLICATION

PERCOLATION TESTING

A 517904

F _____

HOWARD COUNTY HEALTH DEPARTMENT

BUREAU OF ENVIRONMENTAL HEALTH

3525-H ELLICOTT MILLS DRIVE/ELLICOTT CITY, MARYLAND 21043
TELEPHONE: 313-2640

DISTRICT _____

DATE 9/5/02

TO: THE COUNTY HEALTH OFFICER
ELLICOTT CITY, MARYLAND

I HEREBY APPLY FOR THE NECESSARY TEST PRIOR TO APPLICATION FOR PERMIT TO CONSTRUCT (OR RECONSTRUCT) A SEWAGE DISPOSAL SYSTEM.

PROPERTY OWNER DORSEY MILL L.L.C.
ADDRESS 14045 GARET DRIVE PHONE 410-531-8950
GLENWOOD, MD 21738 FAX 410-531-8939

AGENT OR PROSPECTIVE BUYER _____

ADDRESS _____ PHONE _____

PROPERTY LOCATION:


SUBDIVISION DORSEY MILL ROAD LOT NO. _____

ROAD AND DESCRIPTION 14445 DORSEY MILL RD, GLENELG, MD 21737

TAX MAP 21 PARCEL # 227

SIZE OF LOT 53.87 AC. TYPE BLDG. SINGLE FAMILY DWELLING
(SINGLE FAMILY DWELLING OR COMMERCIAL)

THE SYSTEM INSTALLED UNDER THIS APPLICATION IS ACCEPTABLE ONLY UNTIL PUBLIC FACILITIES BECOME AVAILABLE. I FULLY UNDERSTAND THE
FEE CONNECTED WITH THE FILING OF THIS PERC TEST APPLICATION IS NON-REFUNDABLE UNDER ANY CIRCUMSTANCES. I ALSO AGREE TO
COMPLY WITH ALL M.O.S.H.A. REQUIREMENTS IN TESTING THIS LOT.

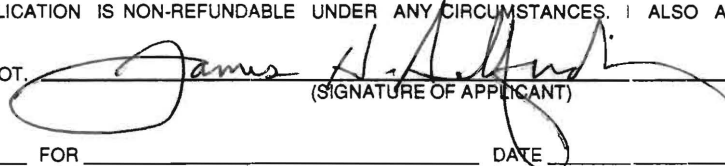
(SIGNATURE OF APPLICANT)

APPROVED BY _____ FOR _____ DATE _____

DISAPPROVED BY _____ FOR _____ DATE _____

HOLD PENDING FURTHER TESTS _____

REASONS FOR REJECTION OR HOLDING _____

PERCOLATION TEST PLAT/PRELIMINARY PLAT - TITLE OR I.D. # _____ DATE _____

SITE DEVELOPMENT PLAN/FINAL PLAT - TITLE OR I.D. # _____ DATE _____

THIS IS NOT A PERMIT

517904

NOT TO SCALE

COUNTY #

SOIL PROFILE

3568

brown
topsoil

org-brn

red-brn

silty

clay

lm

red-brn

silt lm

org-brn

fine

sandy lm

0-5%

ROCK

13'

3569

SEE

3568



13'6"

3570

SEE

3568



14'6"

SOIL PROFILE


3571

SEE

3568



13'

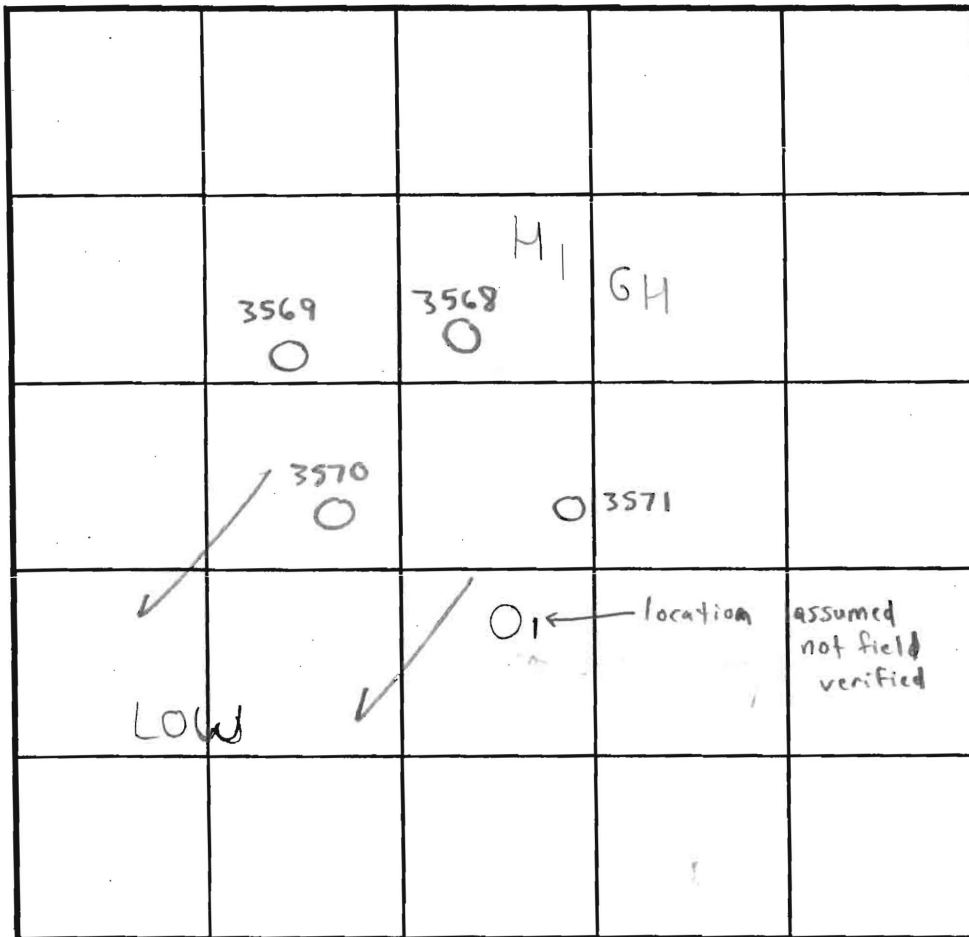

INDICATE NORTH - NAME ADJOINING ROADWAY AS BASE LINE.

DATE	TEST NO.	DEPTH	PRE-WET		TEST - 1" DROP		TIME	
			START	STOP	START	STOP		
12/6/02	3568	13'V	(VISUAL OK		SEE SOIL	PROFILE)	NA	OK
	3569	13'6"V	"	"	"	"	NA	OK
	3570	14'6"V	"	"	"	"	NA	OK
	3571	13'V	"	"	"	"	NA	OK
3/16/98	1	12'V	(PREVIOUSLY EVAL. BY RTP)				NA	Marginal

REMARKS

All holes consistent / picked w/trowel

TYPE OF SOIL

Glenelg

TESTED BY

SRK

Donnie Simpson Backhoe

ALSO PRESENT

Bob Sheesley } 12/6/02
Jim Selfridge }

TRENCH DESIGN DATA: AVERAGE PERCOLATION TIME

2-7min est.

TRENCH WIDTH

3'

INLET DEPTH

4

MAXIMUM BOTTOM DEPTH

6

SQ. FT/BEDROOM

180

Lot 18