

PERMIT

SEWAGE DISPOSAL SYSTEM DEPARTMENT OF HEALTH AND MENTAL HYGIENE

P _____

A 514944

DISTRICT _____

DATE _____

DATE SYSTEM APPROVED _____

INSPECTOR _____

HOWARD COUNTY HEALTH DEPARTMENT

BUREAU OF ENVIRONMENTAL HEALTH

~~XXXXXX~~

410-313-2640

RPS# 328019

INDEXED

ADDRESS 4102 Roxbury Mill Road IS PERMITTED TO INSTALL _____ ALTER _____
PHONE _____

SUBDIVISION _____ LOT _____ ROAD _____

PROPERTY OWNER Irene Smallwood → Phone 489-4879ADDRESS 4102 Roxbury Mill Road

SEPTIC TANK CAPACITY _____ GALLONS

NUMBER OF BEDROOMS _____

_____ SQUARE FEET PER BEDROOM

LINEAR FEET OF TRENCH REQUIRED _____

Unofficial
See Jane Nadeau's note dated 9/28/89 - Holding Tank installed
by Van Sant Plumbing & Heating.

ANS APPROVED BY _____ DATE _____

OVER NO WORK UNTIL INSPECTED AND APPROVED

NEITHER THE HOWARD COUNTY COUNCIL NOR THE HEALTH DEPARTMENT IS RESPONSIBLE FOR THE SUCCESSFUL OPERATION OF ANY SYSTEM

NOTE: CLEANOUT REQUIRED EVERY 70 FEET OF SEWER LINE AND/OR AT 90° SWEEPS IN LINES FROM HOUSE TO DRAIN FIELDS, 90° ELBOWS NOT ACCEPTABLE.

NOTE: ALL PARTS OF SEPTIC SYSTEMS (I.E. TANK, DISTRIBUTION BOX TRENCHES) TO BE 100 FEET FROM WELL (UNLESS OTHERWISE SPECIFICALLY AUTHORIZED)

NOTE: IF DEEP TRENCH(ES) ARE USED CALL FOR INSPECTION BEFORE AND AFTER PLACING GRAVEL IN TRENCH(ES)

NOTE: NO DRY WELL SHALL EXCEED 15 FOOT IN DIAMETER NO ABSORPTION TRENCH TO EXCEED 100 FEET IN LENGTH

NOTE: ALL PIPE FROM HOUSE TO SEPTIC TANK MUST BE CAST IRON OR SCHEDULE 35/40 PVC OR ABS

LIMIT VOID AFTER TWO YEARS

NOTE: INSTALL STAND PIPE ON SEPTIC TANK AND DRY WELL STAND PIPES MUST BE 6 INCHES IN DIAMETER CAST IRON, CONCRETE OR TERRA COTTA OR PVA OR ABS ACCEPTED. IF TOP OF SEPTIC TANK IS DEEPER THAN 3 FEET. MANHOLE TO GRADE REQUIRED.

NOTE: DISTRIBUTION BOXES MUST HAVE BAFFLES

*INSTALLER IS RESPONSIBLE FOR OBTAINING FINAL APPROVAL ON THIS PERMIT
*CALL 461-9933 FOR INSPECTION OF SEPTIC SYSTEM.


514944B

REPLACEMENT WELL SITE INSPECTION

OWNER Smallwood, Irene
ADDRESS 4102 Roxbury Mill Rd
Brooksville, MD 20833
489-4879

DATE REQUESTED 8-22-89
DRILLER George Easterday
WELL TAG# HO-88-1023
COUNTY# 13

LOCATION DIAGRAM

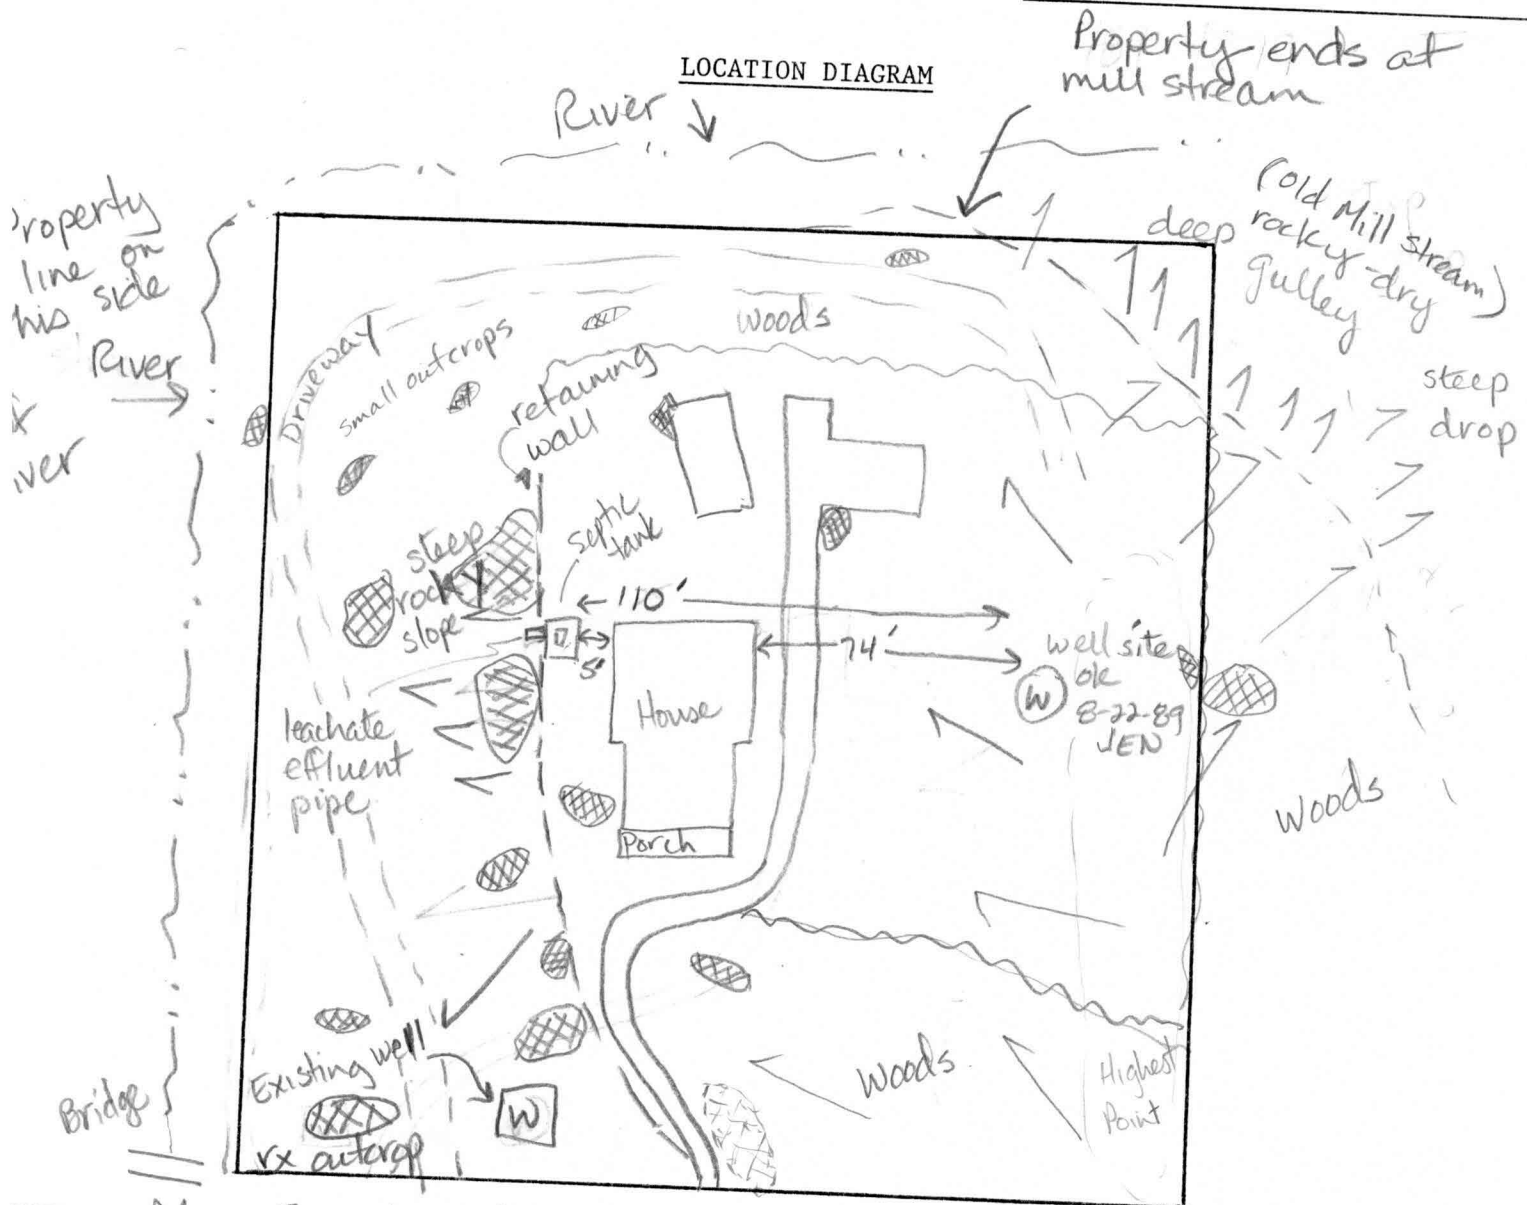

COMMENTS: Mrs. Smallwood has water but is concerned about contamination from septic tank. Holding tank which is pumped occasionally. A leachate effluent pipe is attached near top of tank. Leachate flows down rocky slope and probably into stream. Property is extremely rocky. 8-22-89 JEN 8-24-89 Septic tank last pumped 3 yrs ago - almost empty according to Mrs. Smallwood. JEN → OVER

9-28-89

Septic tank outlet pipe plugged inside and outside with cement. Alarm & float installed to alert owner to pump tank. Van Sant did work. JEN

