

7/17/01
Late PM

PERMIT

SEWAGE DISPOSAL SYSTEM
HOWARD COUNTY HEALTH DEPARTMENT
BUREAU OF ENVIRONMENTAL HEALTH
410-313-2640

P 515340

A 56495

ISSUE DATE 7/16/2001

APPROVAL DATE 7/18/01

INDEXED

WTC III

IS PERMITTED TO INSTALL ☒ ALTER

ADDRESS 1820 Gills Falls Road, Woodbine, MD 21797 PHONE 410-489-4457

DIVISION Spring Meadow Farm LOT NUMBER 4 ADDRESS 2351 Roxbury Mills Road

PROPERTY OWNER Vozniak PROPERTY OWNER'S ADDRESS P.O. Box 310 (21794)

SEPTIC TANK CAPACITY 1000 GALLONS * WATERTIGHT SEPTIC TANK REQUIRED *

PUMP CHAMBER CAPACITY N/A GALLONS

NUMBER OF BEDROOMS 3

SQUARE FEET PER BEDROOM 180

DEPT. FEET OF TRENCH REQUIRED 180

REMARKS: Trenches to be 3 feet wide. Inlet 3.5 feet below original grade. Bottom maximum depth 5.5 feet below original grade. 2 feet of stone below distribution pipe.

NOTES: Starting at the left front property corner (286.55'/129.42' intersection), place the distribution box 55 feet up the left (286.55') lot line and 85 feet off this same lot line. Run (3) trenches on contour to front of lot. 3/1/01 OK BB

PERMIT APPROVED Mark Rifkin, R.S. DATE 2/27/2001

PERMIT VOID AFTER 2 YEARS

NOTE: CONTRACTOR RESPONSIBLE FOR SCHEDULING A PRE-CONSTRUCTION INSPECTION FOR ALL INSTALLATIONS

NOTE: TOP OF SEPTIC TANKS ARE TO BE NO DEEPER THAN 3.0 FEET BELOW FINISH GRADE

NOTE: WATERTIGHT SEPTIC TANKS REQUIRED

NOTE: CLEANOUT REQUIRED EVERY 70 FEET OF SEWER LINE AND/OR AT 90° SWEEPS IN LINES FROM HOUSE TO DRAIN FIELDS, 90° ELBOWS ARE NOT ACCEPTABLE

NOTE: ALL PARTS OF SEPTIC SYSTEMS (I.E. TANK, DISTRIBUTION BOX, DRAINFIELDS) TO BE 100 FEET FROM ANY WATER WELL UNLESS OTHERWISE SPECIFICALLY AUTHORIZED

NOTE: NO ABSORPTION TRENCH TO EXCEED 100 FEET IN LENGTH UNLESS SPECIFICALLY AUTHORIZED

NOTE: ALL PIPE FROM HOUSE TO SEPTIC TANK MUST BE CAST IRON OR SCHEDULE 35/40 PVC OR ABS

NOTE: MANHOLE RISERS REQUIRED ON ALL SEPTIC TANKS AND PUMP CHAMBERS


NOTE: DISTRIBUTION BOXES MUST HAVE BAFFLES

NOTE: IF PUMPED SEPTIC SYSTEM REQUIRED, (1) SEPTIC PUMP DETAIL TO BE PROVIDED BY INSTALLER PRIOR TO ISSUANCE OF SEPTIC PERMIT (2) PUMP PERFORMANCE TEST IS NECESSARY PRIOR TO HEALTH DEPARTMENT APPROVAL OF SEPTIC PERMIT

NEITHER THE HOWARD COUNTY COUNCIL NOR THE HEALTH DEPARTMENT IS RESPONSIBLE FOR THE SUCCESSFUL OPERATION OF ANY SYSTEM
PERMITTEE RESPONSIBLE FOR OBTAINING FINAL APPROVAL ON THIS PERMIT
CALL 410-313-2640 FOR INSPECTION OF SEPTIC SYSTEM

P 515340

NOT TO SCALE

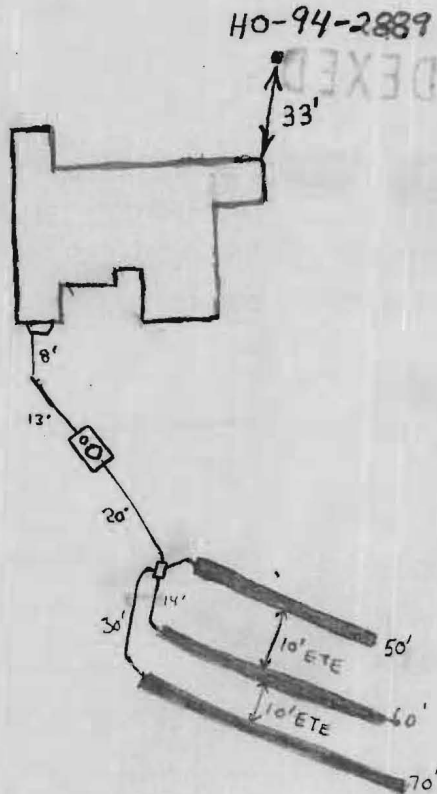

TRENCH DATA

TRENCH WIDTH 3'
TRENCH INLET DEPTH 3.5'
TRENCH BOTTOM DEPTH 5.5'
DEPTH OF STONE 2
NUMBER OF TRENCHES 3
TOTAL TRENCH LENGTH 180'
ABSORBENT AREA 540 ft²
DISTRIBUTION BOX LEVEL ✓
BAFFLE IN DISTRIBUTION BOX ✓

SEPTIC TANK DATA

SEPTIC TANK 1000 TS GALLONS
MANHOLE RISER on center
6 INCH INSPECTION PORT on front

PUMP CHAMBER DATA

PUMP CHAMBER GALLONS NA
MANHOLE RISER NA
ALARM NA
PUMP PERFORMANCE TEST NA

Route 97
PRE-CONSTRUCTION INSPECTION: 7/16/01 To install as per B.P. plan. Easement not staked - builder contacted. Will allow installation. Contractor to determine
INSPECTION COMMENTS: easement corners from property corner stakes. (BB)
7/18/01 - OK TO COVER ALL WORK - (BRK)

INSPECTOR


Steven R. Krieg

DATE SYSTEM APPROVED

7/18/01

THIS PLAT IS OF BENEFIT TO A CONSUMER
 INsofar AS IT IS REQUIRED BY A LENDER
 TITLE INSURANCE COMPANY OR ITS AGENT IN
 CONNECTION WITH CONTEMPLATED TRANSFER,
 MORTGAGING, OR REFINANCING.
 THIS PLAT IS NOT TO BE RELIED UPON FOR THE ESTABLISHMENT OR
 LOCATION OF FENCES, GARAGES, BUILDINGS, POOLS, BUILDING ADDITIONS OR OTHER
 IMPROVEMENTS OR FUTURE IMPROVEMENTS.
 THIS PLAT DOES NOT PROVIDE FOR THE ACCURATE IDENTIFICATION
 PROPERTY BOUNDARY LINES, BUT SUCH IDENTIFICATION MAY
 BE REQUIRED FOR THE TRANSFER OF TITLE OR SECURING
 MORTGAGING OR REFINANCING.
 ACCURACY OF BUILDING MEASUREMENTS: 0.1'
 ACCURACY OF SETBACK DIMENSIONS: 0.2'
 ACCURACY OF ELEVATIONS: 0.1'

UES IN ZONE 3 AND SPECIAL
 FLOOD INSURANCE RATE MAP
 NO:240044 00148
 DATED: DEC. 4,1980

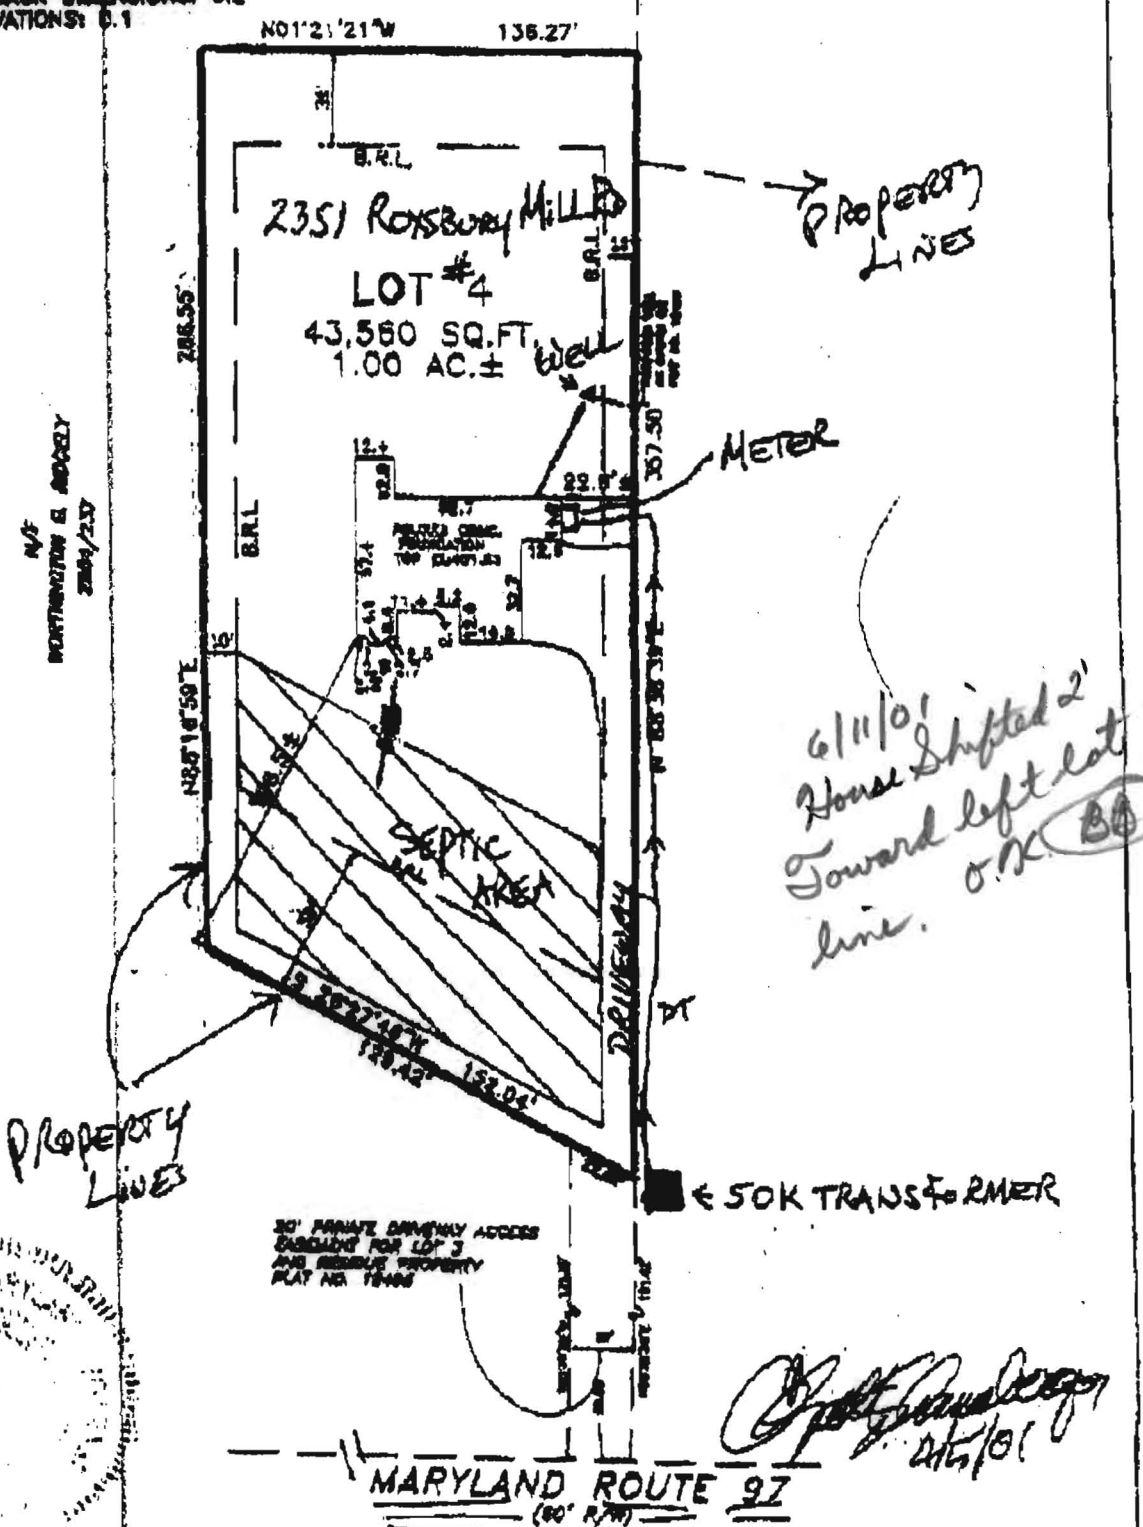

HEREBY CERTIFY THAT I HAVE LOCATED
 IMPROVEMENTS AS SHOWN. THIS PLAT
 IS NOT REPRESENT A BOUNDARY SURVEY
 I CANNOT BE USED TO ESTABLISH
 PROPERTY LINES OR CORNERS.

FOUNDATION LOCATION DRAWING
 LOT 4
 SPRING MEADOW FARM