LAYOUT				
INSP 1 2/17/11	INSP 3			
INSP 2				
ISSUE DATE: 1118 APPROVAL		PERMIT	TEM	р <u>534096</u> А
DATE:	SHAN	ED SEFIIC 515		
-71810 -71810	HOUSE SEW	ID # 05-448719 ER LINE CONNECT NTY HEALTH DEPARTM NVIRONMENTAL HEAD	MENT LTH	
Josth Carroll Da	shhe	IS PERMITTED TO	INST	ALL 🛛 ALTER 🗌
ADDRESS: 440 Sale	in Bottom Bot We	Stminster MD PHONE NI		
SUBDIVISION Walnut	Grove	LOT NUM	BER:	12
ADDRESS: <u>12212 Run</u>	ning Fence Lane	PROPERTY OWNE	R: <u>Huz</u>	zefa and Michelle Bahrain
NUMBER OF BEDROOMS	3:			
HOUSE SERVED BY	PUBLIC WATE	R? NO		
LOCATION Install 4'	'house sewer line com	nection per the approved site p	lan	

LOCATION:	Install 4" house sewer line connection per the approved site plan.
NOTES:	This permit is limited to the installation of the individual house sewer line connection and installation of the grinder pump, if applicable. The Howard County Bureau of Utilities must be contacted for scheduling of inspection of these items as well, at 410-313-4900.

PLANS APPROVED:

Heidi Scott

DATE: 7/27/10

PERMIT VOID AFTER 2 YEARS

1. CONTRACTOR IS RESPONSIBLE FOR SCHEDULING A PRE-CONSTRUCTION INSPECTION FOR ALL INSTALLATIONS.

2. ALL PARTS OF SEPTIC SYSTEM SHALL BE 100 FEET FROM ANY WATER WELL UNLESS SPECIFICALLY AUTHORIZED.


3. MANHOLE RISERS REQUIRED ON ALL SEPTIC TANKS AND PUMP CHAMBERS UNLESS SPECIFICALLY AUTHORIZED.

4. CONTRACTOR RESPONSIBLE FOR COMPLIANCE WITH APPLICABLE REGULATIONS, GUIDELINES AND THE TERMS OF THIS PERMIT.

5. NEITHER THE HOWARD COUNTY COUNCIL NOR THE HEALTH DEPARTMENT IS RESPONSIBLE FOR THE SUCCESSFUL OPERATION OF ANY SYSTEM.

6. PERMITTEE RESPONSIBLE FOR OBTAINING FINAL APPROVAL ON THIS PERMIT.

CALL 410-313-1771 FOR INSPECTION HOUSE CONNECTION

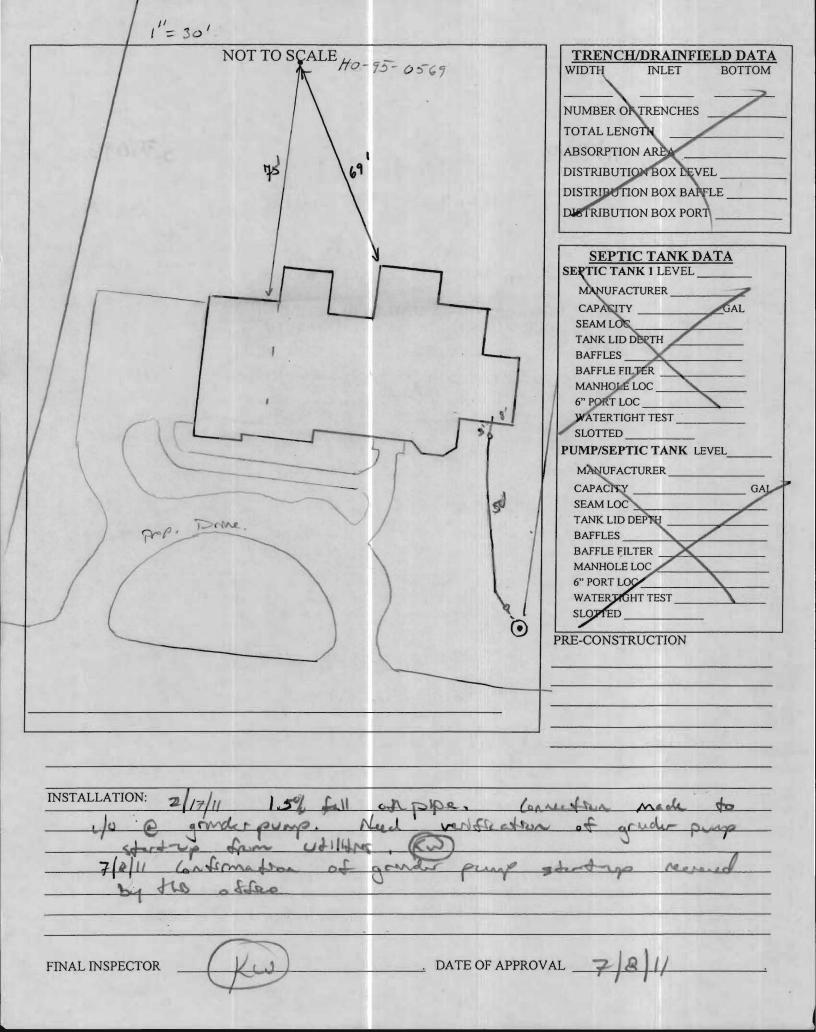

FOREST CALER A REAL CONSERVATION PRIVATE DRAINAGE EASEMENT AREA 8 N 77 8 70 W 53.11" 40,111 SQ FT Ř LOT 11 x. 900 45-0508 WALNUT GROVE 6 5x, Well H0--96--0870 22 LOT 13 WALNUT GROVE Ш 16.97 inte-500 38.05 R 4.07 TOP OF FOUNDATION 418.3' 10' PUBLIC TREE 150 2 19.50 200 9-20 MAINTAINANCE SC In UTILITY EASEMENT Wall check OK NEB 11/18/2010 10'X10' PUBLIC Q SEWER & UTILITY ſ, EASEMENT -60.88, 1-480.00 (\cdot) 533.8' TO PE AT 8 84"23'33" E 100.00 PREAKNESS CIRCLE LANE 6 L=13.00, R=520.00 RUNNING FENCE LANE BUILDING PERMIT # 810002170 HE PLAT. WALNUT GROVE SHEET 7 OF B PLAT NO. 19228 nj was propared wilhout the benefit of a this report which may reveal additional conveyences, essenceria, righte-piway or ministra aut shown herson. OF MARY building rea This isocian dreating, and the excepting work relievant in it, were prepared under my responsible charge and comply with the requirements sectors in the Maryland minimum standards for professional land surveyors (CCMAR 08, 13.09, 12). It is of bandit to a consumer only, insolar as it is required by a lander or a title insurence company or its egent in connection with contemplated transfer, insuring, or refinancing it is not to be relied upon for the exclusionment or location of innore, garages, buildings, or other existing or induce large and it does not provide for the exclusion of property lines, inverser, this identification may not be required for the security or refinancing, dimensions of buildings to property lines are within a tolerance of one (0.1) foot, more or isse. VALLAND ATTRACTOR OF FOLINDATION ORAWING 12212 RUNNING FENCE LANE LOT 12, WALNUT GROVE \mathcal{Z} 11-11-10 allet CLARKSVILLE, MD. 21029 Alan Vincent Burks, Jo. Professional Land Surveyor (Maryland No. 10846) SIN ELECTION DISTRICT HOWARD COUNTY, MARYLAND Drowns 8.P.GREEN NON Checked; AVE 11-08-2010 Date: gineering Design Project No. : 10008.12 Acubilizations Land Pla Land B areasing L 6990 Columbia General Dr. Ste 150 Columbia, Maryland 21048 www.udomaril.com 448, 278, 8220 Soala 1=40 449 978 8094 Con. hioe adomed.com Shants 10F1