Howard County Building/Fire Permit Application Department of Inspections, Licenses & Permits

Permit Number:

Automated Line: 410-313-3800	3430 Court Hou Ellicott City, M	use Drive D 21043 スリンク	2958
Building Address:		Property Owner's Name:	
-13904 Ryon Dr. (alenda md 21737	Address:	
Suite/Apt. #SD	5		Zip Code:
	Subdivision: Hopkins Choice	11	Work Phone:
		J	
Section: Ar		Applicant's Name & Mailing Address	s, (If other than stated herein):
Tax Map: Parcel:	Grid: 12		
Zoning: Map Coordina	ates: Lot Size: 1.05 A	Phone: F	ax:
Existing Use:		Email:	
Proposed Use:			
Estimated Construction Cost: \$		Contact Person:	
		Address:	
Description of Work:		City:State:	Zip Code:
-install A loso an	I underground propane	License No. :	
ga	+ank	Phone:	Fax:
Occupant or Tenant:	Farts	Email:	
Was tenant space previously occupied			
		Engineer/Architect Company:	
Contact Name:		Responsible Design Prof.:	
Address:		Address:	
City:	State: Zip Code:		Zip Code:
	_Fax:		
		Phone:	
Email:		Email:	
	TION - COMMERCIAL	BUILDING DESCRIP	TION – RESIDENTIAL
Building Characteristics	Utilities	Building Characteristics	Utilities
Height:	Water Supply	□ SF Dwelling □ SF Townhouse	Water Supply
No. of stories:	Public	Depth Width	
Gross area, sq. ft./floor:	🗆 Private	1 st floor: 2 nd floor:	Private
	Sewage Disposal	Basement:	Sewage Disposal
Area of construction (sq. ft.):	Public	Finished Basement	
	□ Private		Electric: Yes No
Use group:	Electric: 🗌 Yes 🗌 No	Crawl Space	Gas: 🗌 Yes 🗌 No
	Gas: Yes No	□ Slab on Grade	Heating System
Construction type:	Heating System	No. of Bedrooms:	
Reinforced Concrete		Multi-family Dwelling	
	□ Electric □ Oli	No. of efficiency units: No. of 1 BR units:	Natural Gas
		No. of 1 BR units:	Propane Gas
Masonry Wood Frame	<u>Sprinkler System:</u>	No. of 3 BR units:	
State Certified Modular		Other Structure:	
		Dimensions:	
	Dertial		
Roadside Tree Project Permit	Partial	Footings:	Roadside Tree Project Permit
□Yes □No	Other Suppression	Roof:	□Yes □No

WITH ALL REGULATIONS OF HOWARD COUNTY WHICH ARE APPLICABLE THERETO; (4) THAT HE/SHE WILL PERFORM NO WORK ON THE ABOVE REFERENCED PROPERTY NOT SPECIFICALLY DESCRIBED IN THIS APPLICATION; (5) THAT HE/SHE GRANTS COUNTY OFFICIALS THE RIGHT TO ENTER ONTO THIS PROPERTY FOR THE PURPOSE OF INSPECTING THE WORK PERMITTED AND POSTING NOTICES.

Applicant's Signature

Print Name

Email Address

Date

Title/Company

Checks Payable to: DIRECTOR OF FINANCE OF HOWARD COUNTY **PLEASE WRITE NEATLY & LEGIBLY** -FOR OFFICE USE ONLY-

AGENCY	DATE	SIGNATURE OF APPROVAL
State Highways		
Building Officials		
PSZA (Zoning)		
PSZA (Engineering)		
Health	10-12-11	Deidt Stitt
Fire Protection		
Is Sediment Control app	•	ed for issuance? Yes No

ONTINGENCY CONSTRUCTION START

□ ONE STOP SHOP


DPZ SETBACK INFORMATION		
Front:		
Rear:		
Side:		
Side St.:		
All minimum setbacks met?	🗆 Yes	□No
Is Entrance Permit Required?	🗆 Yes	□No
Historic District?	🗆 Yes	□No
Lot Coverage for New Town Z	one:	
SDP/Red-line approval date:		

Filing Fee	\$
Permit Fee	\$
Tech Fee	\$
Excise Tax	\$
PSFS	\$
Guaranty Fund	\$
Add'l per Fee	\$
Total Fees	\$
Sub- Total Paid	\$
Balance Due	\$

Green: PSZA,Zoning **Distribution of Copies:** White: Building Officials F:\Operations\Updated Forms\New building app 11.10.2010.docx

Yellow: PSZA, Engineering

Pink: Health Gold: SHA

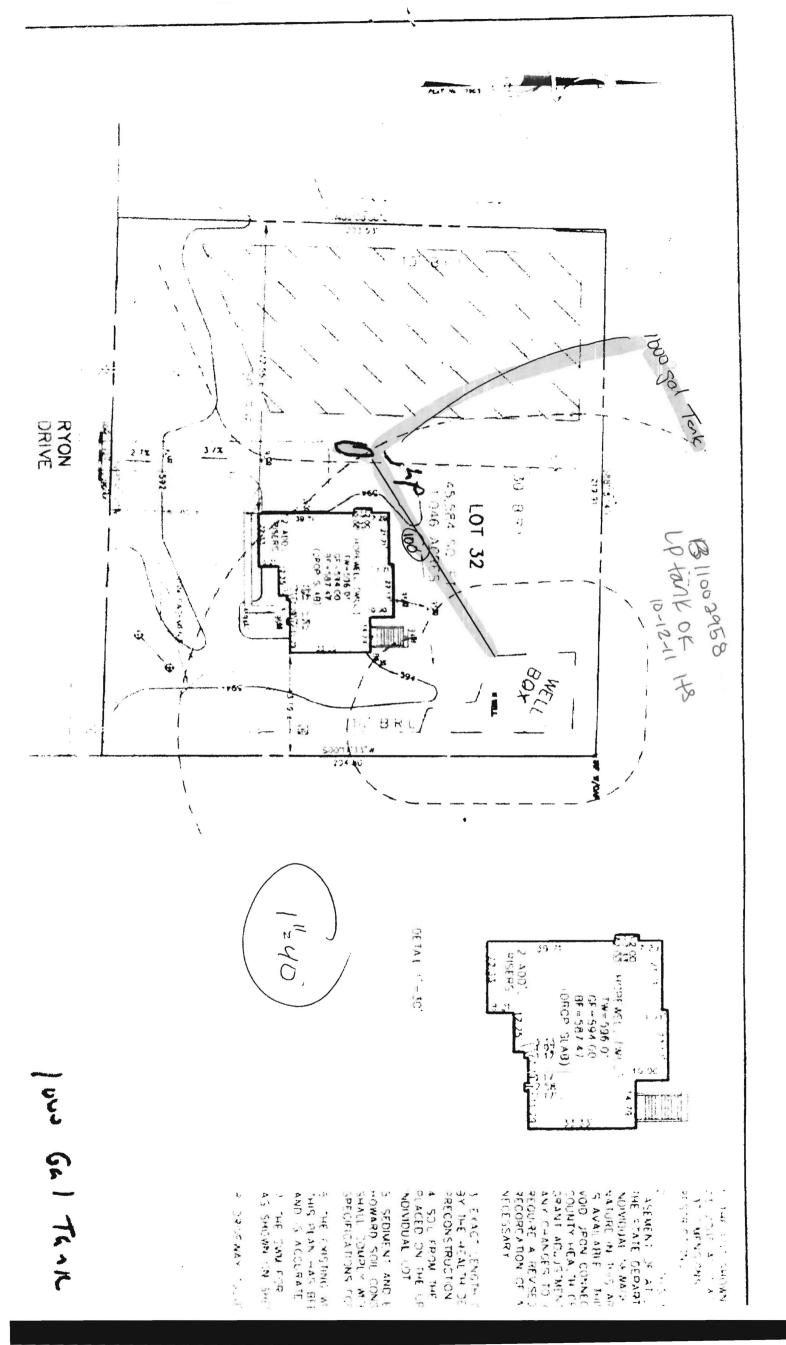

Permits: 410-313-2455 Inspections: 410-313-1810 Automated Line: 410-313-3800	Howard County Building/ Department of Inspection 3430 Court H	Fire Permit Application ns, Licenses & Permits	Permit Number:
. <i>Ť</i> .	Ellicott City, I		111:31 2-2
Building Address: 13904	Bud Drive	Property Owner's Name: 10,11	no TTO
		Address: 14/18 Categories	N Form OF
Suite/Apt. #		City: <u>Clenelq</u> State:	
Concurs Tractu	Subdivision: Hopkins (hoi	Home Phone:	
			_ Work Phone:
Section:	Area:Lot:32	Applicant's Name & Mailing Address	, (If other than stated herein):
Tax Map: Parce	el:Grid:		
Zoning: Map Coord	inates: Lot Size:	Phone: Fa	
			ax:
Existing Use: Vacant	ot	Email:	
Proposed Use: Single F		Contractor Company: TGH	pathers Inc
Estimated Construction Cost: \$4	100,000	Contact Person: Mike ()	Dection
Description of Work:		Address: 71/04 Columbia	Charlenky Dr
		City: Columbic_State: M	DZip Code:
		License No. :	
		Phone:	ax:
Occupant or Tenant:	· · · · ·	Email:	
Was tenant space previously occupie	ed? 🗍 🗆 Yes 👘 🗆 No	Engineer/Architect Company:	CIE
Contact Name: Michael			
		Responsible Design Prof.: <u></u>	PLOUCE
Address: 4/18 Patters	M A FORM	Address: 7164 Columb	in Gational Dr.
City:	State: Zip Code:	City: Colombia_State: n	Di Zin Code: 210410
Phone: 410 489-1401	Fax: 410-489-21076	Phone:F	ax:
Email:		Email:	
Email:	Fax: 410-489-21076	Email:BUILDING DESCRIPT	TION – RESIDENTIAL
Email:	RIPTION - COMMERCIAL Utilities	Email:	TION – RESIDENTIAL Utilities
Email:	RIPTION - COMMERCIAL Utilities <u>Water Supply</u>	Email:	TION – RESIDENTIAL Utilities <u>Water Supply</u>
Email:	RIPTION - COMMERCIAL Utilities <u>Water Supply</u> Dublic	Email:	TION – RESIDENTIAL Utilities Water Supply
Email:	RIPTION - COMMERCIAL Utilities <u>Water Supply</u> Dublic Private	Email:	TON – RESIDENTIAL Utilities <u>Water Supply</u> Public Private <u>Sewage Disposal</u>
Email:	RIPTION - COMMERCIAL Utilities Water Supply Dublic Private Sewage Disposal	Email:	TION – RESIDENTIAL Utilities Water Supply Public Private Sewage Disposal Public
Email:	RIPTION - COMMERCIAL Utilities Utili	Email:	TION – RESIDENTIAL Utilities Water Supply Public Private Sewage Disposal Public Public
Email:	RIPTION - COMMERCIAL Utilities Water Supply Public Private Sewage Disposal Public Private	Email:	TION – RESIDENTIAL Utilities Water Supply Public Private Sewage Disposal Public Public Private Electric: Yes No
Email:	AIPTION - COMMERCIAL Utilities Utili	Email:	TION – RESIDENTIAL Utilities Water Supply Public Private Sewage Disposal Public Public
Email:	RIPTION - COMMERCIAL Utilities Utilities Utilities Utilities Public Private Sewage Disposal Public Private Electric: Yes No Gas: Yes No	Email:	TION – RESIDENTIAL Utilities Water Supply Public Private Sewage Disposal Public Private Electric: Yes No Gas: Yes No Heating System Electric
Email:	RIPTION - COMMERCIAL Utilities Utilities Water Supply Public Private Sewage Disposal Public Private Electric: Yes No Gas: Yes No <u>Heating System</u>	Email:	TION – RESIDENTIAL Utilities Water Supply Public Private Sewage Disposal Public Private Electric: Yes No Gas: Yes No <u>Heating System</u> Electric Oil
Email:	RIPTION - COMMERCIAL Utilities Utilities Utilities Utilities Utilities Utilities Utilities Utilities Sewage Disposal Sewage Di	Email:	TION – RESIDENTIAL Utilities <u>Water Supply</u> Public Private <u>Sewage Disposal</u> Public Private Electric: Yes No Gas: Yes No <u>Heating System</u> Electric Oil Natural Gas
Email:	NPTION - COMMERCIAL Utilities Water Supply Public Private Sewage Disposal Public Private Electric: Yes No Gas: Yes No Heating System Electric Oil Natural Gas	Email:	TION – RESIDENTIAL Utilities Water Supply Public Private Sewage Disposal Public Private Electric: Yes No Gas: Yes No <u>Heating System</u> Electric Oil
Email:	RIPTION - COMMERCIAL Utilities Water Supply Public Private Sewage Disposal Public Private Electric: Yes No Gas: Yes No Heating System Electric Oil Natural Gas Propane Gas Sprinkler System:	Email:	TION – RESIDENTIAL Utilities <u>Water Supply</u> Public Private <u>Sewage Disposal</u> Public Private Electric: Yes No Gas: Yes No <u>Heating System</u> Electric Oil Natural Gas
Email:	AIPTION - COMMERCIAL Utilities Utilities Utilities Utilities Utilities Utilities Utilities Utilities Sewage Disposal Private Sewage Disposal Private Electric: Yes No Gas: Yes No Gas: Yes No Heating System Electric Oil Natural Gas Propane Gas Sprinkler System: No NA	Email:	TION – RESIDENTIAL Utilities <u>Water Supply</u> Public Private <u>Sewage Disposal</u> Public Private Electric: Yes No Gas: Yes No <u>Heating System</u> Electric Oil Natural Gas
Email:	AIPTION - COMMERCIAL Utilities Utilities Utilities Utilities Utilities Utilities Utilities Utilities Sewage Disposal Private Sewage Disposal Private Electric: Yes No Gas: Yes No Electric: Yes No Electric: Oil Electric Oil Electric Oil Natural Gas Propane Gas Sprinkler System: NA Full	Email:	TION – RESIDENTIAL Utilities <u>Water Supply</u> Public Private <u>Sewage Disposal</u> Public Private Electric: Yes No Gas: Yes No <u>Heating System</u> Electric Oil Natural Gas
Email:	RIPTION - COMMERCIAL Utilities Utilities Water Supply Public Private Sewage Disposal Public Private Electric: Yes No Gas: Yes No Electric: Yes No Electric Oil Electric Oil Electric Oil Natural Gas Propane Gas Sprinkler System: NA Full Partial	Email:	TION – RESIDENTIAL Utilities <u>Water Supply</u> Public Private <u>Sewage Disposal</u> Public Private Electric: Yes No Gas: Yes No <u>Heating System</u> Electric Oil Natural Gas
Email:	RIPTION - COMMERCIAL Utilities Water Supply Public Private Sewage Disposal Private Private Electric: Yes No Gas: Yes No Electric Oil Electric Oil Natural Gas Propane Gas Sprinkler System: N/A Full Other Suppression	Email:	TION – RESIDENTIAL Utilities <u>Water Supply</u> Public Private <u>Sewage Disposal</u> Public Private Electric: Yes No Gas: Yes No <u>Heating System</u> Electric Oil Natural Gas
Email:	RIPTION - COMMERCIAL Utilities Utilities Water Supply Public Private Sewage Disposal Public Private Electric: Yes No Gas: Yes No Electric: Yes No Electric Oil Electric Oil Electric Oil Natural Gas Propane Gas Sprinkler System: NA Full Partial	Email: BUILDING DESCRIPT Building Characteristics Building Characteristics SF Dwelling SF Townhouse Depth Width 1 st floor: Basement: 2 nd floor: Basement: Finished Basement Unfinished Basement Crawl Space Slab on Grade No. of Bedrooms: Multi-family Dwelling No. of 1 BR units: No. of 2 BR units: No. of 3 BR units: Other Structure: Dimensions: Footings: Roof: State Certified Modular	TION – RESIDENTIAL Utilities <u>Water Supply</u> Public Private <u>Sewage Disposal</u> Public Private Electric: Yes No Gas: Yes No <u>Heating System</u> Electric Oil Natural Gas
Email:	RIPTION - COMMERCIAL Utilities Water Supply Public Private Sewage Disposal Private Private Electric: Yes No Gas: Yes No Electric Oil Electric Oil Natural Gas Propane Gas Sprinkler System: N/A Full Other Suppression	Email: BUILDING DESCRIPT Building Characteristics Building Characteristics SF Dwelling SF Townhouse Depth Width 1 st floor: 2 nd floor: Basement: Finished Basement Crawl Space Slab on Grade No. of Bedrooms: Multi-family Dwelling No. of efficiency units: No. of 1 BR units: No. of 2 BR units: No. of 3 BR units: Other Structure: Dimensions: Footings: Roof: State Certified Modular Manufactured Home Now OK ON THE ABOVE REFERENCE	TION - RESIDENTIAL Utilities Water Supply Public Private Sewage Disposal Public Private Electric: Yes No Gas: Yes No Heating System Electric Oil Natural Gas Propane Gas
Email:	RIPTION - COMMERCIAL Utilities Water Supply □ Public □ Private Sewage Disposal O □ Private □ Private Electric: □ Yes □ No Gas: □ Yes □ No Electric: □ Oil □ □ Pitural Gas □ Propane Gas Sprinkler System: □ N/A □ N/A □ □ N/A □ □ Partial □ □ Other Suppression No. of Heads: □ SREES AS FOLLOWS: (1) THAT HE/SHE IS AUTHORIZED TO TO Y WHICH ARE APPLICABLE THERETO; (4) THAT HE/SHE COUNTY OFFICIALS THE RIGHT TO ENTER ONTO THIS PRO	Email:	TION – RESIDENTIAL Utilities Water Supply Public Private Sewage Disposal Public Private Electric: Yes No Gas: Yes No Heating System Electric Oil Natural Gas Propane Gas
Email:	RIPTION - COMMERCIAL Utilities Water Supply □ Public □ Private Sewage Disposal O □ Private □ Private Electric: □ Yes □ No Gas: □ Yes □ No Electric: □ Oil □ □ Pitural Gas □ Propane Gas Sprinkler System: □ N/A □ N/A □ □ N/A □ □ Partial □ □ Other Suppression No. of Heads: □ SREES AS FOLLOWS: (1) THAT HE/SHE IS AUTHORIZED TO TO Y WHICH ARE APPLICABLE THERETO; (4) THAT HE/SHE COUNTY OFFICIALS THE RIGHT TO ENTER ONTO THIS PRO	Email: BUILDING DESCRIPT Building Characteristics Building Characteristics SF Dwelling SF Townhouse Depth Width 1 st floor: 2 nd floor: Basement: Finished Basement Crawl Space Slab on Grade No. of Bedrooms: Multi-family Dwelling No. of efficiency units: No. of 1 BR units: No. of 2 BR units: No. of 3 BR units: Other Structure: Dimensions: Footings: Roof: State Certified Modular Manufactured Home Now OK ON THE ABOVE REFERENCE	TION - RESIDENTIAL Utilities Water Supply Public Private Sewage Disposal Public Private Electric: Yes No Gas: Yes No Heating System Electric Oil Natural Gas Propane Gas

~	-
Title/Con	npany

Checks Payable to: DIRECTOR OF FINANCE OF HOWARD COUNTY **PLEASE WRITE NEATLY & LEGIBLY** -FOR OFFICE USE ONLY-

AGENCY	DATE	SIGNATURE OF APPROVA
State Highways		
Building Officials		· ·
PSZA (Zoning)		7
PSZA (Engineering)		~
Health	5311	Kanci Bernard
Fire Protection		- united and


DPZ SETBACK INFORMATION			
Front:			
Rear:			
Side:	a.		
Side St.:			
All minimum setbacks met?	🗆 Yes	□No	
Is Entrance Permit Required?	🗆 Yes	□No	
Historic District?	🗆 Yes	□No	
Lot Coverage for New Town Z	one:		
SDP/Red-line approval date:			
L'a			-

Filing Fee	\$ 160.00
Permit Fee	\$1. 100
Tech Fee	\$
Excise Tax	\$
PSFS	\$
Guaranty Fund	\$
Add'l per Fee	\$
Total Fees	\$
Sub- Total Paid	\$
Balance Due	\$

Da vini

Gold: SHA

Yellow: PSZA, Engineering Pink: Health

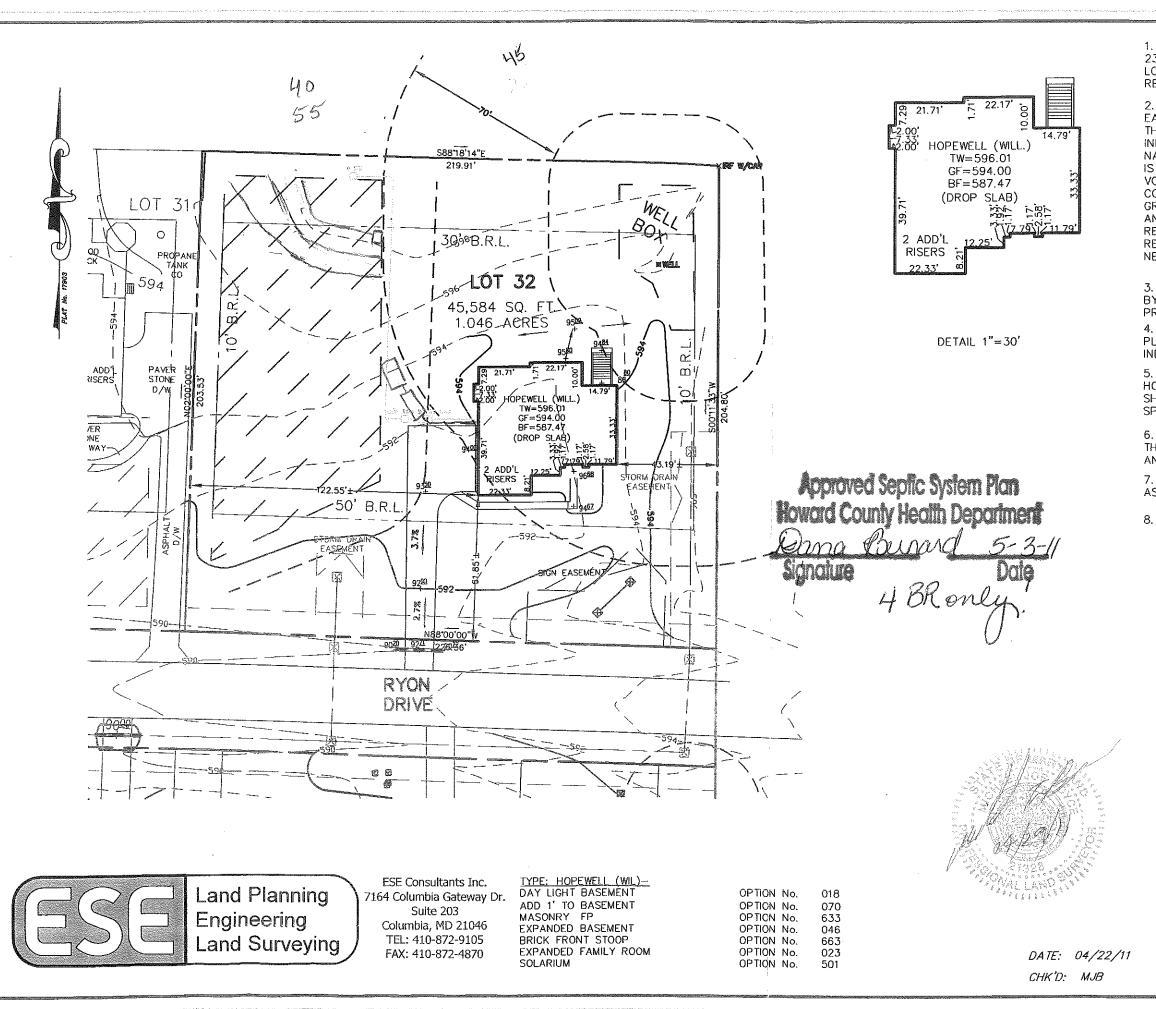

1. THE LOT SHOWN HEREON WAS RECORDED ON SEPTEMBER 23, 2005 AS PLAT NUMBER 17725. REFER TO THIS PLAT FOR LOT DIMENSIONS, LOT AREAS, ALL EASEMENTS AND BUILDING RESTRICTIONS.

2. THIS AREA DESIGNATES A PRIVATE SEWERAGE EASEMENT OF AT LEAST 10,000 SQ. FT. AS REQUIRED BY THE STATE DEPARTMENT OF THE ENVIRONMENT FOR INDIVIDUAL SEWAGE DISPOSAL. IMPROVEMENTS OF ANY NATURE IN THIS AREA IS RESTRICTED UNTIL PUBLIC SEWER IS AVAILABLE. THIS EASEMENT SHALL BECOME NULL AND VOID UPON CONNECTION TO A PUBLIC SEWAGE SYSTEM. THE COUNTY HEALTH OFFICER SHALL HAVE THE AUTHORITY TO GRANT ADJUSTMENTS TO THE PRIVATE SEWAGE EASEMENT. ANY CHANGES TO A PRIVATE SEWAGE EASEMENT SHALL REQUIRE A REVISED PERCOLATION CERTIFICATION PLAN. RECORDATION OF A MODIFIED EASEMENT PLAT SHALL NOT BE NECESSARY.

3. EXACT LENGTH OF SEPTIC TRENCHES ARE BE DETERMINED BY THE HEALTH DEPARTMENT AT THE TIME OF PRECONSTRUCTION INSPECTION.

4. SOIL FROM THE TRENCHING OF THE SEPTIC AREA IS TO BE PLACED ON THE UPHILL SIDE OF THE EXCAVATION FOR EACH INDIVIDUAL LOT.

5. SEDIMENT AND EROSION CONTROLS WERE APPROVED BY HOWARD SOIL CONSERVATION DISTRICT UNDER GP 10-74 AND SHALL COMPLY WITH THE 1994 MARYLAND STANDARDS AND SPECIFICATIONS FOR SOIL EROSION AND SEDIMENT CONTROL.

6. THE EXISTING WELL (TAG NO.HO-94-4071) SHOWN ON THIS PLAN HAS BEEN FIELD LOCATED BY ESE CONSULTANTS AND IS ACCURATELY SHOWN.

7. THE SWM FOR LOT 32 IS MANAGED BY SWM BMP POND #1 AS SHOWN ON SHEET 5 OF 22 OF THE 05-029 PLANS.

8. DRIVEWAY CULVERT- PER PLAN 05-029,

INV @ HSE	590.20
GROUND AT HSE	594.0
INV. IN @ TANK	589.8
INV OUT @ TANK	589.5
TOP OF TANK	590.5
GROUND OVER TANK	593.0
INV IN @ PUMP PREASURE TO D BOX	589.3
INV IN © D BOX	595.3
INVT OUT © D BOX	595.0
GROUND © D BOX	599.0

ADDRESS: 13904 RYON DRIVE GLENELG, MD 21737

PERMIT PLOT PLAN LOT #32 HOPKINS CHOICE LIBER 07504, FOLIO 0437 PLAT No. 17903 FOURTH ELECTION DISTRICT HOWARD COUNTY, MARYLAND

SCALE: 1"=40' JOB#: 2975 FILE: 2975_LOT_32 PP DRAWN: MJB

44124930 791111



Toll Brothers Inc -Glenelg Estates/Hopkins Choice 14118 Patterson Farm Court Glenelg Maryland 21737

August 12, 2011

Ms. Avis L. Corbin-Chief of Licenses and Permits Division 3430 Court House Drive Ellicott City Maryland 21043

> Re: Permit Revision B11000233- Permit Number 13904 Ryon Drive Hopkins Choice Lot #32


Dear Ms. Corbin

Thank you for taking the time to review the attached documentation. The reason for the letter is that the homeowner re-selected their house type. Included in the documentation are a revised blue prints, revised site plan, and an amendment check

Please accept my apologies for the trouble. Please contact me with any questions or concerns of any kind at 410-320-0223 or mmartin3@tollbrothersinc.com.

CC: Zoning DED Hearthc Sincerely, Michael Martin TOLL BROTHERS, INC. Project Manager RECEIVED SEP 6 2011 New York Stock Exchange • Symbol TOL Maryland Division Maryland Division LICENSES & PERMITS 7164 Columbia Gateway Drive, Suite 230, Columbia, MD 2104 BIVISION (410) 872-9105 • Fax (410) 872-9141

tollbrothers.com

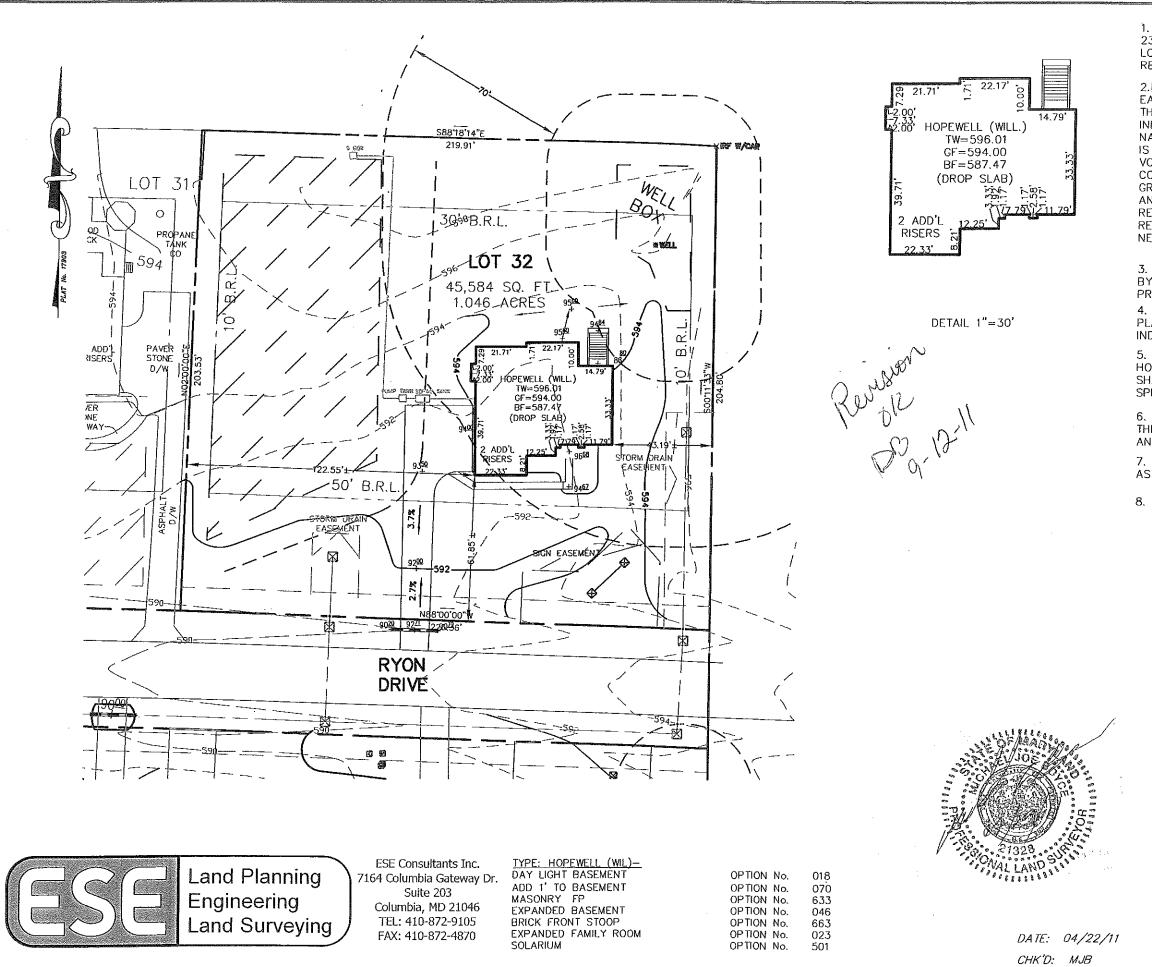

1. THE LOT SHOWN HEREON WAS RECORDED ON SEPTEMBER 23, 2005 AS PLAT NUMBER 17725. REFER TO THIS PLAT FOR LOT DIMENSIONS, LOT AREAS, ALL EASEMENTS AND BUILDING RESTRICTIONS.

2. THIS AREA DESIGNATES A PRIVATE SEWERAGE EASEMENT OF AT LEAST 10,000 SQ. FT. AS REQUIRED BY THE STATE DEPARTMENT OF THE ENVIRONMENT FOR INDIVIDUAL SEWAGE DISPOSAL. IMPROVEMENTS OF ANY NATURE IN THIS AREA IS RESTRICTED UNTIL PUBLIC SEWER IS AVAILABLE. THIS EASEMENT SHALL BECOME NULL AND VOID UPON CONNECTION TO A PUBLIC SEWAGE SYSTEM. THE COUNTY HEALTH OFFICER SHALL HAVE THE AUTHORITY TO GRANT ADJUSTMENTS TO THE PRIVATE SEWAGE EASEMENT. ANY CHANGES TO A PRIVATE SEWAGE EASEMENT SHALL REQUIRE A REVISED PERCOLATION CERTIFICATION PLAN. RECORDATION OF A MODIFIED EASEMENT PLAT SHALL NOT BE NECESSARY.

3. EXACT LENGTH OF SEPTIC TRENCHES ARE BE DETERMINED BY THE HEALTH DEPARTMENT AT THE TIME OF PRECONSTRUCTION INSPECTION.

4. SOIL FROM THE TRENCHING OF THE SEPTIC AREA IS TO BE PLACED ON THE UPHILL SIDE OF THE EXCAVATION FOR EACH INDIVIDUAL LOT.

5. SEDIMENT AND EROSION CONTROLS WERE APPROVED BY HOWARD SOIL CONSERVATION DISTRICT UNDER GP 10-74 AND SHALL COMPLY WITH THE 1994 MARYLAND STANDARDS AND SPECIFICATIONS FOR SOIL EROSION AND SEDIMENT CONTROL.

6. THE EXISTING WELL (TAG NO.HO-94-4071) SHOWN ON THIS PLAN HAS BEEN FIELD LOCATED BY ESE CONSULTANTS AND IS ACCURATELY SHOWN.

7. THE SWM FOR LOT 32 IS MANAGED BY SWM BMP POND #1 AS SHOWN ON SHEET 5 OF 22 OF THE 05-029 PLANS.

8. DRIVEWAY CULVERT- PER PLAN 05-029,

INV @ HSE	590.20
GROUND AT HSE	594.0
INV. IN @ TANK	589.8
INV OUT @ TANK	589.5
TOP OF TANK	590.5
GROUND OVER TANK	593.0
INV IN @ PUMP PREASURE TO D BOX	589.3

INV IN @ D BOX	595.3
INVT OUT @ D BOX	595.0
GROUND @ D BOX	599.0

ADDRESS: 13904 RYON DRIVE GLENELG, MD 21737

PERMIT PLOT PLAN LOT #32 HOPKINS CHOICE LIBER 07504, FOLIO 0437

PLAT No. 17903 FOURTH ELECTION DISTRICT HOWARD COUNTY, MARYLAND

SCALE: 1"=40' JOB#: 2975 FILE: 2975_LOT_32 PP DRAWN: MJB