

APPLICATION

PERCOLATION TESTING

A 516525

P _____

HOWARD COUNTY HEALTH DEPARTMENT
BUREAU OF ENVIRONMENTAL HEALTH
3525-H ELLICOTT MILLS DRIVE/ELLICOTT CITY, MARYLAND 21043
TELEPHONE: 313-2840

DISTRICT _____

DATE _____

TO: THE COUNTY HEALTH OFFICER
ELLICOTT CITY, MARYLAND

I HEREBY APPLY FOR THE NECESSARY TEST PRIOR TO APPLICATION FOR PERMIT TO CONSTRUCT (OR RECONSTRUCT) A SEWAGE DISPOSAL SYSTEM

PROPERTY OWNER EDWINA S. DASCHUK

ADDRESS 10290 CAVEY LANE PHONE 410.465.8298

AGENT OR PROSPECTIVE BUYER HAILEY DEVELOPMENT, LC

ADDRESS 3905 NATIONAL DRIVE, SUITE 105 PHONE 301.476.7715

PROPERTY LOCATION:

SUBDIVISION DASCHUK PROPERTY LOT NO. 2, 1 3

ROAD AND DESCRIPTION CAVEY LANE

TAX MAP 11 PARCEL # 32

SIZE OF LOT 1 ACRE TYPE BLDG. SINGLE FAMILY DWELLING
(SINGLE FAMILY DWELLING OR COMMERCIAL)

THE SYSTEM INSTALLED UNDER THIS APPLICATION IS ACCEPTABLE ONLY UNTIL PUBLIC FACILITIES BECOME AVAILABLE. I FULLY UNDERSTAND THE FEE CONNECTED WITH THE FILING OF THIS PERC TEST APPLICATION IS NON-REFUNDABLE UNDER ANY CIRCUMSTANCES. I ALSO AGREE TO COMPLY WITH ALL M.O.S.H.A. REQUIREMENTS IN TESTING THIS LOT. Phoebe Adams
(SIGNATURE OF APPLICANT)

APPROVED BY _____ FOR _____ DATE _____

DISAPPROVED BY _____ FOR _____ DATE _____

HOLD PENDING FURTHER TESTS _____

REASONS FOR REJECTION OR HOLDING _____

PERCOLATION TEST PLAT/PRELIMINARY PLAT - TITLE OR I.D. # _____ DATE _____

SITE DEVELOPMENT PLAN/FINAL PLAT - TITLE OR I.D. # _____ DATE _____

THIS IS NOT A PERMIT

APPLICATION

PERCOLATION TESTING

A 516525

P _____

HOWARD COUNTY HEALTH DEPARTMENT
BUREAU OF ENVIRONMENTAL HEALTH
3525-H ELLICOTT MILLS DRIVE/ELLICOTT CITY, MARYLAND 21043
TELEPHONE: 313-2840

DISTRICT _____

DATE _____

TO: THE COUNTY HEALTH OFFICER
ELLICOTT CITY, MARYLAND

I HEREBY APPLY FOR THE NECESSARY TEST PRIOR TO APPLICATION FOR PERMIT TO CONSTRUCT (OR RECONSTRUCT) A SEWAGE DISPOSAL SYSTEM

PROPERTY OWNER EDWINA S. DASCHUK

ADDRESS 10290 CAVEY LANE PHONE 410.465.8298

AGENT OR PROSPECTIVE BUYER HAILEY DEVELOPMENT, LC

ADDRESS 3905 NATIONAL DRIVE, SUITE 105 PHONE 301.476.7715

PROPERTY LOCATION:

SUBDIVISION DASCHUK PROPERTY LOT NO. 21 3

ROAD AND DESCRIPTION CAVEY LANE

TAX MAP 11 PARCEL # 32

SIZE OF LOT 1 ACRE TYPE BLDG. SINGLE FAMILY DWELLING
(SINGLE FAMILY DWELLING OR COMMERCIAL)

THE SYSTEM INSTALLED UNDER THIS APPLICATION IS ACCEPTABLE ONLY UNTIL PUBLIC FACILITIES BECOME AVAILABLE. I FULLY UNDERSTAND

FEE CONNECTED WITH THE FILING OF THIS PERC TEST APPLICATION IS NON-REFUNDABLE UNDER ANY CIRCUMSTANCES. I ALSO AGREE

COMPLY WITH ALL M.O.S.H.A. REQUIREMENTS IN TESTING THIS LOT. INSE AGENT
(SIGNATURE OF APPLICANT)

APPROVED BY _____ FOR _____ DATE _____

DISAPPROVED BY _____ FOR _____ DATE _____

HOLD PENDING FURTHER TESTS _____

REASONS FOR REJECTION OR HOLDING _____

PERCOLATION TEST PLAT/PRELIMINARY PLAT - TITLE OR I.D. # _____ DATE _____

SITE DEVELOPMENT PLAN/FINAL PLAT - TITLE OR I.D. # _____ DATE _____

THIS IS NOT A PERMIT

APPLICATION

PERCOLATION TESTING

A 516525

P _____

HOWARD COUNTY HEALTH DEPARTMENT
BUREAU OF ENVIRONMENTAL HEALTH
3525-H ELLICOTT MILLS DRIVE/ELLICOTT CITY, MARYLAND 21043
TELEPHONE: 313-2840

DISTRICT _____

DATE _____

TO: THE COUNTY HEALTH OFFICER
ELLICOTT CITY, MARYLAND

I HEREBY APPLY FOR THE NECESSARY TEST PRIOR TO APPLICATION FOR PERMIT TO CONSTRUCT (OR RECONSTRUCT) A SEWAGE DISPOSAL SYSTEM.

PROPERTY OWNER EDWINA S. DASCHUK

ADDRESS 10290 CAVEY LANE PHONE 410.465.8298

AGENT OR PROSPECTIVE BUYER HAILEY DEVELOPMENT

ADDRESS 3905 NATIONAL DRIVE SUITE 105 PHONE 301.476.7715

PROPERTY LOCATION:

SUBDIVISION DASCHUK Property LOT NO. 1

ROAD AND DESCRIPTION CAVEY LANE

TAX MAP 11 PARCEL # 32

SIZE OF LOT 1 ACRE TYPE BLDG. SFD
(SINGLE FAMILY DWELLING OR COMMERCIAL)

THE SYSTEM INSTALLED UNDER THIS APPLICATION IS ACCEPTABLE ONLY UNTIL PUBLIC FACILITIES BECOME AVAILABLE. I FULLY UNDERSTAND THE FEE CONNECTED WITH THE FILING OF THIS PERC TEST APPLICATION IS NON-REFUNDABLE UNDER ANY CIRCUMSTANCES. I ALSO AGREE TO COMPLY WITH ALL M.O.S.H.A. REQUIREMENTS IN TESTING THIS LOT. HAILEY AGENT

(SIGNATURE OF APPLICANT)

APPROVED BY _____ FOR _____ DATE _____

DISAPPROVED BY _____ FOR _____ DATE _____

HOLD PENDING FURTHER TESTS _____

REASONS FOR REJECTION OR HOLDING _____

PERCOLATION TEST PLAT/PRELIMINARY PLAT - TITLE OR I.D. # _____ DATE _____

SITE DEVELOPMENT PLAN/FINAL PLAT - TITLE OR I.D. # _____ DATE _____

THIS IS NOT A PERMIT

516525
COUNTY #

ADJ WELL

SOIL PROFILE

0' (601) (603)

Strong
org yellow
brn
micaceous
hvy Lm
Trace
Rx

5'
to
5 1/2'

tan
beige
SLm
Trace
Rx

Bottom

13'

(600)

org brn
Y brn
micaceous
SiLm-Lm
TRACE
Rx

5'

beige
Si-SiLm

Trace
Rx

Bottom

14'

(602)

Strong
Rd brn
Dense
CLm
Trace Rx


4 1/2'
to
5'

beige
micaceous
Lms-S

Trace
Rx

Bottom

14'

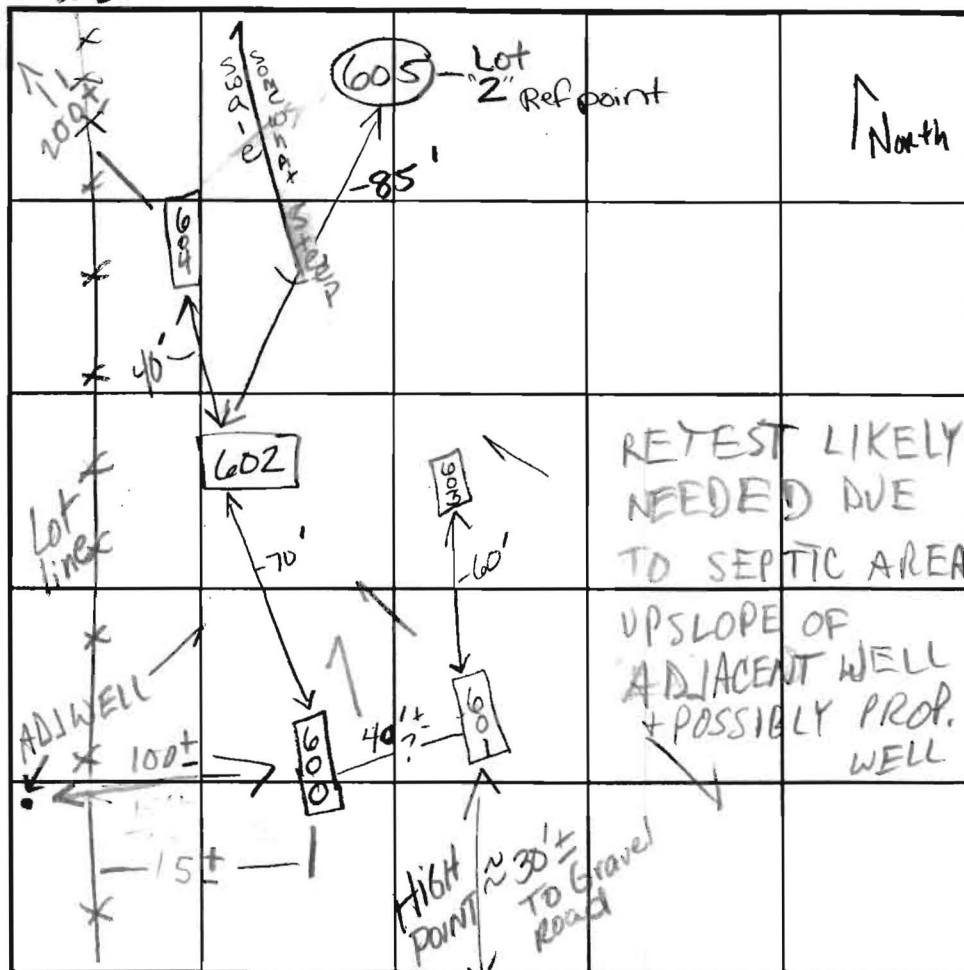

INDICATE NORTH - NAME ADJOINING ROADWAY AS BASE LINE.

Gravel Road

DATE	TEST NO.	DEPTH	PRE-WET		TEST - 1" DROP		TIME
			START	STOP	START	STOP	
5-1-02	603	Visual	See Soil Profile				EST 8 min OK
	601	5 1/2' S / 13' V	3:56:40	4:00	Pulled Out of time		EST 7 min ± OK
	602	5' S / 14' V	3:44:27	3:46:58	"	3:49:44	2+ min OK
	600	Visual	See Soil Profile				OK
	604	4' 3" / 14' V	3:33:14	3:35:00	"	3:39:00	4 min OK

REMARKS Test holes locations dug not congruent with plan locations
ie: 45' difference between field located 602, 604 and plan measurement (90'). Holes 603 & 601 25' discrepancy

TYPE OF SOIL

TESTED BY Kacie ALSO PRESENT

TRENCH DESIGN DATA: AVERAGE PERCOLATION TIME Trench Width Tony T.

INLET DEPTH MAXIMUM BOTTOM DEPTH SQ. FT/BEDROOM

SOIL PROFILE

0' (604)

org brn
hvy Lm

2 1/2'

SiLm
Trace
Rx


5'

blue
grey
SAND
Rx 510%
Sm size
(pebbles)

Bottom

14'

1. Private water and Private sewer will be used within this site.
2. ☒ This area designates a private sewage easement, of at least 10,000 SF as required by the Maryland State Department of the Environment for individual sewage disposal (COMAR 26.04.03). Improvements for any nature in this area are restricted until public sewerage is available. These easements shall become null and void upon connection to a public sewerage system. The County Health Officer shall have the authority to grant adjustments to the private sewage easement. Recordation of a modified sewage easement shall not be necessary.
3. All wells and septic fields within 100' of property's boundary have been shown.
4. The lots shown hereon comply with the minimum ownership, width and lot area as required by the Maryland Department of the Environment.

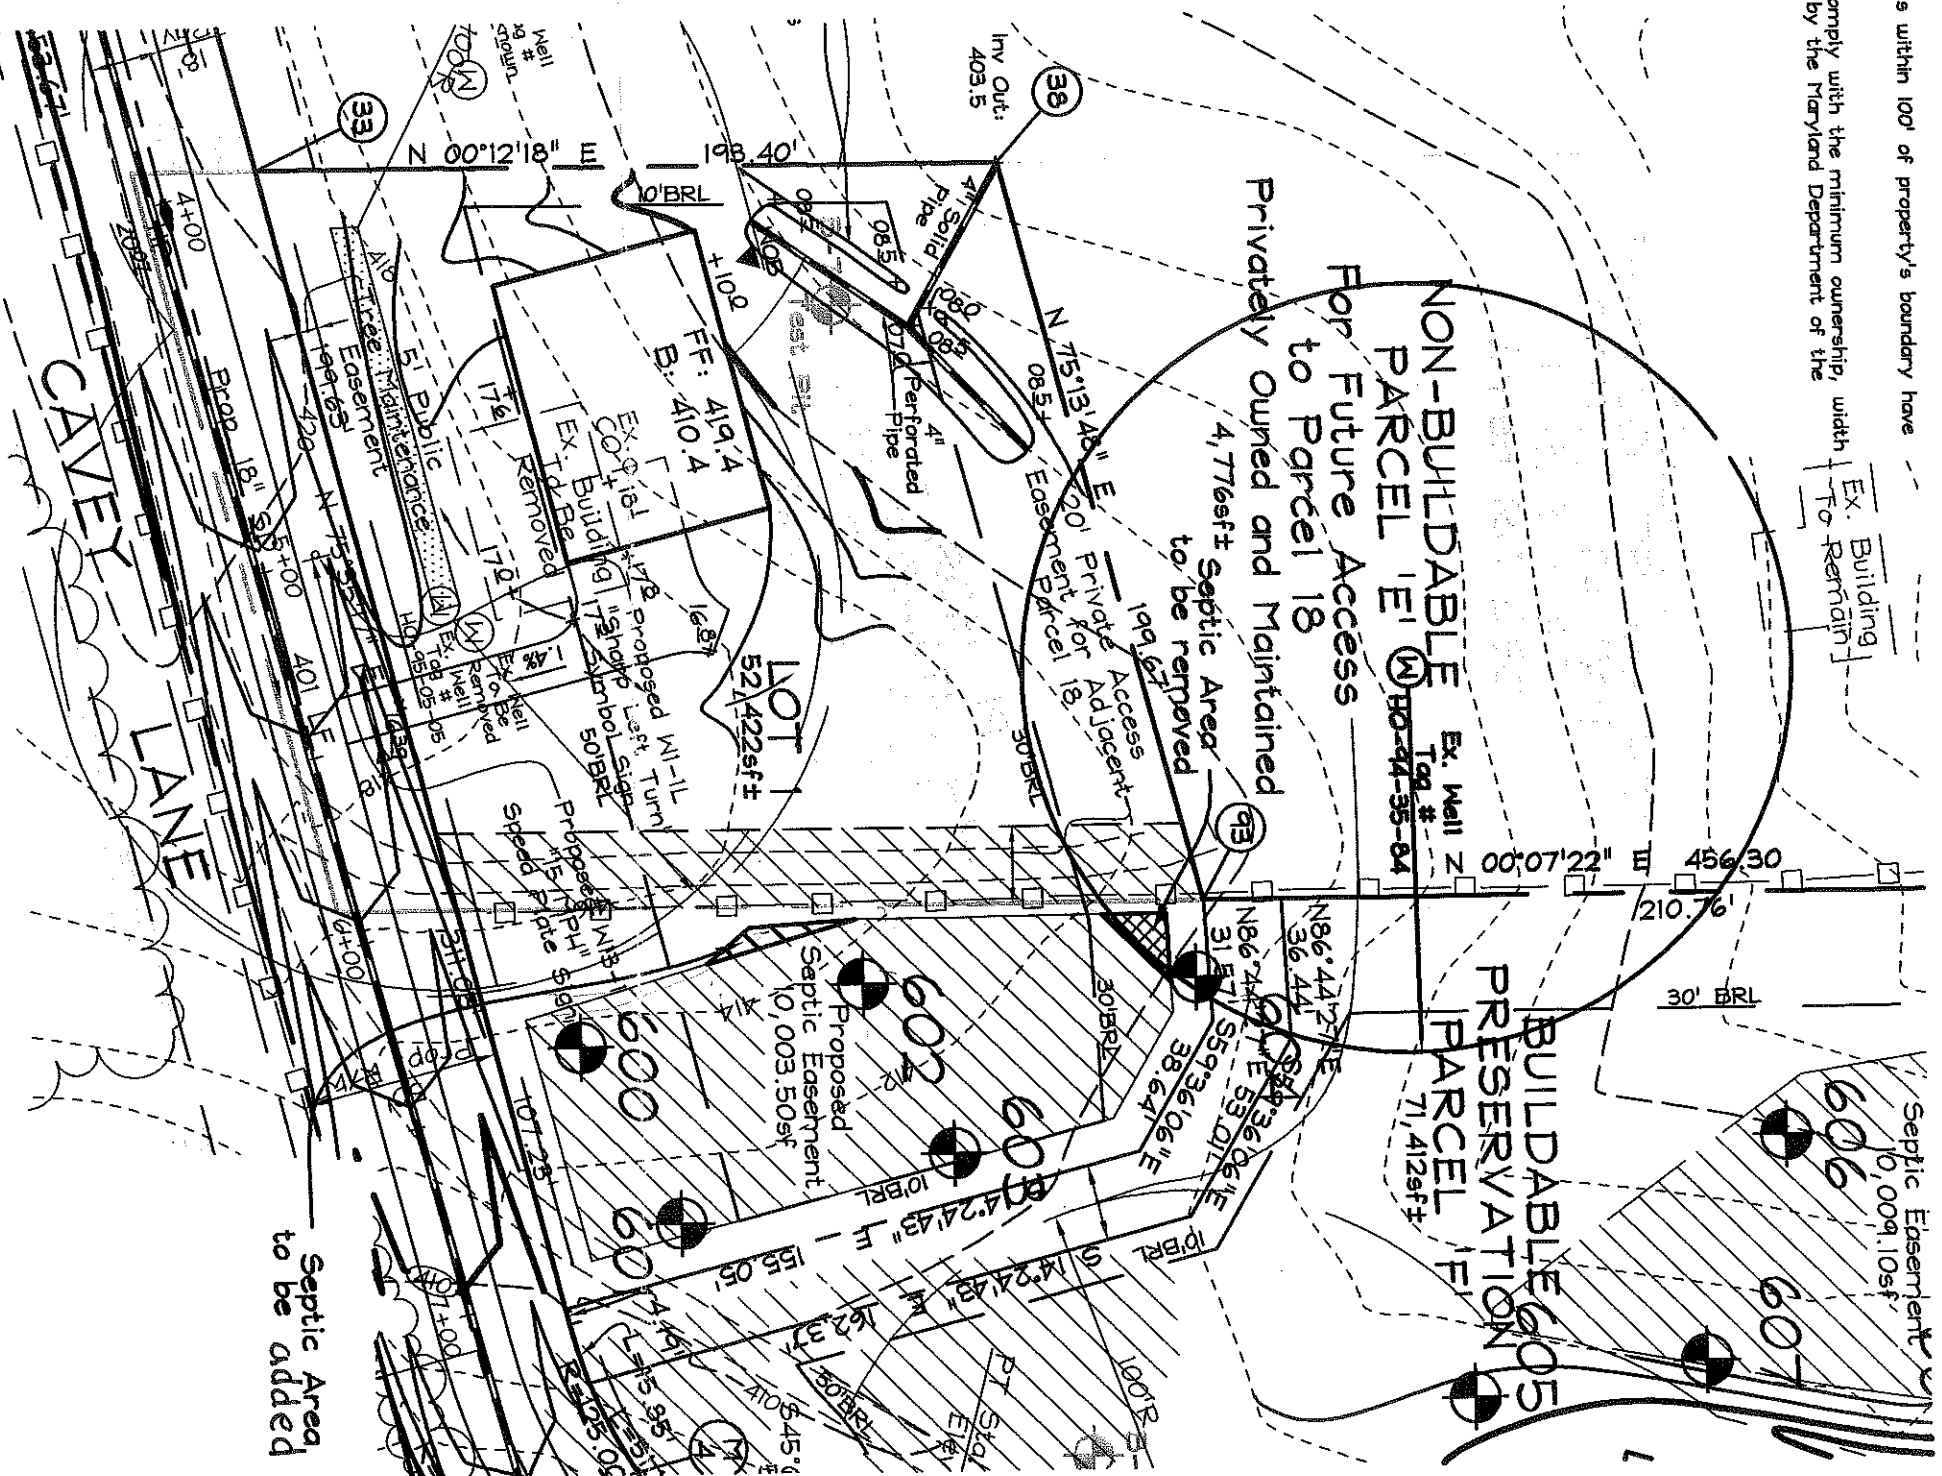


APPROVED: FOR PRIVATE WATER AND PRIVATE SEWERAGE SYSTEMS IN ACCORDANCE WITH THE MASTER PLAN OF HOWARD COUNTY

Robert L. Delaney
COUNTY HEALTH OFFICER
10/30/06
DATE

AMENDED PERC CERTIFICATION FOR LOT 1 SADDLEBROOKE FARM

TAX MAP 11 GRID 13
3RD ELECTION DISTRICT

PARCELS 19 & 32
HOWARD COUNTY, MARYLAND

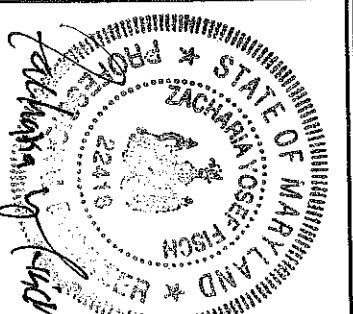

FSH Associates

Engineers Planners Surveyors

6339 Howard Lane Elkhridge, MD 21075

Tel: 410-567-5200 Fax: 410-796-1562

E-mail: info@fsn.com

DESIGN BY: ZF

DRAWN BY: SAR

CHECKED BY: ZF

SCALE: 1"=50'

DATE: Oct. 26, 2006

M.O. No.: 3312

SHEET No.: 1 OF 1

PARCEL E
For Future Access
to Parcel 18
Privately Owned and Maintained
4,775.57sf±

36
R LUKE
NSKI
E. 302
-DEO

PARCEL 19
JOHN R. AND MONICA A.
LAIRD
L. 2323 F. 244
Zoned R2-DEO
LOT 1

52,422.19sf±

Ex. CO.
Ex. Building
To Be
Removed
After Plat
Recordation

5' Public
Tree Maintenance
Easement

Ex. Well
To Remain

Proposed
Septic Easement
10,034.45sf

PARCEL
STEPHEN D. AND
WINICK
L. 1381 F.
Zoned R2

Sp-03-10
signed

