

LAYOUT 10/15/07 INSP 4 _____
INSP 2 10/16/07 INSP 5 _____
INSP 3 _____ INSP 6 _____

ISSUE DATE: 10/11/2007

P 527858

APPROVAL DATE: 10/17/07

A 516525

PERMIT

TAX ID # 03347621

ON-SITE SEWAGE DISPOSAL SYSTEM HOWARD COUNTY HEALTH DEPARTMENT BUREAU OF ENVIRONMENTAL HEALTH

Craftmark Homes, Inc.

IS PERMITTED TO INSTALL ☒ ALTER ☐

ADDRESS: 6820 Elm Street, Ste 102
McLean VA 22101

PHONE NUMBER: 703-928-6531

SUBDIVISION: Saddlebrook Farm

LOT NUMBER: 8

ADDRESS: 10164 Saddlebrook Farms

PROPERTY OWNER: Shalehearth Lc

SEPTIC TANK CAPACITY (GALLONS): 2000

OUTLET BAFFLE FILTER REQUIRED ☐

PUMP CHAMBER CAPACITY (GALLONS): _____

COMPARTMENTED TANK REQUIRED ☒

NUMBER OF BEDROOMS: 4

SQUARE FEET PER BEDROOM: _____

LINEAR FEET OF TRENCH REQUIRED: 143

TRENCHES:	Trench to be 2.0 feet wide. Inlet 5.0 feet below original grade. Bottom maximum depth 7.0 feet below original grade. Effective area begins at 5.0 feet below original grade. 2.0 feet of stone below distribution pipe.
LOCATION:	Set distribution box at top-center or at southwest (top-left) corner of easement. Install 1x45' & 2x50' trenches from southwest easement boundary.
NOTES:	Install per plan unless directed by HCHD. Layout required prior to installation. Stone tickets must be available for inspectors. Stake easement corners

PLANS APPROVED: Sara Fegel

DATE: 7/10/07

NOTE: PERMIT VOID AFTER 2 YEARS

NOTE: CONTRACTOR RESPONSIBLE FOR SCHEDULING A PRE-CONSTRUCTION INSPECTION FOR ALL INSTALLATIONS

NOTE: WATERTIGHT SEPTIC TANKS REQUIRED

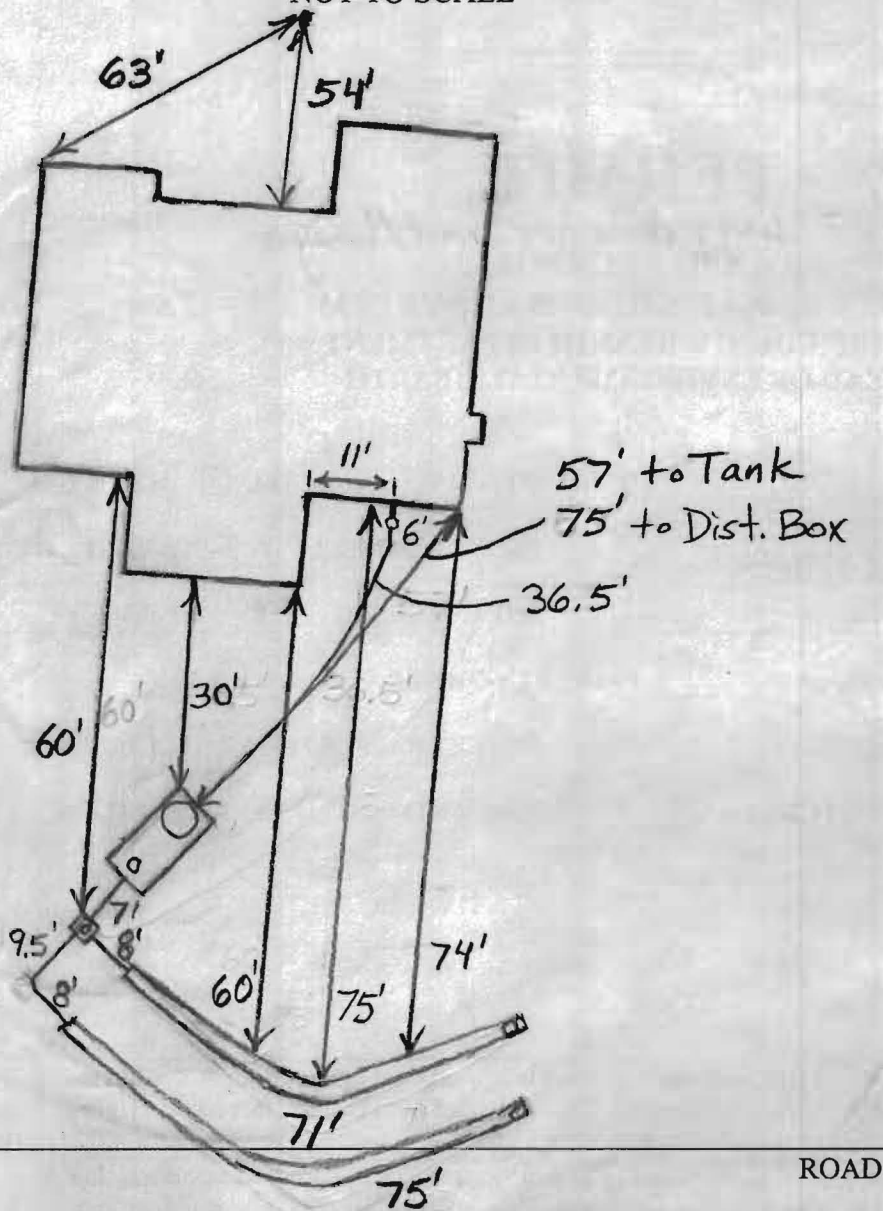
NOTE: ALL PARTS OF SEPTIC SYSTEM SHALL BE 100 FEET FROM ANY WATER WELL

NOTE: MANHOLE RISERS REQUIRED ON ALL SEPTIC TANKS AND PUMP CHAMBERS UNLESS SPECIFICALLY AUTHORIZED

**NEITHER THE HOWARD COUNTY COUNCIL NOR THE HEALTH DEPARTMENT IS
RESPONSIBLE FOR THE SUCCESSFUL OPERATION OF ANY SYSTEM
PERMITTEE RESPONSIBLE FOR OBTAINING FINAL APPROVAL ON THIS PERMIT
CALL 410-313-1771 FOR INSPECTION OF SEPTIC SYSTEM**

H0-95-0338

NOT TO SCALE

**TRENCH/DRAINFIELD DATA**

WIDTH	INLET	BOTTOM
2'	5'	7'

NUMBER OF TRENCHES 2TOTAL LENGTH 146'ABSORPTION AREA 292DISTRIBUTION BOX LEVEL LevelersDISTRIBUTION BOX BAFFLE YesDISTRIBUTION BOX PORT Yes**SEPTIC TANK DATA**SEPTIC TANK 1 LEVEL YesCAPACITY 2000 GALSEAM LOC Top2-Comp. TANK LID DEPTH 0.5'-2'BAFFLES YesBabylon BAFFLE FILTER NoMANHOLE LOC Front6" PORT LOC RearWATERTIGHT TEST NoSEPTIC TANK 2 LEVEL N/A

CAPACITY _____ GAL

SEAM LOC _____

TANK LID DEPTH _____

BAFFLES _____

BAFFLE FILTER _____

MANHOLE LOC _____

6" PORT LOC _____

WATERTIGHT TEST _____

PRE-CONSTRUCTION

10/15/07 Easement not staked. Layout cancelled. (BB)

INSTALLATION

10/16/07 Trench locations painted in field. Installer to set distribution box as shown on plan and install 2-72' trenches toward lot 7 in highest part of easement. (BB) 10/17/07 System finished. O.K. to backfill. (BB)

FINAL INSPECTOR

B. Baper

DATE OF APPROVAL

10/17/07

NOTES

1. THIS IMPROVEMENT LOCATION DRAWING:

- IS OF BENEFIT TO A CONSUMER ONLY INsofar AS IT IS REQUIRED BY A LENDER OR A TITLE INSURANCE COMPANY OR ITS AGENT IN CONNECTION WITH CONTEMPLATED TRANSFER, FINANCING OR REFINANCING;
 - IS NOT TO BE RELIED UPON FOR THE ESTABLISHMENT OR LOCATION OF FENCES, GARAGES, BUILDINGS, OR OTHER EXISTING OR FUTURE IMPROVEMENTS; AND
 - DOES NOT PROVIDE FOR THE ACCURATE IDENTIFICATION OF PROPERTY BOUNDARY LINES, BUT SUCH IDENTIFICATION MAY NOT BE REQUIRED FOR THE TRANSFER OF TITLE OR SECURING FINANCING OR REFINANCING.
2. THE LEVEL OF ACCURACY AND ACCURACY OF APPARENT SETBACK DISTANCES IS ONE FOOT, MORE OR LESS.
 3. THIS PLAT WAS PREPARED WITHOUT BENEFIT OF A TITLE REPORT.
 4. RECORD PLAT IS TITLED "SUBDIVISION PLAT OF SADDLEBROOK FARM, LOTS 1-12, NON-BUILDABLE PRESERVATION PARCELS 'A'-'D', NON-BUILDABLE PARCEL 'E', AND BUILDABLE PRESERVATION PARCEL 'F' ", AND RECORDED AS PLAT #'S 18622 THRU 18624 ON 11-03-06 AMONG THE LAND RECORDS OF HOWARD COUNTY, MD.

