

PERMIT
SEWAGE DISPOSAL SYSTEM
HOWARD COUNTY HEALTH DEPARTMENT
BUREAU OF ENVIRONMENTAL HEALTH
410-313-2640

P 515215

A 50560-C

ISSUE DATE 4/24/2001

APPROVAL DATE 4/27/01

03-325075 INDEXED

Hatfields Equipment

IS PERMITTED TO INSTALL X ALTER

ADDRESS 13785 Burntwoods Road, Glenelg, MD 21737 PHONE 301-854-6177

SUBDIVISION Lyndonbrook LOT NUMBER 3 ADDRESS 2062 St James Road

PROPERTY OWNER JAN DOYLE Williamsburg Group LLC PROPERTY OWNER'S ADDRESS P.O. Box 1018 (21044)

SEPTIC TANK CAPACITY 1250 GALLONS

PUMP CHAMBER CAPACITY N/A GALLONS

NUMBER OF BEDROOMS 4

SQUARE FEET PER BEDROOM 180

LINEAR FEET OF TRENCH REQUIRED 240

TRENCHES: Trenches to be 2 feet wide. Inlet 4 feet below original grade. Bottom maximum depth 7 feet below original grade. 3 feet of stone below distribution ~~box~~ pipe.

LOCATION: Beginning from the intersection of the 188.10' and 257.04' lot lines, begin trenches 45 feet down the 257.04' lot line and 40 feet off that same lot line. Run trenches on contour in both directions. 2/5/01 OK BB

PLANS APPROVED Amy McMillen, R.S. DATE 2/2/2001

PERMIT VOID AFTER 2 YEARS

NOTE: CONTRACTOR RESPONSIBLE FOR SCHEDULING A PRE-CONSTRUCTION INSPECTION FOR ALL INSTALLATIONS

NOTE: TOP OF SEPTIC TANKS ARE TO BE NO DEEPER THAN 3.0 FEET BELOW FINISH GRADE

NOTE: WATERTIGHT SEPTIC TANKS REQUIRED

NOTE: CLEANOUT REQUIRED EVERY 70 FEET OF SEWER LINE AND/OR AT 90° SWEEPS IN LINES FROM HOUSE TO DRAIN FIELDS, 90° ELBOWS ARE NOT ACCEPTABLE

NOTE: ALL PARTS OF SEPTIC SYSTEMS (I.E. TANK, DISTRIBUTION BOX, DRAINFIELDS) TO BE 100 FEET FROM ANY WATER WELL UNLESS OTHERWISE SPECIFICALLY AUTHORIZED

NOTE: NO ABSORPTION TRENCH TO EXCEED 100 FEET IN LENGTH UNLESS SPECIFICALLY AUTHORIZED

NOTE: ALL PIPE FROM HOUSE TO SEPTIC TANK MUST BE CAST IRON OR SCHEDULE 35/40 PVC OR ABS

NOTE: MANHOLE RISERS REQUIRED ON ALL SEPTIC TANKS AND PUMP CHAMBERS

NOTE: DISTRIBUTION BOXES MUST HAVE BAFFLES

NOTE: IF PUMPED SEPTIC SYSTEM REQUIRED, (1) SEPTIC PUMP DETAIL TO BE PROVIDED BY INSTALLER PRIOR TO ISSUANCE OF SEPTIC PERMIT (2) PUMP PERFORMANCE TEST IS NECESSARY PRIOR TO HEALTH DEPARTMENT APPROVAL OF SEPTIC PERMIT

**BUILDING PERMIT SIGNED
AND RETURNED**


9/5/2002 800138277 FINISH BASEMENT

NEITHER THE HOWARD COUNTY COUNCIL NOR THE HEALTH DEPARTMENT IS RESPONSIBLE FOR THE
SUCCESSFUL OPERATION OF ANY SYSTEM
PERMITTEE RESPONSIBLE FOR OBTAINING FINAL APPROVAL ON THIS PERMIT
CALL 410-313-2640 FOR INSPECTION OF SEPTIC SYSTEM

P515215

2062 ST. JAMES ROAD

NOT TO SCALE HO-94-1087

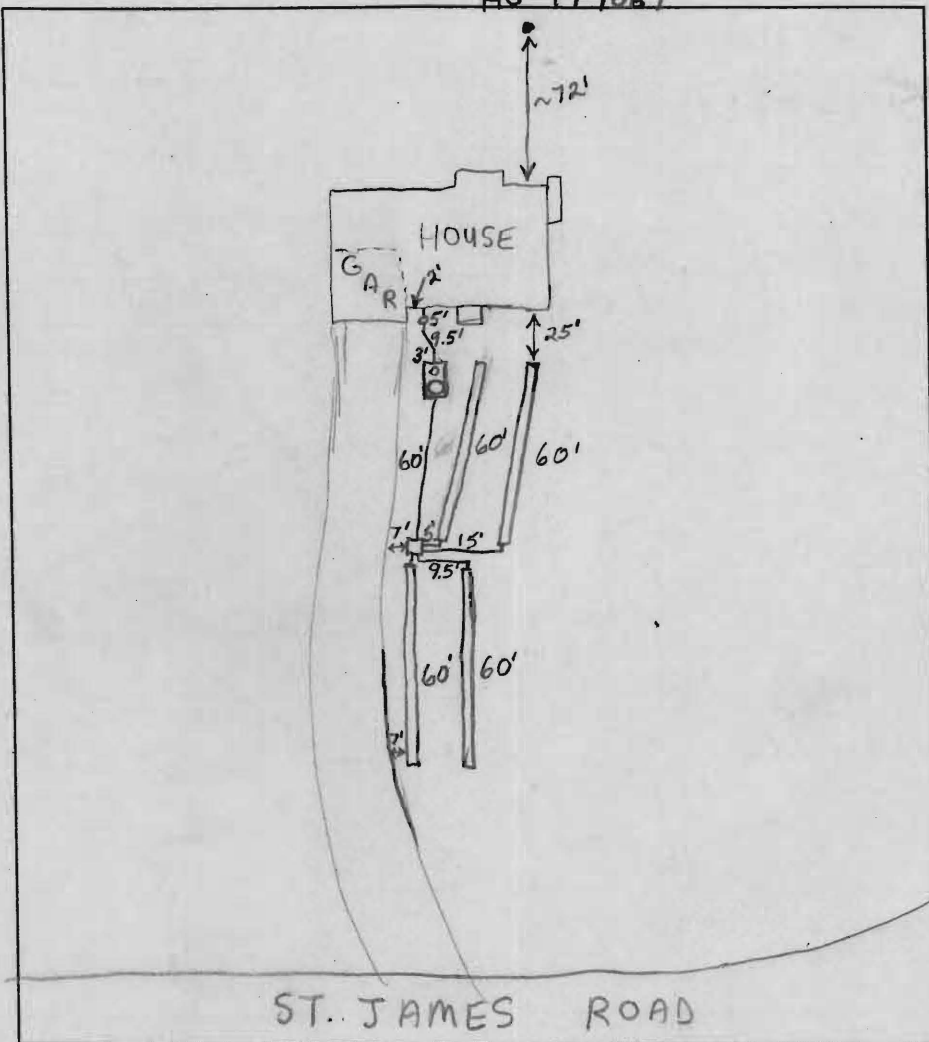

TRENCH DATA

TRENCH WIDTH 2'
TRENCH INLET DEPTH 4'
TRENCH BOTTOM DEPTH 7'
DEPTH OF STONE 3'
NUMBER OF TRENCHES 4
TOTAL TRENCH LENGTH 240'
ABSORBENT AREA 720 sq ft
DISTRIBUTION BOX LEVEL Yes
BAFFLE IN DISTRIBUTION BOX Yes

SEPTIC TANK DATA

SEPTIC TANK 1500 TS GALLONS
MANHOLE RISER Yes
6 INCH INSPECTION PORT Yes

PUMP CHAMBER DATA

PUMP CHAMBER GALLONS NA
MANHOLE RISER NA
ALARM NA
PUMP PERFORMANCE TEST NA

PRE-CONSTRUCTION INSPECTION: 4/26/01 - TANK SET, EASEMENT STATED, INSTALL TRENCHES 10' CTC

7' EASEMENT TO CONSERVE FUTURE SDA (SRK)

INSPECTION COMMENTS: 4/27/01 System satisfactory, O.K. to cover (BB)

INSPECTOR B. Baker

DATE SYSTEM APPROVED 4/27/01