

HOWARD COUNTY
PERMIT APPLICATION

PERMIT NUMBER

300 127588

Building Address 2074 ST. JAMES RD
ELLICOTT CITY, MD 21043
Suite/Apt. #: _____ SDP/WP/Petition #: 6P#99-139
Census Tract 6030 Subdivision LYNDON BROOK
Section _____ Area 3rd E. Dist Lot 6
Tax Map 15 Parcel 40 Grid 5
Zoning PP-17D Map Coordinates 35 B Lot size 50,000

Property Owner's Name DORSEY FAMILY HOMES
Address 9926 Cypressmade Dr.
City Ellicott City State Md Zip Code 21042
Home Phone 410-465-7200 Work Phone 410-465-0488
Applicant's Name & Mailing Address, (if other than stated hereon):
Phone _____ Fax _____

Existing Use Vacant Lot
Proposed Use gar family dwelling
Estimated Construction Cost \$ 85,000
Description of Work Chamberlain II model
Direct end use 2 story, full
hant, 10 BR, 2 F.B., 1 H.B. garage,
4 B.T. FIREPLACE

Contractor Company DORSEY FAMILY HOMES
Contact Person Rob Dorsey Sr Pres
Address 9926 Cypressmade Dr.
City Ellicott City State Md Zip Code 21042
License No. 189906
Phone 410-465-7200 Fax 410-465-0488

Occupant or Tenant N/A
Contact Name _____
Address _____
City _____ State _____ Zip Code _____
Phone _____ Fax _____

Engineer or Architect Company Architectural Collaborative
Contact Person Dave Robbins, Pres
Address 8380 Main St. Suite 2
City Ellicott City State Md Zip Code 21043
Phone 410-465-7500 Fax 410-465-0903

BUILDING DESCRIPTION - COMMERCIAL

Building Characteristics	Utilities
Height: _____	Water Supply: _____ Public _____ Private _____
No. of stories: _____	Sewage Disposal: _____ Public _____ Private _____
Gross area, sq. ft. per floor: _____	Electric Yes ☐ No ☐ Gas Yes ☐ No ☐
Use group: _____	Heating System: _____ Electric ☐ Oil ☐ Natural Gas ☐ Propane Gas ☐
Construction type: _____ Reinforced Concrete _____ Structural Steel _____ Masonry _____ Wood Frame _____	Sprinkler system: N/A ☐ Full _____ Partial _____ Other Suppression _____ # of Heads _____
State Certified Modular _____	

BUILDING DESCRIPTION - RESIDENTIAL

Building Characteristics	Utilities
SF Dwelling ☐ SF Townhouse ☐ Depth _____ Width _____ 1st floor: <u>52</u> <u>40</u> <u>10</u> <u>1798</u> 2nd floor: <u>52</u> <u>34</u> <u>10</u> <u>1237</u> Basement: <u>52</u> <u>34</u> <u>10</u> <u>1281</u> Finished Basement ☐ Unfinished Basement ☒ Crawl space ☐ Slab on Grade ☐ No. of Bedrooms <u>4</u> <u>BR</u> Chamberlain II model Multi-family dwellings: _____ No. of efficiency units: _____ No. of 1 BR units: <u>N/A</u> No. of 2 BR units: _____ No. of 3 BR units: _____ Other Structure: <u>40 frame 19.2</u> Dimensions: _____ Footings: <u>8" 16" concrete</u> Roof: <u>asph/f/gle</u> N/A State Certified Modular Manufactured Home	Water Supply: _____ Public _____ Private ☒ Sewage Disposal: _____ Public _____ Private ☒ Electric Yes ☒ No ☐ Gas Yes ☒ No ☐ Heating System: <u>FHA</u> Electric ☐ Oil ☐ Natural Gas ☐ Propane Gas ☐ Sprinkler system: N/A ☐ NFPA #13D _____ NFPA #13R _____ Other: _____

THE UNDERSIGNED HEREBY CERTIFIES AND AGREES AS FOLLOWS: (1) THAT HE/SHE IS AUTHORIZED TO MAKE THIS APPLICATION; (2) THAT THE INFORMATION IS CORRECT; (3) THAT HE/SHE WILL COMPLY WITH ALL REGULATIONS OF HOWARD COUNTY WHICH ARE APPLICABLE THEREON; (4) THAT HE/SHE WILL PERFORM NO WORK ON THE ABOVE REFERENCED PROPERTY NOT SPECIFICALLY DESCRIBED IN THIS APPLICATION; (5) THAT HE/SHE GRANTS COUNTY OFFICIALS THE RIGHT TO ENTER ONTO THIS PROPERTY FOR THE PURPOSE OF INSPECTING THE WORK PERMITTING AND POSTING NOTICES.

Robert L. Dorsey Sr. Pres
Applicant's Signature
DORSEY FAMILY HOMES
Title/Company

ROBERT L. DORSEY SR. PRES.
Print Name
11-29-00
Date

Checks payable to: DIRECTOR OF FINANCE OF HOWARD COUNTY
** PLEASE WRITE NEATLY AND LEGIBLY. **
- FOR OFFICE USE ONLY -

AGENCY DATE SIGNATURE APPROVAL
Land Development, DPZ _____
State Highways _____
Building Official _____
Dev. Engineering, DPZ _____
Health 12/15/00 M. Liffin
Fire Protection _____
Is Sediment Control approval required prior to issuance?
YES ☐ NO ☐

CONTINGENCY CONSTRUCTION START: ☐
ONE STOP SHOP: ☐

DPZ SETBACK INFORMATION
Front: 180 FT
Rear: 25 FT
Side: 10 FT
Side St.: 25 FT
All minimum setbacks met?
YES ☐ NO ☐
Is Entrance Permit required?
YES ☐ NO ☐
Historic District?
YES ☐ NO ☐
Lot Coverage for New Town Zone _____
SDP/Red-line approval date _____ Accepted by _____

PROPERTY ID#: 118878
Filing fee \$ 25
Permit fee \$ _____
Excise tax \$ _____
Sub-total paid \$ _____
Add'l permit fee \$ _____
TOTAL FEES \$ _____
Balance due \$ _____
Check # 1191
Validation # _____

Total linear feet of trench
required 240 feet

Width of trench(es) 2 feet


Depth of trench(es) 6 feet

Depth of stone required below
distribution pipe 3 feet

Approved Septic System Plan Howard County Health Department

JOHN C. & BONNIE D. TIERKE
P. 186
848/474

Mark Refkin 12/15/00
Signature Date

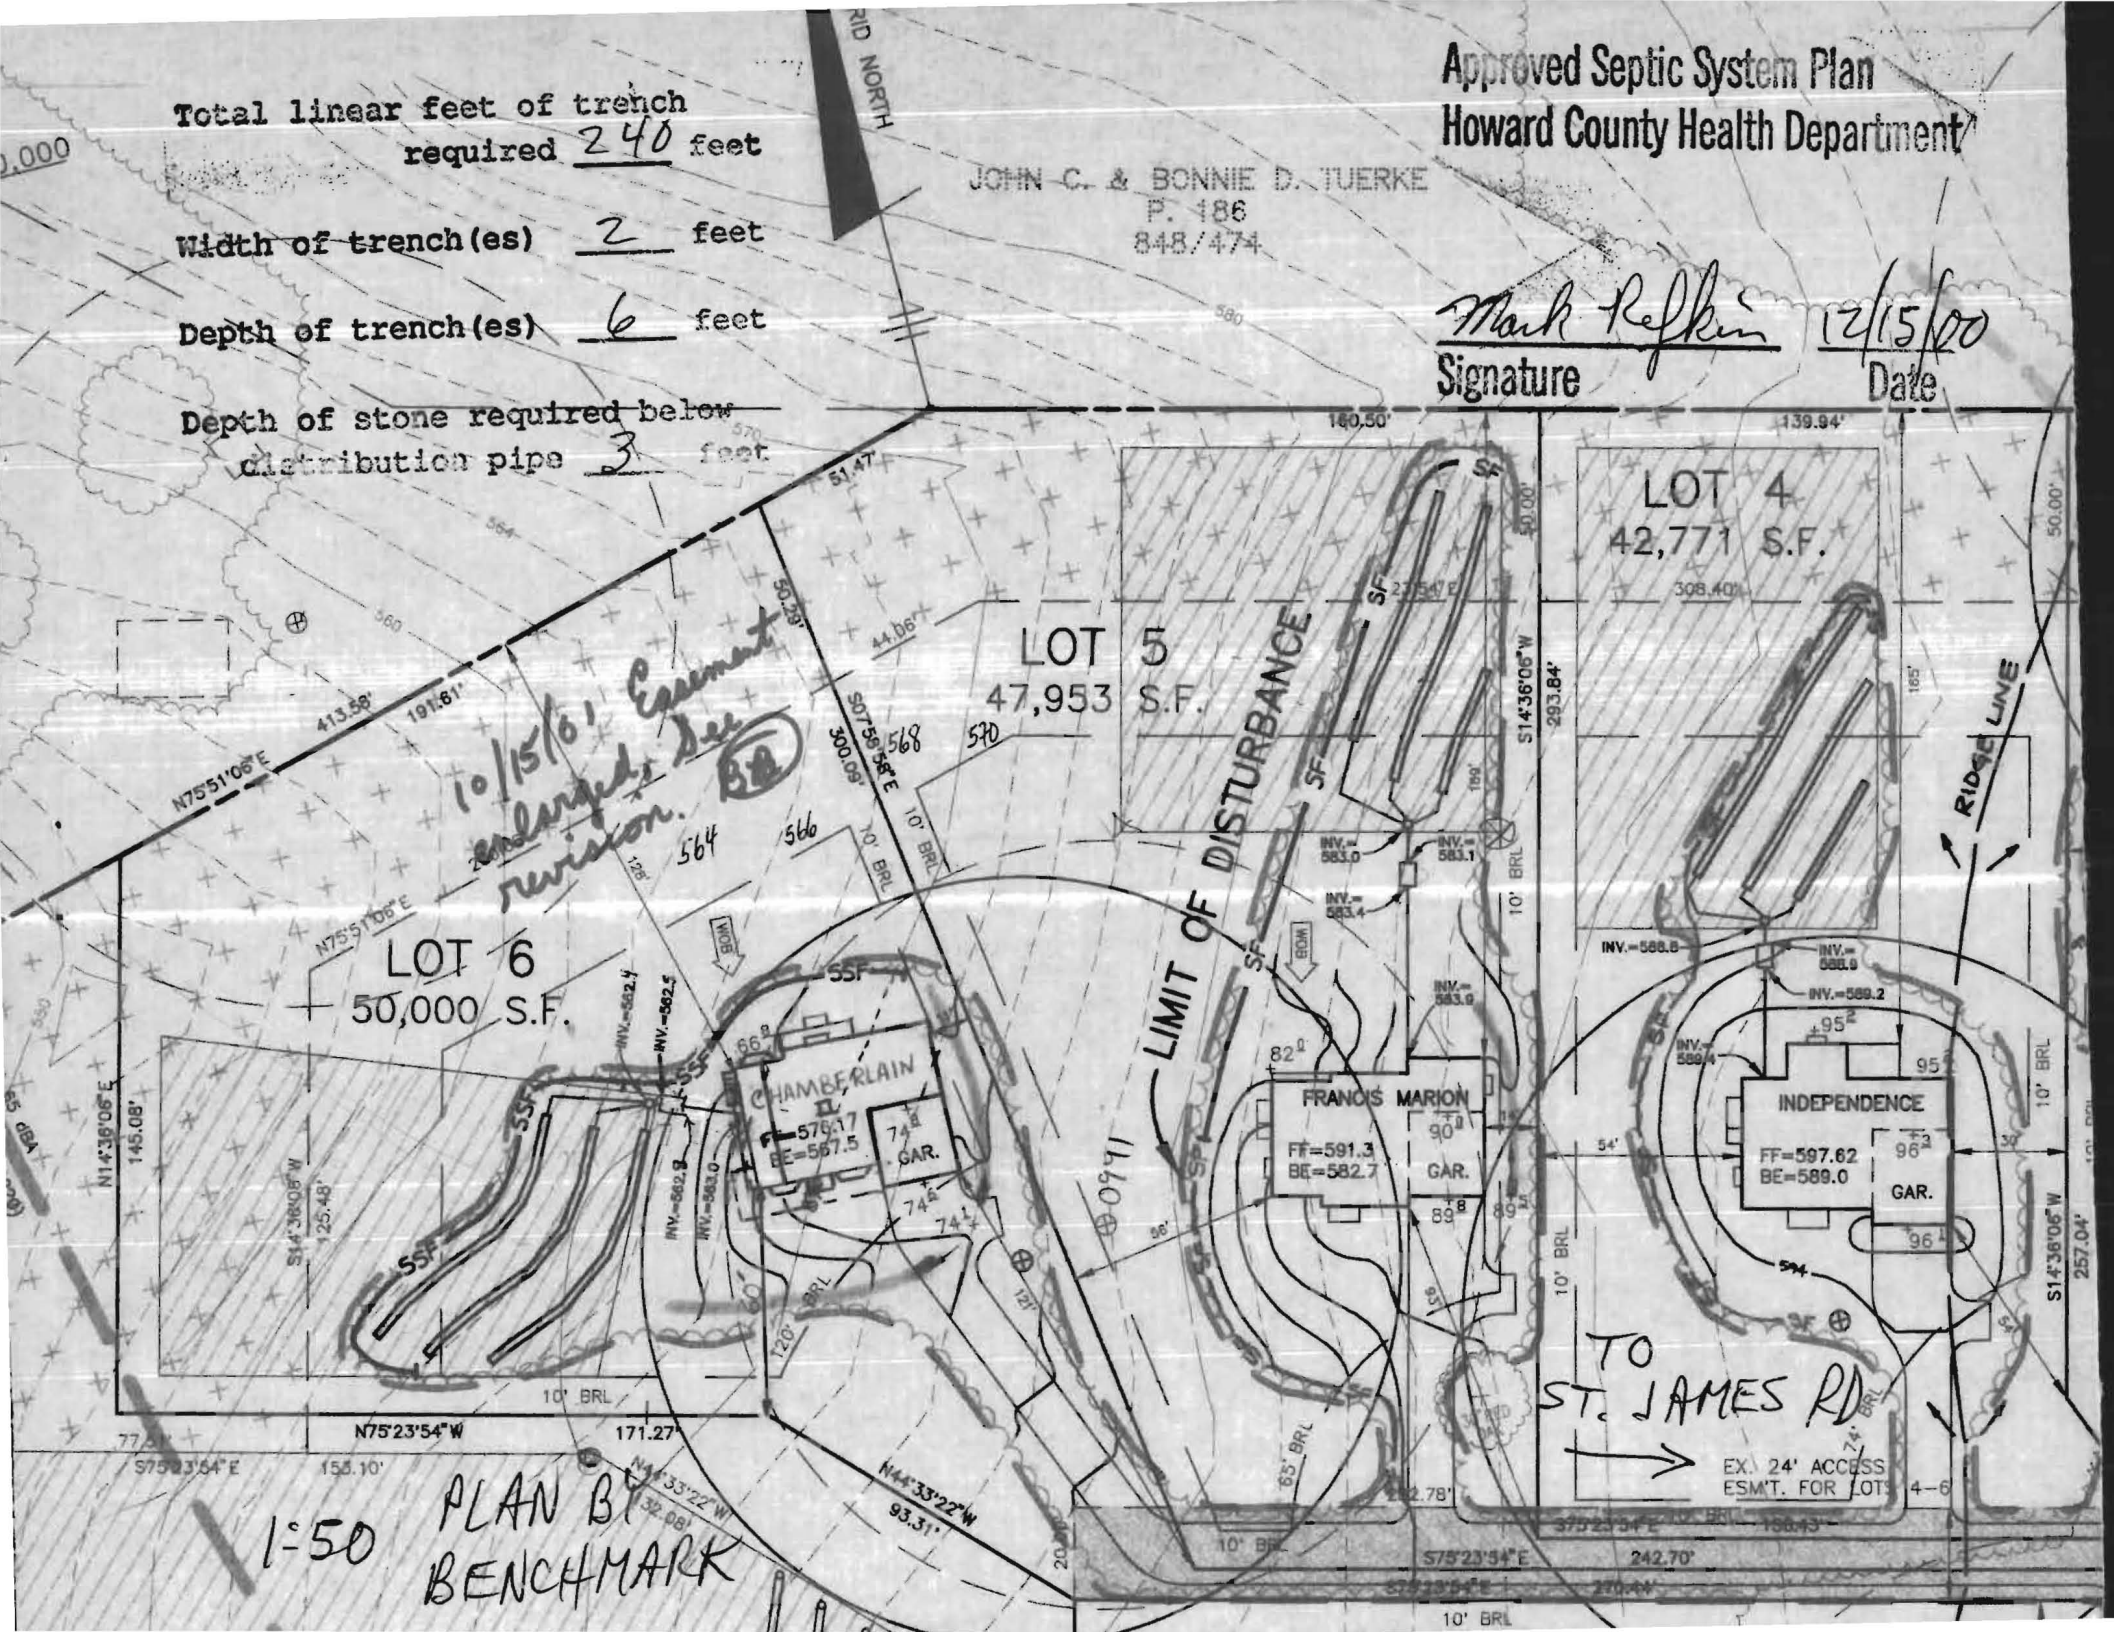

10/15/01, Easement
enlarged, see
revision. BE

1:50 PLAN BY
BENCHMARK

TO
ST. JAMES RD
→ EX. 24' ACCESS
ESMT. FOR LOTS 4-6