7/23/01- 8/2/01-Layout ASAP Final ASAP

7/31/01 10/18/01

Layout Loyout
10:00 Loyout

PERMIT03-325105

SEWAGE DISPOSAL SYSTEM

HOWARD COUNTY HEALTH DEPARTMENT

BUREAU OF ENVIRONMENTAL HEALTH

ISSUE DATE 7/13/2001

P 5/5334- A

A 50560-F


410-313-2640

APPROVAL DATE 0/18

J Joseph Gartland, Inc			IS PERMITT	TED TO INSTALL X ALTER
ADDRESS 1835 West Old Liberty Road, Westmi	nster, MD	21157		PHONE 410-875-2400
SUBDIVISION Lyndonbrook LOT N				
PROPERTY OWNER <u>Dorsey Family Homes</u> SEPTIC TANK CAPACITY 1250 GALLONS PUMP CHAMBER CAPACITY N/A GALLONS NUMBER OF BEDROOMS 10/15/01 A SQUARE FEET PER BEDROOM 180 LINEAR FEET OF TRENCH REQUIRED 240 TRENCHES: Trenches to be a feet wide left.				
RENCHES: Trenches to be 2 feet wide. Inlet 6 feet below original grade. 3 feet OCATION: Starting at the intersection distribution box 30 feet down the 1 lot line. Run (3) 80' trenches tow	et of stone be of the 93	low distri .31'/17 t line	bution box. 1.27' lot and 80 fe	lines, place the
PLANS APPROVED Mark Rifkin, R.S. O	n SRU	1a/a1	600	DATE 12/15/2000
PERMIT VOID AFTER 2 YEARS .			1	
NOTE: CONTRACTOR RESPONSIBLE FOR SCHEDULING A PRE-C	ONSTRUCTION	INSPECT	ON FOR ALL I	INSTALLATIONS
NOTE: TOP OF SEPTIC TANKS ARE TO BE NO DEEPER THAN 3.0	FEET BELOW	FINISH GR	ADE	
NOTE: WATERTIGHT SEPTIC TANKS REQUIRED				
NOTE: CLEANOUT REQUIRED EVERY 70 FEET OF SEWER LINE A ARE NOT ACCEPTABLE	ND/OR AT 90°	SWEEPS IN	I LINES FROM	HOUSE TO DRAIN FIELDS, 90° ELBOWS
NOTE: ALL PARTS OF SEPTIC SYSTEMS (I.E. TANK, DISTRIBUTION OTHERWISE SPECIFICALLY AUTHORIZED	ON BOX, DRAIN	NFIELDS) T	O BE 100 FEE	T FROM ANY WATER WELL UNLESS
NOTE: NO ABSORPTION TRENCH TO EXCEED 100 FEET IN LENG	TH UNLESS SE	PECIFICALI	LY AUTHORIZI	ED
NOTE: ALL PIPE FROM HOUSE TO SEPTIC TANK MUST BE CAST	IRON OR SCH	EDULE 35/4	40 PVC OR AB	s
NOTE: MANHOLE RISERS REQUIRED ON ALL SEPTIC TANKS AN	D PUMP CHAM	BERS		
NOTE: DISTRIBUTION BOXES MUST HAVE BAFFLES				
NOTE: IF PUMPED SEPTIC SYSTEM REQUIRED, (1) SEPTIC PUMP PERMIT (2) PUMP PERFORMANCE TEST IS NECESSARY P	DETAIL TO BE	PROVIDE	D BY INSTALL TMENT APPR	ER PRIOR TO ISSUANCE OF SEPTIC OVAL OF SEPTIC PERMIT
MEITHER THE HOWARD COUNTY COUNCIL A	OP THE HE	ALTH DE	DADTMENT	I IS DESDONISIDI E EOD THE

SUCCESSFUL OPERATION OF ANY SYSTEM
PERMITTEE RESPONSIBLE FOR OBTAINING FINAL APPROVAL ON THIS PERMIT
CALL 410-313-2640 FOR INSPECTION OF SEPTIC SYSTEM

P5/5334A

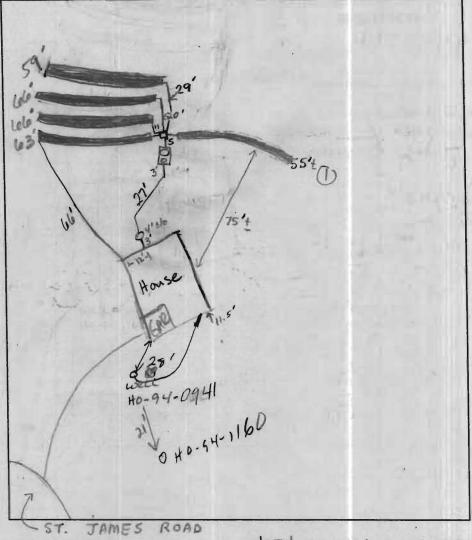

TRENCH DATA
TRENCH WIDTH
TRENCH INLET DEPTH 3-9
TRENCH BOTTOM DEPTH 6-7
DEPTH OF STONE
NUMBER OF TRENCHES 4
TOTAL TRENCH LENGTH 309±
ABSORBENT AREA 727 ++2
DISTRIBUTION BOX LEVEL
BAFFLE IN DISTRIBUTION BOX
0.00

SEPTIC TANK	DATA Baffles inv
SEPTIC TANK 125	OT.S. GALLONS
MANHOLE RISER _	on center
6 INCH INSPECTION	PORT on front
PUMP CHAMBI	ER DATA
PUMP CHAMBER GALLONS	NA
MANHOLE RISER _	NA
ALARM	NA
PUMP PERFORMAN	ICE TEST NA

PRE-CONSTRUCTION INSPECTION: 1/27/01 SDA NOT STOCKED - TOUR NOT SET PRE-CONSTRUCTION INSPECTION COMMENTS: 7/31/01-SDA STAKED, OK TO BEGIN, KEEP TRENCHES 7'ETE (10'CTC)

TO CONSERVE SEPTIC AREA, DEPENDING ON CONTOUR (RUN 4-60' TRENCHES OR 3-80'TRENCHES)
WHICHEVER SAVES MORE SDA-GRU 8-2-01 OK TO CAMP TYPINHES MY/KG

10/5/01 Jo add one 50-60' trench since house changed from H to 5 bedrooms. Trench depth to be determined by installed location and sere test notes BB)

10/18/01-OK TO COVER ALL WORK - (TRENCH1) - (SRK)

INSPECTOR Steven R. Wieg DATE SYSTEM APPROVED 10/18/01