

LAYOUT 12/26/02 12:00 INSP 4 3/11/03 12 Noon
INSP 2 3/5/03 AM INSP 5 _____
INSP 3 3/10/03 1:30 PM INSP 6 _____

ISSUE DATE: 12/24/2002

APPROVAL DATE: 3/11/03

**PERMIT
INDEXED**

P 518041

A 514939

RPS# 321022

**ON-SITE SEWAGE DISPOSAL SYSTEM
HOWARD COUNTY HEALTH DEPARTMENT
BUREAU OF ENVIRONMENTAL HEALTH**

WTC III _____ IS PERMITTED TO INSTALL ☒ ALTER ☐

ADDRESS: 1820 Gillis Falls Rd, Woodbine PHONE NUMBER: 410-489-4457

SUBDIVISION: Poplar Heights LOT NUMBER: 20-A

ADDRESS: 1000 Saint Michaels Road PROPERTY OWNER: Viking Development

SEPTIC TANK CAPACITY (GALLONS): 1250 OUTLET BAFFLE FILTER REQUIRED ☐

PUMP CHAMBER CAPACITY (GALLONS): N/A COMPARTMENTED TANK REQUIRED ☐

NUMBER OF BEDROOMS: 4

SQUARE FEET PER BEDROOM: 180

LINEAR FEET OF TRENCH REQUIRED: 240 HOUSE SERVED BY PUBLIC WATER ☐

TRENCHES:	Trench to be 3.0 feet wide. Inlet 5.0 feet below original grade. Bottom maximum depth 6.5 feet below original grade. Effective area begins at 5.0 feet below original grade. 1.5 feet of stone below distribution pipe.
LOCATION:	Place the distribution box as shown on the approved site plan. Run trenches on contour (40', 60', 70', 70').
NOTES:	

PLANS APPROVED: Steven R. Krieg OK MR SRK DATE: 9/10/2002

NOTES: PERMIT VOID AFTER 2 YEARS

CONTRACTOR IS RESPONSIBLE FOR SCHEDULING A PRE-CONSTRUCTION INSPECTION FOR ALL INSTALLATIONS
WATERTIGHT SEPTIC TANKS REQUIRED

ALL PARTS OF SEPTIC SYSTEM SHALL BE 100 FEET FROM ANY WATER WELL UNLESS SPECIFICALLY AUTHORIZED

MANHOLE RISERS REQUIRED ON ALL SEPTIC TANKS AND PUMP CHAMBERS UNLESS SPECIFICALLY AUTHORIZED

CONTRACTOR RESPONSIBLE FOR COMPLIANCE WITH APPLICABLE REGULATIONS, GUIDELINES AND THE TERMS OF THIS PERMIT


**NEITHER THE HOWARD COUNTY COUNCIL NOR THE HEALTH DEPARTMENT IS
RESPONSIBLE FOR THE SUCCESSFUL OPERATION OF ANY SYSTEM
PERMITTEE RESPONSIBLE FOR OBTAINING FINAL APPROVAL ON THIS PERMIT
ALL 410-313-2640 FOR INSPECTION OF SEPTIC SYSTEM**

**BUILDING PERMIT SIGNED
AND RETURNED**

2-14-03 B00140263-016 PRO PANE TANK

AS14939

NOT TO SCALE

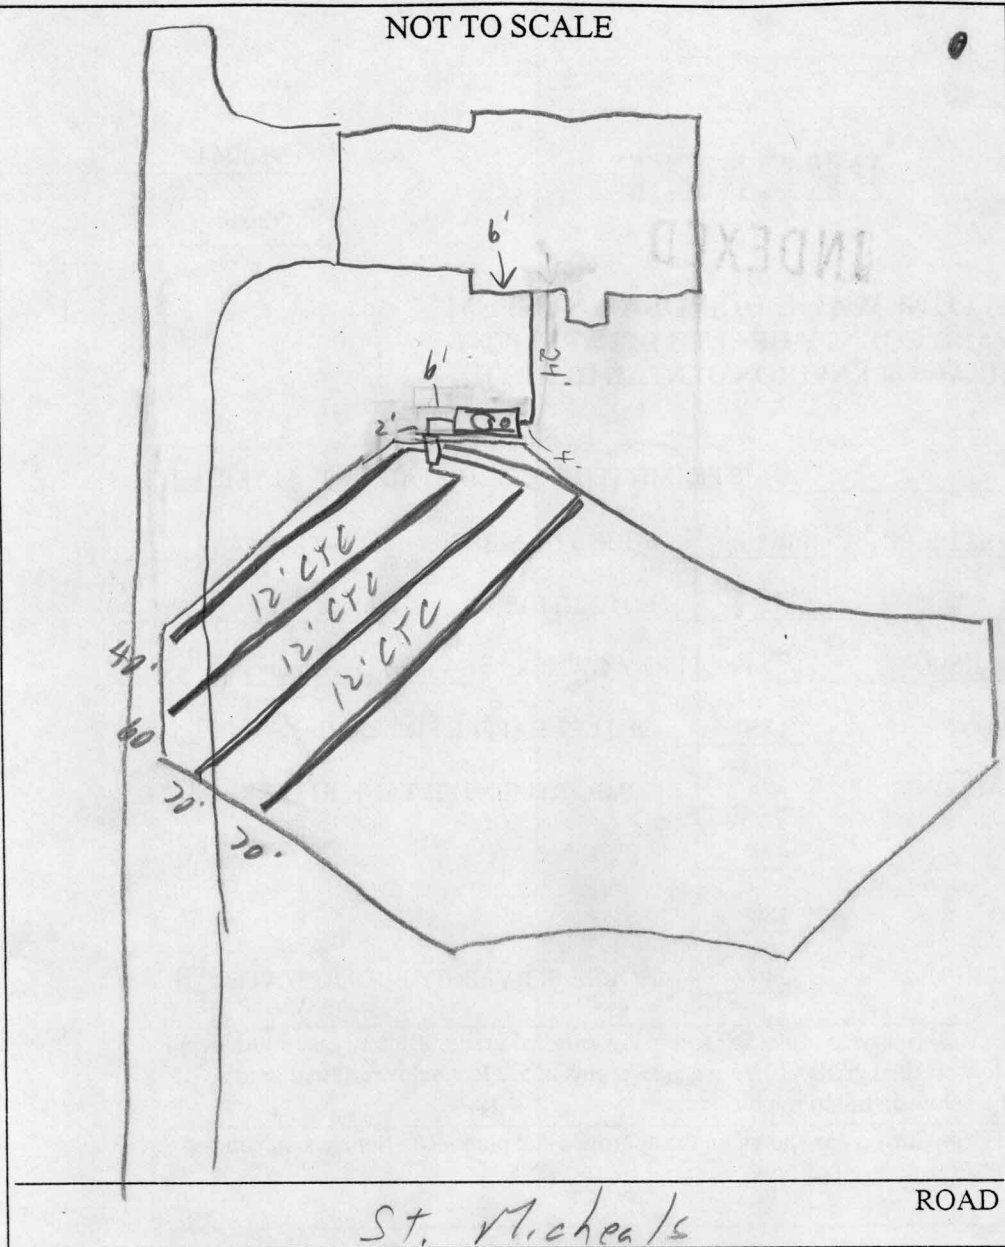

TRENCH/DRAINFIELD DATA		
WIDTH	INLET	BOTTOM
<u>3</u>	<u>5</u>	<u>6.5</u>
NUMBER OF TRENCHES		<u>4</u>
TOTAL LENGTH		<u>240</u>
ABSORPTION AREA		<u>7200</u>
DISTRIBUTION BOX LEVEL		<u>✓</u>
DISTRIBUTION BOX BAFFLE		<u>✓</u>
DISTRIBUTION BOX PORT		<u> </u>

SEPTIC TANK DATA	
SEPTIC TANK 1 LEVEL <u>✓</u>	
CAPACITY	<u>1250</u> GAL
SEAM LOC	<u>Mid</u>
TANK LID DEPTH	<u>1'</u>
BAFFLES	<u>✓</u>
BAFFLE FILTER	<u> </u>
MANHOLE LOC	<u>Center</u>
6" PORT LOC	<u>Front</u>
WATERTIGHT TEST <u> </u>	
SEPTIC TANK 2 LEVEL <u> </u>	
CAPACITY	<u> </u> GAL
SEAM LOC	<u> </u>
TANK LID DEPTH	<u> </u>
BAFFLES	<u> </u>
BAFFLE FILTER	<u> </u>
MANHOLE LOC	<u> </u>
6" PORT LOC	<u> </u>
WATERTIGHT TEST <u> </u>	

PRE-CONSTRUCTION 12/26/02 Stake on driveway missing, restake. Contour appears accurate. Measure well radius. Layout per BP. (SO)

INSTALLATION 3/4/03 - OK TO COVER 5' OF END OF TRENCHES WHICH WILL BE UNDER DRIVEWAY (TELEPHONE CONV. WITH INSTALLER) - (SRK) 3/5/03 OK to cover trenches, Mid seam tank needs to be water tightness tested. (SO) 3/11/03 Water tightness test on S.T. OK (SO)

BUILDING PERMIT SIGNED
AND RETURNED


FINAL INSPECTOR

DATE OF APPROVAL

3/11/03

THE PROPERTY SHOWN HEREON
LIES IN NO SPECIAL FLOOD HAZARD AREA
FLOOD INSURANCE RATE MAP
NO: 240044-0007 (UNPRINTED PANEL)

HOUSE
DROPPED
0.6'
WALL CHECK
OTHERWISE
OK
MR
12/24/02

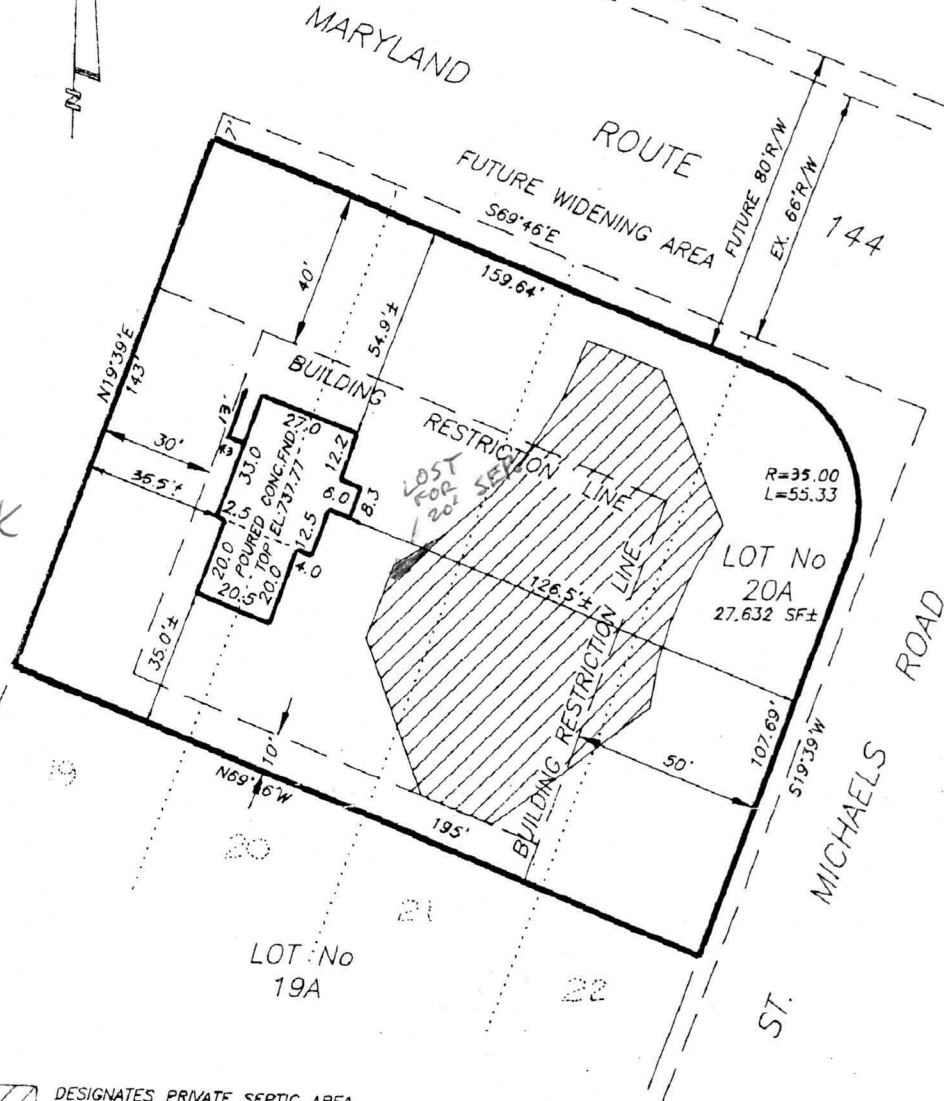

DESIGNATES PRIVATE SEPTIC AREA
PER SITE PLAN DATED APRIL 24, 2002

NOTES:

1. THIS PLAT IS OF BENEFIT TO A CONSUMER ONLY INsofar AS IT IS REQUIRED BY A LENDER OR TITLE INSURANCE COMPANY OR ITS AGENT IN CONNECTION WITH CONTEMPLATED TRANSFER, FINANCING, OR REFINANCING.
2. THIS PLAT IS NOT TO BE RELIED UPON FOR THE ESTABLISHMENT OR LOCATION OF FENCES, GARAGES, BUILDINGS, POOLS, BUILDING ADDITIONS OR OTHER EXISTING OR FUTURE IMPROVEMENTS.
3. THIS PLAT DOES NOT PROVIDE FOR THE ACCURATE IDENTIFICATION OF PROPERTY BOUNDARY LINES, BUT SUCH IDENTIFICATION MAY NOT BE REQUIRED FOR THE TRANSFER OF TITLE OR SECURING FINANCING OR REFINANCING.
4. ACCURACY OF BUILDING MEASUREMENTS: 0.1'
5. ACCURACY OF SETBACK DIMENSIONS: 0.5'

I HEREBY CERTIFY THAT I HAVE LOCATED THE IMPROVEMENTS AS SHOWN. THIS PLAT DOES NOT REPRESENT A BOUNDARY SURVEY AND CANNOT BE USED TO ESTABLISH PROPERTY LINES OR CORNERS.

SHANABERGER & LANE
8726 TOWN AND COUNTRY BLVD.
SUITE 201
ELLCOTT CITY, MD. 21043
(410) 481-0553 FAX: (410) 481-0554

FOUNDATION LOCATION DRAWING
LOT 20A
RESUBDIVISION OF LOTS 19, 20, 21 & 22
POPLAR HEIGHTS SUBDIVISION

P.B. 17/72
ELECTION DISTRICT: 4TH
DEED REFERENCE: 6538/457
COUNTY: HOWARD
SCALE: 1"=40'
DATE: NOVEMBER 11, 2002

150