

APPLICATION

PERCOLATION TESTING

A 47047

P _____

HOWARD COUNTY HEALTH DEPARTMENT
BUREAU OF ENVIRONMENTAL HEALTH
P.O. BOX 476 ELLICOTT CITY, MARYLAND 21043
TELEPHONE 461-9933

DISTRICT 4th

DATE April 12, 1991

5/7/91

TO: THE COUNTY HEALTH OFFICER
ELLICOTT CITY, MARYLAND

I, HEREBY, APPLY FOR THE NECESSARY TEST IN ORDER TO CONSTRUCT (OR RECONSTRUCT) A SEWAGE DISPOSAL SYSTEM

PROPERTY OWNER W. Lambert Cissel, Jr.

ADDRESS 3425 Hipsley Mill Road, Woodbine, MD 21797 PHONE 301-442-2463

PROSPECTIVE BUYER Same

ADDRESS _____ PHONE _____

PROPERTY LOCATION:

SUBDIVISION Scott's Delight LOT NO 2

ROAD AND DESCRIPTION 1400 ± St. Michael's Rd.

TAX MAP 7 PARCEL # 38

SIZE OF LOT 3.5 acres ± TYPE BLDG Single Family Dwelling
(SINGLE FAMILY DWELLING OR COMMERCIAL)

THE SYSTEM INSTALLED UNDER THIS APPLICATION IS ACCEPTABLE ONLY UNTIL PUBLIC FACILITIES BECOME AVAILABLE. I FULLY UNDERSTAND THE
FEE CONNECTED WITH THE FILING OF THIS PERC TEST APPLICATION IS NON-REFUNDABLE UNDER ANY CIRCUMSTANCES. I ALSO AGREE TO COMPLY
WITH ALL M.O.S.H.A. REQUIREMENTS IN TESTING THIS LOT Christine A. Richards
(SIGNATURE OF APPLICANT)

APPROVED BY _____ FOR _____ DATE _____

REJECTED BY _____ FOR _____ DATE _____

HOLD PENDING FURTHER TESTS _____ DATE _____


REASONS FOR REJECTION OR HOLDING PERC OK - HOLD FOR PLAT 6/91

HD-216

THIS IS NOT A PERMIT

Lot 2
A47047

SOIL PROFILE

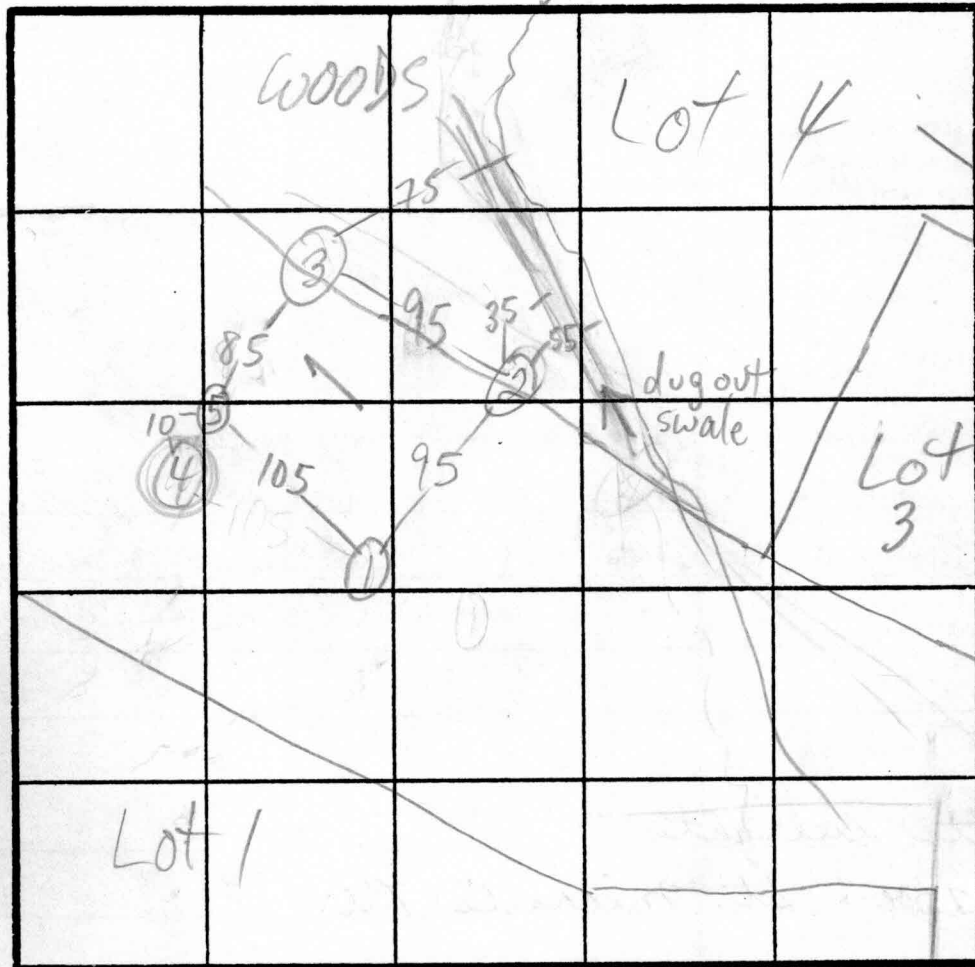

$\bar{x} = 22$
300' BR
Inlet 4'
Bottom 8'

0' red
org
sandy
cl lm
5% frags
1/2' org yel
pink silty
sa lm
10-15% frags
7' red brn
sand loam
20-25%
10' red shale
frags
12' red brn
sa lm
30-35%
red shale

5' lt. brn/red
sandy
cl loam
red brn
sand
loam
25-30%
shale frags

12' red
brn sa
cl loam
10-20%
frags
hard
shale
red brn
sa lm
30-35%
shale
frags

6' deep red
clay &
clay
loam
deep
red,
brn
pink
sa lm
5-15%
frags
13' ↓

5' red brn
sa cl lm
10-20%
frags
6' red pink
brn
sa loam
20-25%
red shale
frags


INDICATE NORTH - NAME ADJOINING ROADWAY AS BASE LINE.

DATE	TEST NO.	DEPTH	PRE-WET		TEST - 1" DROP		TIME
			START	STOP	START	STOP	
6/6/91	1 S	⑤ 6	1:39 3:16	1:54 3:21	1:54 3:21	35 min 3:31	③/4" 10 EST
	1 V	12	see profile				
	2 S	⑤ 7	1:55 2:27	2:10 2:35	2:35	REDIG 3:07	32
	2 V	13	see profile				
	3 S	⑤ 6	2:19 3:09	2:31 3:15	NO MOVEMENT		14
	3 V	12 1/2	see profile				
	4 S	⑤	2:53	slow REDIG			
	4 V	12 1/2	see profile		FALL		
	5 S	6 1/2	3:38	3:50	3:50	4:23	33
	5 V	11	see profile				

REMARKS

HOLES IN WOODS, ①-⑤ PER PLAN
USE ①-②-③-⑤

TYPE OF SOIL

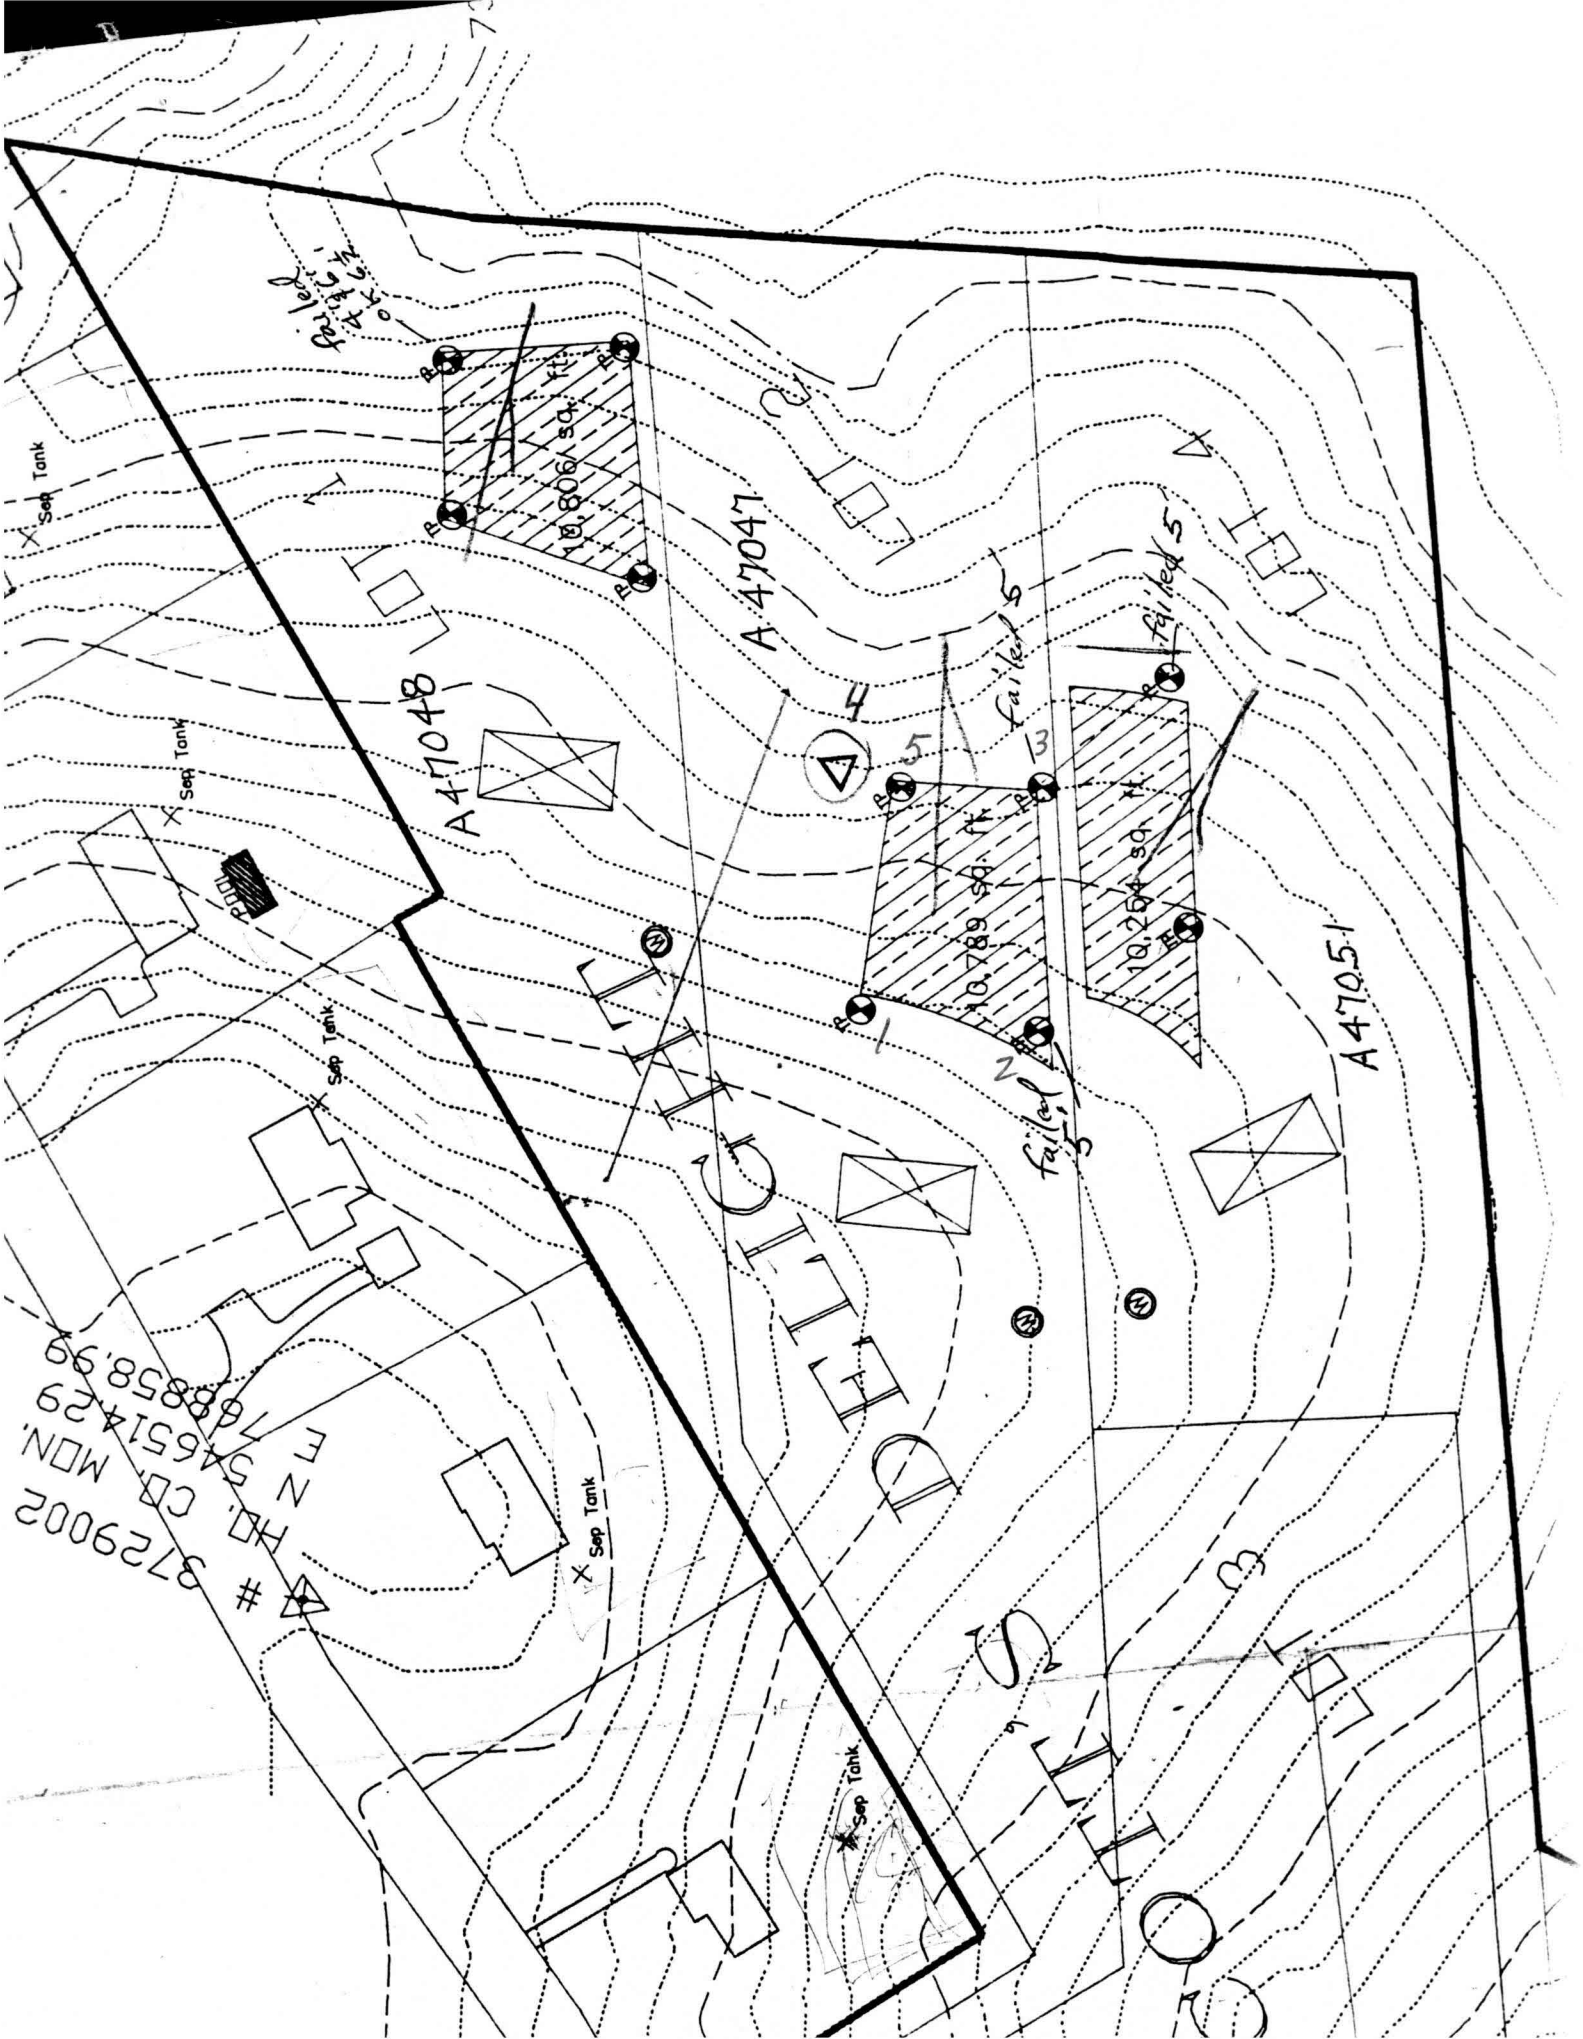

3729002
MON. 54651429
EN 768858.99
3729002

to leg 1 1/2 2 1/2 3 4 5 6 7 8 9 10

failed 5

failed 5

failed 5


A 47051

A 47047

A 47048

DELETED

TO SITE

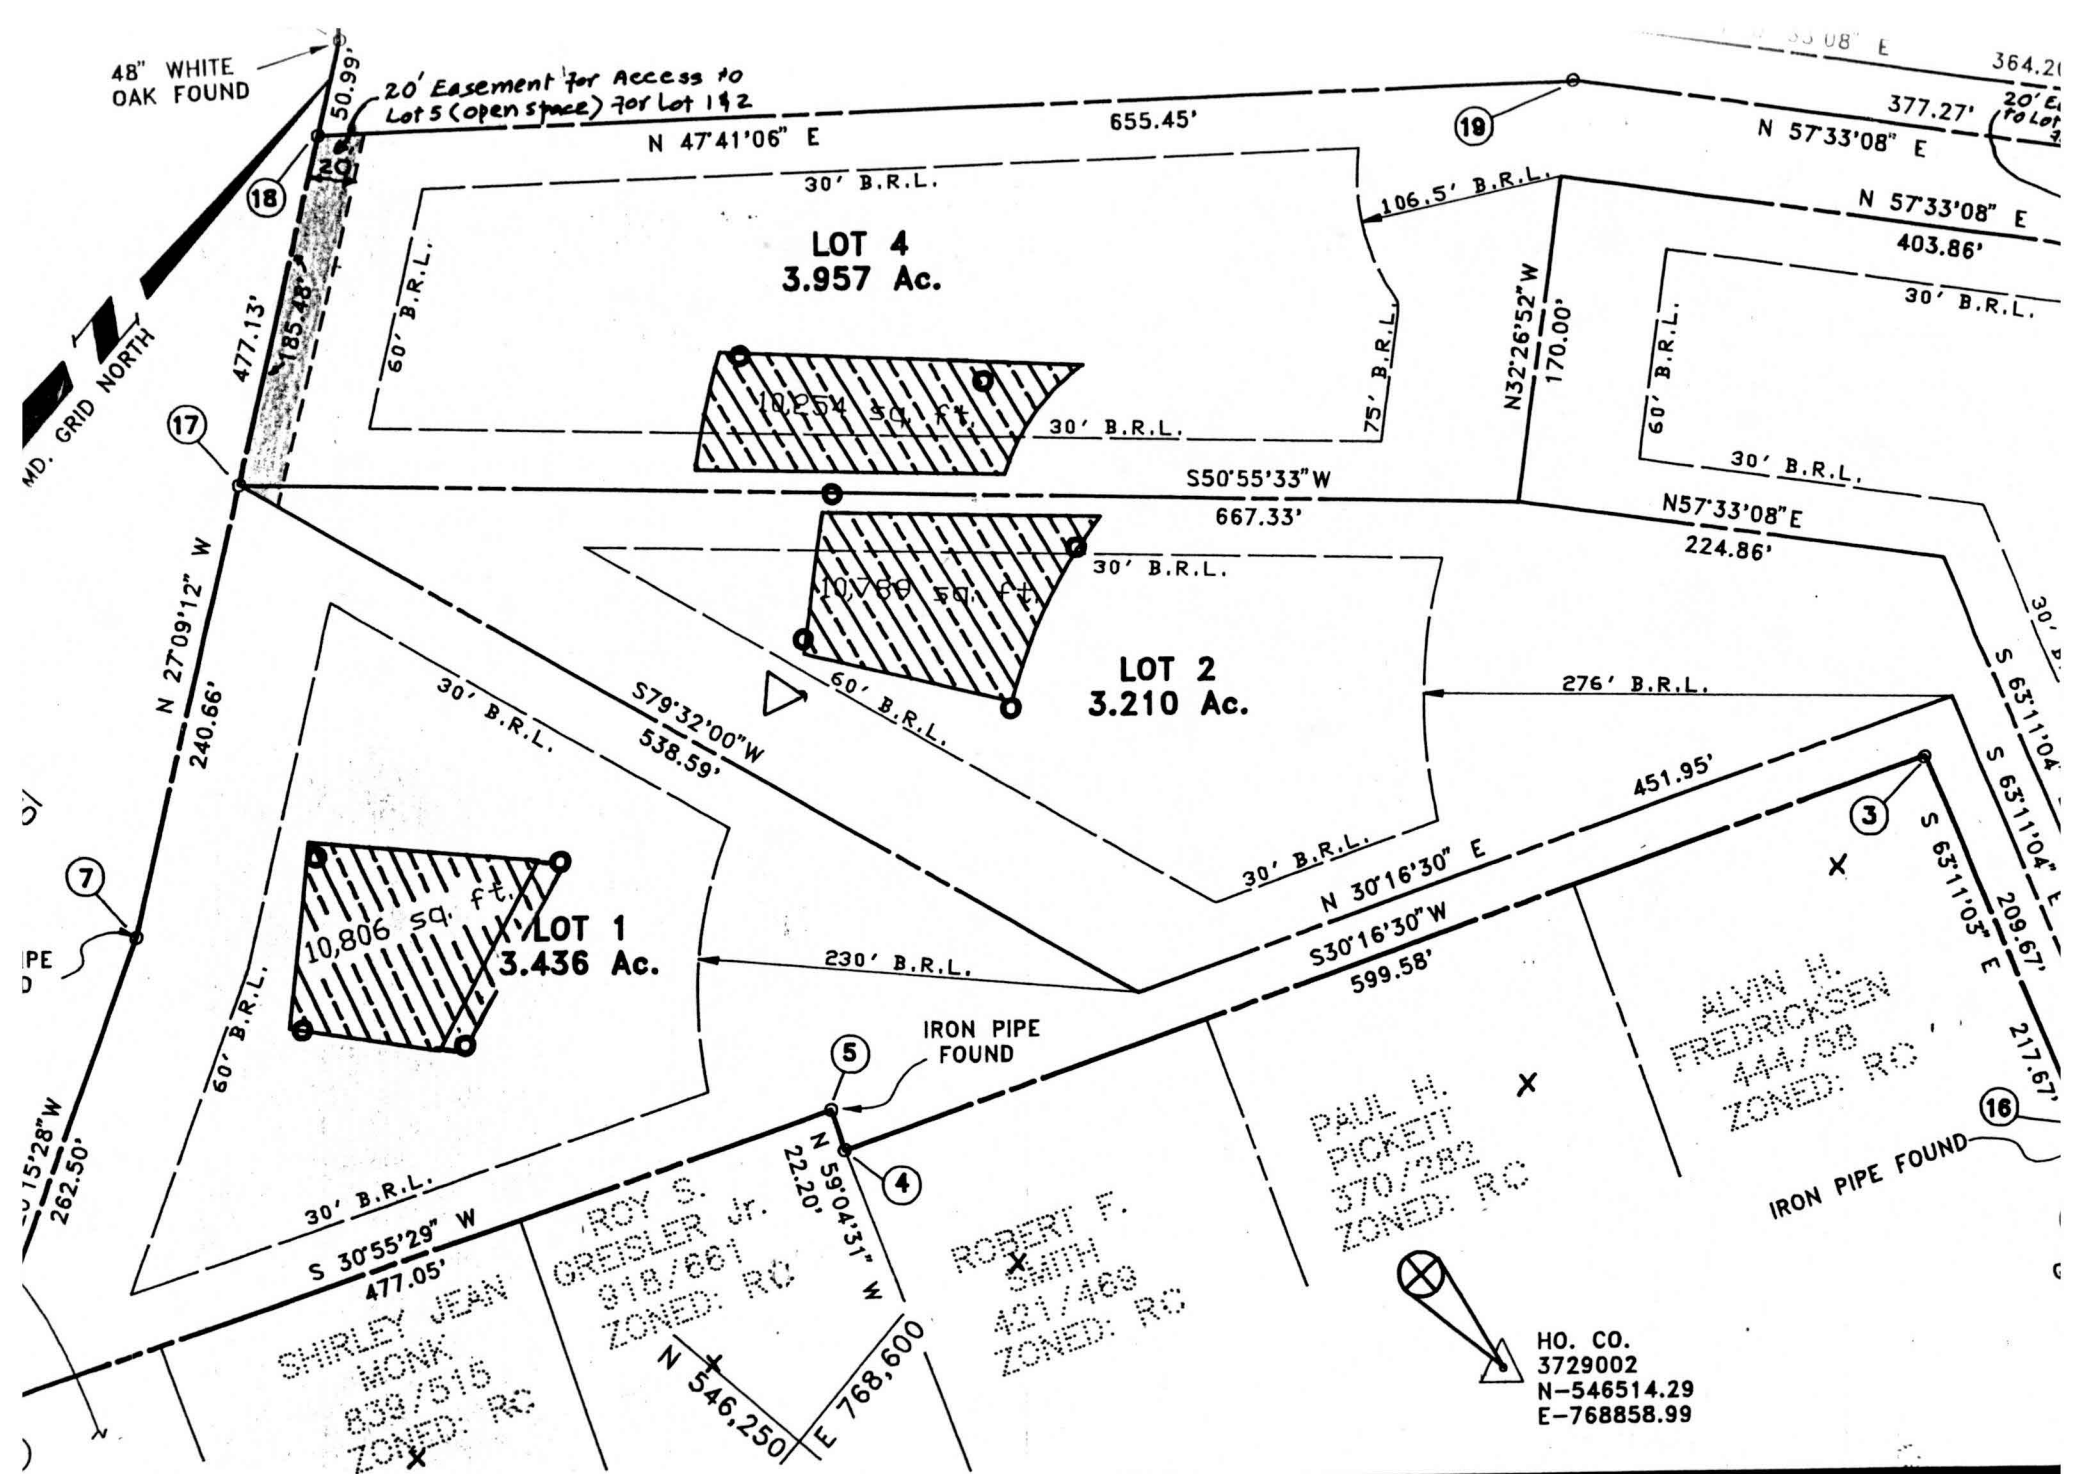

OWNER'S STATEMENT

SUR

I hereby cert