

PERMIT

(15%)

P 23359
A 20497

SEWAGE DISPOSAL SYSTEM

MARYLAND STATE DEPARTMENT OF HEALTH

HOWARD COUNTY

ELLICOTT CITY

CT 5th

TE 6/8/76

ALTER

022

INDEXED

Need a
A#

Howard W. Sadler

ADDRESS Route 2, Box 567, Maple Ave., Hanover,

A SEWAGE DISPOSAL SYSTEM LOCATED AT

SUBDIVISION White Oak Estates

ROAD 13043 St. Patrick's Court LOT 30, Sec. 1

PROPERTY OWNER Mr. Robert Johnson

ADDRESS 11552 Cashley Circle, Rockville, Maryland 20852 Phone: 881-7933

SPECIFICATIONS 4 bedrooms

DRAIN FIELD DEPTH FEET, BOTTOM AREA SQ. FT.

SEEPAGE PITS ABSORBENT SIDE WALL AREA SQ. FT.

SEPTIC TANK CAPACITY 1250 GALLONS

FOR GARBAGE GRINDER, INCREASE DISPOSAL AREA 25% & TANK CAPACITY 50%.

OTHER DRY WELL 480 sq. ft. at sidewall area below top 5 ft. of clay. Dry well inlet to be no deeper than 5 ft. and bottom of dry well to be 13 ft. deep below original grade. Place the dry well 140 ft. from the lot line which runs along St. Patrick's Court and 30 ft. from the lot line which runs along Deanna Drive. Deep ditches also satisfactory but must call this office to get approval for deep ditches.

NOTE: ALL PIPE FROM HOUSE TO DISPOSAL AREA MUST BE CAST IRON.

PERMIT VOID AFTER THREE YEARS.

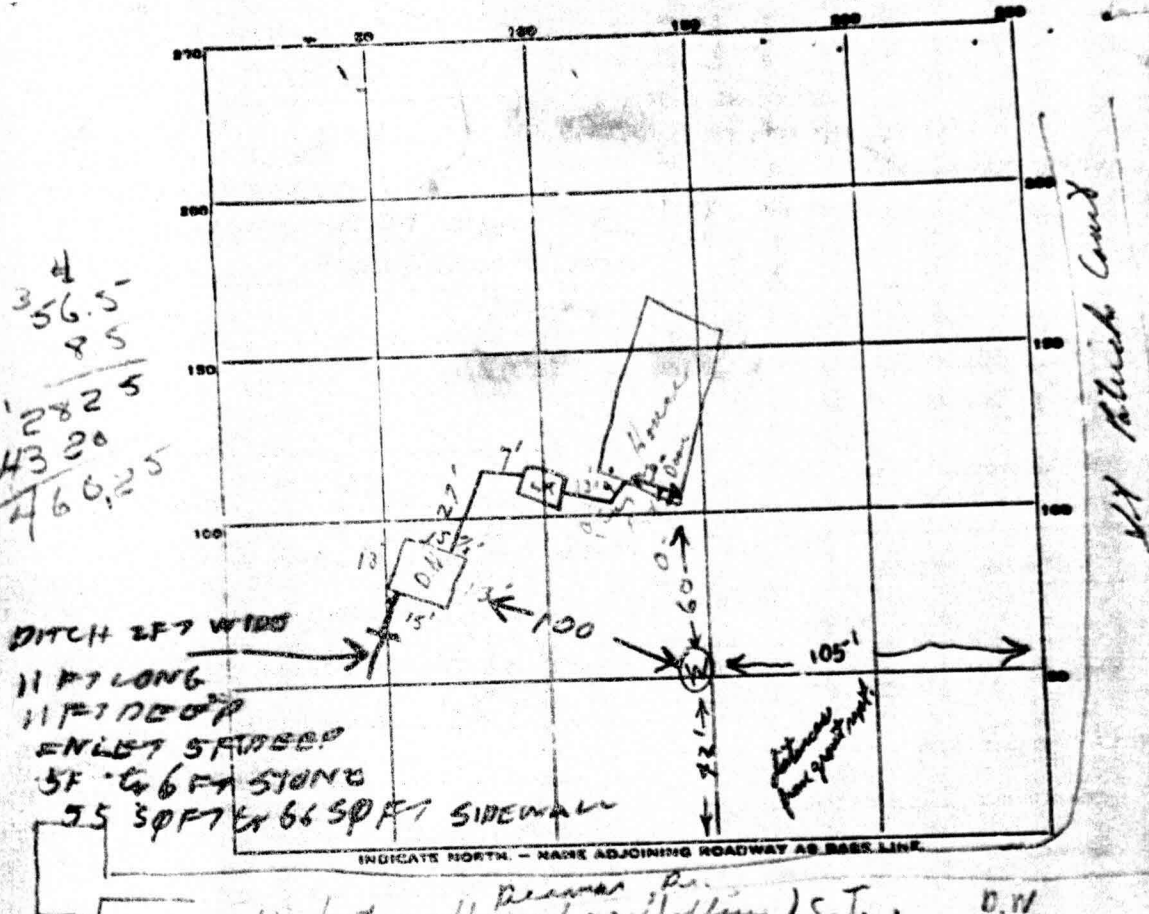
NOTE: INSTALL STAND PIPE ON SEPTIC TANK AND DRY WELL. STAND PIPES MUST BE 6 INCHES IN DIAMETER. CAST IRON, CONCRETE OR TERRA COTTA ACCEPTED.

PLANS APPROVED BY Raymond Johnson DATE 9/9/75

FILL SEPTIC TANK AND DISTRIBUTION BOX WITH WATER BEFORE CALLING FOR AN INSPECTION. COVER NO WORK UNTIL INSPECTED AND APPROVED.

NEITHER THE HOWARD COUNTY COMMISSIONERS NOR THE HEALTH DEPARTMENT IS RESPONSIBLE FOR THE SUCCESSFUL OPERATION OF ANY SYSTEM.

A 20497

$$\begin{array}{r} 4 \\ 356.5 \\ 85 \\ \hline 12825 \\ 4320 \\ \hline 466.25 \end{array}$$


PERMIT CARD 1250 gal CLEANOUTS ok ok on right

DISTRIBUTION BOX, LEVEL

DATE 11/14
RICE FIELD, DEPTH 5-6 FT. TRENCH WIDTH 2 FT.

GRAVEL DEPTH 5-6 F¹/₂ TOTAL LENGTH 11 FT.

NUMBER OF TRENCHES 1 ONE SIDE
TOTAL BOTTOM AREA 55466

20 outside 5 1/2 FT. DEPTH BELOW INLET 8 1/2 FT. 8 FT (517 7/13)

ABSORBENT AREA 452+ - SQ. FT.

REMARKS 7/9/76 1.4.4. (old) check water level on
river at well about 1/2 mile south of mouth
of river. Found top of "Keweenaw" and stop all
measurements (4' d. by 1/2" diameter) (Add a 10' thickness
at least 6' of stone
at Dry Well also not
have 9' below inlet pipe)
on F.F. & C.B.S.

7-12-76 - Add 10 Tons w at least 6 of stone

DATE SYSTEM APPROVED 7/13/76 INSPECTOR Raymond Nozick