

APPLICATION

A 26001

SEWAGE DISPOSAL TESTING

P _____

STATE OF MARYLAND - DEPARTMENT OF HEALTH AND MENTAL HYGIENE

HOWARD COUNTY HEALTH DEPARTMENT
ENVIRONMENTAL HEALTH SERVICES

DISTRICT 3rd

P. O. BOX 476, ELLICOTT CITY, MARYLAND 21043
TELEPHONE: 465-5000, EXT. 356

DATE 6-3-77

TO: THE COUNTY HEALTH OFFICER
ELLICOTT CITY, MARYLAND

I, HEREBY, APPLY FOR THE NECESSARY TEST IN ORDER TO CONSTRUCT (OR RECONSTRUCT) A SEWAGE DISPOSAL SYSTEM.

PROPERTY OWNER SAND HILL JOINT VENTURE

ADDRESS 51 MONROE ST. ROCKVILLE, MD PHONE 424-5103

PROPERTY LOCATION:

SUBDIVISION SAND HILL ACRES LOT NO. 3 lot 9

ROAD AND DESCRIPTION SAND HILL COURT, SECTION III

SIZE OF LOT 2.4 Acres TYPE BLDG. 4
NUMBER OF BEDROOMS

IF NOT SINGLE RESIDENCE DESCRIBE _____

THE SYSTEM INSTALLED UNDER THIS APPLICATION IS ACCEPTABLE ONLY UNTIL PUBLIC FACILITIES BECOME AVAILABLE.

SIGNATURE OF APPLICANT Martin F. Lynett


APPROVED BY _____ FOR _____ DATE _____
(KIND OF SYSTEM)

REJECTED BY _____ FOR _____ DATE _____
(KIND OF SYSTEM)

HOLD PENDING FURTHER TESTS Per FF. Dgou. J.S. DATE _____

REASONS FOR REJECTION OR HOLDING water 12' need tests low lead

THIS IS NOT A PERMIT

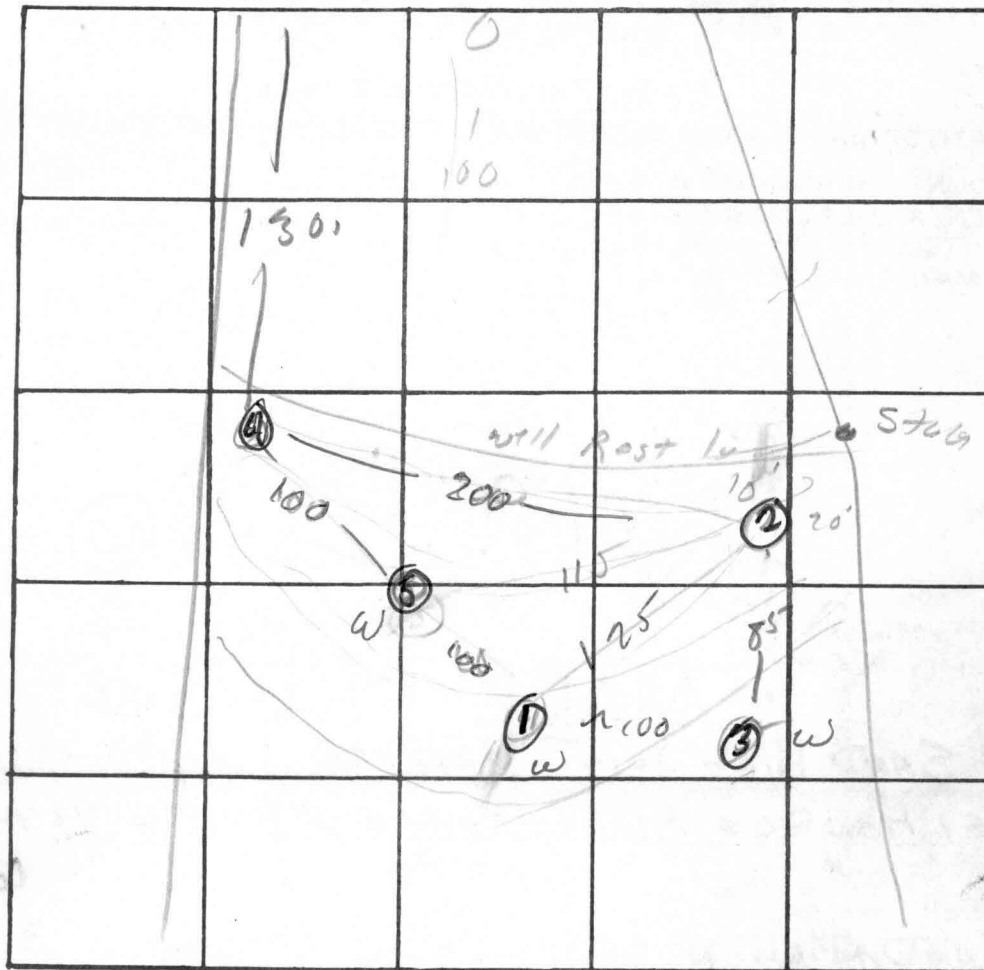

INDICATE NORTH. - NAME ADJOINING ROADWAY AS BASE LINE.

DATE	TEST NO.	DEPTH	PRE-WET		TEST - 1" DROP		TIME
			START	STOP	START	STOP	
7/8/41	1 s	3'	1 26	1 25	1 25	1 32	4
	d	12' Grate					
	2 s	3'	1 58	2 00	2 00	2 06	6
	d	11'	1 55	2 06	2 06	2 17	11
	3	8 1/2'	Water				
	5	2' 1/3	2 15	2 30	2 30	2 44	14
	4 s	3 1/2'	2 30	2 36	2 36	2 58	22
	d	13'	2 45	2 56	2 56	3 03	7

REMARKS

hold for spring

TYPE OF SOIL

TESTED BY

A. J. J. J.


ALSO PRESENT:

lot 9

2-T- 2 1/2'-3' & 7 1/2'-8'
dig to 12' check fracture

2-U check 12' for water

Soil Profile

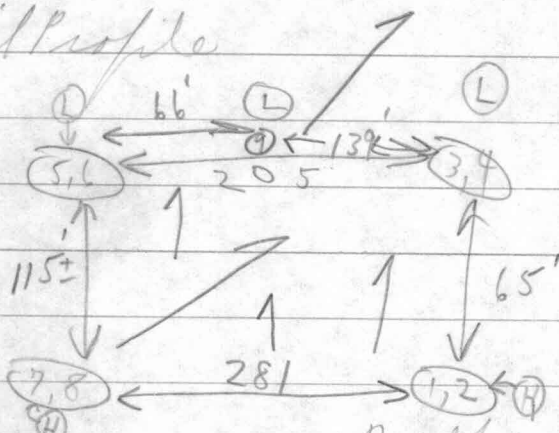

(Observed) 5/28/79
9/20/79
C.B.O.
+FF

Field
sheet
Test
in
stake

3 min average
= Int'l 3'

		Depth	1st	2nd	Stop	Total
Soil	Micro	2 1/2'	9:48	9:50	9:53	3 min
	Loam	8 1/2'	9:48	9:50	9:53	3 min
	More	2 1/2'	9:54	9:58	10:03	5 min
	Loam	8 1/2'	9:54	9:56	9:58	2 min
	Micro	3'	10:15	10:16	10:17	1 min
	Loam	8'	10:15	10:17	10:19	2 min
Use	(H)	3 1/2'	10:08	10:10	10:12	2 min
	Micro	8 1/2'	10:08	10:10	10:13	3 min
		13'	Vertical	Micro	(Hole ready)	21

Mr Barth

+ helper

Martin, owner

(Wooded lot near Rt 20)

(Hole for certified holes)

9/7/78

LOT 9 VISUAL 42 FT - WATER

MOVED UP SLOPE 55 FT. (WEST) - 13 FT. OK

JS

SOIL PROFILE

0-5 FT - CLAY, SAND

5-12 FT SAND, CLAY, SMALL SHALEY STONES