

APPLICATION

PERCOLATION TESTING

HOWARD COUNTY HEALTH DEPARTMENT
BUREAU OF ENVIRONMENTAL HEALTH
P.O. BOX 476 ELLICOTT CITY, MARYLAND 21043
TELEPHONE 461-9933

A 40945

P _____

DISTRICT 4

DATE 1-29-88

TO: THE COUNTY HEALTH OFFICER
ELLICOTT CITY, MARYLAND

I, HEREBY, APPLY FOR THE NECESSARY TEST IN ORDER TO CONSTRUCT (OR RECONSTRUCT) A SEWAGE DISPOSAL SYSTEM.

PROPERTY OWNER Hilltop Development Corp

ADDRESS P.O. Box 208 CLARKSVILLE Md 21029 PHONE 531-5539

PROSPECTIVE BUYER _____

ADDRESS _____ PHONE _____

PROPERTY LOCATION:

SUBDIVISION SAND HILL ACRES LOT NO. 48

ROAD AND DESCRIPTION 2415 SAND HILL ROAD & LAMPLIGHTERS DRIVE

TAX MAP 16 PARCEL # 5

SIZE OF LOT 3 acres TYPE BLDG Single Family
(SINGLE FAMILY DWELLING OR COMMERCIAL)

THE SYSTEM INSTALLED UNDER THIS APPLICATION IS ACCEPTABLE ONLY UNTIL PUBLIC FACILITIES BECOME AVAILABLE. I FULLY UNDERSTAND THE

FEE CONNECTED WITH THE FILING OF THIS PERC TEST APPLICATION IS NON-REFUNDABLE UNDER ANY CIRCUMSTANCES. I ALSO AGREE TO COMPLY

WITH ALL M.O.S.H.A. REQUIREMENTS IN TESTING THIS LOT. Richard Demmitt
(SIGNATURE OF APPLICANT)

APPROVED BY _____ FOR _____ DATE _____

REJECTED BY _____ FOR _____ DATE _____

HOLD PENDING FURTHER TESTS _____ DATE _____

REASONS FOR REJECTION OR HOLDING _____

BOG: PERMIT SIGNED

AND RETURNED 9/12/89


Signal # 27045-SFD

3 Beckron

THIS IS NOT A PERMIT

3, 4, 8

SOIL PROFILE

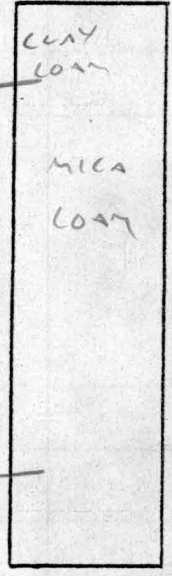


7

CLAY & MICA LOAM

MICA LOAM WITH WHITE CLAY

WATER

A40193

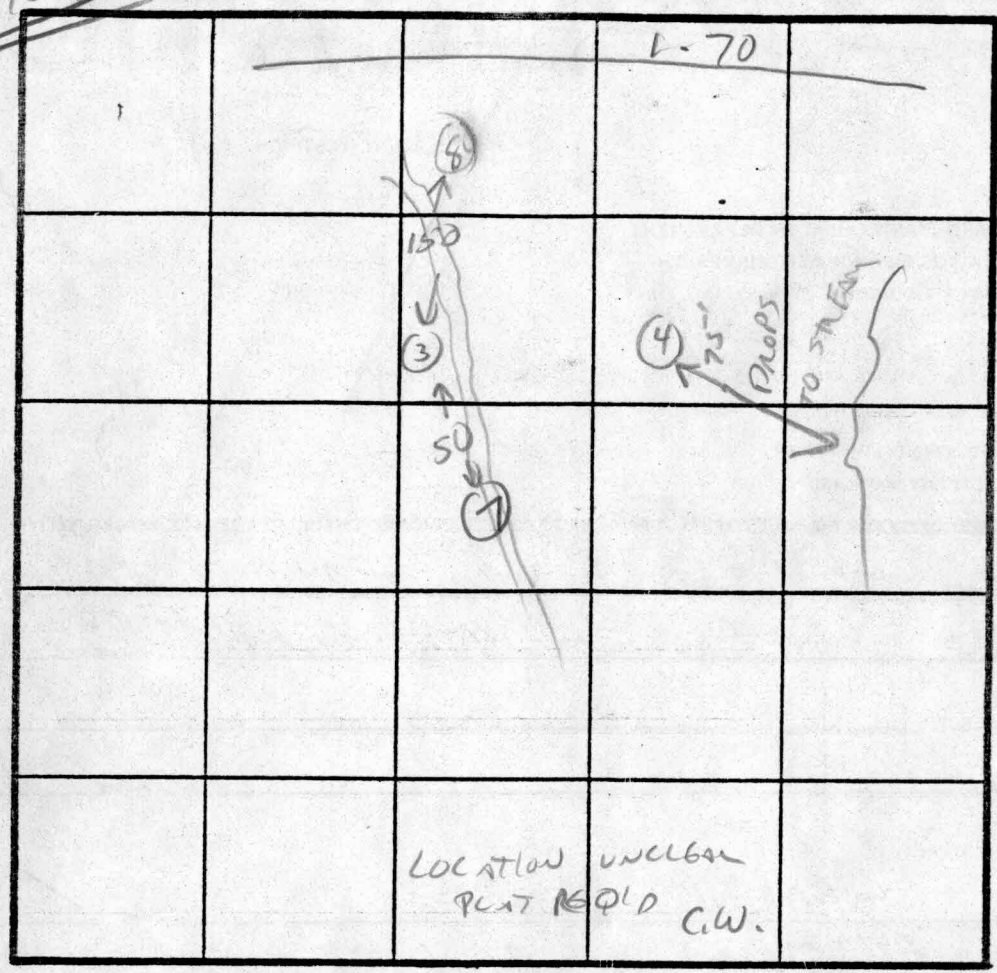


INDICATE NORTH - NAME ADJOINING ROADWAY AS BASE LINE.

DATE	TEST NO.	DEPTH	PRE-WET		TEST - 1" DROP		TIME
			START	STOP	START	STOP	
MARCH 29+30 1988	3	2 1/2	10:51	10:52	10:52	10:54	2 MIN
		7	10:48	10:49	10:49	10:51	3 MIN
		11					
	4	2 1/2	VIS OK	SAME AS 3			
		11	BOUNDED BY SPRINGHEADS	STRAIN BOTTOM			
	7	WATER	AT 10' SOIL DIS COLORED AT VARIOUS DEPTHS				
			SUGGESTING SEASONAL WATER CHARGE				
	8	2 1/2	11:02	11:04	11:04	11:07	3 MIN
		7		VIS OK LOAM			
		11					

REMARKS SWALO- POSSIBLE SPRINGHEAD THRU TEST AREA - REDDESIGN REQ'D

TYPE OF SOIL MICA LOAM, SITE LIMITATIONS

TESTED BY CWILLIAMS ALSO PRESENT R DOMMUTT

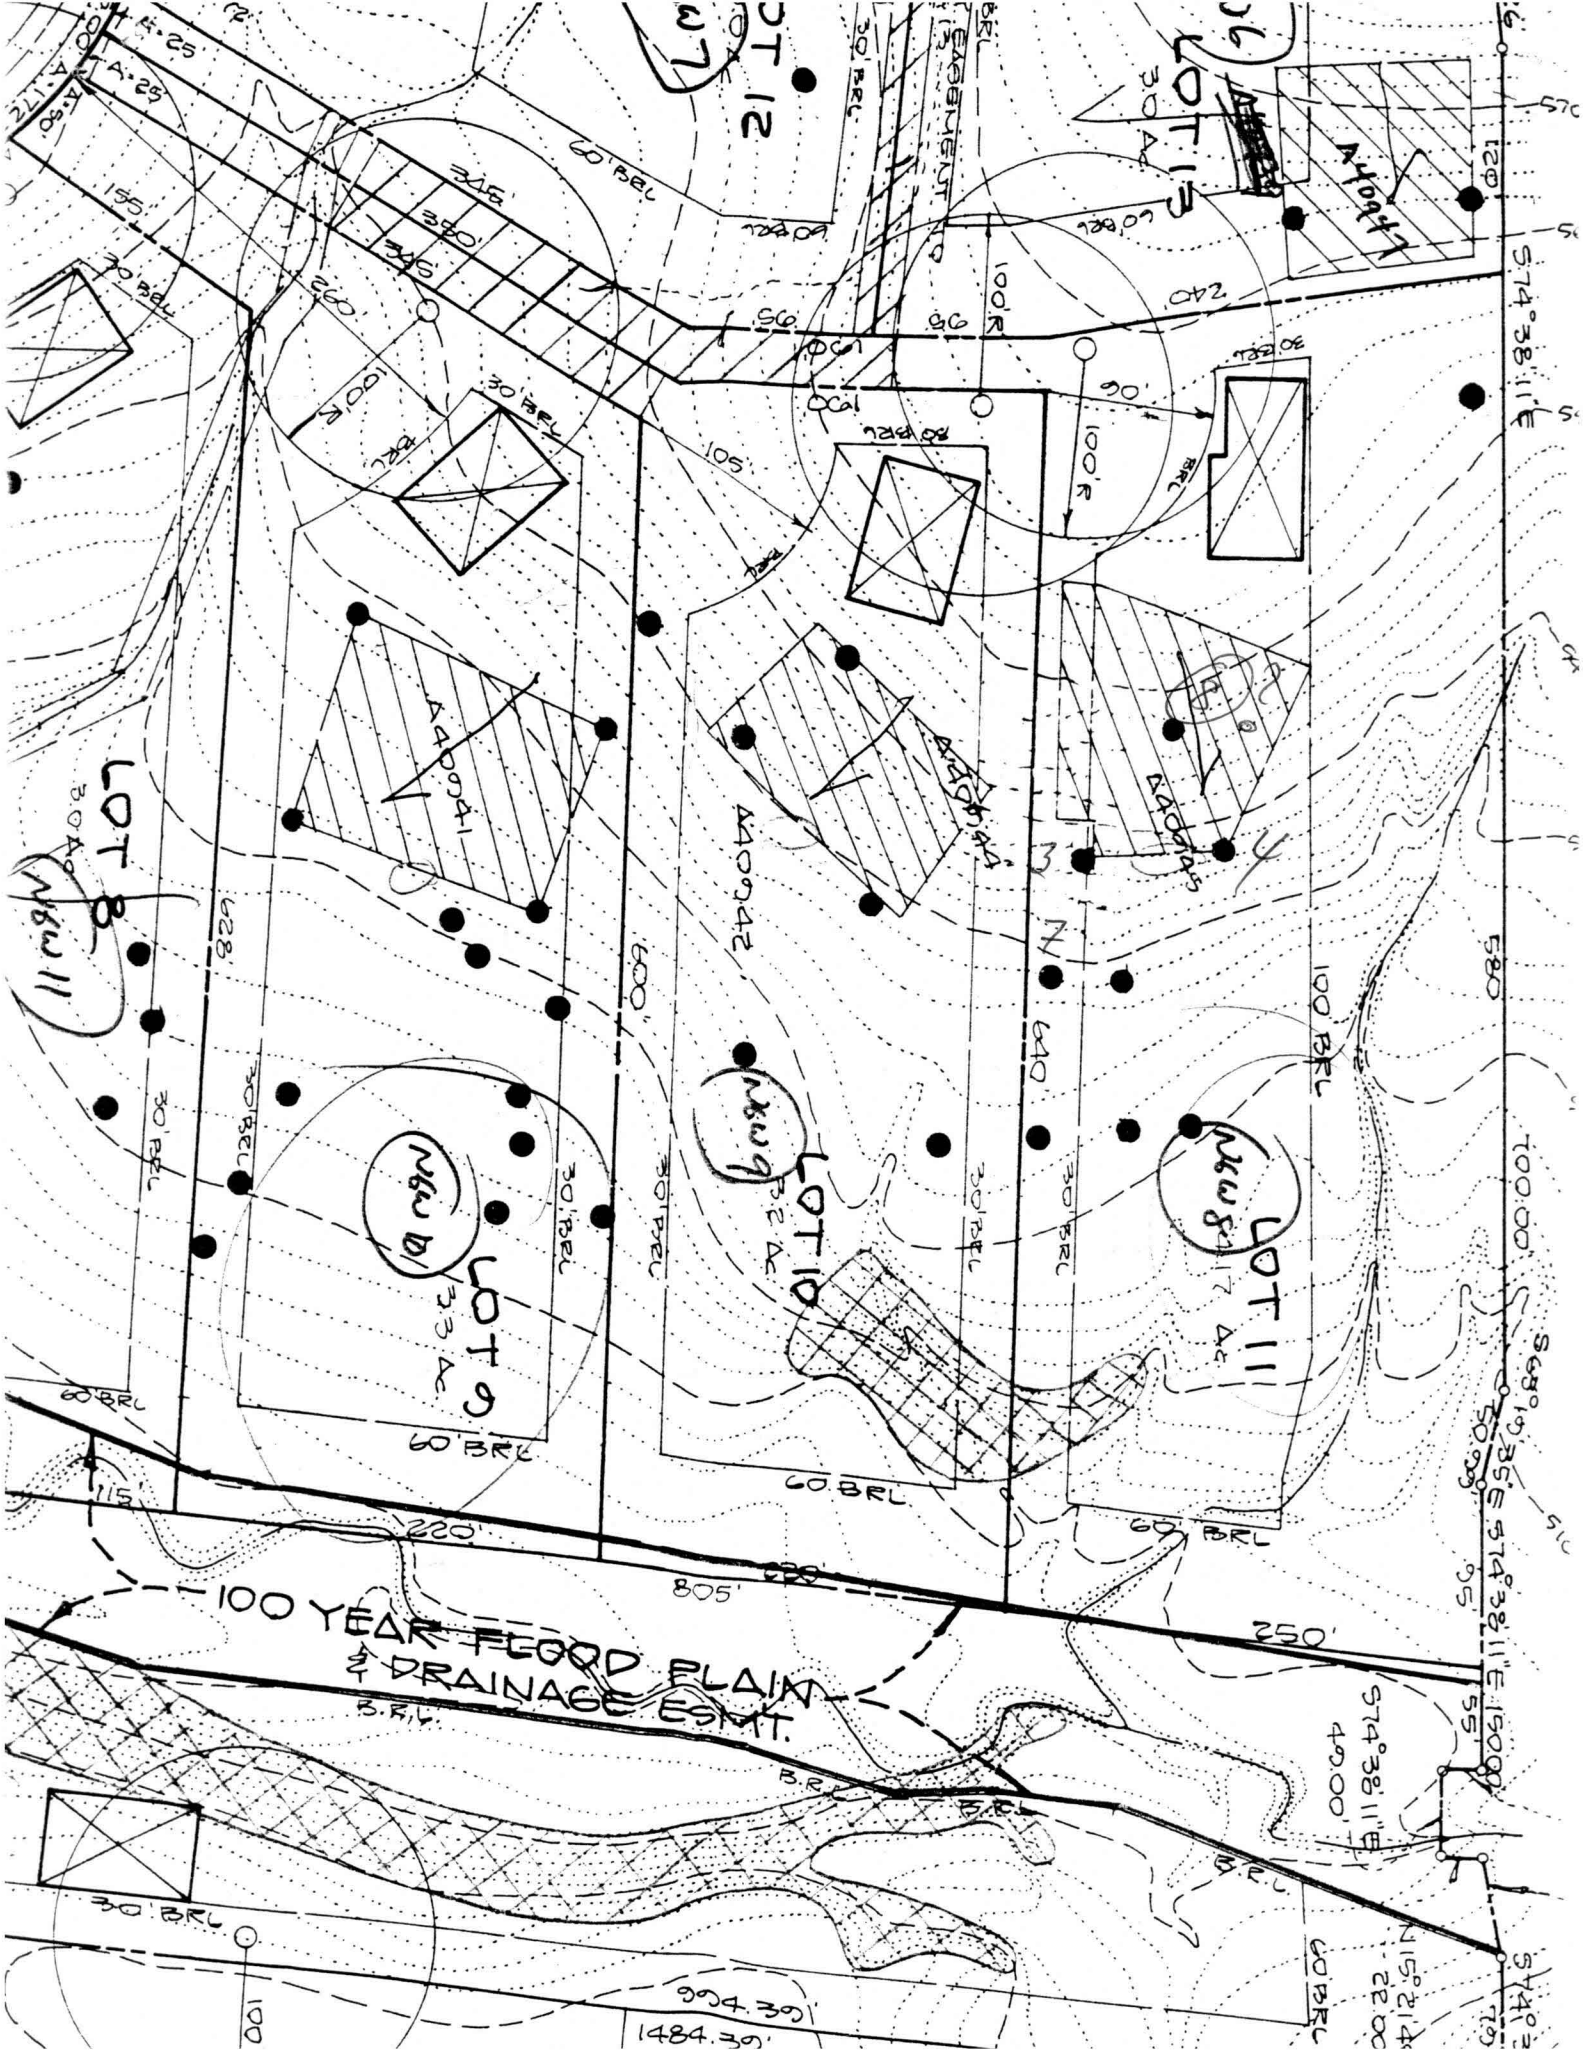

100 YEAR FLOOD PLAIN
& DRAINAGE ESMT.

LOT 13

LOT 11

LOT 10

LOT 9

LOT 8

LOT 12

574°38'11"E
490.00'

574°2'14"
22.00'

568°15'35"
50.00'

574°38'11"E
120.00'

1484.30'

805'

220'

250'

55'

55'

