

LAYOUT 7/15/04 pm INSP 4 _____
INSP 2 8/3/04 2pm INSP 5 _____
INSP 3 _____ INSP 6 _____

ISSUE DATE: 6/24/2004

APPROVAL DATE: 2/4/05

PERMIT

INDEXED

P 520440

A 514999

ON-SITE SEWAGE DISPOSAL SYSTEM HOWARD COUNTY HEALTH DEPARTMENT BUREAU OF ENVIRONMENTAL HEALTH

Fogles Septic Clean, Inc IS PERMITTED TO INSTALL ☒ ALTER ☐
ADDRESS: 580 Obrecht Road, Sykesville PHONE NUMBER: 410-795-5670
SUBDIVISION: Sand Hill Acres LOT NUMBER: 8
ADDRESS: 2415 Sand Hill Road PROPERTY OWNER: Steve & LaTonya Watson
SEPTIC TANK CAPACITY (GALLONS): 1250 OUTLET BAFFLE FILTER REQUIRED ☐
PUMP CHAMBER CAPACITY (GALLONS): 1250 COMPARTMENTED TANK REQUIRED ☐
NUMBER OF BEDROOMS: 4
SQUARE FEET PER BEDROOM: 180
LINEAR FEET OF TRENCH REQUIRED: 240

TRENCHES:	Trench to be 3.0 feet wide. Inlet 2.0 feet below original grade. Bottom maximum depth 4.0 feet below original grade. Effective area begins at 3.0 feet below original grade. 2.0 feet of stone below distribution pipe.
LOCATION:	Place the distribution box exactly 100' off the water well serving this lot (located on the adjacent lot uphill) and 120' off the well on the adjacent lot (across the 639.22' lot line). Run (3) trenches on contour away from driveway entrance.
NOTES:	Pumped septic system

PLANS APPROVED: MER KSA 6/24/04 DATE: 10/16/01

NOTE: PERMIT VOID AFTER 2 YEARS

NOTE: CONTRACTOR RESPONSIBLE FOR SCHEDULING A PRE-CONSTRUCTION INSPECTION FOR ALL INSTALLATIONS


NOTE: WATERTIGHT SEPTIC TANKS REQUIRED

NOTE: ALL PARTS OF SEPTIC SYSTEM SHALL BE 100 FEET FROM ANY WATER WELL

NOTE: MANHOLE RISERS REQUIRED ON ALL SEPTIC TANKS AND PUMP CHAMBERS UNLESS SPECIFICALLY AUTHORIZED

**NEITHER THE HOWARD COUNTY COUNCIL NOR THE HEALTH DEPARTMENT IS
RESPONSIBLE FOR THE SUCCESSFUL OPERATION OF ANY SYSTEM
PERMITTEE RESPONSIBLE FOR OBTAINING FINAL APPROVAL ON THIS PERMIT
CALL 410-313-2640 FOR INSPECTION OF SEPTIC SYSTEM**

A 514999

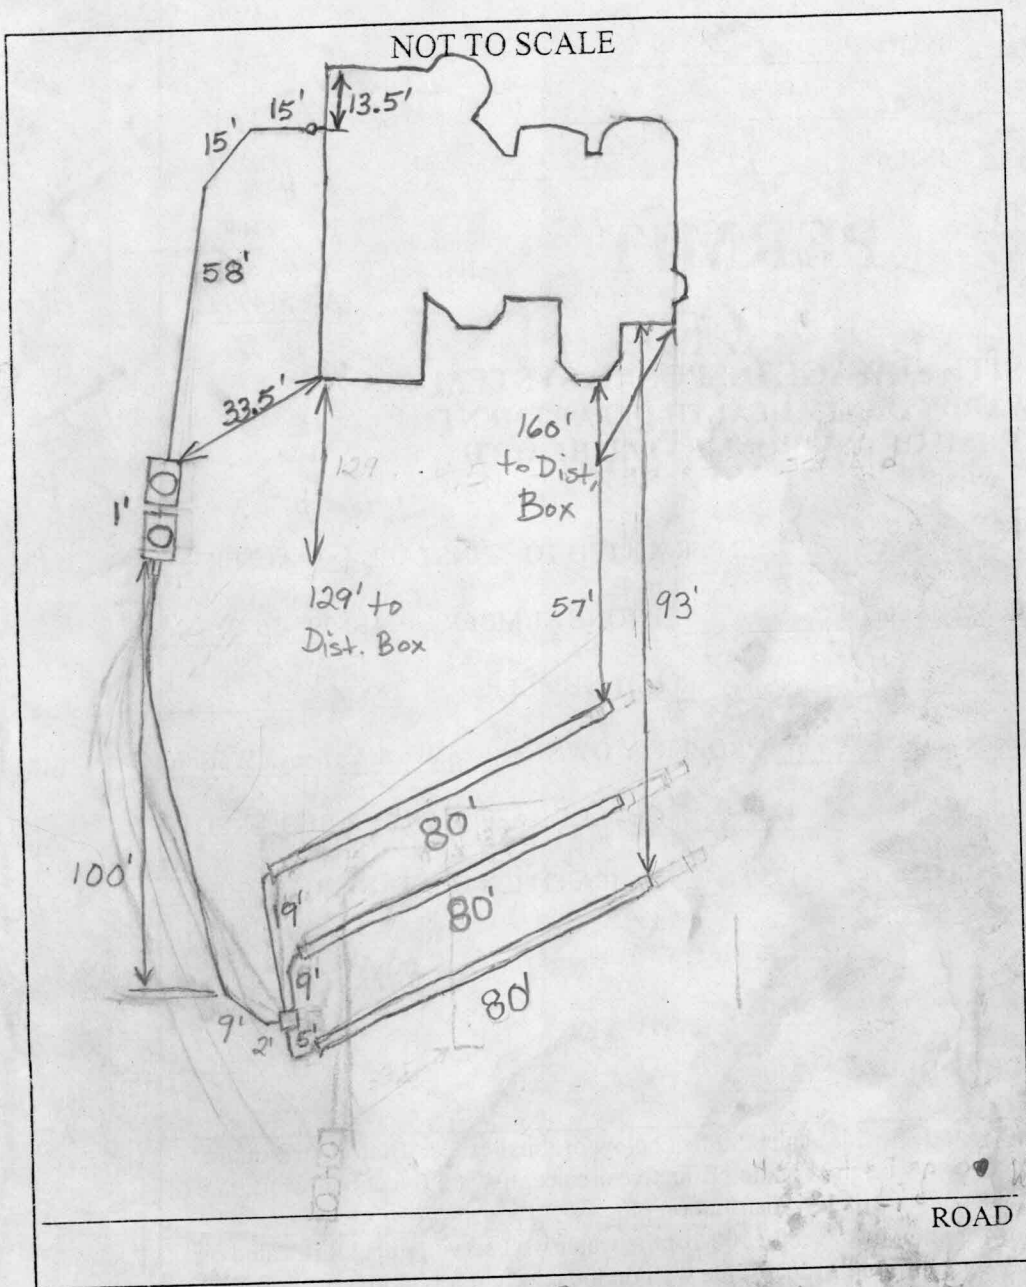

TRENCH/DRAINFIELD DATA		
WIDTH	INLET	BOTTOM
3'	2'	4'
NUMBER OF TRENCHES 3		
TOTAL LENGTH 240'		
ABSORPTION AREA 2204		
DISTRIBUTION BOX LEVEL Levelers		
DISTRIBUTION BOX BAFFLE Elbow		
DISTRIBUTION BOX PORT Yes		

SEPTIC TANK DATA	
SEPTIC TANK 1 LEVEL ✓	
CAPACITY	1250 GAL
SEAM LOC	Top
TANK LID DEPTH	2'-4'
BAFFLES	Yes
BAFFLE FILTER	No
MANHOLE LOC	Middle
6" PORT LOC	None
WATERTIGHT TEST	No
SEPTIC TANK 2 LEVEL ✓	
CAPACITY	1250 GAL
SEAM LOC	Top
TANK LID DEPTH	2'-4'
BAFFLES	Tec
BAFFLE FILTER	No
MANHOLE LOC	Middle
6" PORT LOC	None
WATERTIGHT TEST	No

PRE-CONSTRUCTION 7/15/04 Easement staked incorrectly. Surveyor to restake and Fiegles to call in for another layout.

INSTALLATION Top of septic tank riser lids are 4.5' above tanks. Final grade should be about 1.5' below top of lids. (BB)

8/3/04 Layout cancelled. Stopped at site. Trench locations staked out but easement not staked. (BB) 8/5/04 Easement needs to be staked out. Could not do layout. Is driveway going over easement? (BB) 8/17/04 Surveyor called (David Ransone). I explained to him that whole easement needs to be staked out so that we can do proper layout. (BB) 8/23/04 - SRA staked, install

FINAL INSPECTOR B. Baker DATE OF APPROVAL 2/4/05

(3) 80' trenches per BP (Sc)

BB

LAMPLIGHTER'S DRIVE

SAND HILL ROAD

Lot 7

Lot 6

Lot 10



HOUSE MOVED
20' TO RIGHT
NO IMPACT TO WELL OR SEPTIC
OK MR
4/17/02



This plat is of benefit to a consumer only insofar as it is required by a lender/title insurance company or their agent in connection with a contemplated transfer or financing or refinancing. This plat is not to be relied upon for the establishment or location of fences, garages, buildings, or other existing or future improvements. This plat does not provide for the accurate identification of property boundary lines, but such identification is not required for the transfer of title or securing financing or refinancing of the property shown hereon.

The setback dimensions shown hereon and as they relate to structures noted are to be interpreted as being within 2 feet either way of the dimension shown.

LOCATION DRAWING

Property Address: No. 2415 SAND HILL ROAD & NE SIDE LAMPLIGHTER'S DRIVE
LOT 8 SECT. 3 AREA 1 LOTS 6 THRU 11
SAND HILL ACRES PLAT # B355
3RD DIST. HOWARD COUNTY, MD

Scale: 1" = 100' Date: 4-11-02

David Ransone - Land Surveyor
MD Lic.# 10928
PO Box 10007
Baltimore, MD 21285-0007
(410) 828-5354

3 SYSTEMS
LAYOUT
2 BP
REVIEW

