

03-334244

ISSUE DATE: 5/23/2001APPROVAL DATE: 6/21/01**PERMIT**P 515259-AA 511435-F

INDEXED

**ON-SITE SEWAGE DISPOSAL SYSTEM
HOWARD COUNTY HEALTH DEPARTMENT
BUREAU OF ENVIRONMENTAL HEALTH**K & K ExcavatingIS PERMITTED TO INSTALL ☒ ALTER ☐ADDRESS: 14960 Frederick Road, Woodbine 21797 PHONE NUMBER: 410-442-1336SUBDIVISION: The Estates @ Sandhill LOT NUMBER: 6ADDRESS: 12021 Sand Hill Manor PROPERTY OWNER: Oak Hill PropertiesSEPTIC TANK CAPACITY (GALLONS): 1000PUMP CHAMBER CAPACITY (GALLONS): N/ANUMBER OF BEDROOMS: 3SQUARE FEET PER BEDROOM: 180LINEAR FEET OF TRENCH REQUIRED: 180

TRENCHES:	Trench to be 3.0 feet wide. Inlet 4.0 feet below original grade. Bottom maximum depth 6.0 feet below original grade. Effective area begins at 4.0 feet below original grade. 2.0 feet of stone below distribution pipe.
LOCATION:	Begin trenches 200 feet up the right lot line and 30 feet off that same lot line as seen when facing the lot from Sand Hill Manor Drive. Run trenches on contour toward the left lot line.
NOTES:	

PLANS APPROVED: Amy Mc Millen 4/13/01 OK (BB) DATE: 3-26-01

NOTE: PERMIT VOID AFTER 2 YEARS

NOTE: CONTRACTOR RESPONSIBLE FOR SCHEDULING A PRE-CONSTRUCTION INSPECTION FOR ALL INSTALLATIONS

NOTE: WATERTIGHT SEPTIC TANKS REQUIRED

NOTE: ALL PARTS OF SEPTIC SYSTEM SHALL BE 100 FEET FROM ANY WATER WELL


NOTE: MANHOLE RISERS REQUIRED ON ALL SEPTIC TANKS AND PUMP CHAMBERS

**NEITHER THE HOWARD COUNTY COUNCIL NOR THE HEALTH DEPARTMENT IS
RESPONSIBLE FOR THE SUCCESSFUL OPERATION OF ANY SYSTEM
PERMITTEE RESPONSIBLE FOR OBTAINING FINAL APPROVAL ON THIS PERMIT
CALL 410-313-2640 FOR INSPECTION OF SEPTIC SYSTEM**

P 515259-A

6/21/01
Layout
10:00

NOT TO SCALE

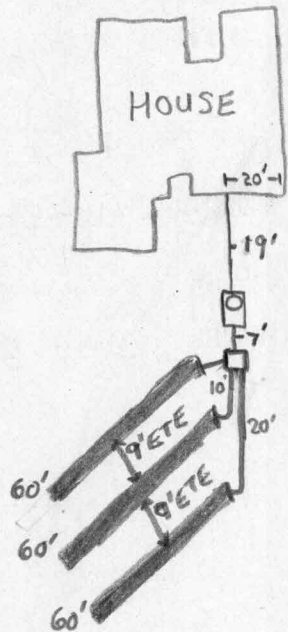

SAND HILL MANOR DRIVE

TRENCH DATA

TRENCH WIDTH 3'
TRENCH INLET DEPTH 4'
TRENCH BOTTOM DEPTH 6'
DEPTH OF STONE 2
NUMBER OF TRENCHES 3
TOTAL TRENCH LENGTH 180'
ABSORBENT AREA 540ft²
DISTRIBUTION BOX LEVEL ✓
BAFFLE IN DISTRIBUTION BOX ✓

SEPTIC TANK DATA

SEPTIC TANK 1500TS GALLONS
BAFFLES IN on front
MANHOLE RISER NA
6 INCH INSPECTION PORT NA

PUMP CHAMBER DATA

PUMP CHAMBER
GALLONS NA
MANHOLE RISER NA
ALARM NA
PUMP PERFORMANCE TEST NA

PRE-CONSTRUCTION INSPECTION: 6/21/01 - PROCEED PER PLAN, SDA STAKED - (SRK)

INSPECTION COMMENTS: 6/21/01 - OK TO COVER ALL WORK - (SRK)

INSPECTOR Steven R. Krieg DATE SYSTEM APPROVED 6/21/01