

03-334287

ISSUE DATE: 5/23/2001

APPROVAL DATE: 6/28/01

# PERMIT

P 515259-B

A 511435-G

6/21/01  
Layout  
10:00

## ON-SITE SEWAGE DISPOSAL SYSTEM HOWARD COUNTY HEALTH DEPARTMENT BUREAU OF ENVIRONMENTAL HEALTH

6/28/01  
Final 3:00

K & K Excavating

IS PERMITTED TO INSTALL ☒ ALTER ☐

ADDRESS: 14960 Frederick Road, Woodbine 21797 PHONE NUMBER: 410-442-1336

SUBDIVISION: Estates @ Sandhill LOT NUMBER: 7

ADDRESS: 12025 Sand Hill Manor Drive PROPERTY OWNER: Oakhill Properties

SEPTIC TANK CAPACITY (GALLONS): 1250

PUMP CHAMBER CAPACITY (GALLONS): 1250 N/A

NUMBER OF BEDROOMS: 4

SQUARE FEET PER BEDROOM: 180

LINEAR FEET OF TRENCH REQUIRED: 240

4.0

|           |   |
|-----------|---|
| TRENCHES: | Trench to be 3.0 feet wide. Inlet <del>3.0</del> <sup>4.0</sup> feet below original grade. Bottom maximum depth <del>5.0</del> <sup>4.0</sup> feet below original grade. Effective area begins at <del>3.0</del> <sup>4.0</sup> feet below original grade. 2.0 feet of stone below distribution pipe. |
| LOCATION: | Begin trenches 130 feet down the left lot line and 20 feet off that same lot line as seen when facing the lot from Sand Hill Manor Drive. Run trenches on contour toward the house.   |
| NOTES:    | 6/1/01 Specs revised AM<br>6/21/01 - D.BOX LOCATION REVISED (SRU)   |

PLANS APPROVED: Amy Mc Millen 4/12/01 OK (BB) DATE: 4-11-01

NOTE: PERMIT VOID AFTER 2 YEARS

NOTE: CONTRACTOR RESPONSIBLE FOR SCHEDULING A PRE-CONSTRUCTION INSPECTION FOR ALL INSTALLATIONS

NOTE: WATERTIGHT SEPTIC TANKS REQUIRED

NOTE: ALL PARTS OF SEPTIC SYSTEM SHALL BE 100 FEET FROM ANY WATER WELL

NOTE: MANHOLE RISERS REQUIRED ON ALL SEPTIC TANKS AND PUMP CHAMBERS

NEITHER THE HOWARD COUNTY COUNCIL NOR THE HEALTH DEPARTMENT IS  
RESPONSIBLE FOR THE SUCCESSFUL OPERATION OF ANY SYSTEM  
PERMITTEE RESPONSIBLE FOR OBTAINING FINAL APPROVAL ON THIS PERMIT  
CALL 410-313-2640 FOR INSPECTION OF SEPTIC SYSTEM


BUILDING PERMIT SIGNED

AND RETURNED

7-03 B00141716-DECK

515259-B

NOT TO SCALE

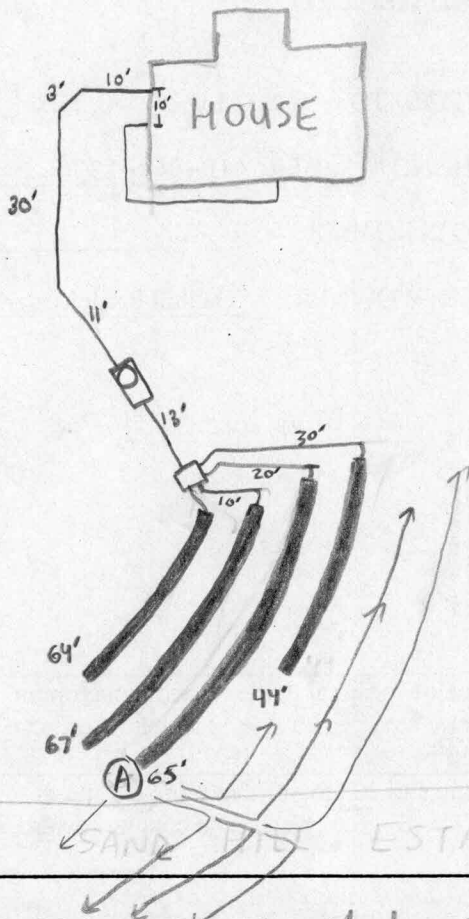

### TRENCH DATA

TRENCH WIDTH 3'  
TRENCH INLET DEPTH 4'  
TRENCH BOTTOM DEPTH 6'  
DEPTH OF STONE 2'  
NUMBER OF TRENCHES 4  
TOTAL TRENCH LENGTH 240'  
ABSORBENT AREA 720ft<sup>2</sup>  
DISTRIBUTION BOX LEVEL ✓  
BAFFLE IN DISTRIBUTION BOX ✓

### SEPTIC TANK DATA

SEPTIC TANK 1500 TS GALLONS  
MANHOLE RISER on front  
6 INCH INSPECTION PORT NA

### PUMP CHAMBER DATA

PUMP CHAMBER GALLONS NA  
MANHOLE RISER NA  
ALARM NA  
PUMP PERFORMANCE TEST NA

PRE-CONSTRUCTION INSPECTION: 6/21/01 - SDA STAKED, PROCEED W/ GRAVITY SYSTEM AT 4'-6' OR PUMP AT 3'-5', - (SRK)

INSPECTION COMMENTS: 6/28/01 - OK TO COVER ALL WORK, 1ST REPAIR SHOULD INVOLVE SETTING A NEW D. BOX IN LOCATION (A) AND RUN TRENCHES ON CONTOUR IN BOTH DIRECTIONS AS ARROWS INDICATE, NEW SOLID SCH. 40 COULD BE RUN FROM SEPTIC TANK OUTLET TO NEW D. BOX GOING THRU/OVER EX. TRENCHES, INLET TO BE 4' AND BOTTOM 6' - (SRK)

INSPECTOR

Steven R. Krieg

DATE SYSTEM APPROVED

6/28/01

BUILDING PERMIT SIGNED  
AND RETURNED