

ISSUE DATE: 8/16/01

PERMIT

P 515986

APPROVAL DATE: 8/22/01

A REPAIR

05-348749

ON-SITE SEWAGE DISPOSAL SYSTEM
HOWARD COUNTY HEALTH DEPARTMENT
BUREAU OF ENVIRONMENTAL HEALTH

INDEXED

Beautifys Home & Businesses

IS PERMITTED TO INSTALL ☐ ALTER ☒

ADDRESS: 9055-H Thamesmeade Road PHONE NUMBER: 301-604-5400

SUBDIVISION: LOT NUMBER:

ADDRESS: 12289 Scaggsville Road PROPERTY OWNER: Floyd Ray Taylor

SEPTIC TANK CAPACITY (GALLONS): 1000 (existing)

PUMP CHAMBER CAPACITY (GALLONS): N/A

NUMBER OF BEDROOMS: 4

SQUARE FEET PER BEDROOM:

LINEAR FEET OF TRENCH REQUIRED:

(Credit for
ex. drywell per MR)

$$180\text{ft}^2 \times 4 = 720\text{ft}^2 - 360\text{ft}^2 = 360\text{ft}^2 \div 3' \text{ wide}$$

120' (2 - 60' Trenches on contour)

TRENCHES:	Trench to be 3 feet wide. Inlet 2 feet below original grade. Bottom maximum depth 4 feet below original grade. Effective area begins at 3 feet below original grade. 2 feet of stone below distribution pipe.
LOCATION:	
PURPOSE:	In support of building permit #B00131927. Call for inspection when ground is opened so sanitarian can recommend repair.

PLANS APPROVED: Mark Rifkin / SRK DATE: 8/20/2001

NOTE: PERMIT VOID AFTER 2 YEARS

NOTE: CONTRACTOR RESPONSIBLE FOR SCHEDULING A PRE-CONSTRUCTION INSPECTION FOR ALL INSTALLATIONS

NOTE: WATERTIGHT SEPTIC TANKS REQUIRED

NOTE: ALL PARTS OF SEPTIC SYSTEM SHALL BE 100 FEET FROM ANY WATER WELL


NOTE: MANHOLE RISERS REQUIRED ON ALL SEPTIC TANKS AND PUMP CHAMBERS

8/16/2001
B00131927 REMODEL BASEMENT

NEITHER THE HOWARD COUNTY COUNCIL NOR THE HEALTH DEPARTMENT IS
RESPONSIBLE FOR THE SUCCESSFUL OPERATION OF ANY SYSTEM
PERMITTEE RESPONSIBLE FOR OBTAINING FINAL APPROVAL ON THIS PERMIT
CALL 410-313-2640 FOR INSPECTION OF SEPTIC SYSTEM

515986

NOT TO SCALE

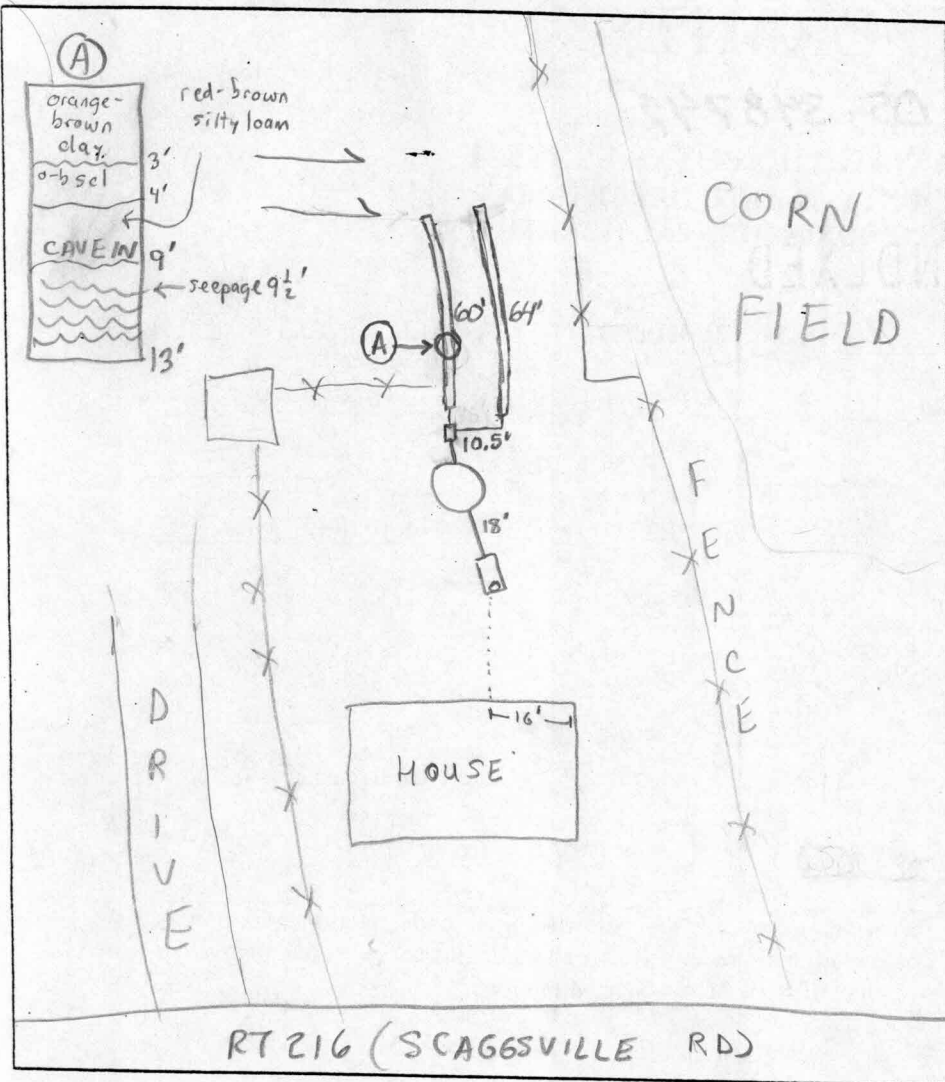

TRENCH DATA

TRENCH WIDTH 3'
 TRENCH INLET DEPTH 2.5'
 TRENCH BOTTOM DEPTH 4.5'
 DEPTH OF STONE 2'
 NUMBER OF TRENCHES 2
 TOTAL TRENCH LENGTH 124'
 ABSORBENT AREA 372 sq. ft. + Dryw
 DISTRIBUTION BOX LEVEL OK
 BAFFLE IN DISTRIBUTION BOX Yes

SEPTIC TANK DATA

SEPTIC TANK ex 1000 GALLONS

MANHOLE RISER NA

6 INCH INSPECTION PORT Yes

PUMP CHAMBER DATA

PUMP CHAMBER GALLONS NA

MANHOLE RISER NA

ALARM NA

PUMP PERFORMANCE TEST NA

PRE-CONSTRUCTION INSPECTION: 8/21/01-D46 PERC HOLE AT (A), INSTALL PER SPECS ON FRONT, REPLACE PIPE FROM EX. TANK TO DW W/PVC, INSTALL NEW 6" CLEANOUT ON ST (SR)

INSPECTION COMMENTS: 8/22/01 System satisfactory. O.K. to cover. (BB)

INSPECTOR B. Baker DATE SYSTEM APPROVED 8/22/01