

# APPLICATION

PERCOLATION TESTING

A 515032

P \_\_\_\_\_

HOWARD COUNTY HEALTH DEPARTMENT

BUREAU OF ENVIRONMENTAL HEALTH

3525-H ELLICOTT MILLS DRIVE/ELLICOTT CITY, MARYLAND 21043  
TELEPHONE: 313-2640

DISTRICT \_\_\_\_\_

DATE 4/11/01

TO: THE COUNTY HEALTH OFFICER  
ELLICOTT CITY, MARYLAND

I HEREBY APPLY FOR THE NECESSARY TEST PRIOR TO APPLICATION FOR PERMIT TO CONSTRUCT (OR RECONSTRUCT) A SEWAGE DISPOSAL SYSTEM.

PROPERTY OWNER Katie Miles, c/o Marcus Dorsey

ADDRESS 3736 Overview Road  
Baltimore, MD 21215 PHONE \_\_\_\_\_

AGENT OR PROSPECTIVE BUYER Heritage Land Development

ADDRESS 3060 Washington Road, suite 220  
Glenwood, MD 21738 PHONE 410-489-7900

PROPERTY LOCATION:

SUBDIVISION Pooler Property LOT NO. \_\_\_\_\_

ROAD AND DESCRIPTION S. Bushy Park Road

South Side Bushy Park Road, 0.59 Miles off Rt. 144

TAX MAP 8 PARCEL # 70

SIZE OF LOT 3 Acres TYPE BLDG. SFD  
(SINGLE FAMILY DWELLING OR COMMERCIAL)

THE SYSTEM INSTALLED UNDER THIS APPLICATION IS ACCEPTABLE ONLY UNTIL PUBLIC FACILITIES BECOME AVAILABLE. I FULLY UNDERSTAND THE  
FEE CONNECTED WITH THE FILING OF THIS PERC TEST APPLICATION IS NON-REFUNDABLE UNDER ANY CIRCUMSTANCES. I ALSO AGREE TO  
COMPLY WITH ALL M.O.S.H.A. REQUIREMENTS IN TESTING THIS LOT.

Benjamin L. Pooler  
(SIGNATURE OF APPLICANT)  
Benjamin L. Pooler

APPROVED BY \_\_\_\_\_ FOR \_\_\_\_\_ DATE \_\_\_\_\_

DISAPPROVED BY \_\_\_\_\_ FOR \_\_\_\_\_ DATE \_\_\_\_\_

HOLD PENDING FURTHER TESTS \_\_\_\_\_

REASONS FOR REJECTION OR HOLDING \_\_\_\_\_

PERCOLATION TEST PLAT/PRELIMINARY PLAT - TITLE OR I.D. # \_\_\_\_\_ DATE \_\_\_\_\_

SITE DEVELOPMENT PLAN/FINAL PLAT - TITLE OR I.D. # \_\_\_\_\_ DATE \_\_\_\_\_

# THIS IS NOT A PERMIT

COUNTY #

SOIL PROFILE

101

topsoil

org brn  
cl lmpale  
org brn  
si lm10% +  
rock

102/104


topsoil

org brn  
cl lmorg tan  
si lm15-20%  
rock

103

like  
102w/ 10%  
rock

SOIL PROFILE

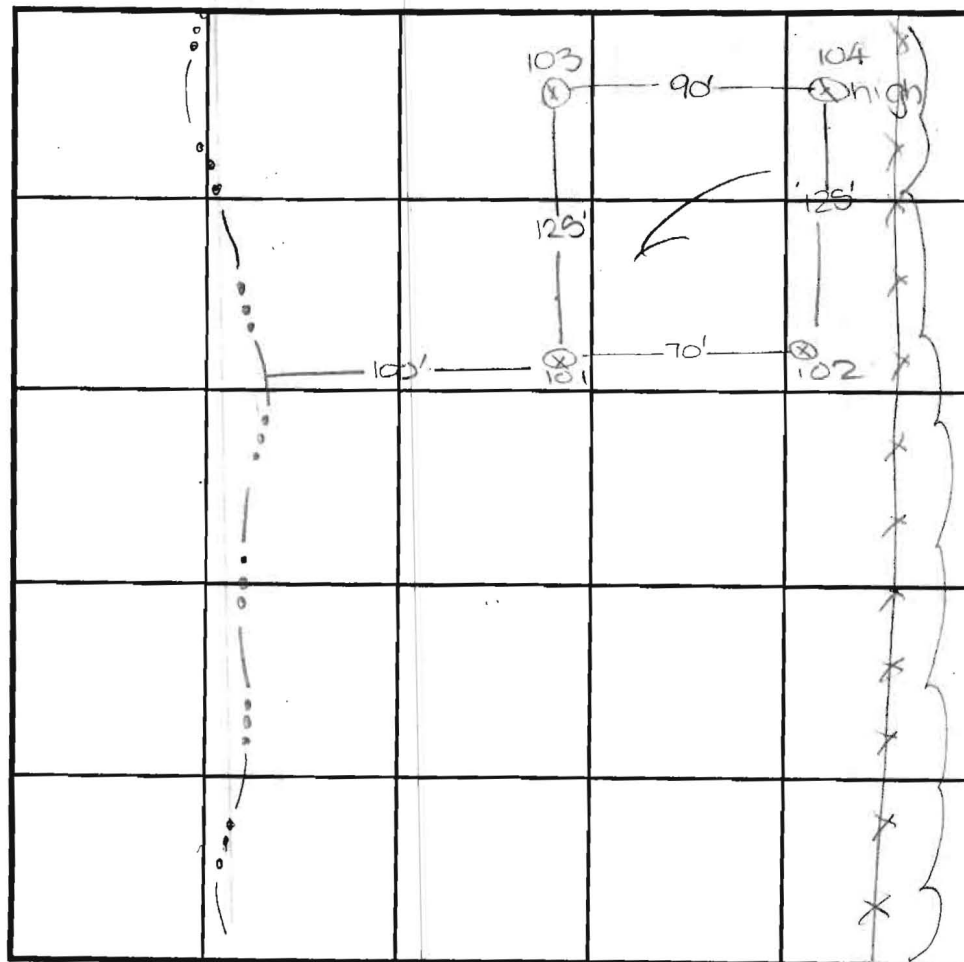

INDICATE NORTH - NAME ADJOINING ROADWAY AS BASE LINE.

Bushy Park Road

DATE	TEST NO.	DEPTH	PRE-WET		TEST - 1" DROP		TIME
			START	STOP	START	STOP	
5-10-01	101	2.5' S	10:29	10:38	10:38	10:48	10
		13.0' D	visual	- see	profile		OK
	102	2' 8" S	10:31	10:33	10:33	10:36	3
		14.0' D	visual	- see	profile		OK
	103	2' 8" S	10:47	10:51	10:51	10:56	6
		13.5' D	visual	- see	profile		OK
	104	13.5' D	visual	- see	profile		OK

REMARKS holes tested as stated in heavy woods

TYPE OF SOIL \_\_\_\_\_

TESTED BY DKE ALSO PRESENT T. Feaga, C. ZoppTRENCH DESIGN DATA: AVERAGE PERCOLATION TIME 6 TRENCH WIDTH 3INLET DEPTH 2.5 MAXIMUM BOTTOM DEPTH 4.5 SQ. FT./BEDROOM 180



EX. WELL



PERC CERTIFICATION  
I CERTIFY THAT THE LOCATIONS SHOWN (●) HEREON ARE BASED ON FIELD LOCATIONS DONE UNDER MY DIRECT SUPERVISION, AND ARE CORRECT TO THE BEST OF MY PROFESSIONAL KNOWLEDGE & BELIEF.  
*G. Scott Shanaberger*  
G. SCOTT SHANABERGER  
PROFESSIONAL LAND SURVEYOR # 10849  
DATE 6/25/01

COUNTRY SPRINGS  
LOTS 1-42  
PLAT # 9647-#9652

POSSIBLE  
LOCATION SEPTIC  
AREA

LOT 42

EX. 20' DRAINAGE & UTILITY EASEMENT  
PER PLAT # 9648  
130.05'

504° W 63 1/4° P. (1043.63')

N 07° 55' 34" E 396.00'

N/F  
SMITH  
1029/84

EX. WELL

APPROXIMATE  
LOCATION SEPTIC  
AREA

"POOLE PROPERTY"  
(MILES et al)  
3 AC. ±  
1044/534

N 4° E 676.50'

N/F  
FARKER et al  
10/479

N/F  
BONNER  
11/1/680

NOTES:

1. SUBJECT PROPERTY IS ZONED RC-DEO.
2. THE TOPOGRAPHY SHOWN HEREON WAS FIELD RUN BY SHANABERGER & LANE IN JUNE OF 2001.
3. THE LOTS SHOWN HEREON COMPLY WITH THE MINIMUM OWNERSHIP WIDTH & LOT AREA AS REQUIRED BY THE MD. STATE DEPT. THE ENVIRONMENT.
4. THIS AREA DESIGNATES A PRIVATE SEWAGE EASEMENT OF AT LEAST 10,000 S.F. AS REQUIRED BY THE MD. STATE DEPT. OF THE ENVIRONMENT FOR INDIVIDUAL SEWAGE DISPOSAL. IMPROVEMENTS OF ANY NATURE IN THIS AREA ARE RESTRICTED. THIS EASEMENT SHALL BECOME NULL & VOID UPON CONNECTION TO A PUBLIC SEWAGE SYSTEM. THE COUNTY HEALTH OFFICER SHALL HAVE THE AUTHORITY TO GRANT VARIANCES FOR ENCROACHMENTS INTO THE PRIVATE SEWAGE EASEMENT PLAT SHALL NOT BE NECESSARY.
5. B.R.L. DESIGNATES BUILDING RESTRICTION LINE.
6. ▲ DESIGNATES EXISTING WELL LOCATION.  
△ DESIGNATES PROPOSED WELL LOCATION.
7. ● DESIGNATES APPROVED PERC TEST LOCATION
8. ——— DESIGNATES SWALE OR STREAM
9. ⊠ DESIGNATES PROPOSED HOUSE LOCATION.
10. ALL VISIBLE WELLS AND SEPTIC SYSTEMS WITHIN 100 FEET OF THE PROPERTY HAVE BEEN SHOWN HEREON.
11. A PUMPED SEPTIC SYSTEM WILL BE REQUIRED.

APPROVED: FOR PRIVATE WATER &  
PRIVATE SEWAGE SYSTEMS.  
HOWARD COUNTY HEALTH  
DEPARTMENT.

*Reginald B. Brel*  
HOWARD COUNTY HEALTH OFFICER  
DATE 6/27/01

SHANABERGER & LANE  
8726 TOWN & COUNTRY BLVD.  
SUITE 201  
ELLCOTT CITY, MD. 21043  
PHONE: 410-461-9563  
FAX: 410-461-9693

FIELD-LOCATED  
PERC TEST PLAT  
"POOLE PROPERTY"  
ELECTION DISTRICT, HOWARD COUNTY, MD  
TAX MAP 8 BLOCK 21  
PARCEL 70  
ZONED: RC-DEO  
SCALE: 1"=50'  
JUNE 21, 2001

PC 515032