


B 00136003
3000 Seneca Chief Ct
Brantwood lot 30
No Conflict - well on site
kindly 5/8/02

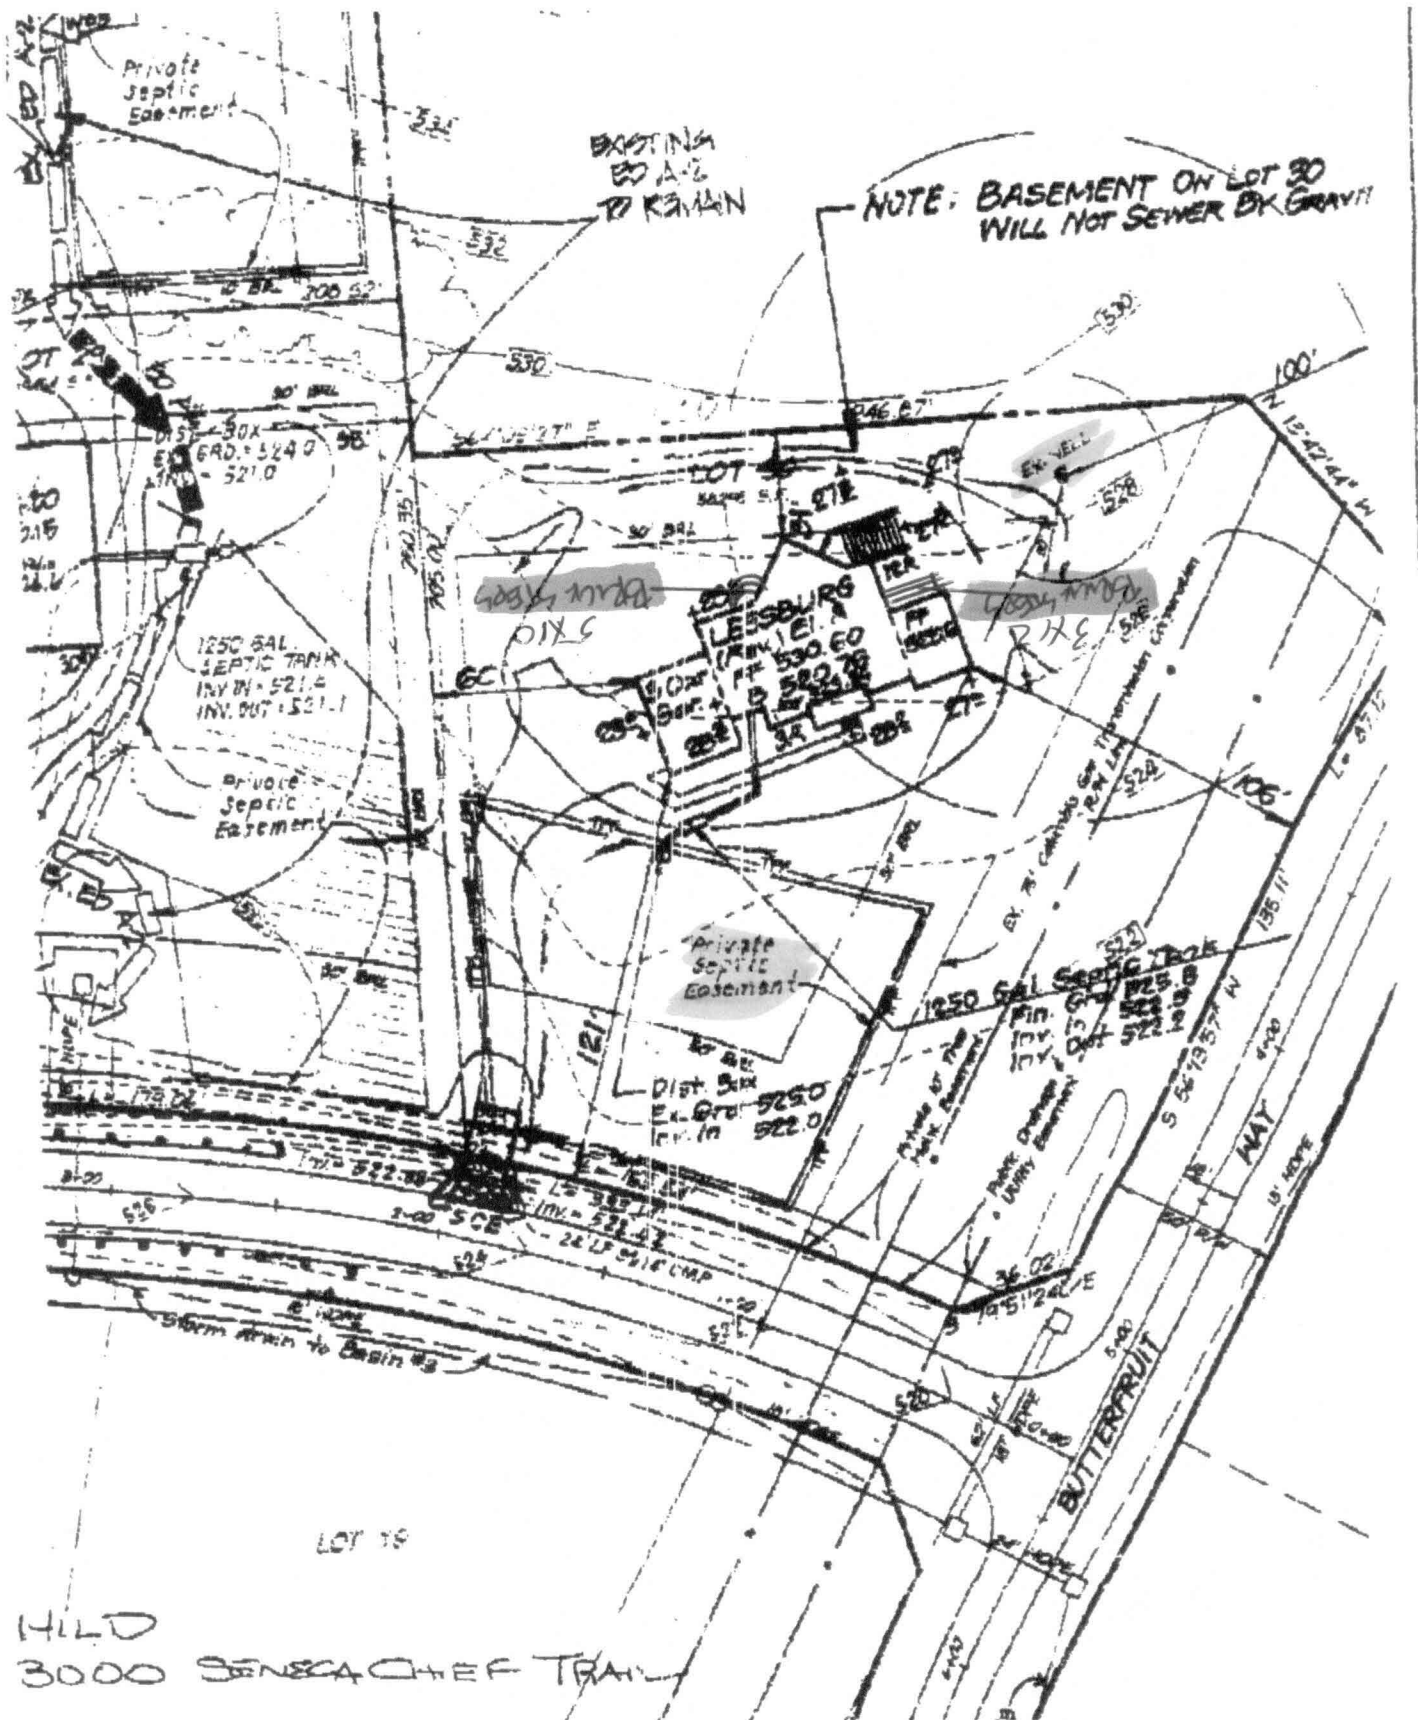


Approved Septic System Plan Howard County Health Department

DIST. BOX
EX-GRD. = 537.5
INV. = 534.5

Amey M. Miller
Signature Date 2/16/01
EXISTING ED A-2 TO REMAIN

total linear feet trench required 240 feet
width of trench (es) 3.0 feet
depth of trench (es) 5.0 feet
depth of stone required below distribution pipe 2.0 feet

NOTE: BASEMENT ON LOT 30 WILL NOT SEWER BY GRAVITY

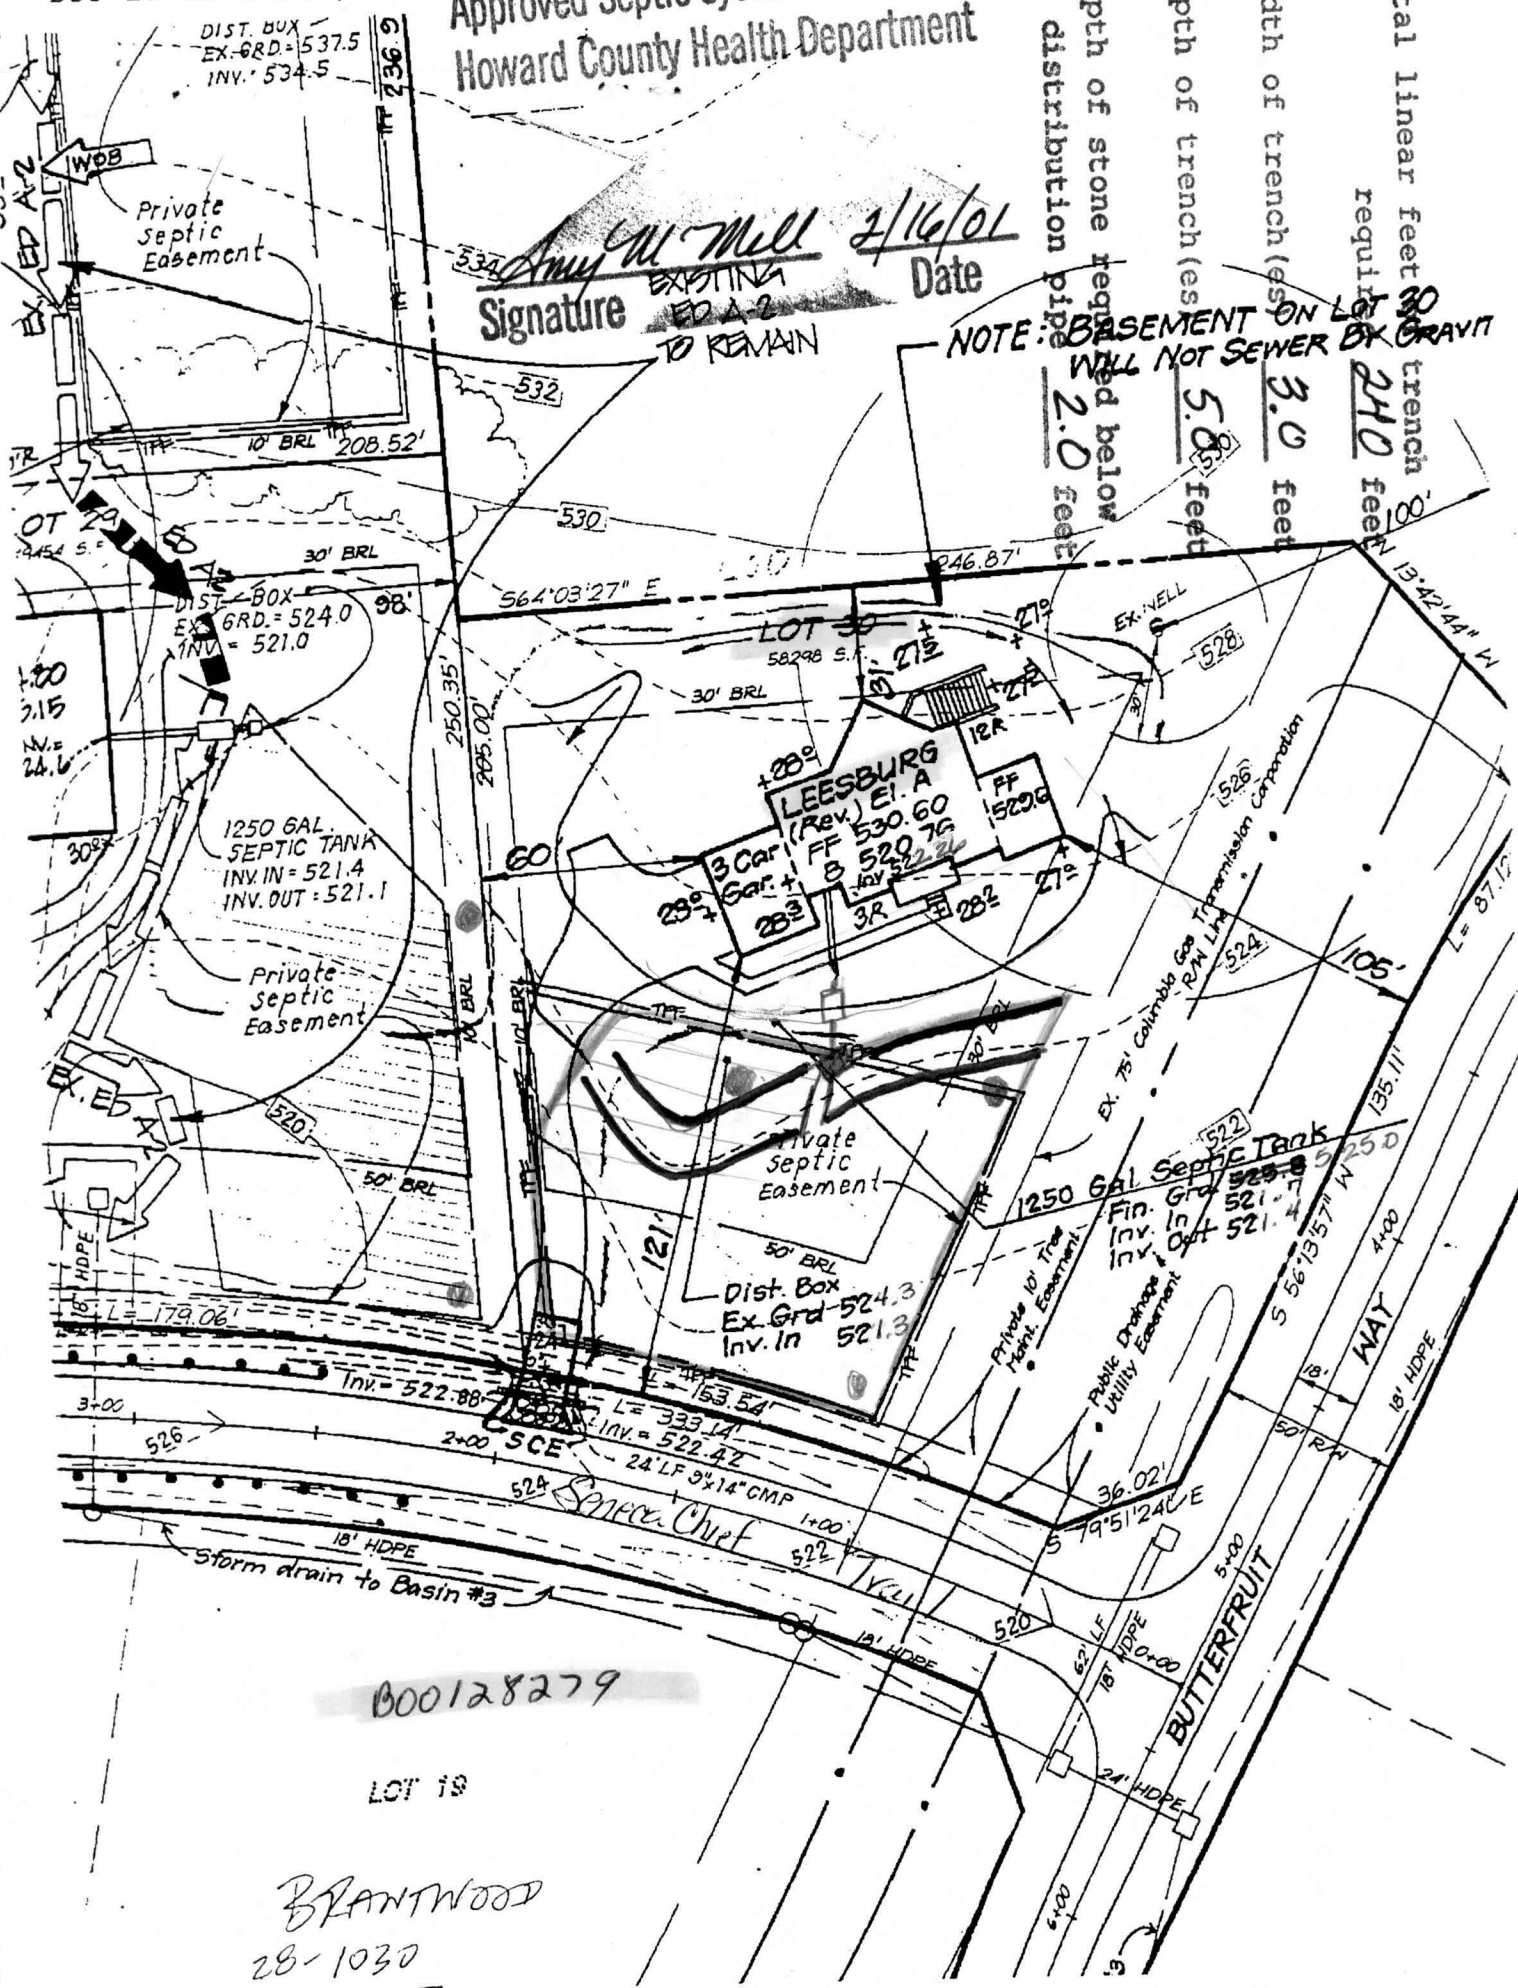

000128279

LOT 19

BRANTWOOD
28-1030