


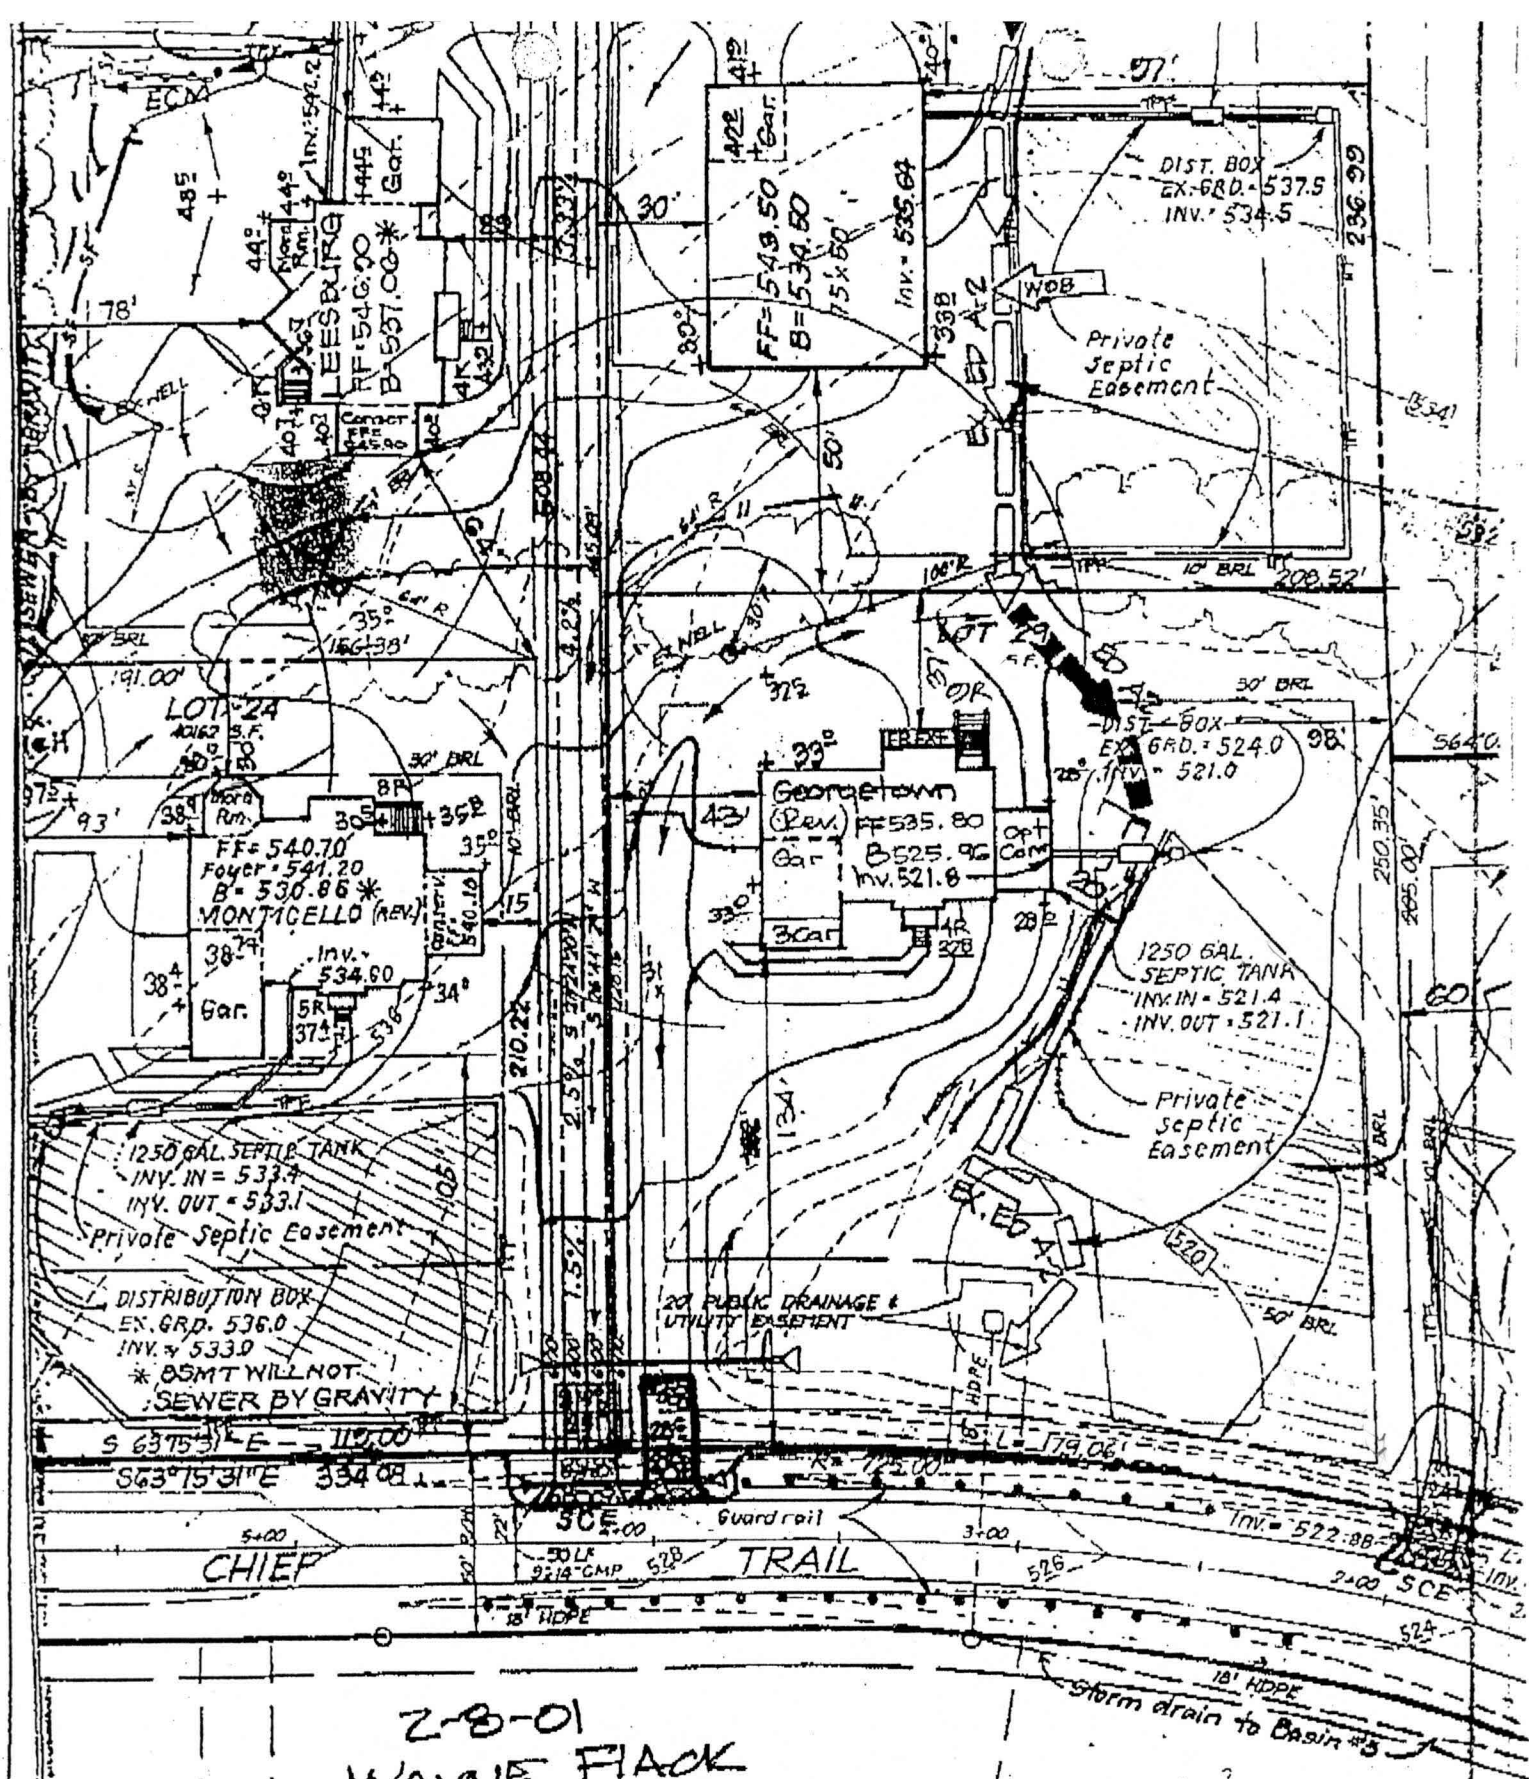

2-B-01
 WAYNE FLACK
 @ N.V. HOMES
 Brantwood LOT 29

GRAVITY
 SEWER SERVICE
 BASINMENT 00030

Approved Septic System Plan
 Howard County Health Department

Total linear feet of trench
 required 240 feet

Width of trench(es) 3 feet

Depth of trench(es) 5 feet

Depth of stone required below
 distribution pipe 2 feet

Wayne Flack 3/1/01
 Signature Date

P-1

410-381-7533

Feb 08 01 02:31P

FEB 20 10 10:39