

APPLICATION

PERCOLATION TESTING

HOWARD COUNTY HEALTH DEPARTMENT
BUREAU OF ENVIRONMENTAL HEALTH
3525-H ELLICOTT MILLS DRIVE/ELLICOTT CITY, MARYLAND 21043
TELEPHONE: 313-2840

A _____

P _____

DISTRICT _____

DATE 8/15/95

TO: THE COUNTY HEALTH OFFICER
ELLICOTT CITY, MARYLAND

I HEREBY APPLY FOR THE NECESSARY TEST PRIOR TO APPLICATION FOR PERMIT TO CONSTRUCT (OR RECONSTRUCT) A SEWAGE DISPOSAL SYSTEM.

PROPERTY OWNER Fenger Family

ADDRESS _____ PHONE _____

AGENT OR PROSPECTIVE BUYER Land Marketing Inc. C/o Tim Fenger

ADDRESS 3243 Bethany Lane Ellicott City PHONE 313-8808

PROPERTY LOCATION:

SUBDIVISION Fenger Property LOT NO. 79

ROAD AND DESCRIPTION Rt 144 + Folly Quarter Rd

TAX MAP 16+23 PARCEL # 34+63

SIZE OF LOT 1 acre +/- TYPE BLDG. SFD
(SINGLE FAMILY DWELLING OR COMMERCIAL)

THE SYSTEM INSTALLED UNDER THIS APPLICATION IS ACCEPTABLE ONLY UNTIL PUBLIC FACILITIES BECOME AVAILABLE. I FULLY UNDERSTAND THE FEE CONNECTED WITH THE FILING OF THIS PERC TEST APPLICATION IS NON-REFUNDABLE UNDER ANY CIRCUMSTANCES. I ALSO AGREE TO COMPLY WITH ALL M.O.S.H.A. REQUIREMENTS IN TESTING THIS LOT.

Myarl A. Reil
(SIGNATURE OF APPLICANT)

APPROVED BY _____ FOR _____ DATE _____

DISAPPROVED BY _____ FOR _____ DATE _____

HOLD PENDING FURTHER TESTS _____

REASONS FOR REJECTION OR HOLDING _____

PERCOLATION TEST PLAT/PRELIMINARY PLAT - TITLE OR I.D. # _____ DATE _____

SITE DEVELOPMENT PLAN/FINAL PLAT - TITLE OR I.D. # _____ DATE _____

THIS IS NOT A PERMIT

COUNTY #

SOIL PROFILE

0' 7028 7029

1gt
orange
brown
silm2.0 red brn
silm
pockets
of
decayed
white
quartz


7030

tan
silm3.0 splotchy
red &
yellow
silm6.0 dark
red
silm
100%
saprolite

12.0

SOIL PROFILE

0'

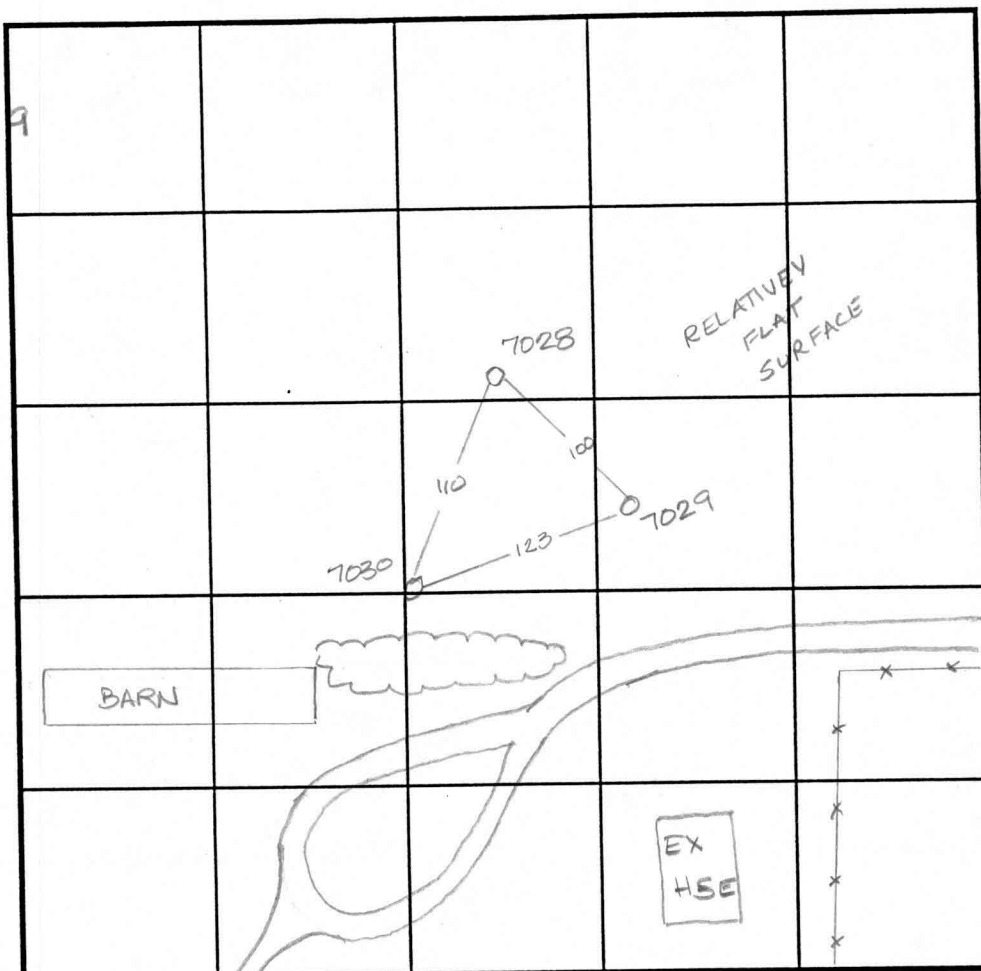

INDICATE NORTH - NAME ADJOINING ROADWAY AS BASE LINE.

DATE	TEST NO.	DEPTH	PRE-WET		TEST - 1" DROP		TIME
			START	STOP	START	STOP	
12-10-96	7028	2.0 V12.0	11:06	11:15	11:15	11:15	slow ✓
	7029	3.0 V12.0	1:59	2:00	2:00	2:02	2min ✓
	7029	Visual	only	see profile			OK ✓
	7030	2.0 V12.0	11:15	11:16	11:16	11:18	2min ✓

REMARKS

TYPE OF SOIL

TESTED BY

Amy McMillen

ALSO PRESENT

Mark Reich

TRENCH DESIGN DATA: AVERAGE PERCOLATION TIME

TRENCH WIDTH

INLET DEPTH

MAXIMUM BOTTOM DEPTH

SQ. FT./BEDROOM

APPLICATION

PERCOLATION TESTING

HOWARD COUNTY HEALTH DEPARTMENT
BUREAU OF ENVIRONMENTAL HEALTH
3525-H ELLICOTT MILLS DRIVE/ELLICOTT CITY, MARYLAND 21043
TELEPHONE: 313-2640

A _____

P _____

DISTRICT _____

DATE 8/15/95

TO: THE COUNTY HEALTH OFFICER
ELLICOTT CITY, MARYLAND

I HEREBY APPLY FOR THE NECESSARY TEST PRIOR TO APPLICATION FOR PERMIT TO CONSTRUCT (OR RECONSTRUCT) A SEWAGE DISPOSAL SYSTEM.

PROPERTY OWNER Feargus Family

ADDRESS _____ PHONE _____

AGENT OR PROSPECTIVE BUYER Land Marketing, Inc. C/O Tim Feargus

ADDRESS 3243 Bethany Lane Ellicott City PHONE 313-8808

PROPERTY LOCATION: 21042

SUBDIVISION Feargus Property LOT NO. X 8180

ROAD AND DESCRIPTION Rt 144 & Folly Quarter Rd

TAX MAP 16 & 23 PARCEL # 34 & 63

SIZE OF LOT 1 acre +/- TYPE BLDG. SFD
(SINGLE FAMILY DWELLING OR COMMERCIAL)

THE SYSTEM INSTALLED UNDER THIS APPLICATION IS ACCEPTABLE ONLY UNTIL PUBLIC FACILITIES BECOME AVAILABLE. I FULLY UNDERSTAND THE FEE CONNECTED WITH THE FILING OF THIS PERC TEST APPLICATION IS NON-REFUNDABLE UNDER ANY CIRCUMSTANCES. I ALSO AGREE TO COMPLY WITH ALL M.O.S.H.A. REQUIREMENTS IN TESTING THIS LOT.

Myrl A. Reil
(SIGNATURE OF APPLICANT)

APPROVED BY _____ FOR _____ DATE _____

DISAPPROVED BY _____ FOR _____ DATE _____

HOLD PENDING FURTHER TESTS _____

REASONS FOR REJECTION OR HOLDING _____

PERCOLATION TEST PLAT/PRELIMINARY PLAT - TITLE OR I.D. # _____ DATE _____

SITE DEVELOPMENT PLAN/FINAL PLAT - TITLE OR I.D. # _____ DATE _____

THIS IS NOT A PERMIT

COUNTY #

SOIL PROFILE

0' 1243 1242

1gt
tan
clm2' orange
brn
sil
strong
blocky
structure6' 1gt
brn
grey
sil
decayed
shale

11 1/2'


1245 1244

1gt
brn
sil2' orange
tan
sil6' brn
sil
100%
very
decayed
shale

12'

SOIL PROFILE

0'

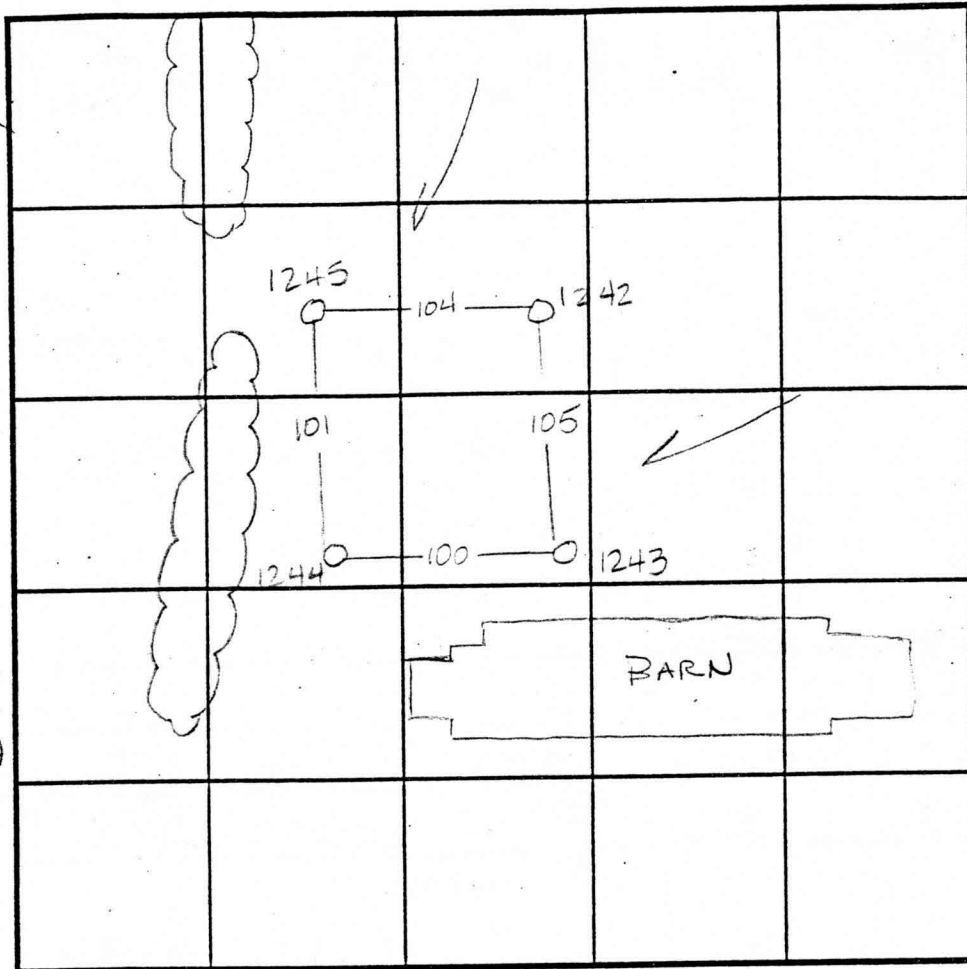

INDICATE NORTH - NAME ADJOINING ROADWAY AS BASE LINE.

DATE	TEST NO.	DEPTH	PRE-WET		*TEST - 1" DROP		TIME
			START	STOP	START	STOP	
9-19-95	1243	2' VII 1/2	2:19	2:21	2:21	2:23	2min ✓
	1243	5' VII 1/2	2:19 ⁵	2:22	2:22	2:25	3min ✓
	1242	25' VII	2:34 ¹⁰	2:35	2:35	2:36 ²⁰	1 1/2 min ✓
	1245	3' VII 2	2:37	2:40	2:40	2:41	2min
	1244	Visual	to 121	see profile	—	—	OK

REMARKS


TYPE OF SOIL

TESTED BY Amy McMillen ALSO PRESENT Mark Reich

TRENCH DESIGN DATA: AVERAGE PERCOLATION TIME TRENCH WIDTH


INLET DEPTH MAXIMUM BOTTOM DEPTH SQ. FT./BEDROOM

11-13-97

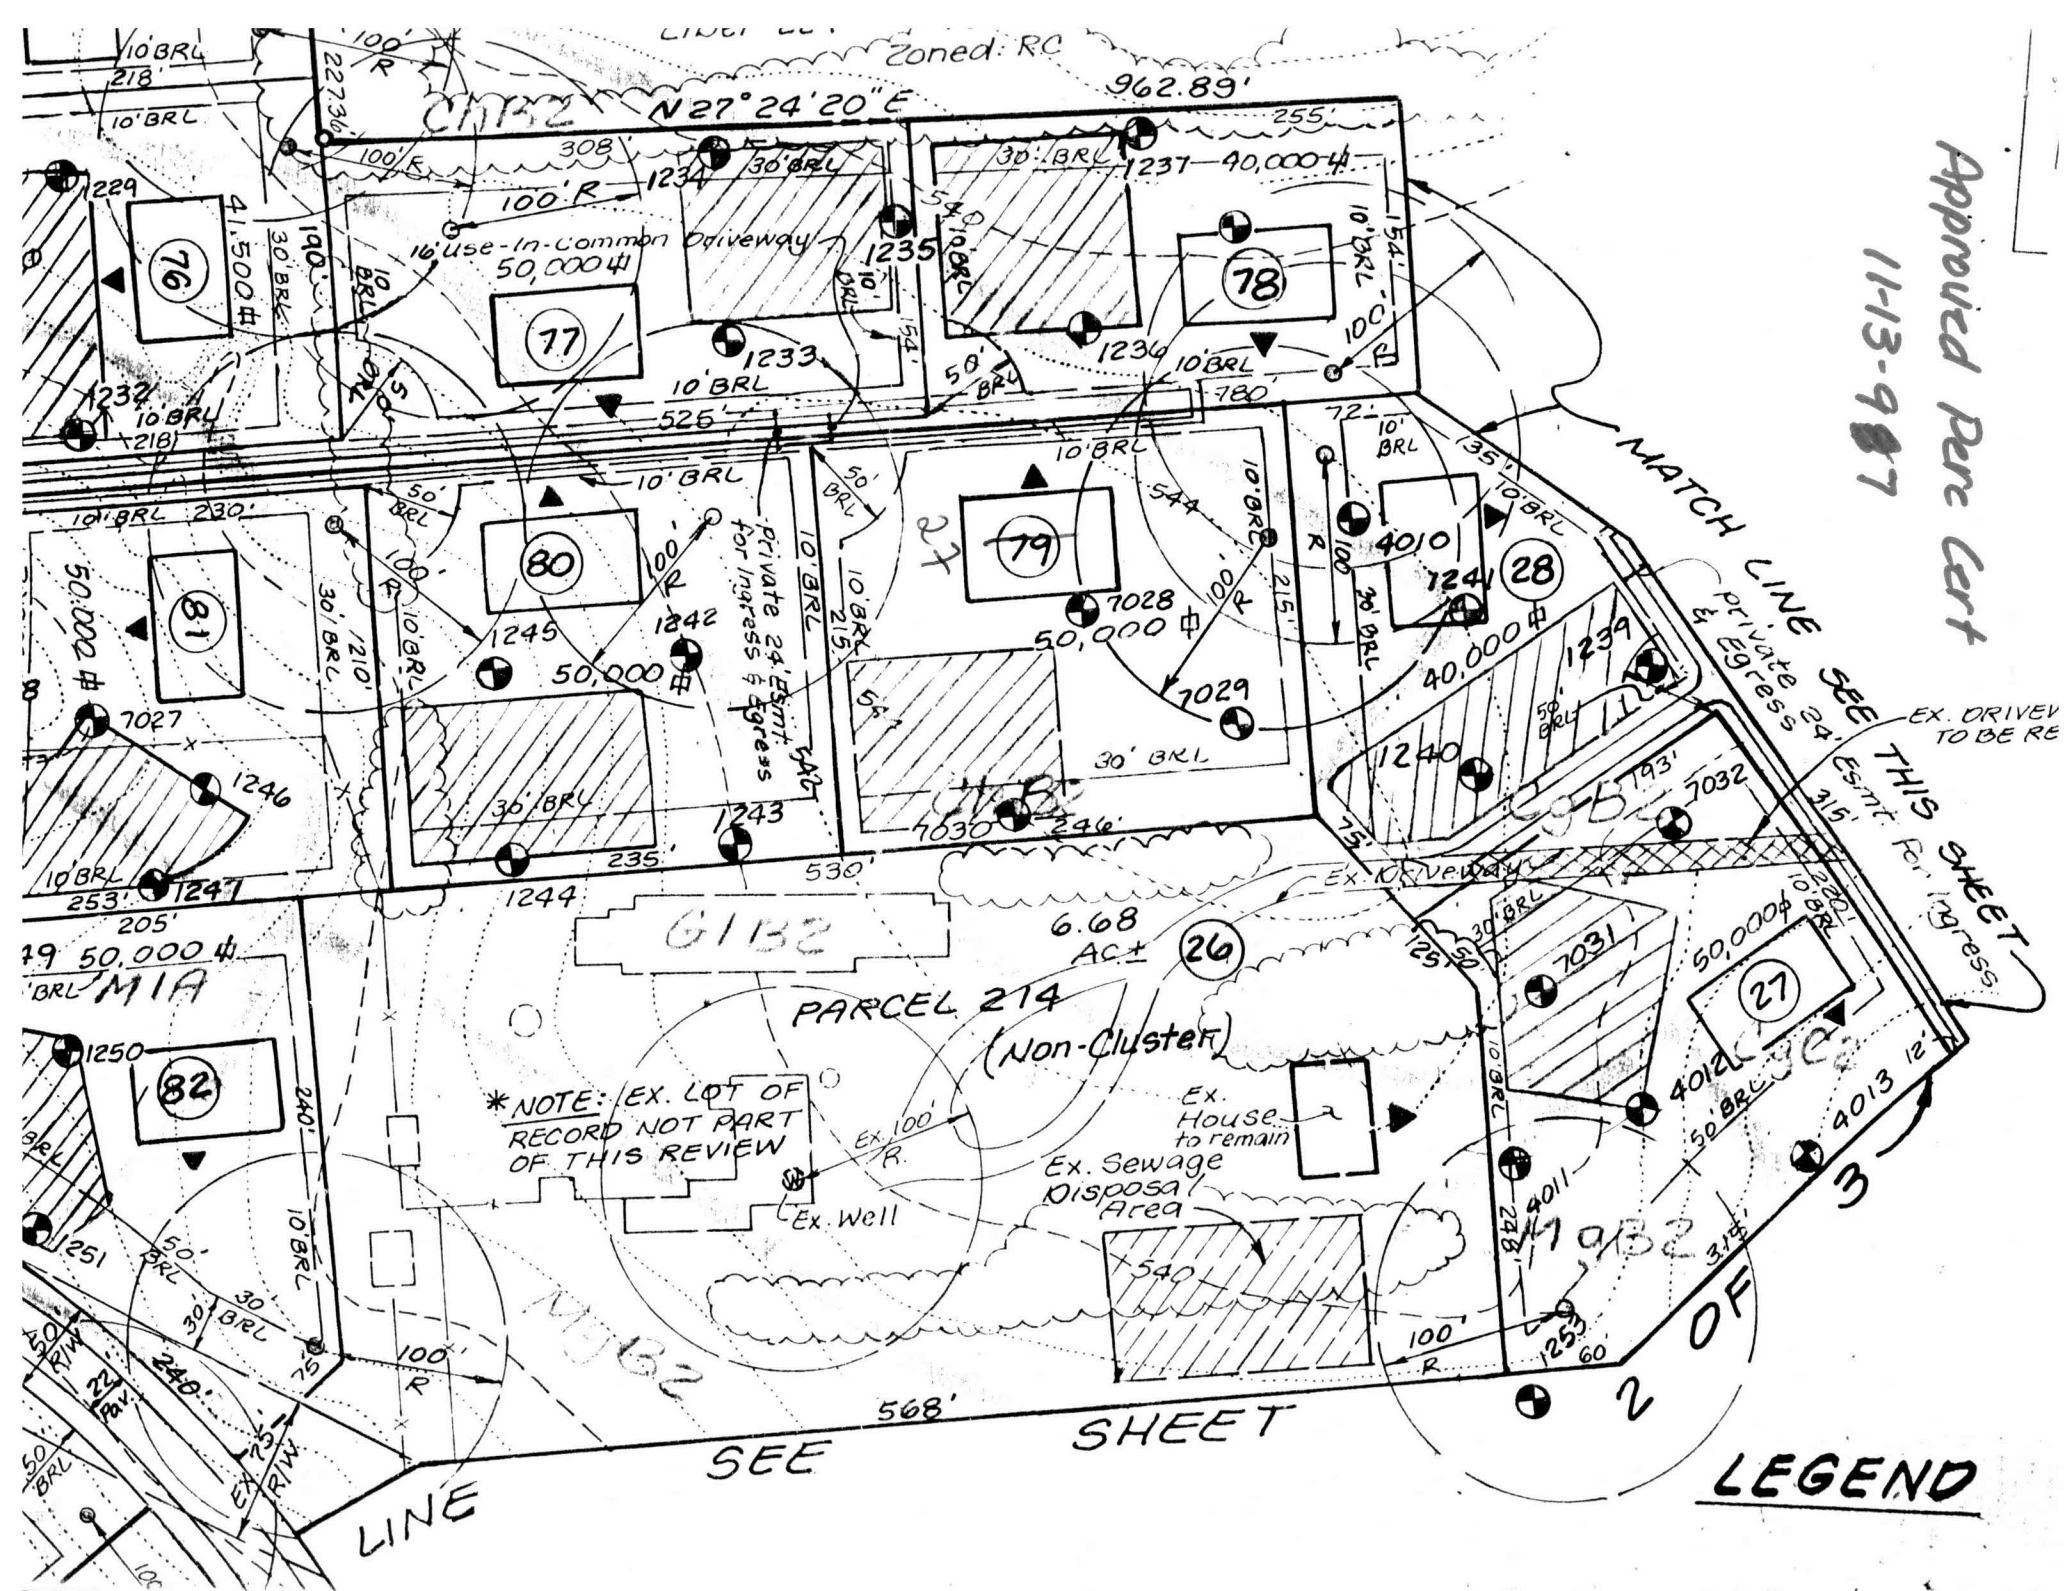

P-98-09

RUDOLPH
L. 162
Zon

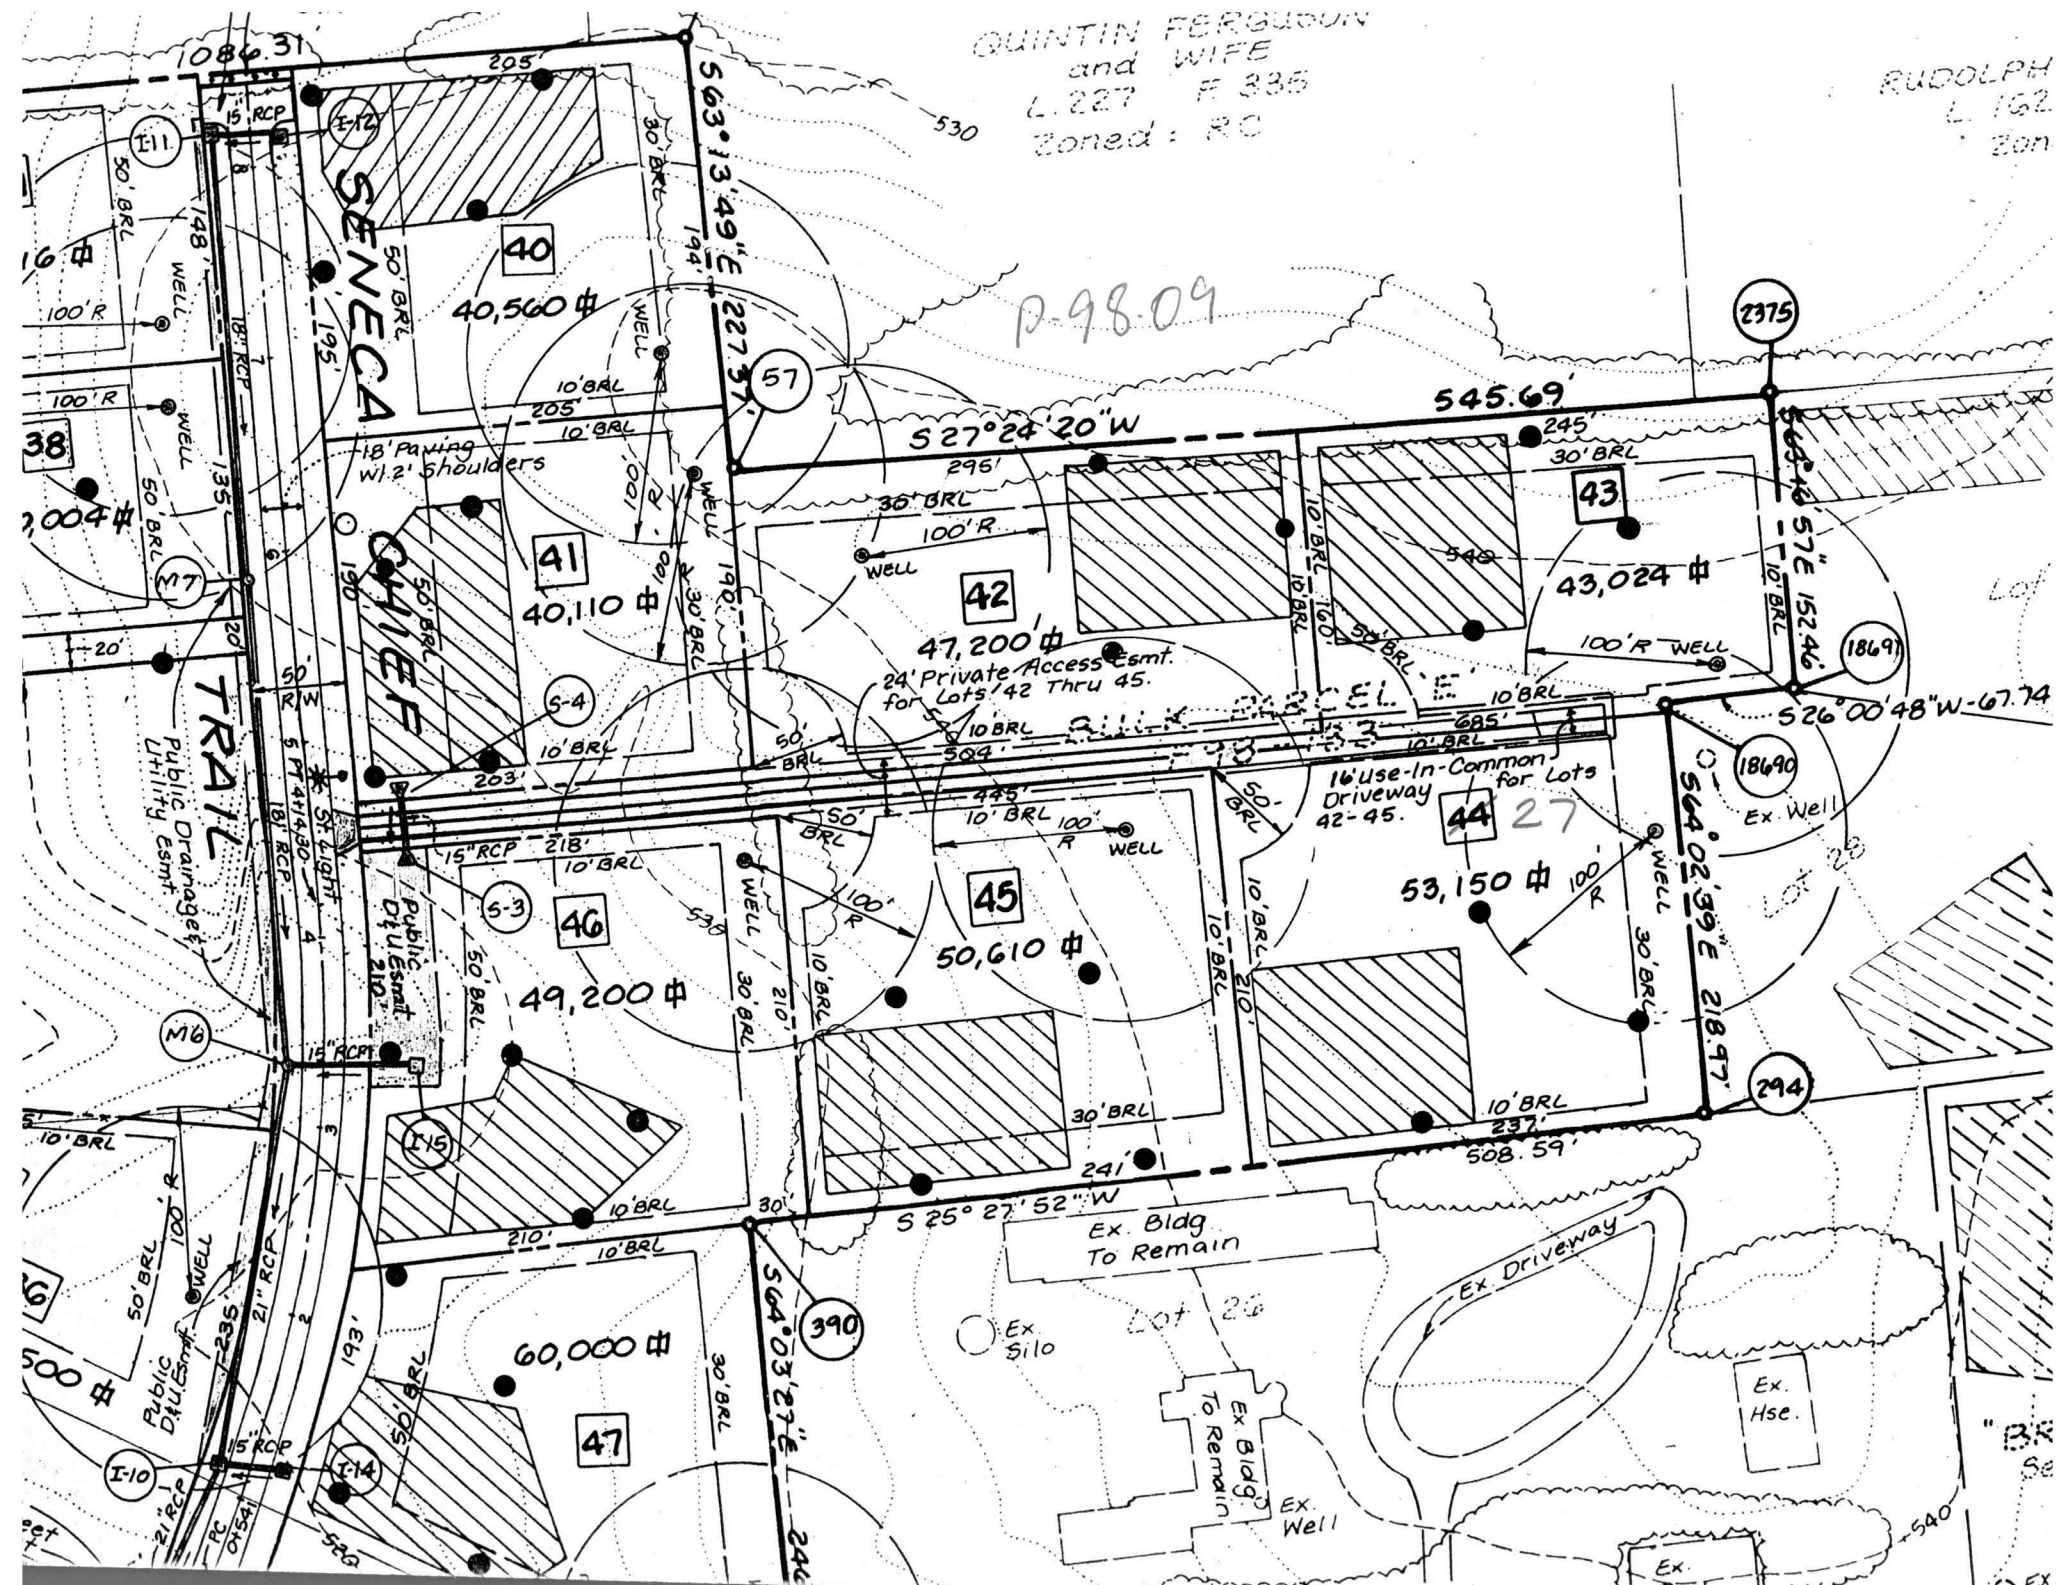

Developer reserves unto easements shown on this stormwater management parcels located in, on, Parcels "E" & "F". Any shall be subjected to expressly stated in the shall execute and deliver appropriate, for the ec The deed(s) of easement recorded in the Land Re of the plat in accordance Planning and Zoning and

Rudolph
ET.,
162,
Zonec

$$\begin{array}{c} E \\ \hline \hline \phi \\ N \\ 2. \\ 7. \\ 10 \end{array}$$

No
for
(F9
and
(Pla

