

ISSUE DATE: 6/22/2001

APPROVAL DATE: 8-23-01

PERMIT

P 515302-A

A 51269-CC

INDEXED

ON-SITE SEWAGE DISPOSAL SYSTEM HOWARD COUNTY HEALTH DEPARTMENT BUREAU OF ENVIRONMENTAL HEALTH

South Carroll Backhoe IS PERMITTED TO INSTALL ☒ ALTER ☐

ADDRESS: 4410 Salem Bottom Road, 21157 PHONE NUMBER: 410-875-4197

SUBDIVISION: Brantwood II LOT NUMBER: 27

ADDRESS: 3012 Seneca Chief Trail PROPERTY OWNER: NVHomes

SEPTIC TANK CAPACITY (GALLONS): 1250 (TOP SEAM)

PUMP CHAMBER CAPACITY (GALLONS): N/A

NUMBER OF BEDROOMS: 4

SQUARE FEET PER BEDROOM: 180

LINEAR FEET OF TRENCH REQUIRED: 240

TRENCHES:	Trench to be 3.0 feet wide. Inlet 2.0 feet below original grade. Bottom maximum depth 4.0 feet below original grade. Effective area begins at 2.0 feet below original grade. 2.0 feet of stone below distribution pipe.
LOCATION:	Begin trenches 100 feet off the front lot line and 115 feet off the left lot line as seen when facing the lot from Seneca Chief Trail. Run trenches on contour toward the rear lot line.
NOTES:	

PLANS APPROVED: Amy Mc Millen OK SRU 4/12/01 DATE: 4-12-01

NOTE: PERMIT VOID AFTER 2 YEARS

NOTE: CONTRACTOR RESPONSIBLE FOR SCHEDULING A PRE-CONSTRUCTION INSPECTION FOR ALL INSTALLATIONS

NOTE: WATERTIGHT SEPTIC TANKS REQUIRED


NOTE: ALL PARTS OF SEPTIC SYSTEM SHALL BE 100 FEET FROM ANY WATER WELL

NOTE: MANHOLE RISERS REQUIRED ON ALL SEPTIC TANKS AND PUMP CHAMBERS

**NEITHER THE HOWARD COUNTY COUNCIL NOR THE HEALTH DEPARTMENT IS
RESPONSIBLE FOR THE SUCCESSFUL OPERATION OF ANY SYSTEM
PERMITTEE RESPONSIBLE FOR OBTAINING FINAL APPROVAL ON THIS PERMIT
CALL 410-313-2640 FOR INSPECTION OF SEPTIC SYSTEM**

P 515302-A

NOT TO SCALE

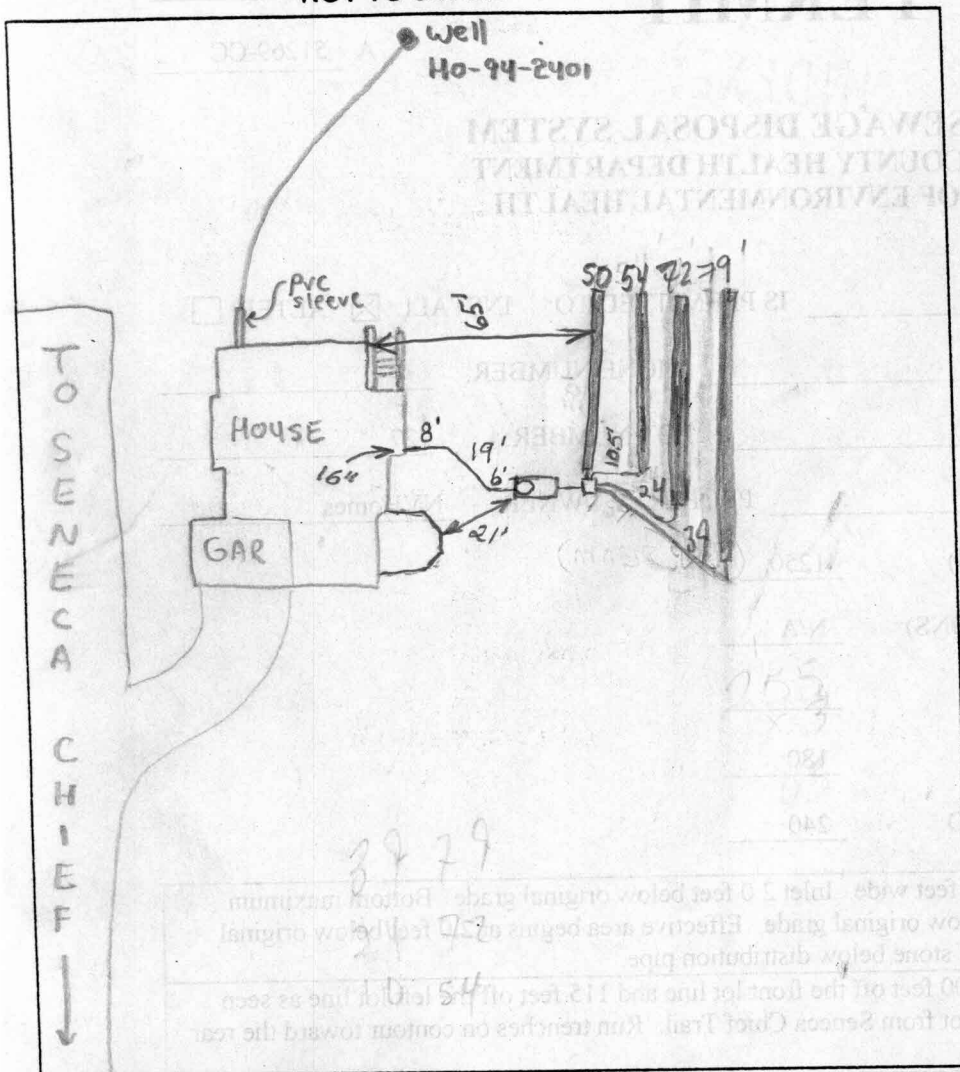

TRENCH DATA

TRENCH WIDTH 3
TRENCH INLET DEPTH 2-2 1/2
TRENCH BOTTOM DEPTH 4-4 1/2
DEPTH OF STONE 2
NUMBER OF TRENCHES 4
TOTAL TRENCH LENGTH 255.58
ABSORBENT AREA 765.42
DISTRIBUTION BOX LEVEL yes
BAFFLE IN DISTRIBUTION BOX yes

SEPTIC TANK DATA

SEPTIC TANK 1500 TS GALLONS
MANHOLE RISER Yes
6 INCH INSPECTION PORT No

PUMP CHAMBER DATA N/A

PUMP CHAMBER GALLONS _____
MANHOLE RISER _____
ALARM _____
PUMP PERFORMANCE TEST _____

PRE-CONSTRUCTION INSPECTION: 8/1/01 Installer thought tank had to be 20' from house.
Tank set in easement.

Whoted part of upper easement, but can be used for repairs if necessary. (BB)

INSPECTION COMMENTS: 8/1/01 Need house connection. First trench done. O.K. to cover. (BB)

8/2/01 OK TO COVER TRENCHES, HOLD FOR HOUSE CONN (MR)/KG

INSPECTOR Steven R. Krieg

DATE SYSTEM APPROVED 8-23-01