


Wall Check: 8-16-01
Top of Wall Elev.: 543.3
Final: 11-5-01

ANTON FERGUSON
and wife
227 / 335

RUDOLPH SHEMA, ET. AL.
162/48

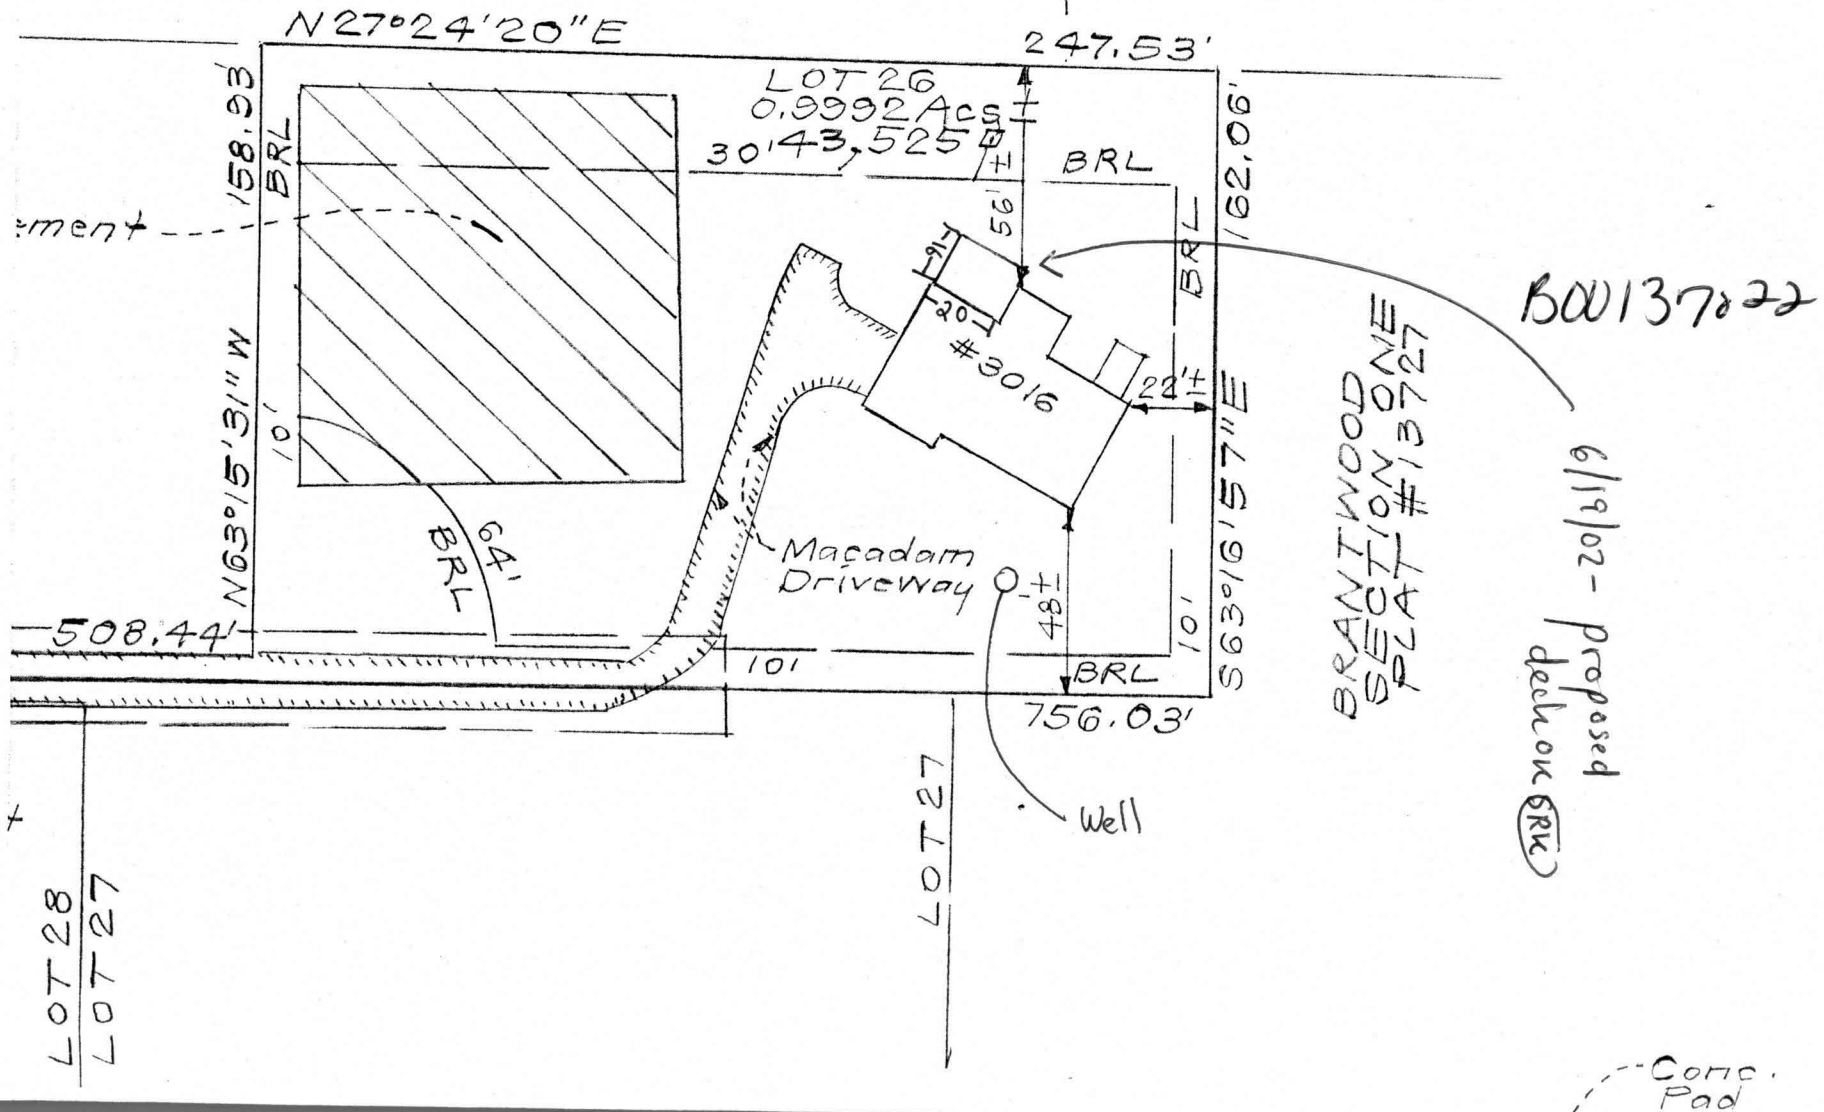

Approved Septic System Plan
Howard County Health Department

required 240 feet

Width of trench(es) 3.0 feet

Depth of trench(es) 6.0 feet

Signature

Date

Depth of stone required below
distribution pipe 2.0 feet

Apr 23 01 02:14p

VALUED CUSTOMER

410-381-7533

p.1

Wayne Flaek at N.Y.

Brantwood ~~assess~~ Lot 1026

4-23-01

CFS - 410-381-7500

NOTE:

EXISTING SILT FENCE ON
LOT 26 IS TO BE REMOVED
AND REPLACE WITH SUPER
SILT FENCE.

3016 Seneca Chief Trail

LOT 26

BRANTWOOD

N.Y. HOMES

04/23/01

#99-083538

UNION FERGUSON AND WIFE
227 / 335
ZONED: RC

