

APPLICATION

PERCOLATION TESTING

HOWARD COUNTY HEALTH DEPARTMENT
BUREAU OF ENVIRONMENTAL HEALTH
3525-H ELLICOTT MILLS DRIVE/ELLICOTT CITY, MARYLAND 21043
TELEPHONE: 313-2640

A _____
P _____
DISTRICT _____
DATE 8/15/95

TO: THE COUNTY HEALTH OFFICER
ELLICOTT CITY, MARYLAND

I HEREBY APPLY FOR THE NECESSARY TEST PRIOR TO APPLICATION FOR PERMIT TO CONSTRUCT (OR RECONSTRUCT) A SEWAGE DISPOSAL SYSTEM.

PROPERTY OWNER Fenger Family

ADDRESS _____ PHONE _____

AGENT OR PROSPECTIVE BUYER Land Marketing, Inc. C/o Tim Fenger

ADDRESS 3243 Bethany Lane Ellicott City PHONE 313-8808

21042

PROPERTY LOCATION:

SUBDIVISION Fenger Property LOT NO. 78 79 78

ROAD AND DESCRIPTION Rt 144 + Folly Quarter Rd

TAX MAP 16+23 PARCEL # 34+63

SIZE OF LOT 1 acre +/- TYPE BLDG. SFD
(SINGLE FAMILY DWELLING OR COMMERCIAL)

THE SYSTEM INSTALLED UNDER THIS APPLICATION IS ACCEPTABLE ONLY UNTIL PUBLIC FACILITIES BECOME AVAILABLE. I FULLY UNDERSTAND THE FEE CONNECTED WITH THE FILING OF THIS PERC TEST APPLICATION IS NON-REFUNDABLE UNDER ANY CIRCUMSTANCES. I ALSO AGREE TO COMPLY WITH ALL M.O.S.H.A. REQUIREMENTS IN TESTING THIS LOT.

Mal A. Reil
(SIGNATURE OF APPLICANT)

APPROVED BY _____ FOR _____ DATE _____

DISAPPROVED BY _____ FOR _____ DATE _____

HOLD PENDING FURTHER TESTS _____

REASONS FOR REJECTION OR HOLDING _____

PERCOLATION TEST PLAT/PRELIMINARY PLAT - TITLE OR I.D. # _____ DATE _____

SITE DEVELOPMENT PLAN/FINAL PLAT - TITLE OR I.D. # _____ DATE _____

THIS IS NOT A PERMIT

COUNTY #

SOIL PROFILE

0' 1238 1237

1gt brn
silim
micaceous
50%
saprolite

6

orange
brown
salim

11.5

1236

1gt tan
silim

2'

reddish
brn
salim

10

pink
salim
micaceous
100%
saprolite

13'

1235


orange
brn
silim

4'

medium
brown
salim
w/ packets
of white
decayed
quartz
from
8-10

SOIL PROFILE

0'

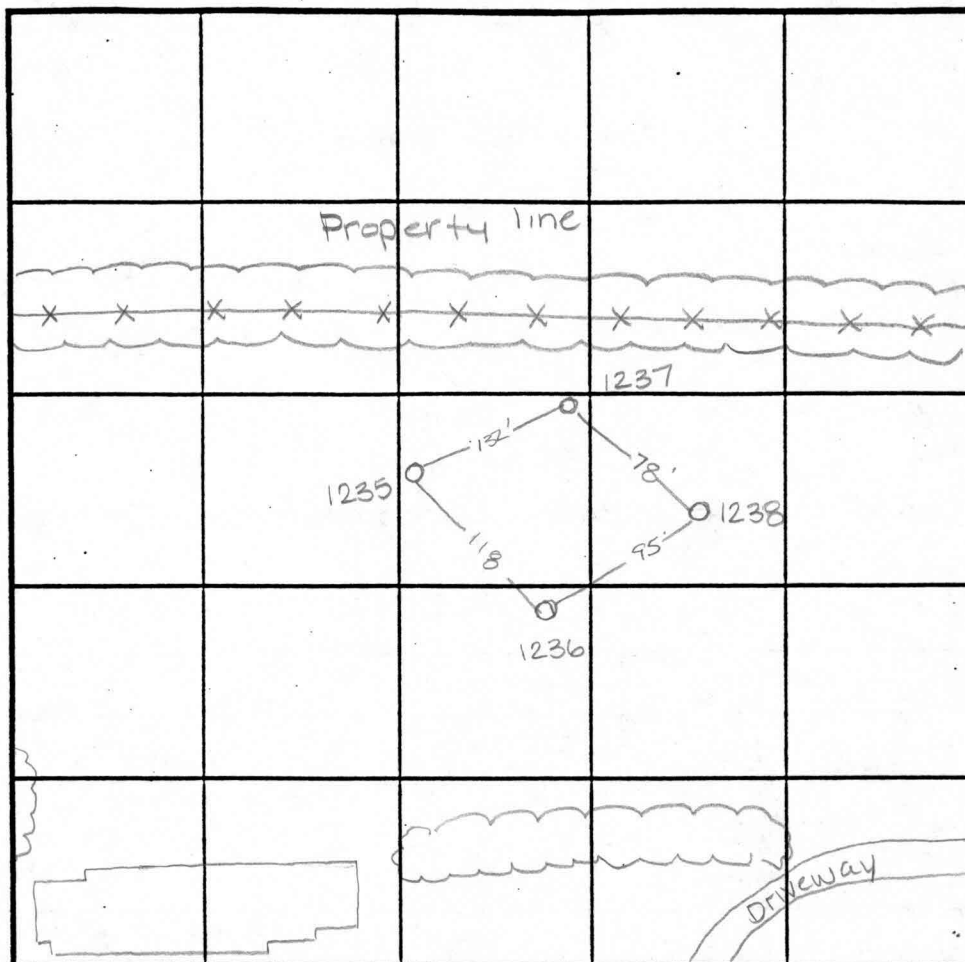

INDICATE NORTH - NAME ADJOINING ROADWAY AS BASE LINE.

DATE	TEST NO.	DEPTH	PRE-WET		TEST - 1" DROP		TIME
			START	STOP	START	STOP	
9-19-95	1238	2.5 VII.5	10:08	10:09 ⁴⁵	10:09 ⁴⁵	10:14 ¹⁵	4 1/2 min
	1236	6' VI.3'	10:19	10:26 ³⁰	10:26 ³⁰	10:36 ³⁰	10 min
	1236	4' VI.3'	10:19 ¹⁵	> 30 min	—	—	slow
	1237	3' VI.2'	10:24 ³⁰	10:28	10:28	10:33	5 min
	1235	3.5 VII'	10:35	10:46	10:46	10:55	9 min
	1236	7.0 VII'	10:58	10:59	10:59	11:04	5 min

REMARKS

TYPE OF SOIL

TESTED BY

Amy McMillan

ALSO PRESENT


Mark Reich

TRENCH DESIGN DATA: AVERAGE PERCOLATION TIME

TRENCH WIDTH

RUDOLPH
L. 162
Zonec

p. 98.09

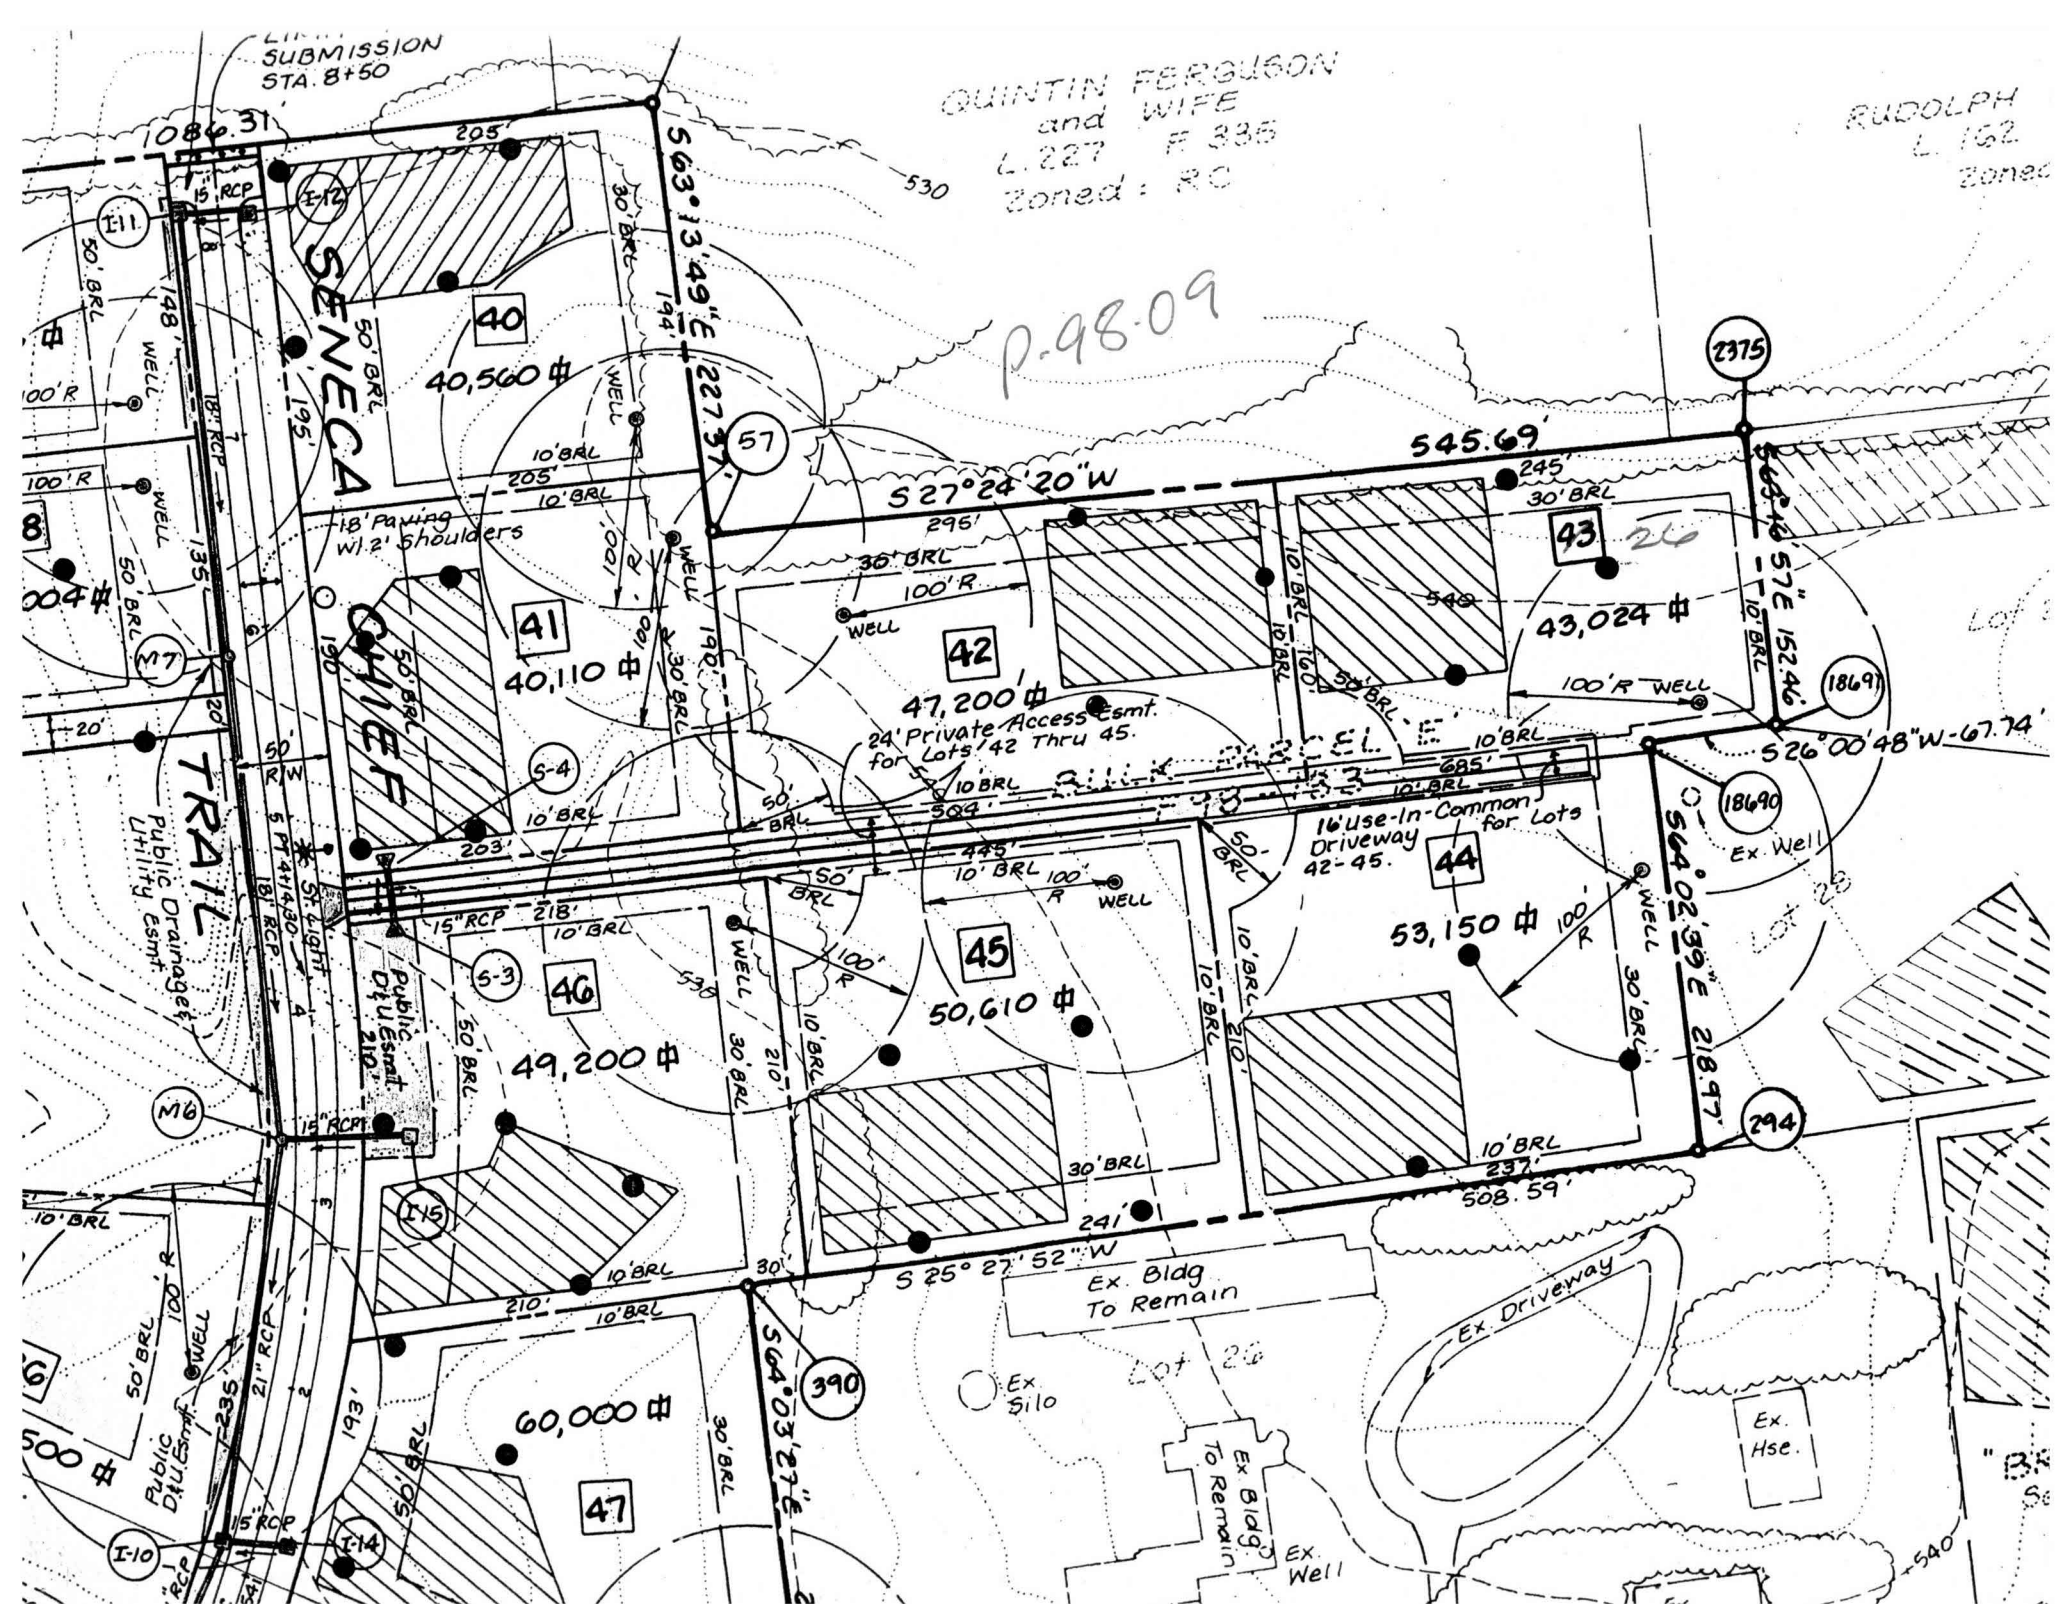

Approved Perc Cert
11-13-987

MATCH LINE SEE THIS SHEET


Private 24' Esmt. for Ingress & Egress
EX. DRIVEN TO BE RE

LEGEND

SHEET

SEE

LINE

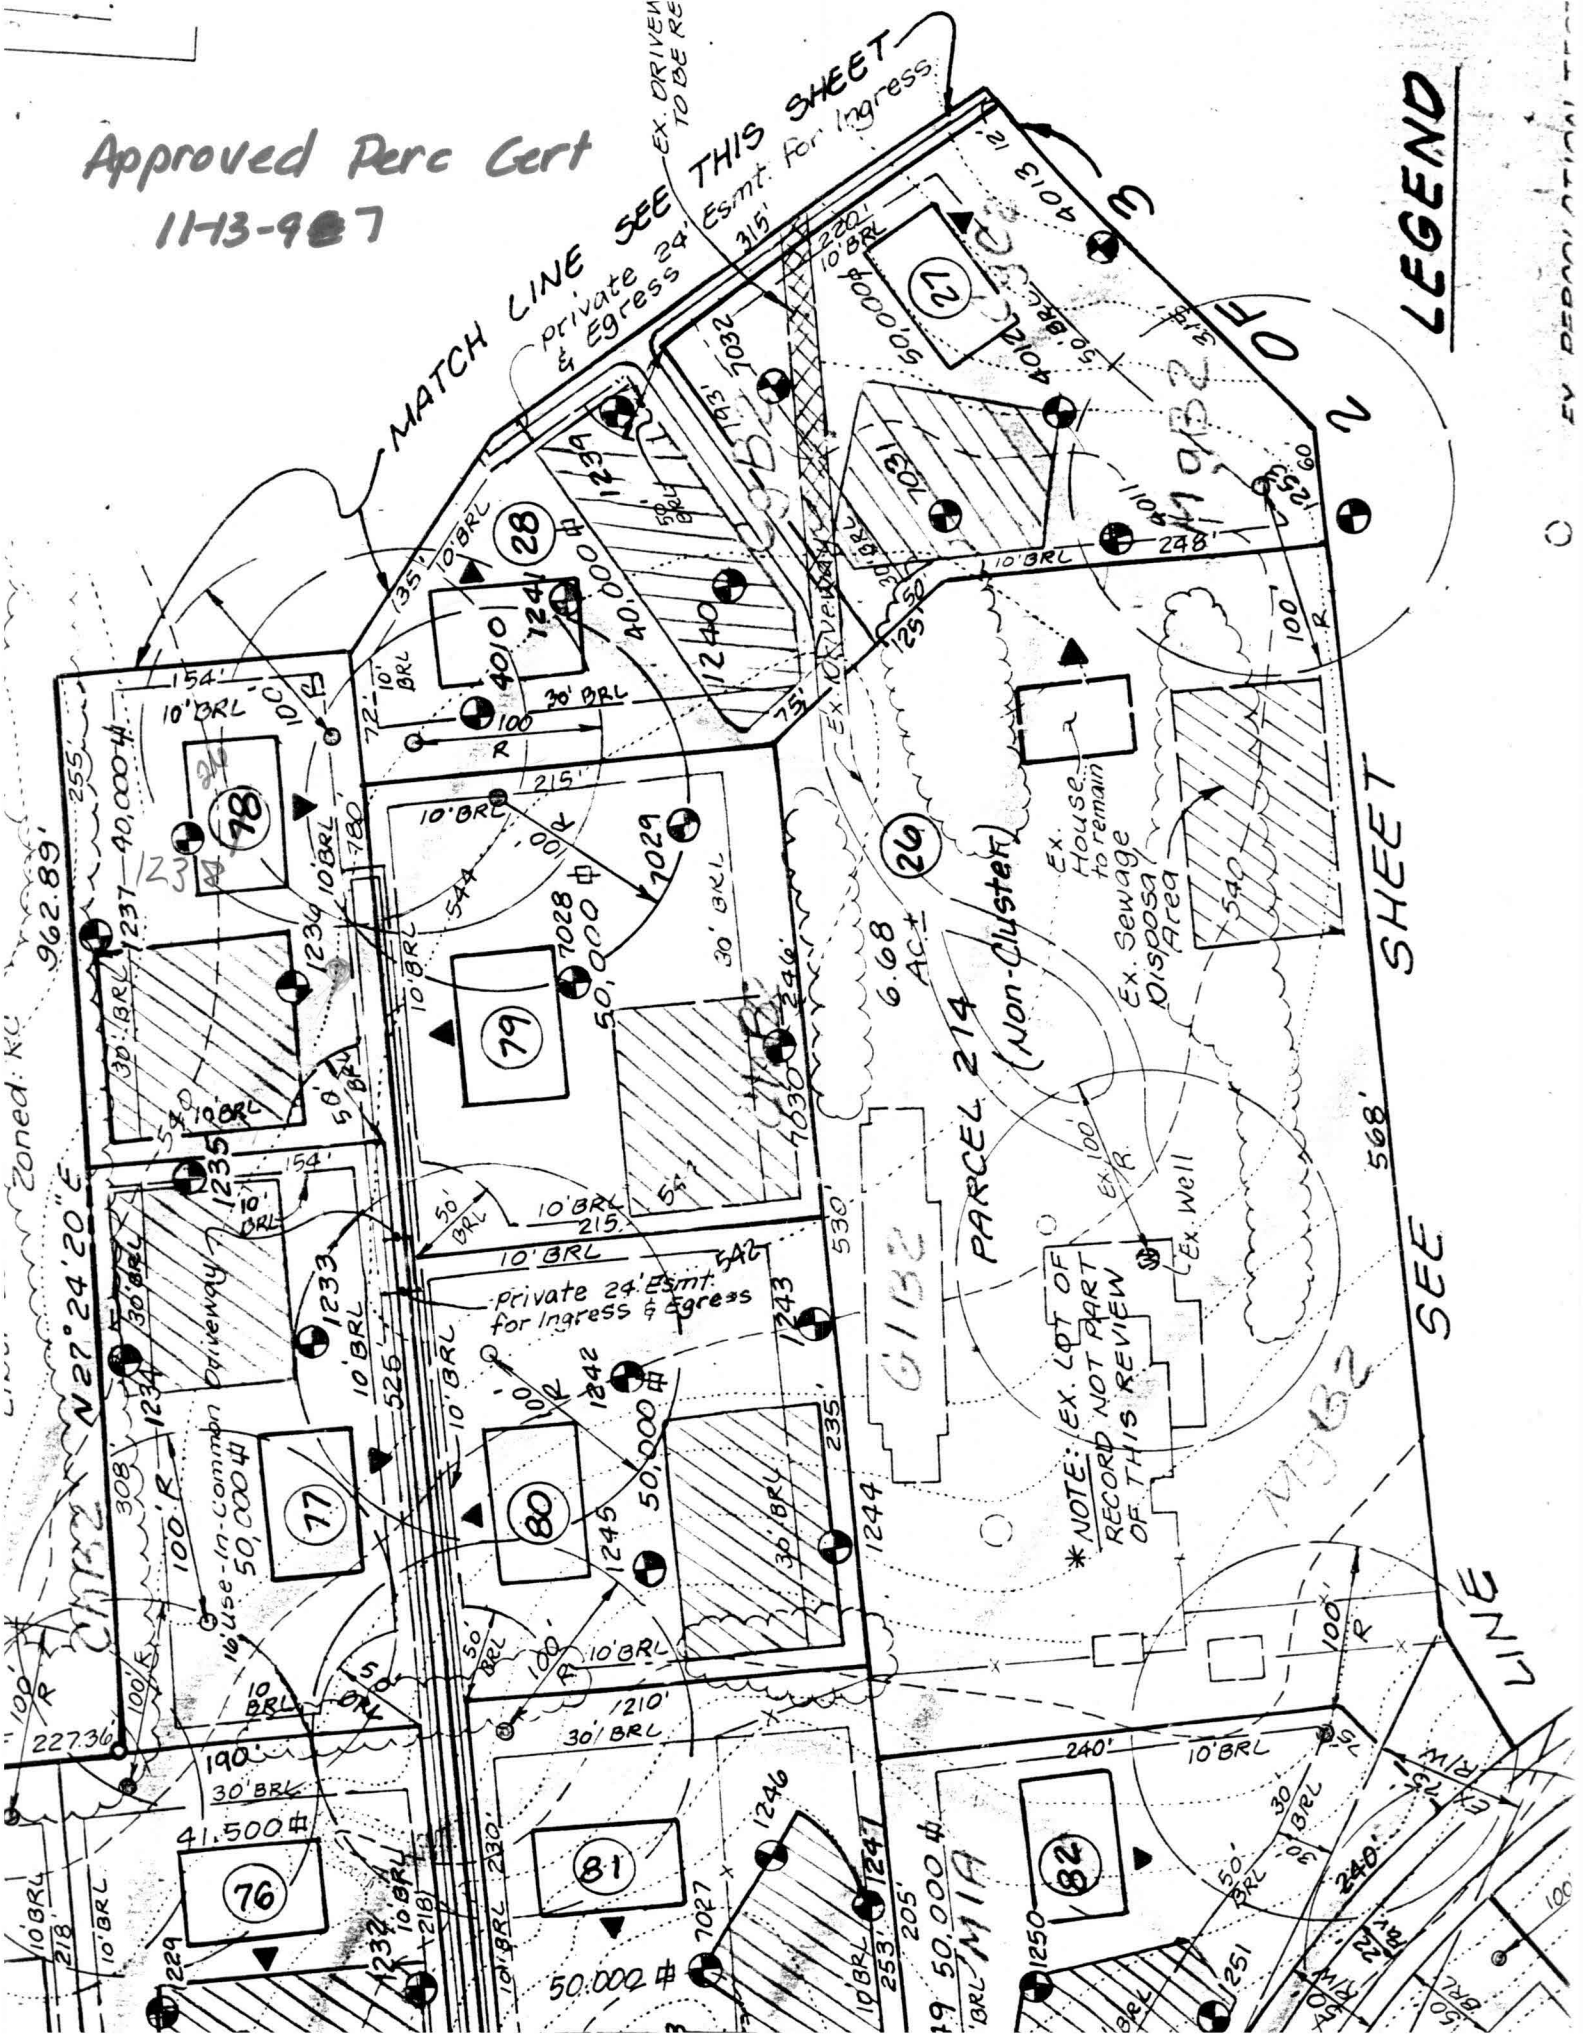


N.V. HOMES Attn: Jim Kerwin

Brantwood 1026 8-03-01

NOTE:

EXISTING SILT FENCE ON LOT 26 IS TO BE REMOVED AND REPLACE WITH SUPER SILT FENCE.

QUINTON FERGUSON AND WIFE
227 / 335
ZONED: RC

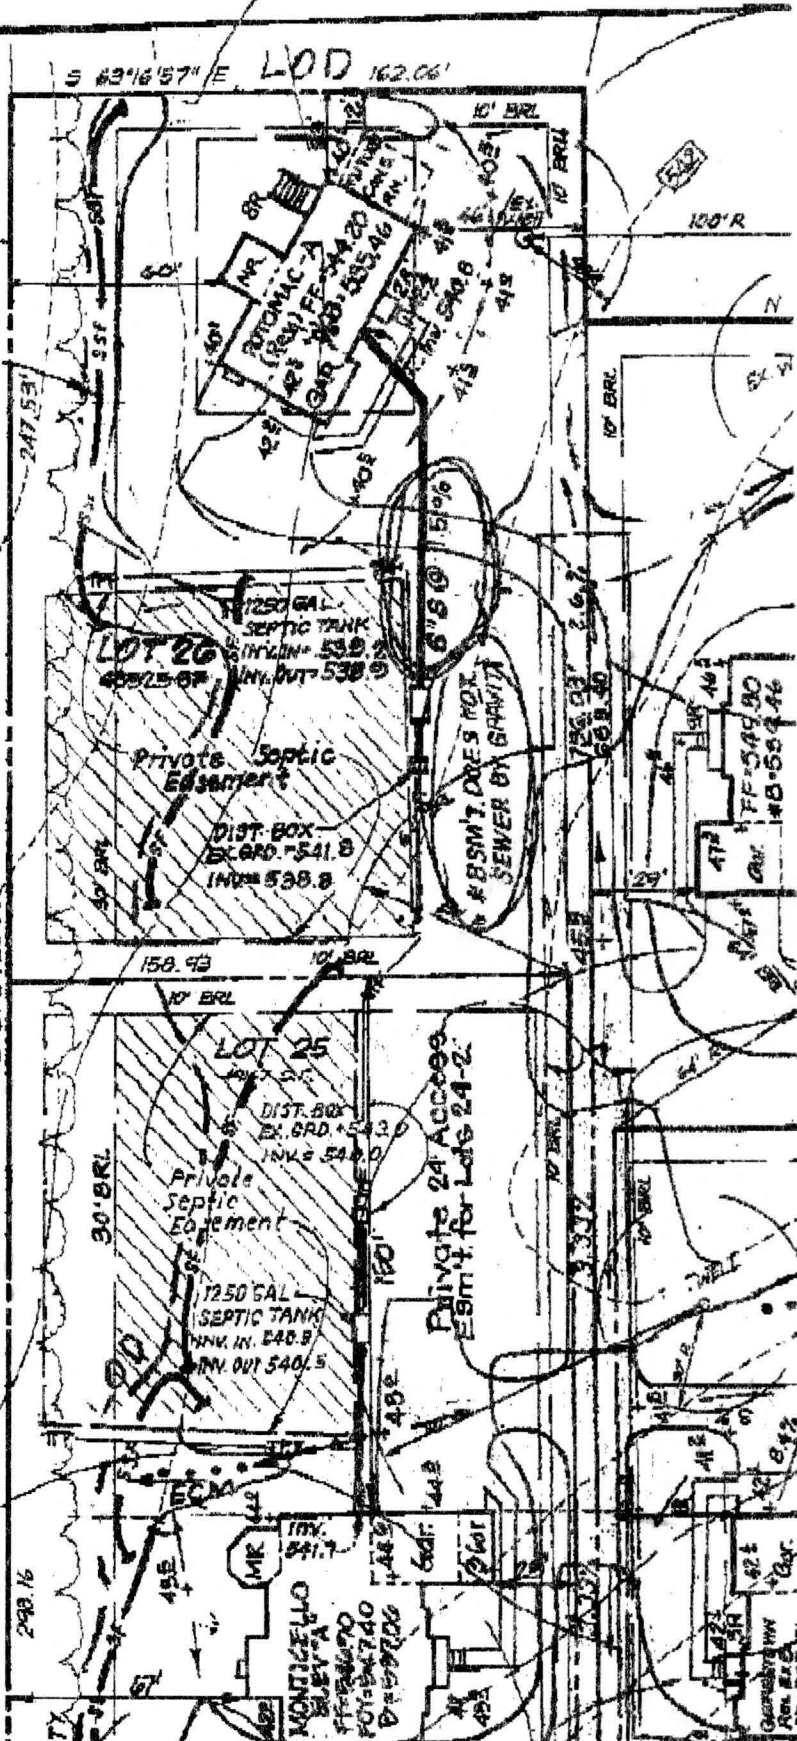

Private 10' Tree Maintenance
Esmt. & Revertible Grading Esmt.

Developer reserves unto easements shown on this stormwater management for parcels located in, on, or near Parcels "E" & "F". Any shall be subjected to the expressly stated in the shall execute and deliver appropriate, for the easement. The deed(s) of easement recorded in the Land Records of the plat in accordance Planning and Zoning and

Quinton Ferguson
and wife
227 / 335
Zoned: RC

Rudolph
ET. Al
162 /
Zoned:

Er
 4
 No
 25
 75
 10

No
for
(F9
and
(Pla

