


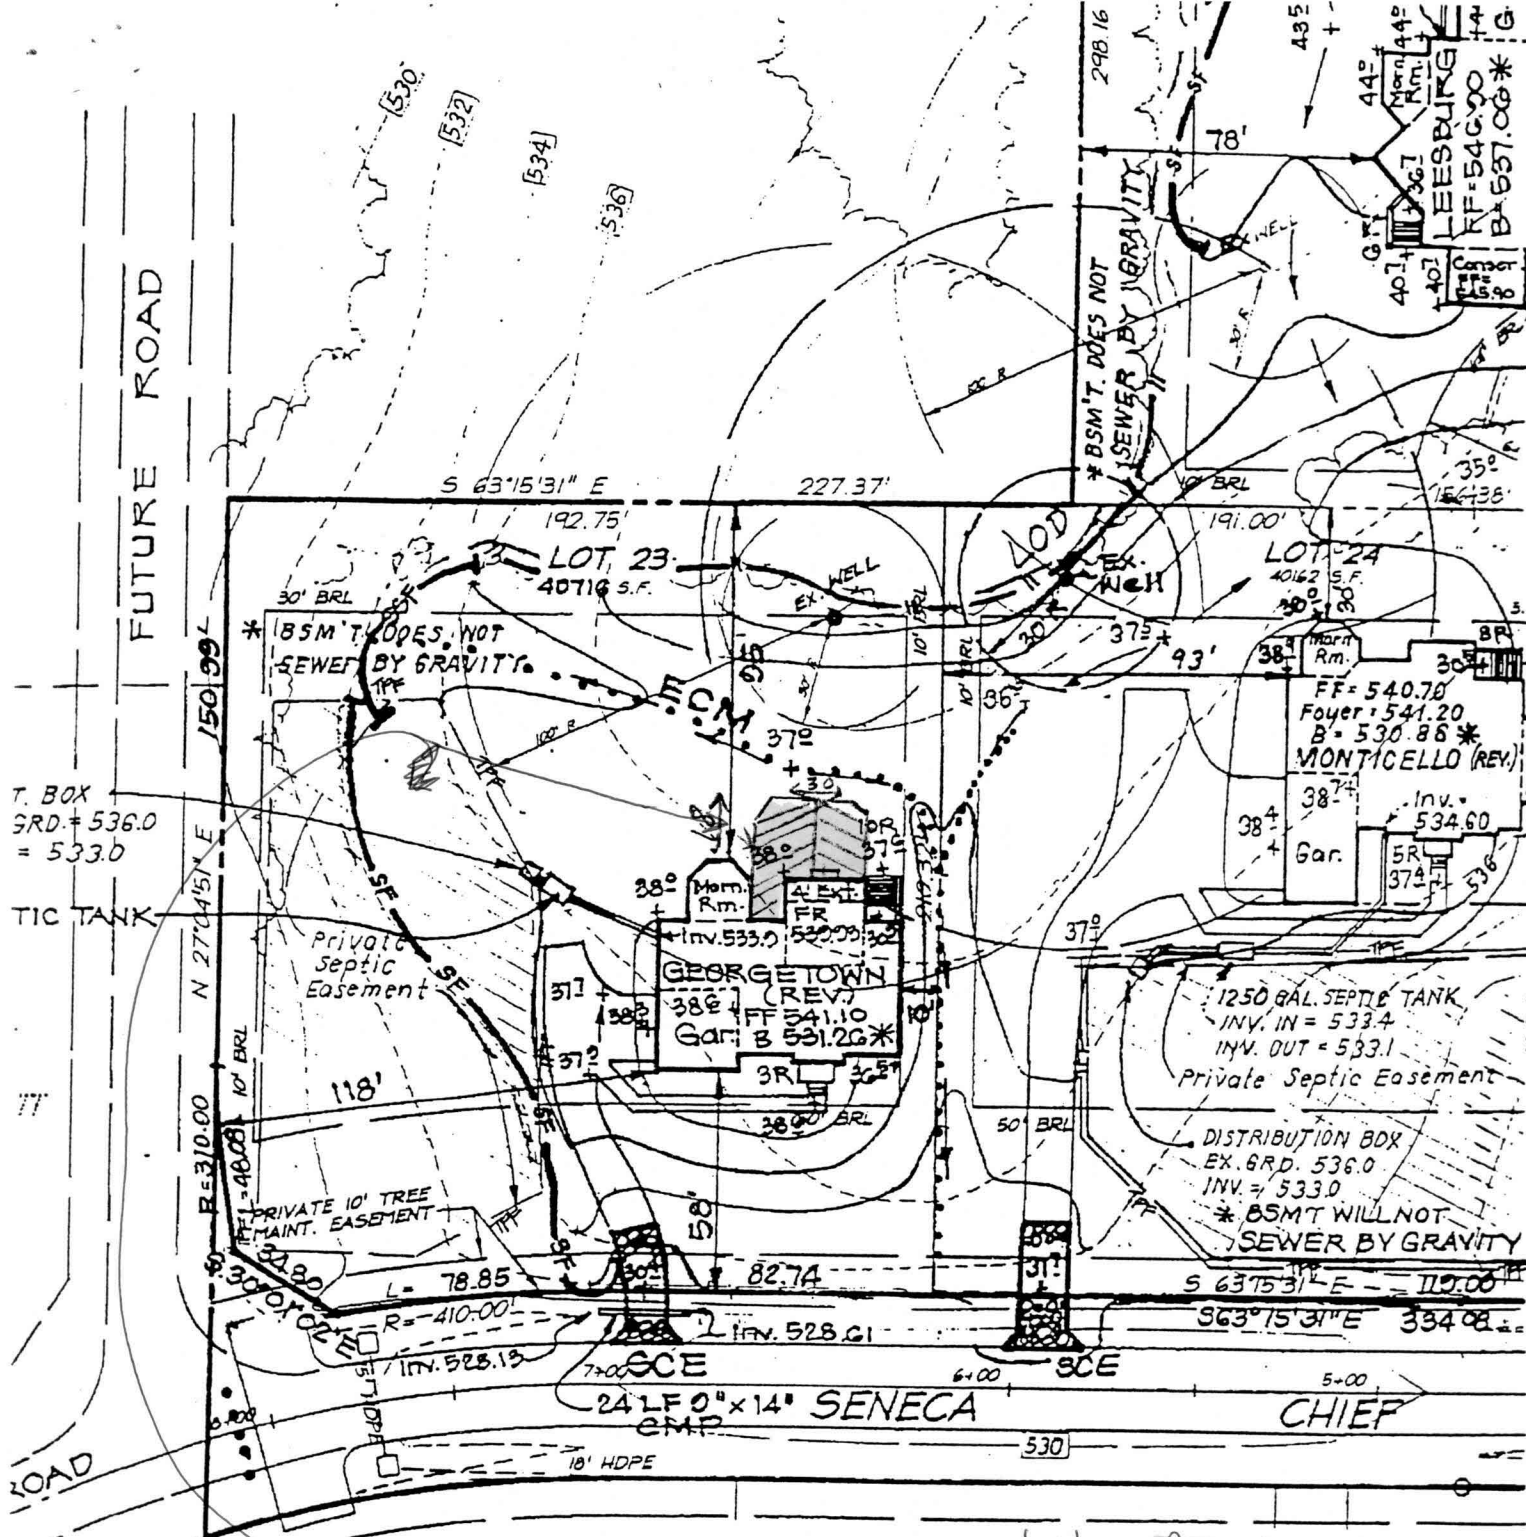

T. BOX
GRD. = 536.0
= 533.0

TIC TANK

77

ROAD

6/26/02 - Proposed
Deck on (SRU)

LOT 22

LOT 21

28-1023
NSCO
m/rm

Post-it® Fax Note	7671	Date	01-10-01	# of pages	1
To	Wayne Flack	From	Donna		
Co./Dept.	NV Homes	Co.	CF & S		
Phone #		Phone #			
Fax #		Email	Brantwood21		
			99-083		


WELL TO ALL PARTS OF THE SEPTIC SYSTEM

Total linear feet of trench required 240 feet

Width of trench(es) 30 feet

Depth of trench(es) 5.0 feet

Depth of stone required below distribution pipe 20 feet

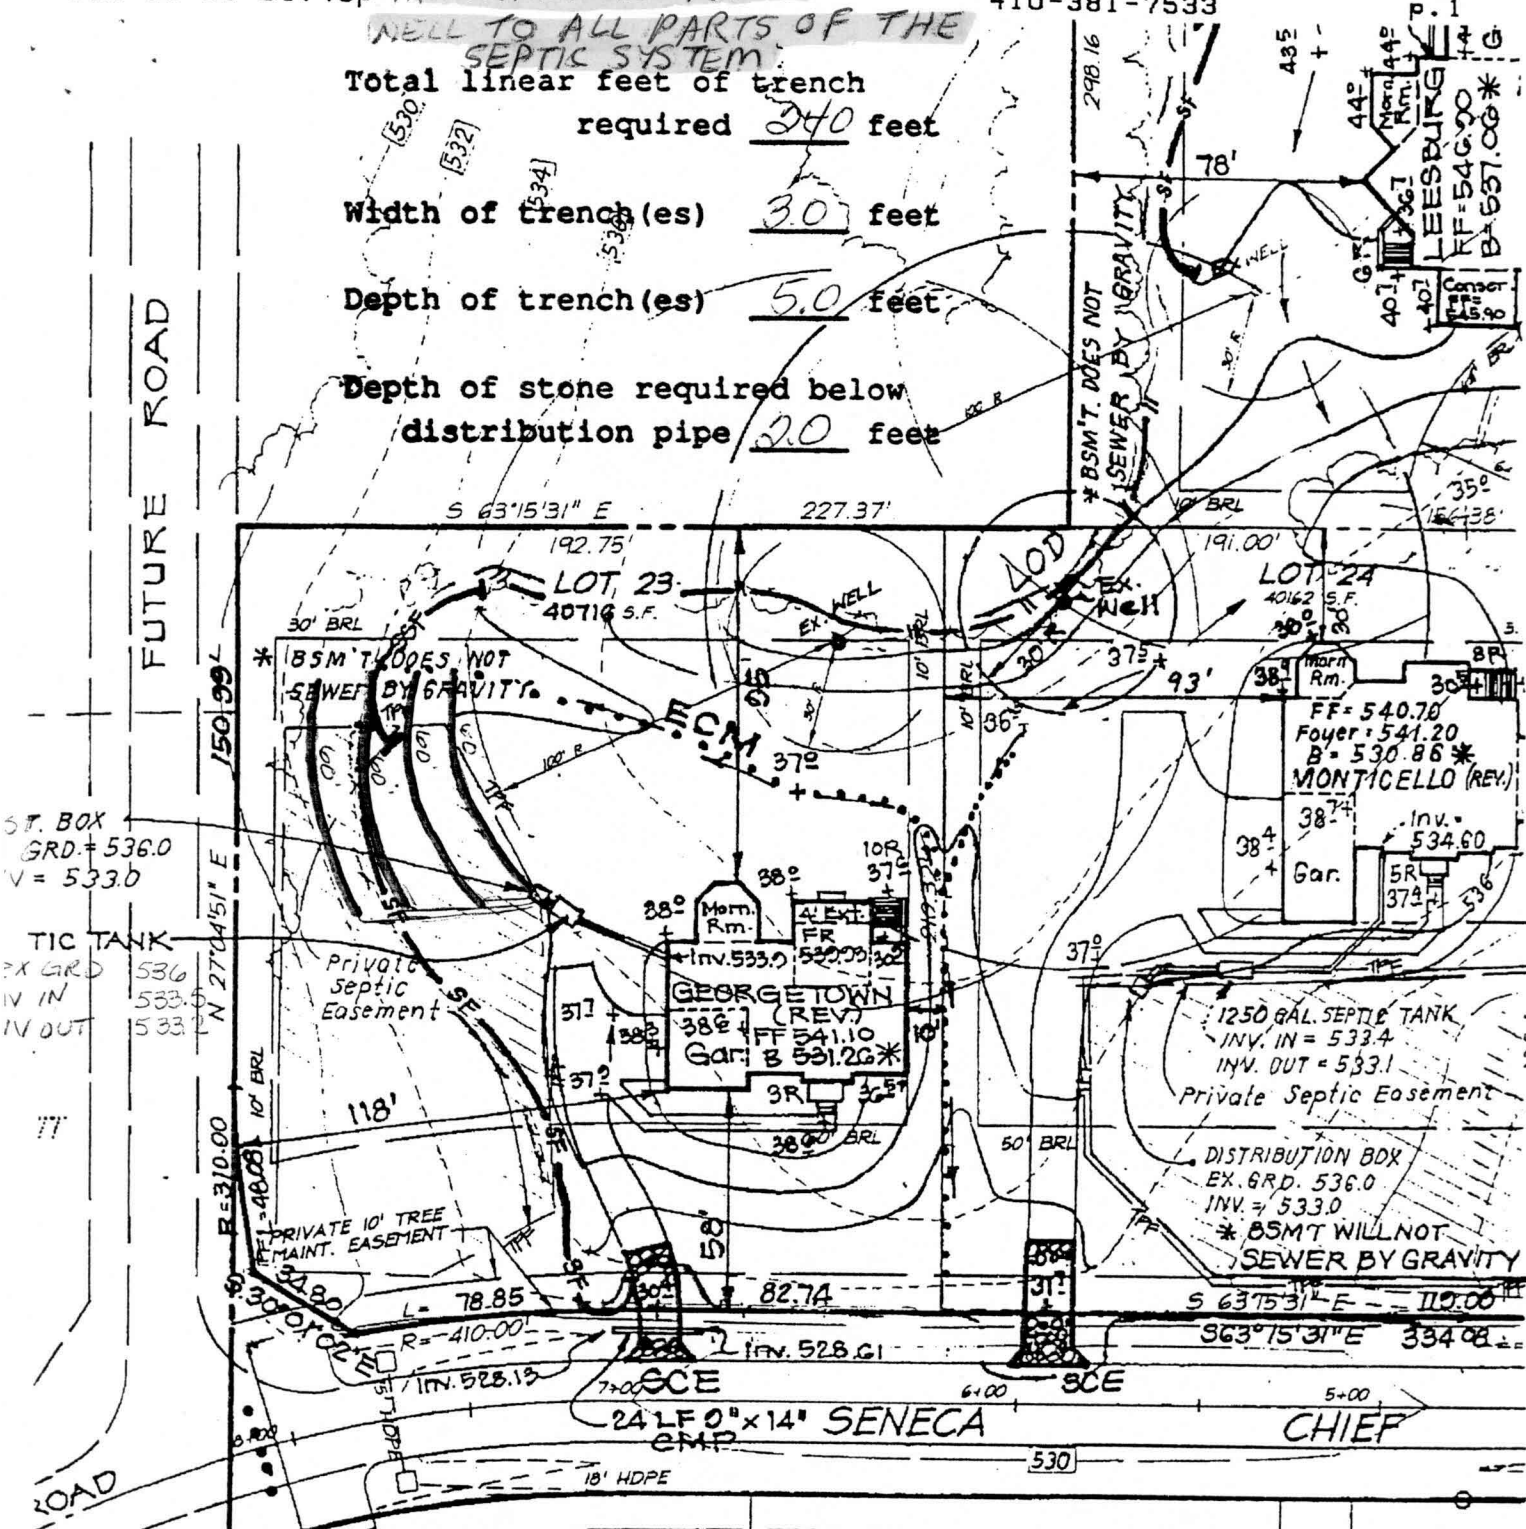

Approved Septic System Plan
Howard County Health Department

Signature *Date*

Post-it* Fax Note 7671

To Wayne Flack
Co./Dept. NV Homes
Phone #
Fax #

Date 01-10-01 # of pages 1
From Donna
Co. CF & S
Phone #
Fax # Brantwood 2/1

99-083