

5/25/01
10:10:30 - layout
5/30/01 - 11:00

PERMIT

SEWAGE DISPOSAL SYSTEM
HOWARD COUNTY HEALTH DEPARTMENT
BUREAU OF ENVIRONMENTAL HEALTH
410-313-2640

P 515024-D

A 512694-Y

ISSUE DATE 4/5/2001

APPROVAL DATE 5/31/01

INDEXED

03-332063

South Carroll Backhoe, Inc. IS PERMITTED TO INSTALL X ALTER

ADDRESS 4410 Salem Bottom Road, Westminster, MD 21157 PHONE 410-875-4197

SUBDIVISION Brantwood 2/1 LOT NUMBER 23 ADDRESS 3028 Seneca Chief Trail

PROPERTY OWNER NY Homes GEORGE KINIGOPoulos PROPERTY OWNER'S ADDRESS 2200 Defense Hwy, #301

SEPTIC TANK CAPACITY 1250 GALLONS *TOP SEAMED SEPTIC TANK REQUIRED* 21114

PUMP CHAMBER CAPACITY N/A GALLONS

NUMBER OF BEDROOMS 4

SQUARE FEET PER BEDROOM 180

MINIMUM FEET OF TRENCH REQUIRED 240

TRENCHES: Trenches to be 3 feet wide. Inlet, 3 feet below original grade. Bottom maximum depth 5 feet below original grade. 3 feet of stone below distribution box pipe

LOCATION: Begin trenches 105 feet off the front lot line and 75 feet off the left lot line as seen when facing the lot from Seneca Chief Trail. Run trenches on contour toward the rear lot line.

PLANS APPROVED Amy McMillen, R.S. OK SRU 2/14/01 DATE 2/5/2001

PERMIT VOID AFTER 2 YEARS

NOTE: CONTRACTOR RESPONSIBLE FOR SCHEDULING A PRE-CONSTRUCTION INSPECTION FOR ALL INSTALLATIONS

NOTE: TOP OF SEPTIC TANKS ARE TO BE NO DEEPER THAN 3.0 FEET BELOW FINISH GRADE

NOTE: WATERTIGHT SEPTIC TANKS REQUIRED

NOTE: CLEANOUT REQUIRED EVERY 70 FEET OF SEWER LINE AND/OR AT 90° SWEEPS IN LINES FROM HOUSE TO DRAIN FIELDS, 90° ELBOWS ARE NOT ACCEPTABLE

NOTE: ALL PARTS OF SEPTIC SYSTEMS (I.E. TANK, DISTRIBUTION BOX, DRAINFIELDS) TO BE 100 FEET FROM ANY WATER WELL UNLESS OTHERWISE SPECIFICALLY AUTHORIZED

NOTE: NO ABSORPTION TRENCH TO EXCEED 100 FEET IN LENGTH UNLESS SPECIFICALLY AUTHORIZED

NOTE: ALL PIPE FROM HOUSE TO SEPTIC TANK MUST BE CAST IRON OR SCHEDULE 35/40 PVC OR ABS

NOTE: MANHOLE RISERS REQUIRED ON ALL SEPTIC TANKS AND PUMP CHAMBERS

NOTE: DISTRIBUTION BOXES MUST HAVE BAFFLES

NOTE: IF PUMPED SEPTIC SYSTEM REQUIRED, (1) SEPTIC PUMP DETAIL TO BE PROVIDED BY INSTALLER PRIOR TO ISSUANCE OF SEPTIC PERMIT (2) PUMP PERFORMANCE TEST IS NECESSARY PRIOR TO HEALTH DEPARTMENT APPROVAL OF SEPTIC PERMIT

BUILDING PERMIT SIGNED


AND RETURNED

6/26/2002
00137138 DECK

515024-D

NEITHER THE HOWARD COUNTY COUNCIL NOR THE HEALTH DEPARTMENT IS RESPONSIBLE FOR THE SUCCESSFUL OPERATION OF ANY SYSTEM
PERMITTEE RESPONSIBLE FOR OBTAINING FINAL APPROVAL ON THIS PERMIT
CALL 410-313-2640 FOR INSPECTION OF SEPTIC SYSTEM

NOT TO SCALE

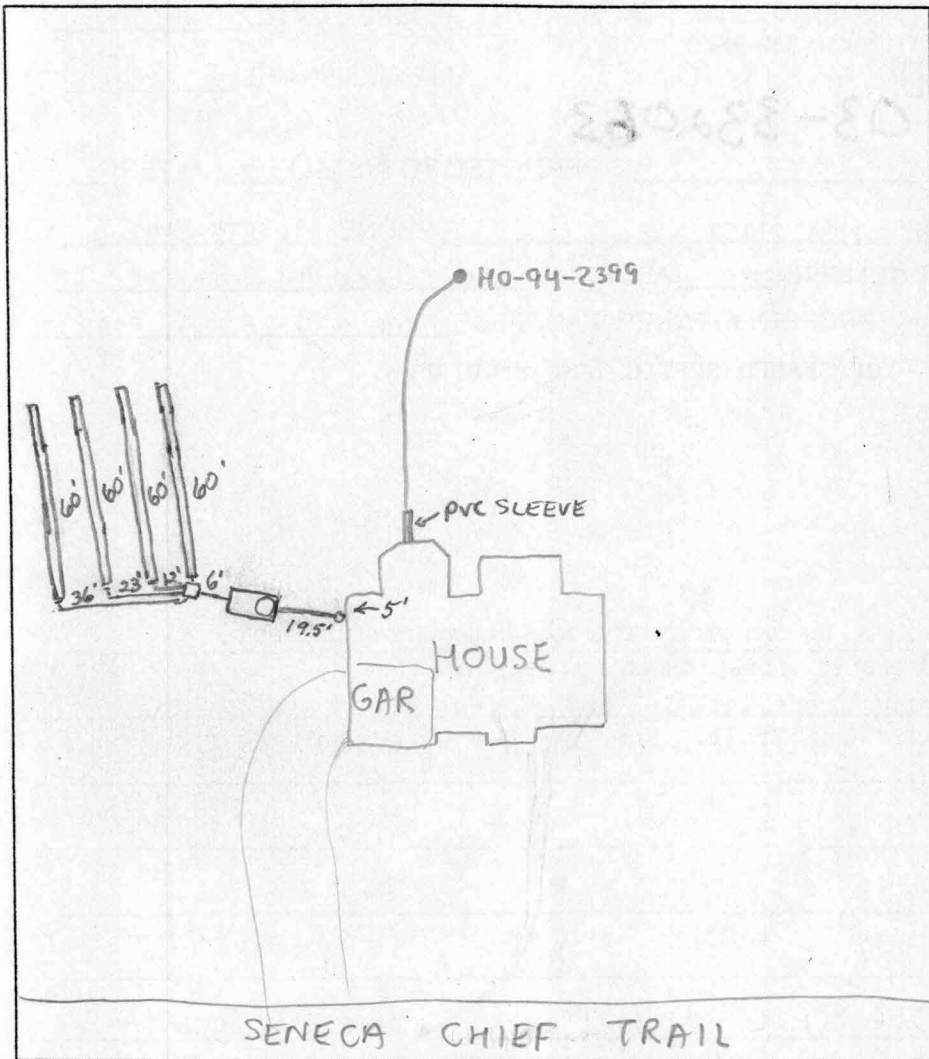

TRENCH DATA

TRENCH WIDTH 3'

TRENCH INLET DEPTH 3'

TRENCH BOTTOM DEPTH 5'

DEPTH OF STONE 2'

NUMBER OF TRENCHES 4

TOTAL TRENCH LENGTH 240'

ABSORBENT AREA 720 sq. ft.

DISTRIBUTION BOX LEVEL Yes

BAFFLE IN DISTRIBUTION BOX Yes

SEPTIC TANK DATA

SEPTIC TANK 1500 TS GALLONS

MANHOLE RISER Yes

6 INCH INSPECTION PORT No

PUMP CHAMBER DATA

PUMP CHAMBER GALLONS NA

MANHOLE RISER NA

ALARM NA

PUMP PERFORMANCE TEST NA

PRE-CONSTRUCTION INSPECTION: 5/25/01 - AREA STAKED, INSTALL PER BP PLAN (4-60' TRENCHES)

CONTRACTOR TO ENSURE 100' IS MAINTAINED TO WELL FROM SEPTIC SYSTEM - (SRK)

INSPECTION COMMENTS: 5/30/01 Tank set. BB 5/31/01 System satisfactory. O.K. to cover. BB

BUILDING PERMIT
AND RETURNED

INSPECTOR B. Baker DATE SYSTEM APPROVED 5/31/01