

APPLICATION

PERCOLATION TESTING

A _____

P _____

HOWARD COUNTY HEALTH DEPARTMENT

BUREAU OF ENVIRONMENTAL HEALTH

3525-H ELLICOTT MILLS DRIVE/ELLICOTT CITY, MARYLAND 21043
TELEPHONE: 313-2840

DISTRICT _____

DATE 8/15/95

TO: THE COUNTY HEALTH OFFICER
ELLICOTT CITY, MARYLAND

I HEREBY APPLY FOR THE NECESSARY TEST PRIOR TO APPLICATION FOR PERMIT TO CONSTRUCT (OR RECONSTRUCT) A SEWAGE DISPOSAL SYSTEM.

PROPERTY OWNER Fearge Family

ADDRESS _____ PHONE _____

AGENT OR PROSPECTIVE BUYER Land Marketing, Inc. C/O Tim Fearge

ADDRESS 3243 Bethany Lane Ellicott City PHONE 313-8808
21042

PROPERTY LOCATION:

SUBDIVISION Fearge Property LOT NO. 74-78 77

ROAD AND DESCRIPTION Rt 144 + Folly Quarter Rd

TAX MAP 16 + 23 PARCEL # 34 + 63

SIZE OF LOT 1 acre +/- TYPE BLDG. SFD
(SINGLE FAMILY DWELLING OR COMMERCIAL)

THE SYSTEM INSTALLED UNDER THIS APPLICATION IS ACCEPTABLE ONLY UNTIL PUBLIC FACILITIES BECOME AVAILABLE. I FULLY UNDERSTAND THE FEE CONNECTED WITH THE FILING OF THIS PERC TEST APPLICATION IS NON-REFUNDABLE UNDER ANY CIRCUMSTANCES. I ALSO AGREE TO COMPLY WITH ALL M.O.S.H.A. REQUIREMENTS IN TESTING THIS LOT.

Myal A Reil
(SIGNATURE OF APPLICANT)

APPROVED BY _____ FOR _____ DATE _____

DISAPPROVED BY _____ FOR _____ DATE _____

HOLD PENDING FURTHER TESTS _____

REASONS FOR REJECTION OR HOLDING _____

PERCOLATION TEST PLAT/PRELIMINARY PLAT - TITLE OR I.D. # _____ DATE _____


SITE DEVELOPMENT PLAN/FINAL PLAT - TITLE OR I.D. # _____ DATE _____

THIS IS NOT A PERMIT

0' 1234
reddish
brn
clum
3' Lt red
micaceous
Salm
wt 5-10%
rock
fragments
pockets
of white
decayed
quartzite

1033
1' 1/2' 1/4' 1/8' 1/16' 1/32' 1/64' 1/128' 1/256' 1/512' 1/1024' 1/2048' 1/4096' 1/8192' 1/16384' 1/32768' 1/65536' 1/131072' 1/262144' 1/524288' 1/1048576' 1/2097152' 1/4194304' 1/8388608' 1/16777216' 1/33554432' 1/67108864' 1/134217728' 1/268435456' 1/536870912' 1/1073741824' 1/2147483648' 1/4294967296' 1/8589934592' 1/17179869184' 1/34359738368' 1/68719476736' 1/137438953472' 1/274877906944' 1/549755813888' 1/1099511627776' 1/2199023255552' 1/4398046511104' 1/8796093022208' 1/17592186044416' 1/35184372088832' 1/70368744177664' 1/140737488355328' 1/281474976710656' 1/562949953421312' 1/1125899906842624' 1/2251799813685248' 1/4503599627370496' 1/9007199254740992' 1/18014398509481984' 1/36028797018963968' 1/72057594037927936' 1/144115188075855872' 1/288230376151711744' 1/576460752303423488' 1/1152921504606846976' 1/2305843009213693952' 1/4611686018427387904' 1/9223372036854775808' 1/18446744073709551616' 1/36893488147419103232' 1/73786976294838206464' 1/147573952589676412928' 1/295147905179352825856' 1/590295810358705651712' 1/1180591620717411303424' 1/2361183241434822606848' 1/4722366482869645213696' 1/9444732965739290427392' 1/18889465931478580854784' 1/37778931862957161709568' 1/75557863725914323419136' 1/151115727451828646838272' 1/302231454903657293676544' 1/604462909807314587353088' 1/1208925819614629174706176' 1/2417851639229258349412352' 1/4835703278458516698824704' 1/9671406556917033397649408' 1/19342813113834066795298816' 1/38685626227668133590597632' 1/77371252455336267181195264' 1/154742504910672534362390528' 1/309485009821345068724781056' 1/618970019642690137449562112' 1/1237940039285380274899124224' 1/2475880078570760549798248448' 1/4951760157141521099596496896' 1/9903520314283042199192993792' 1/19807040628566084398385987584' 1/39614081257132168796771975168' 1/79228162514264337593543950336' 1/158456325028528675187087900672' 1/316912650057057350374175801344' 1/633825300114114700748351602688' 1/1267650600228229401496703205376' 1/2535301200456458802993406410752' 1/5070602400912917605986812821504' 1/10141204801825835211973625643008' 1/20282409603651670423947251286016' 1/40564819207303340847894502572032' 1/81129638414606681695789005144064' 1/162259276829213363391578010288128' 1/324518553658426726783156020576256' 1/649037107316853453566312041152512' 1/1298074214633706907132624082305024' 1/2596148429267413814265248164610048' 1/5192296858534827628530496329220096' 1/10384593717069655257060992658440192' 1/20769187434139310514121985316880384' 1/41538374868278621028243970633760768' 1/83076749736557242056487941267521536' 1/166153499473114484112975882535043072' 1/332306998946228968225951765070086144' 1/664613997892457936451903530140172288' 1/1329227995784915872903807060280344576' 1/2658455991569831745807614120560689152' 1/5316911983139663491615228241121378304' 1/10633823966279326983230456482242756608' 1/21267647932558653966460912964485513216' 1/42535295865117307932921825928971026432' 1/85070591730234615865843651857942052864' 1/170141183460469231731687303715884105728' 1/340282366920938463463374607431768211456' 1/680564733841876926926749214863536422912' 1/1361129467683753853853498429727072845824' 1/2722258935367507707706996859454145691648' 1/5444517870735015415413993718908291383296' 1/10889035741470030830827987437816582766592' 1/21778071482940061661655974875633165533184' 1/43556142965880123323311949751266331066368' 1/87112285931760246646623899502532662132736' 1/174224571863520493293247799005065324265472' 1/348449143727040986586495598010130648530944' 1/696898287454081973172991196020261297061888' 1/1393796574908163946345982392040522594123776' 1/2787593149816327892691964784081045188247552' 1/5575186299632655785383929568162090376495104' 1/11150372599265311570767859136324180752990208' 1/22300745198530623141535718272648361505980416' 1/44601490397061246283071436545296723011960832' 1/89202980794122492566142873090593446023921664' 1/178405961588244985132285746181186892047843328' 1/356811923176489970264571492362373784095686656' 1/713623846352979940529142984724747568191373312' 1/1427247692705959881058285969449495136382746624'

1235
orange
brown
clm
4' medium
brown
Salmon
with
Pockets
of white
decayed
quartz
tion
8'-10'

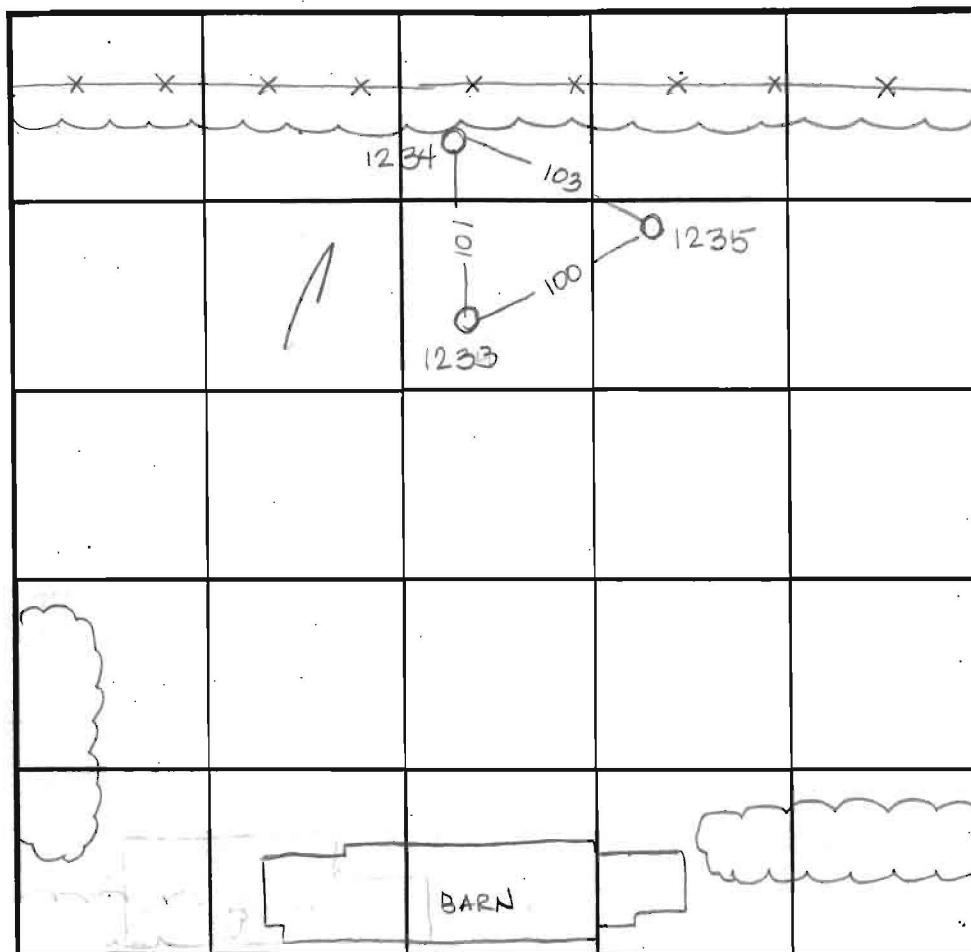[illegible]

REMARKS _____

TYPE OF SOIL _____

TESTED BY Amy McMillen ALSO PRESENT Tim Feaga

TRENCH DESIGN DATA: AVERAGE PERCOLATION TIME _____ TRENCH WIDTH _____


INLET DEPTH _____ MAXIMUM BOTTOM DEPTH _____ SQ. FT./BEDROOM _____

INLET DEPTH

MAXIMUM BOTTOM DEPTH

SO FT/BEDROOM

Approved
Per Cert
143.987

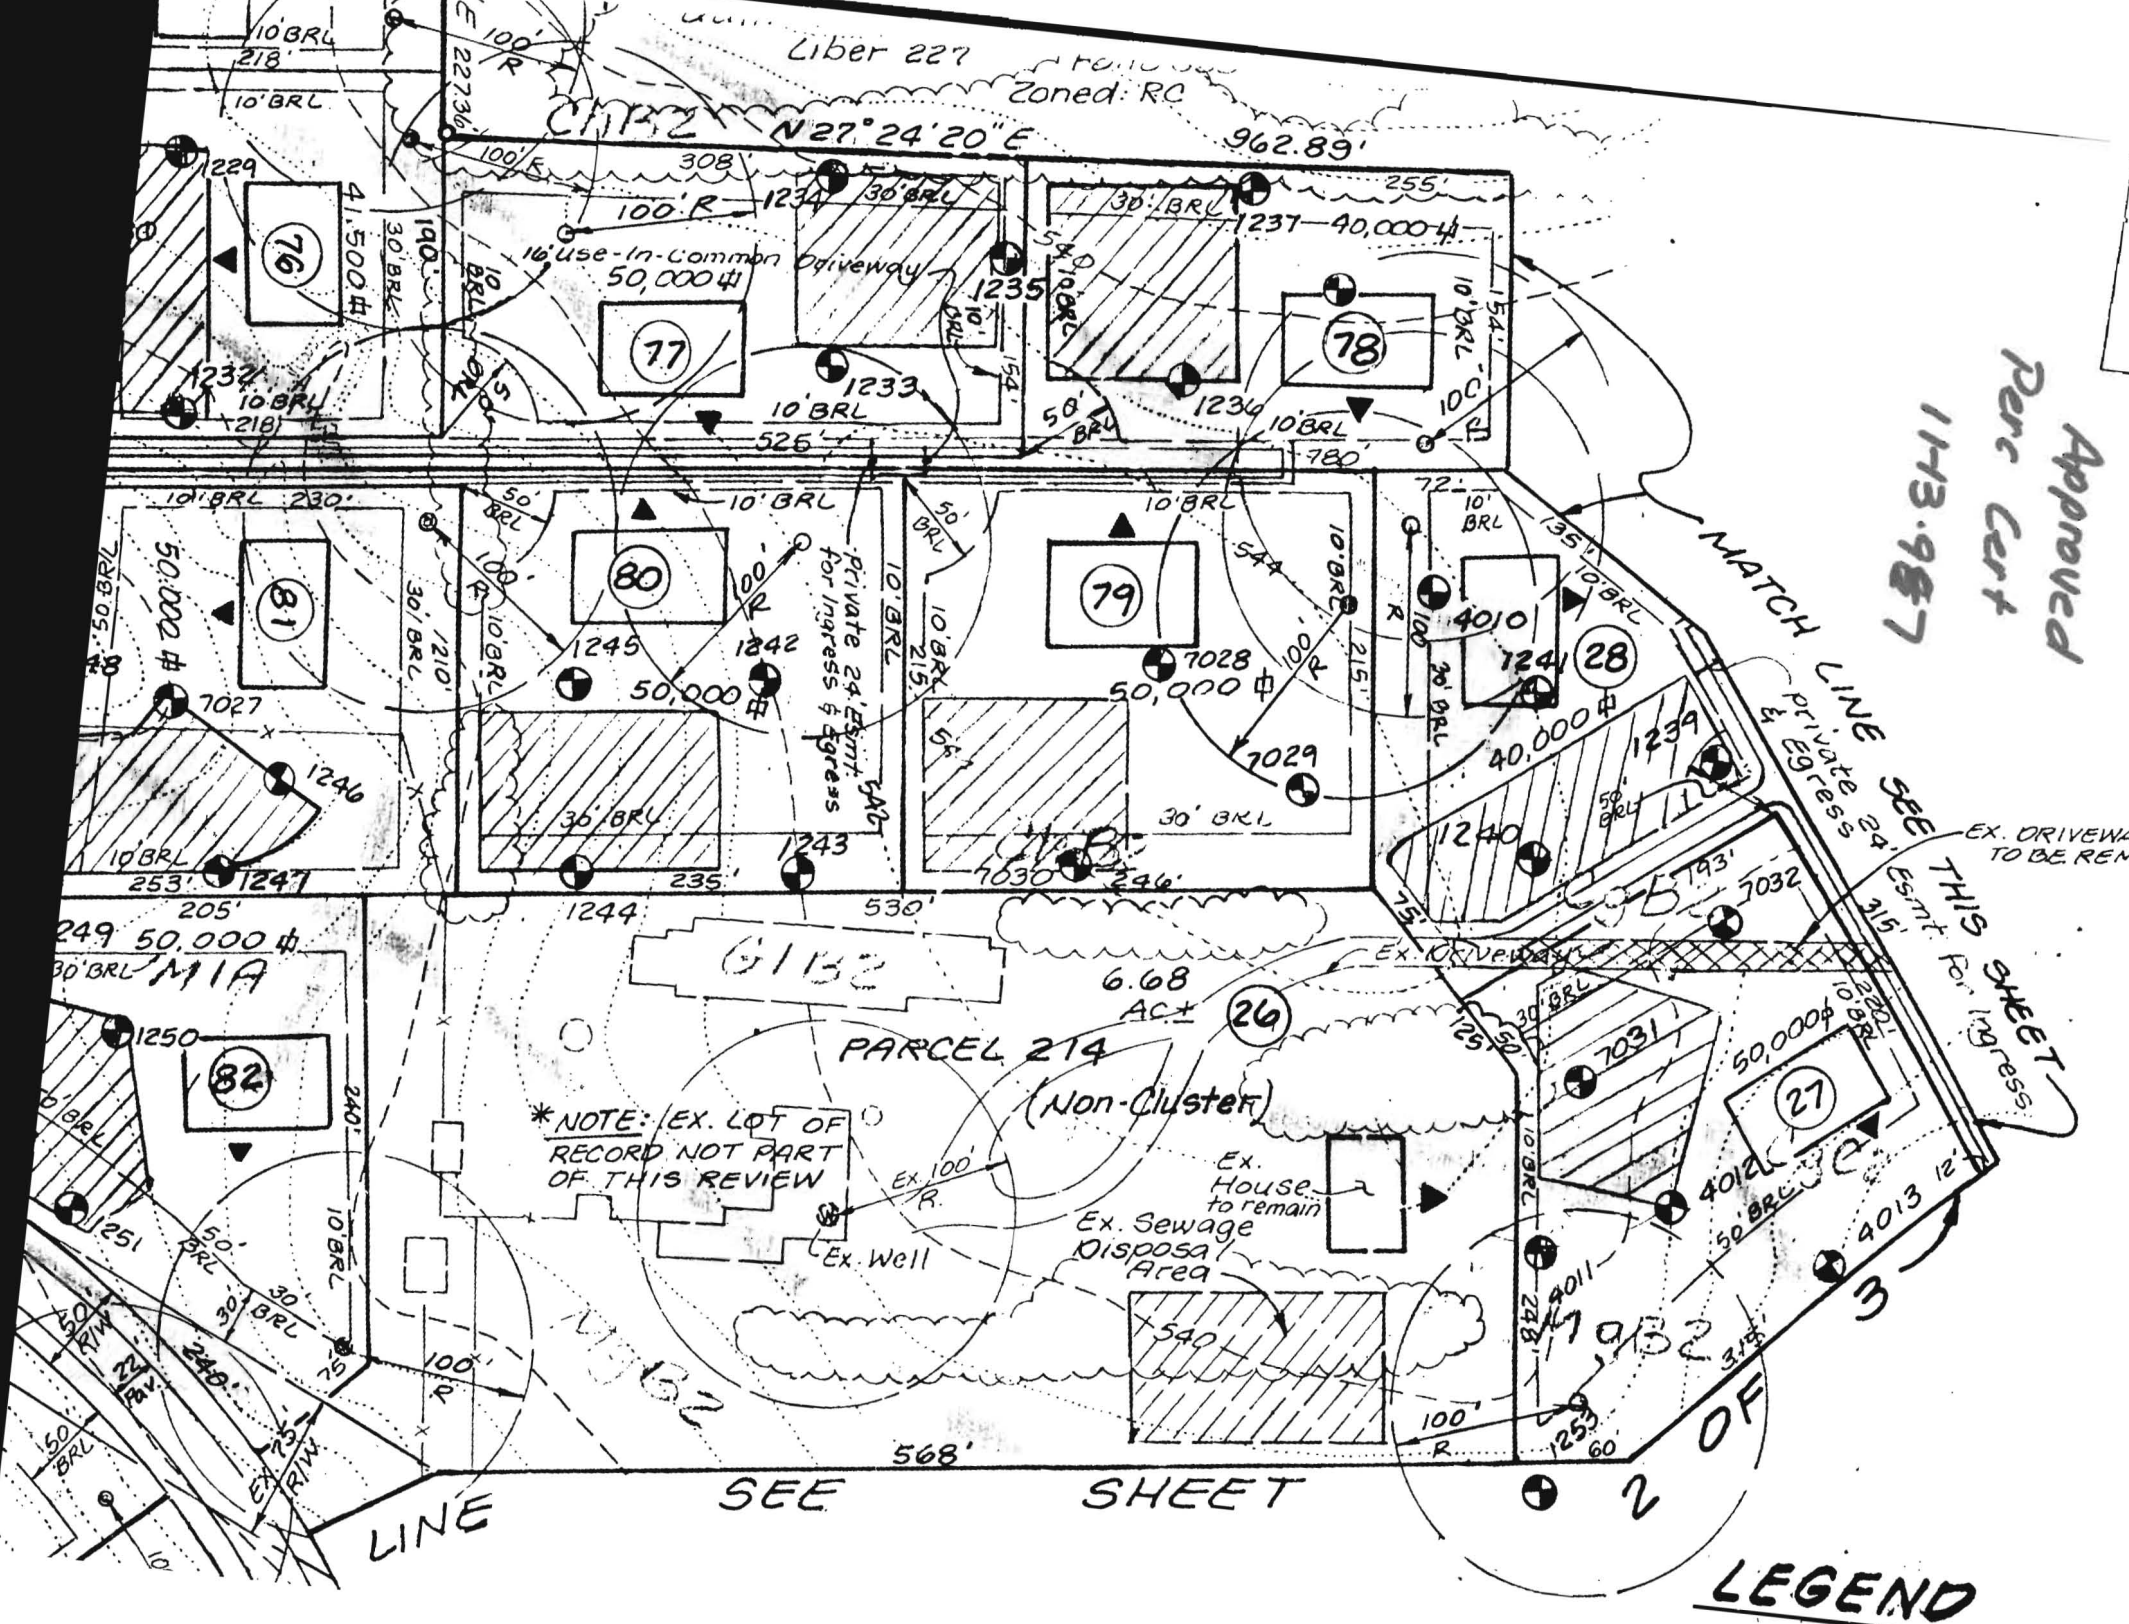

LEGEND

[illegible]

Developer reserves unto it easements shown on this plat for stormwater management facilities located in, on, over, and under Parcels "E" & "F". Any and all easements shall be subjected to the terms and conditions expressly stated in the deed. The deed(s) shall execute and deliver to the appropriate authority for the easement. The deed(s) of easement and the plat shall be recorded in the Land Records Office of the Planning and Zoning Department.

Rudolph S
ET.AL.
162 / A
Zoned: P

Env
£ S
Non
25'
75'
100

Note
for i
(F98
and
(Plat

