

8/22/01
WPT Septic
9/17/01 - 10:30
9/18/01 - 2:00

ISSUE DATE: 8/2/2001

APPROVAL DATE: 11/28/01

PERMIT
INDEXED

P 515771-A

A 512694-AA

ON-SITE SEWAGE DISPOSAL SYSTEM
HOWARD COUNTY HEALTH DEPARTMENT
BUREAU OF ENVIRONMENTAL HEALTH

03 - 332160

South Carroll Backhoe, Inc IS PERMITTED TO INSTALL ☒ ALTER ☐

ADDRESS: 4410 Salem Bottom Road PHONE NUMBER: 410-875-4197

SUBDIVISION: Brantwood 2/1 LOT NUMBER: 25

ADDRESS: 3020 Seneca Chief Trail PROPERTY OWNER: NVHomes

SEPTIC TANK CAPACITY (GALLONS): 1250 (TOPSEAM)

PUMP CHAMBER CAPACITY (GALLONS): N/A

NUMBER OF BEDROOMS: 4

SQUARE FEET PER BEDROOM: 180

LINEAR FEET OF TRENCH REQUIRED: 240

TRENCHES:	Trench to be 3.0 feet wide. Inlet 2.5 feet below original grade. Bottom maximum depth 4.0 feet below original grade. Effective area begins at 2.5 feet below original grade. 1.5 feet of stone below distribution pipe.
LOCATION:	Begin trenches 55 feet off the front lot line and 60 feet off the right lot line as seen when facing the lot from the use-in-common driveway. Run trenches on contour in both directions.
NOTES:	

PLANS APPROVED: Amy Mc Millen OK SRK 6/28/01 DATE: 6-27-01

NOTE: PERMIT VOID AFTER 2 YEARS

NOTE: CONTRACTOR RESPONSIBLE FOR SCHEDULING A PRE-CONSTRUCTION INSPECTION FOR ALL INSTALLATIONS

NOTE: WATERTIGHT SEPTIC TANKS REQUIRED

NOTE: ALL PARTS OF SEPTIC SYSTEM SHALL BE 100 FEET FROM ANY WATER WELL


NOTE: MANHOLE RISERS REQUIRED ON ALL SEPTIC TANKS AND PUMP CHAMBERS

**NEITHER THE HOWARD COUNTY COUNCIL NOR THE HEALTH DEPARTMENT IS
RESPONSIBLE FOR THE SUCCESSFUL OPERATION OF ANY SYSTEM
PERMITTEE RESPONSIBLE FOR OBTAINING FINAL APPROVAL ON THIS PERMIT
CALL 410-313-2640 FOR INSPECTION OF SEPTIC SYSTEM**

ALL PERMITS 3-27-01
B00135102-DECK
8-21-03 B00143098-HOT TUB

P 515971-A

27.5
15.5
41

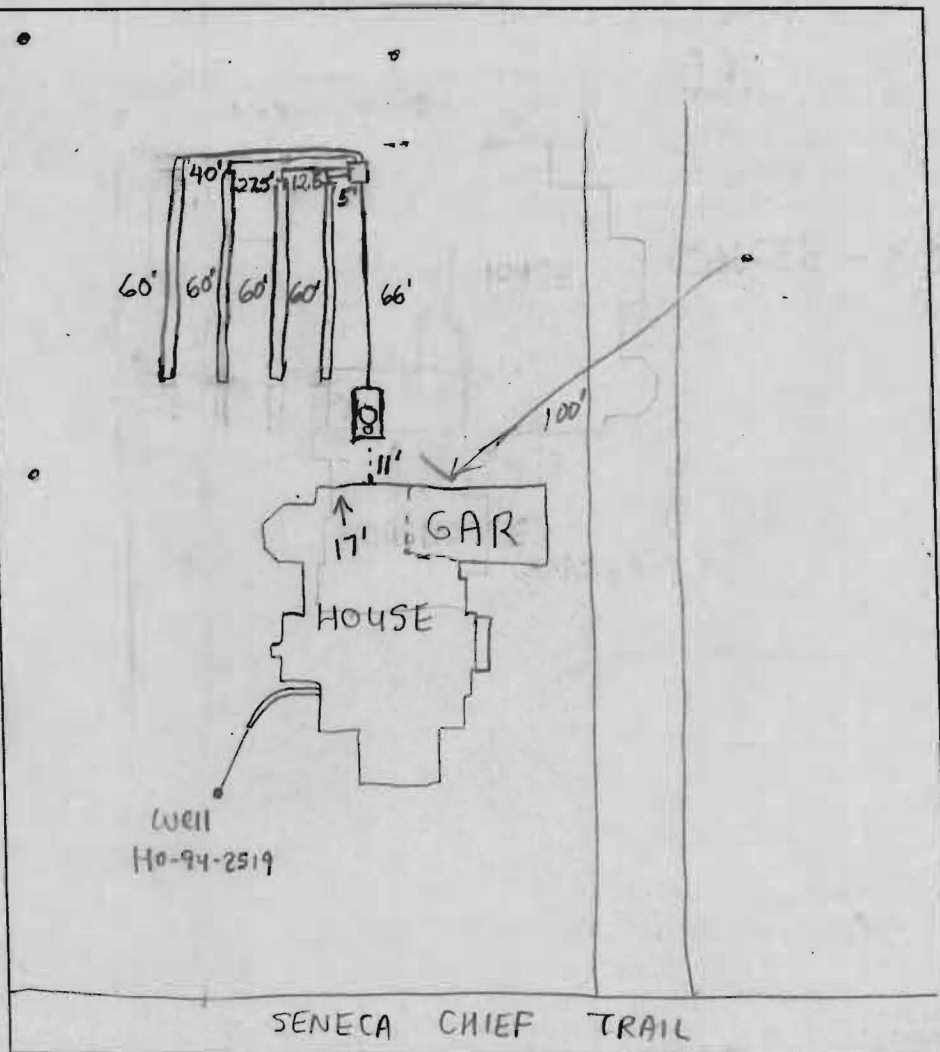

TRENCH DATA

TRENCH WIDTH 3'
TRENCH INLET DEPTH 2.5'
TRENCH BOTTOM DEPTH 4.0'
DEPTH OF STONE 1.5'
NUMBER OF TRENCHES 4
TOTAL TRENCH LENGTH 240'
ABSORBENT AREA 720 sq. ft.
DISTRIBUTION BOX LEVEL Yes
BAFFLE IN DISTRIBUTION BOX Yes

SEPTIC TANK DATA

SEPTIC TANK 1250 TS GALLONS
MANHOLE RISER Yes
6 INCH INSPECTION PORT Yes

PUMP CHAMBER DATA N/A

~~PUMP CHAMBER
GALLONS _____~~

~~MANHOLE RISER _____~~

~~ALARM _____~~

~~PUMP PERFORMANCE TEST _____~~

PRE-CONSTRUCTION INSPECTION: 9/17/01 OK TO START - TANK 10' OFF HOUSE; RUN

(4) 60' TRENCHES TOWARD HOUSE W/D.B. IN MIDDLE (MR)

INSPECTION COMMENTS: 9/18/01 Need house connection. O.K. to cover everything.

BB 11/28/01 - BUILDER VERIFIED HOUSE CONN. HAS BEEN MADE (OVER PHONE) (SRV)

INSPECTOR

Steven R. Krieg

DATE SYSTEM APPROVED _____

11/28/01