

HOWARD COUNTY
PERMIT APPLICATION

PERMIT NUMBER

1300127343

Building Address 3700 Sharp Road
Glenwood, MD 21738
Suite/Apt. #: _____ SDP/WP/Petition #: _____
Census Tract 6051.01 Subdivision Nicholas Sharp Property
Section — Area — Lot 3
Tax Map 21 Parcel 200 Grid 11
Zoning RR Map Coordinates 9D9 Lot size 3.657

Existing Use Undeveloped
Proposed Use Residential
Estimated Construction Cost \$ 295,000
Description of Work New single family
home 4 bedroom, 4 bath, unfinished
basement w/ bath R.I., attached 3 car garage

Occupant or Tenant Owner
Contact Name N/A
Address _____
City _____ State _____ Zip Code _____
Phone _____ Fax _____

Property Owner's Name Guy W. Silas
Address 3753 Ivory Road
City Glenely State MD Zip Code 21737
Home Phone 410-442-0073 Work Phone 301-622-1841
Applicant's Name & Mailing Address, (if other than stated hereon): _____

Phone _____ Fax 301-625-7640

Contractor Company TO BE DECIDED
Contact Person _____
Address _____
City _____ State _____ Zip Code _____
License No. _____
Phone _____ Fax _____

Engineer or Architect Company Aija Schmidt Architects
Contact Person Aija Schmidt
Address 2739 Thornbrook Road
City Ellicott City State MD Zip Code 21042
Phone 410-461-3462 Fax _____

BUILDING DESCRIPTION - COMMERCIAL

Building Characteristics	Utilities
Height: _____	Water Supply: _____ Public _____ Private _____
No. of stories: _____	Sewage Disposal: _____ Public _____ Private _____
Gross area, sq. ft. per floor: _____	Electric Yes ☐ No ☐ Gas Yes ☐ No ☐
Use group: _____	Heating System: _____ Electric ☐ Oil ☐ Natural Gas ☐ Propane Gas ☐
Construction type: _____ Reinforced Concrete _____ Structural Steel _____ Masonry _____ Wood Frame _____ State Certified Modular _____	Sprinkler system: <u>N/A</u> ☐ Full _____ Partial _____ Other Suppression _____ # of Heads _____

BUILDING DESCRIPTION - RESIDENTIAL

Building Characteristics	Utilities
SF Dwelling ☒ SF Townhouse ☐ Depth _____ Width _____ 1st floor: <u>77</u> <u>58</u> 2nd floor: <u>41</u> <u>50</u> Basement: <u>77</u> <u>58</u> Finished Basement ☐ Unfinished Basement ☒ Crawl space ☐ Slab on Grade ☐ No. of Bedrooms <u>4</u> Multi-family dwellings: No. of efficiency units: _____ No. of 1 BR units: _____ No. of 2 BR units: _____ No. of 3 BR units: _____ Other Structure: _____ Dimensions: _____ Footings: _____ Roof: _____ State Certified Modular _____ Manufactured Home _____	Water Supply: _____ Public _____ Private ☒ Sewage Disposal: _____ Public _____ Private ☒ Electric Yes ☒ No ☐ Gas Yes ☐ No ☒ Heating System: _____ Electric ☐ Oil ☐ Natural Gas ☐ Propane Gas ☒ Sprinkler system: <u>N/A</u> ☒ NFPA #13D _____ NFPA #13R _____ Other: _____

THE UNDERSIGNED HEREBY CERTIFIES AND AGREES AS FOLLOWS: (1) THAT HE/SHE IS AUTHORIZED TO MAKE THIS APPLICATION; (2) THAT THE INFORMATION IS CORRECT; (3) THAT HE/SHE WILL COMPLY WITH ALL REGULATIONS OF HOWARD COUNTY WHICH ARE APPLICABLE THERETO; (4) THAT HE/SHE WILL PERFORM NO WORK ON THE ABOVE REFERENCED PROPERTY NOT SPECIFICALLY DESCRIBED IN THIS APPLICATION; (5) THAT HE/SHE GRANTS COUNTY OFFICIALS THE RIGHT TO ENTER ONTO THIS PROPERTY FOR THE PURPOSE OF INSPECTING THE WORK PERMITTED AND POSTING NOTICES.

Applicant's Signature Guy W. Silas
Owner

Print Name Guy W. Silas
Date 11/8/00

Title/Company _____

Date _____

Checks payable to: DIRECTOR OF FINANCE OF HOWARD COUNTY

** PLEASE WRITE NEATLY AND LEGIBLY **

- FOR OFFICE USE ONLY -

AGENCY	DATE	SIGNATURE APPROVAL
☒ Land Development DPZ		
☒ State Highways		
☒ Building Official		
☒ Dev. Engineering DPZ		
☒ Health	<u>11/16/00</u>	<u>J. M. M. Oles</u>
☒ Fire Protection		
☒ Is Sediment Control approval required prior to issuance? YES ☒ NO ☐		

CONTINGENCY CONSTRUCTION START: ☐
ONE STOP SHOP: ☐

DPZ SETBACK INFORMATION
Front: _____
Rear: _____
Side: _____
Side St.: _____
All minimum setbacks met? YES ☐ NO ☐
Is Entrance Permit required? YES ☐ NO ☐
Historic District? YES ☐ NO ☐
Lot Coverage for New Town Zone _____
SDP/Red-line approval date _____

PROPERTY ID#:	48659
Filing fee	\$ <u>25</u>
Permit fee	\$ _____
Excise tax	\$ _____
Sub-total paid	\$ _____
Add'l permit fee	\$ _____
TOTAL FEES	\$ _____
Balance due	\$ _____
Check	# <u>2646</u>
Validation	# <u>31294</u>

Accepted by DJ

Distribution of Copies-

White: Building Official

Green: LDD, DPZ

Yellow: DED, DPZ

Pink: Health

Gold: SHA

Total linear feet of trench required 180 feet


Width of trench(es) 2.0 feet

Depth of trench(es) 8.0 feet

Depth of stone required below distribution pipe 4.0 feet

Approved Septic System Plan
Howard County Health Department

Amy McNeil 11/17/00
Signature Date

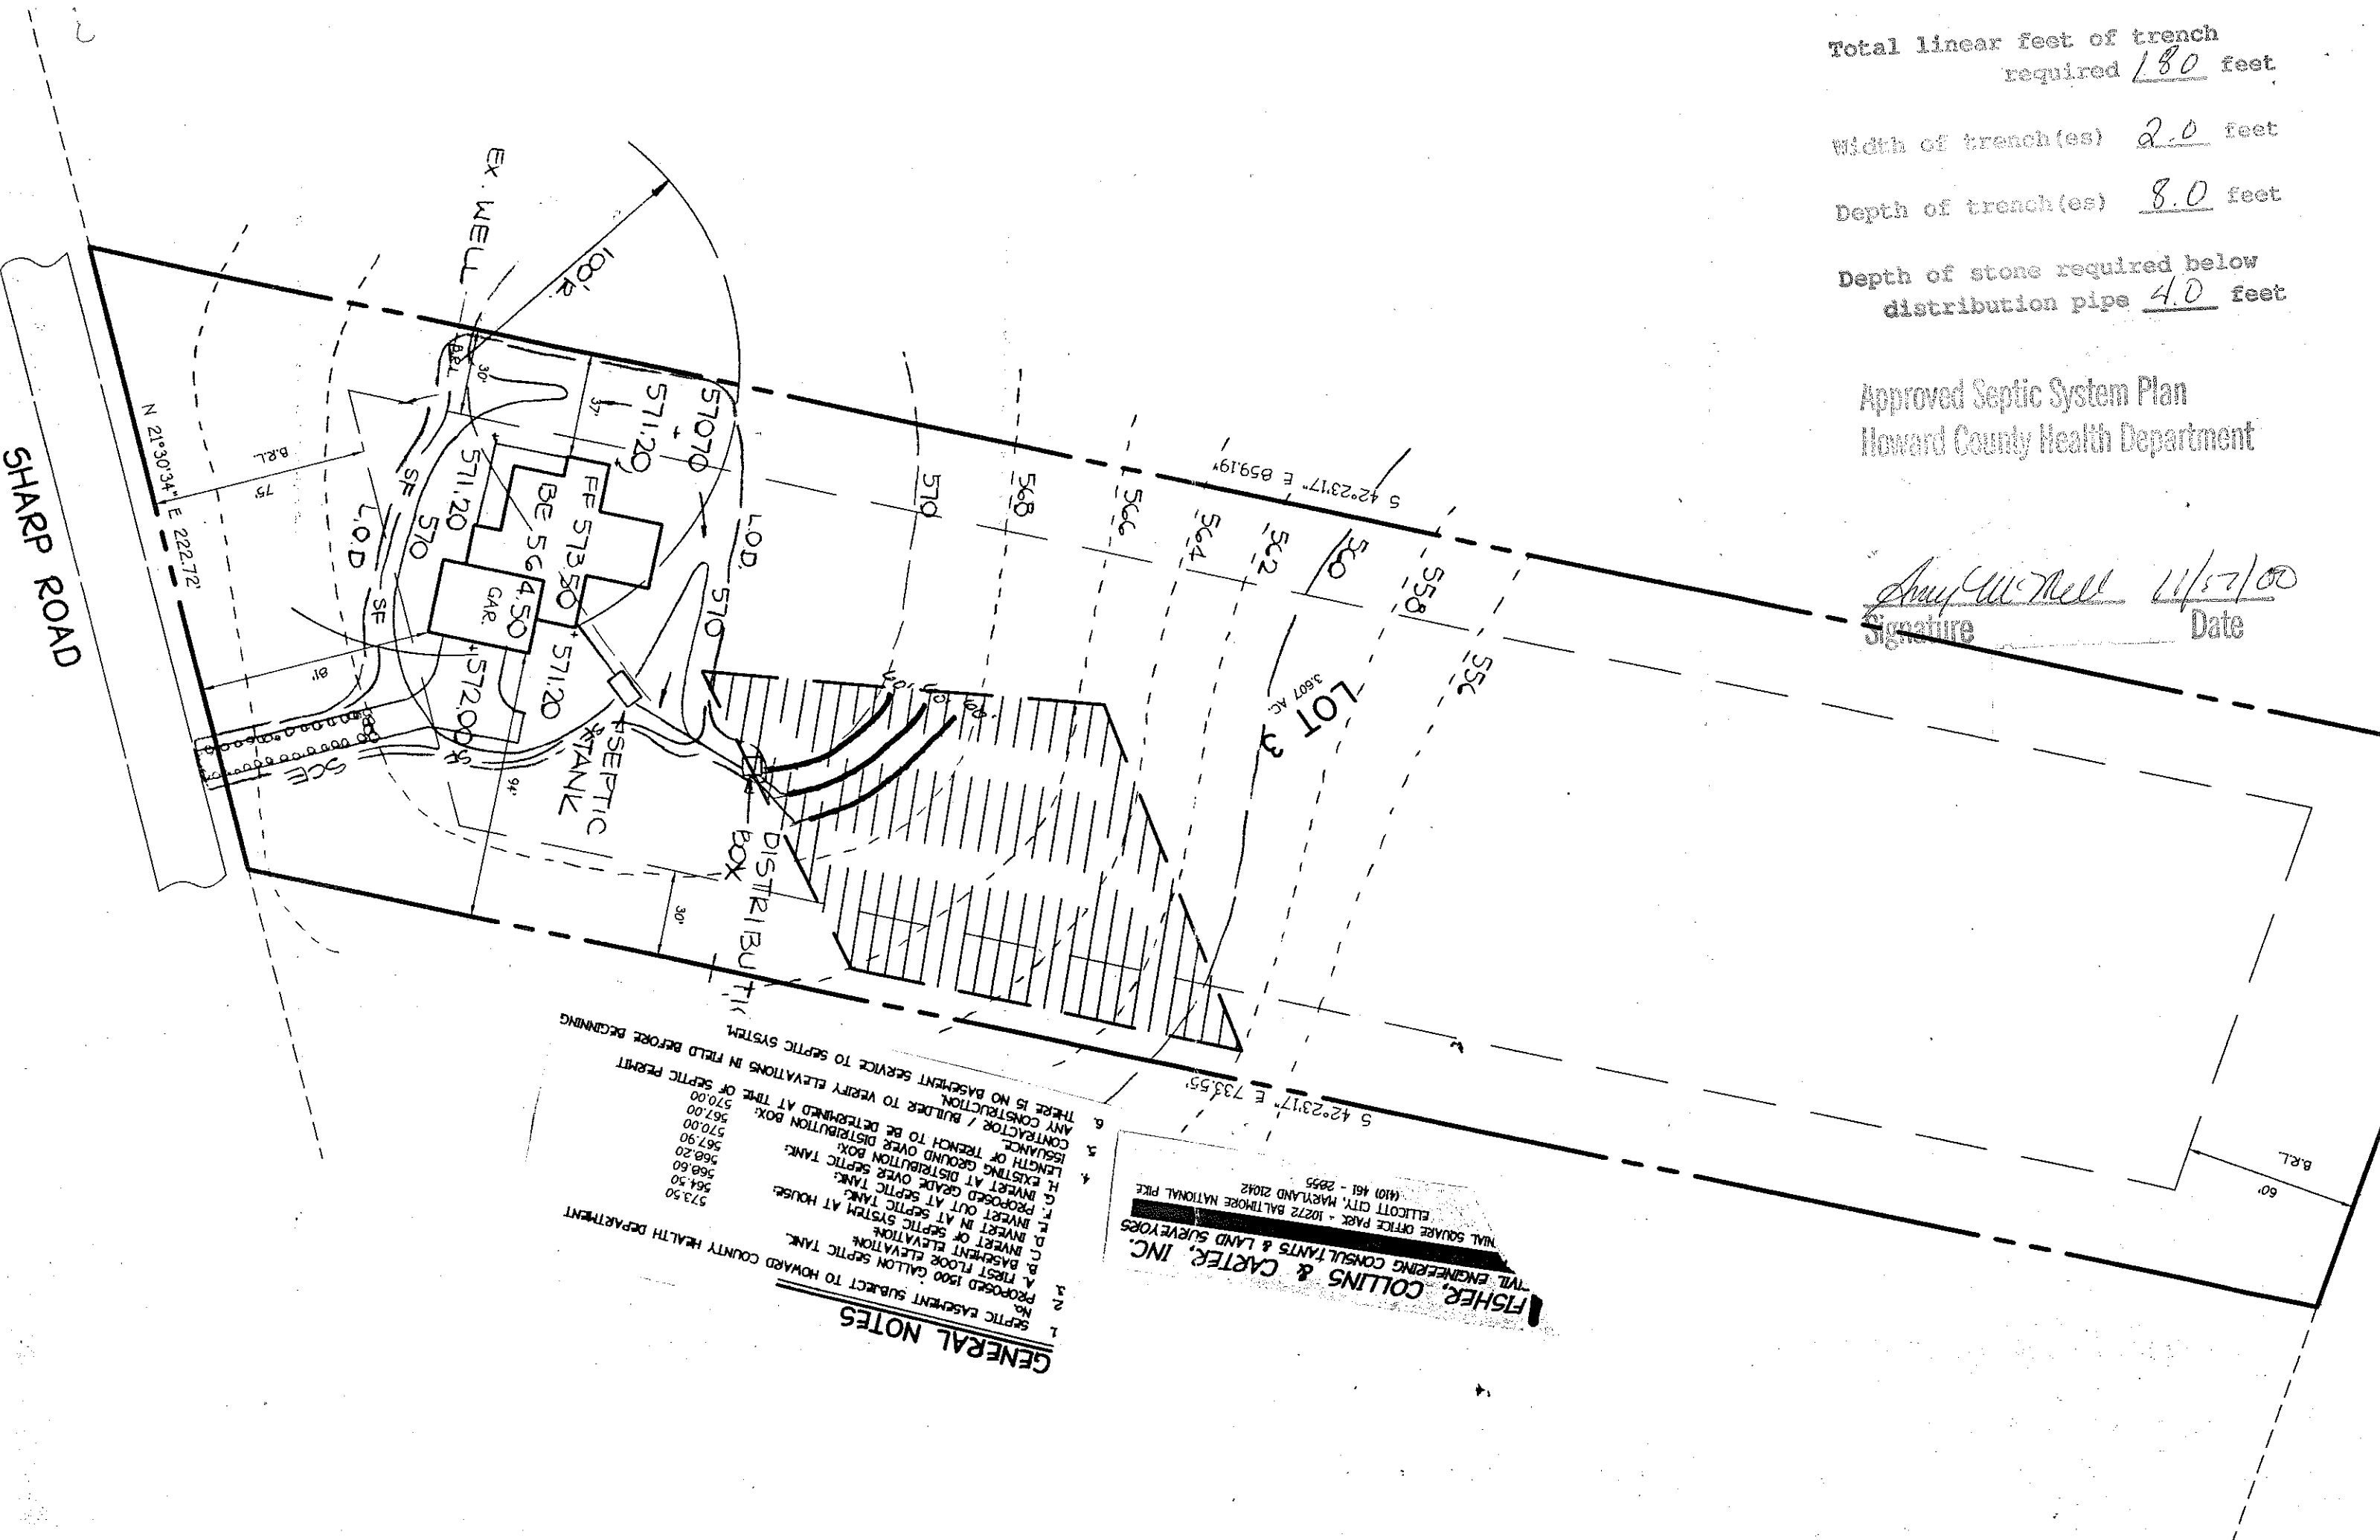


- GENERAL NOTES**
1. SEPTIC EASEMENT SUBJECT TO HOWARD COUNTY HEALTH DEPARTMENT
 2. PROPOSED 1500 GALLON SEPTIC TANK
 3. BASEMENT ELEVATION
 4. INVERT IN AT SEPTIC TANK
 5. INVERT OUT AT SEPTIC TANK
 6. PROPOSED GRADE OVER SEPTIC TANK
 7. EXISTING AT DISTRIBUTION BOX
 8. LENGTH OF TRENCH TO BE DETERMINED AT TIME OF SEPTIC PERMIT
 9. CONTRACTOR / BUILDER TO VERIFY ELEVATIONS IN FIELD BEFORE BEGINNING ANY CONSTRUCTION
 10. THERE IS NO BASEMENT SERVICE TO SEPTIC SYSTEM

FISHER, COLLINS & CARTER, INC.
CIVIL ENGINEERING CONSULTANTS & LAND SURVEYORS
10272 BALTIMORE NATIONAL PIKE
ELICOTT CITY, MARYLAND 21042
(410) 461-2855

B00142542

6/18/03

adm. (K)

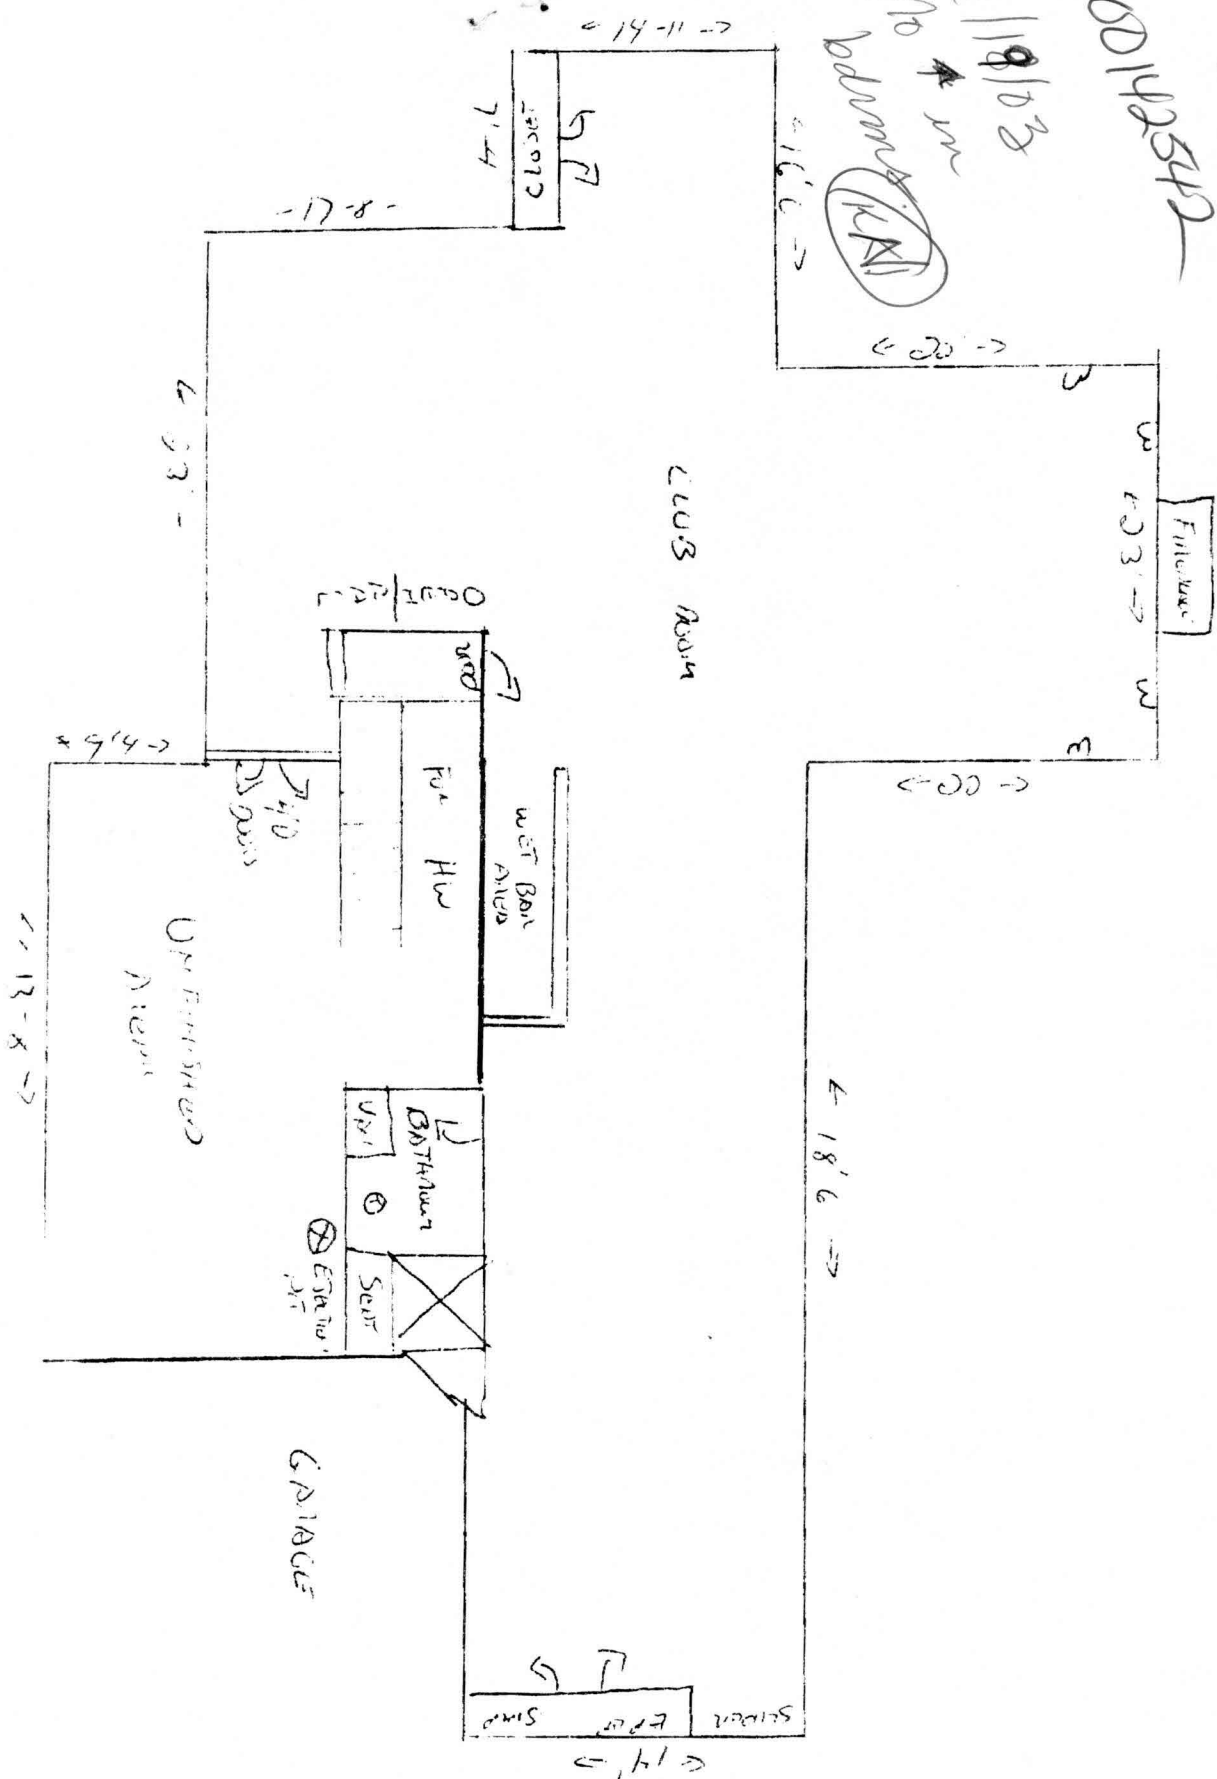

SILAS BASEMENT PLAN

1000 sq ft