

APPLICATION

PERCOLATION TESTING

HOWARD COUNTY HEALTH DEPARTMENT
BUREAU OF ENVIRONMENTAL HEALTH
P.O. BOX 476 ELLICOTT CITY, MARYLAND 21043
TELEPHONE: 461-9933

A 38031

P _____

DISTRICT _____

DATE 11/7/86

*11/19/86
perc pending
meeting requirements
below*

TO: THE COUNTY HEALTH OFFICER
ELLICOTT CITY, MARYLAND

Repair

I, HEREBY, APPLY FOR THE NECESSARY TEST IN ORDER TO CONSTRUCT (OR RECONSTRUCT) A SEWAGE DISPOSAL SYSTEM.

PROPERTY OWNER CHARLES A SHARP

ADDRESS 3779 SHARP RD GLENWOOD PHONE 4894630

PROSPECTIVE BUYER N/A

ADDRESS N/A PHONE N/A

PROPERTY LOCATION:

SUBDIVISION CHARLES A SHARP PROP. LOT NO. #2 Repair

ROAD AND DESCRIPTION SHARP ROAD EXISTING HOUSE

TAX MAP 21 PARCEL # 149

SIZE OF LOT 3AC+ TYPE BLDG Existing (2 Bedrm)
SINGLE FAMILY
(SINGLE FAMILY DWELLING OR COMMERCIAL)

THE SYSTEM INSTALLED UNDER THIS APPLICATION IS ACCEPTABLE ONLY UNTIL PUBLIC FACILITIES BECOME AVAILABLE. I FULLY UNDERSTAND THE

FEE CONNECTED WITH THE FILING OF THIS PERC TEST APPLICATION IS NON-REFUNDABLE UNDER ANY CIRCUMSTANCES. I ALSO AGREE TO COMPLY

WITH ALL M.O.S.H.A. REQUIREMENTS IN TESTING THIS LOT. Charles A Sharp
(SIGNATURE OF APPLICANT)



APPROVED BY _____ FOR _____ DATE _____

REJECTED BY _____ FOR _____ DATE _____

HOLD PENDING FURTHER TESTS _____ DATE _____

REASONS FOR REJECTION OR HOLDING for certified plat showing holes & well
location for future consideration &/or
language stipulating easement requirements/

THIS IS NOT A PERMIT

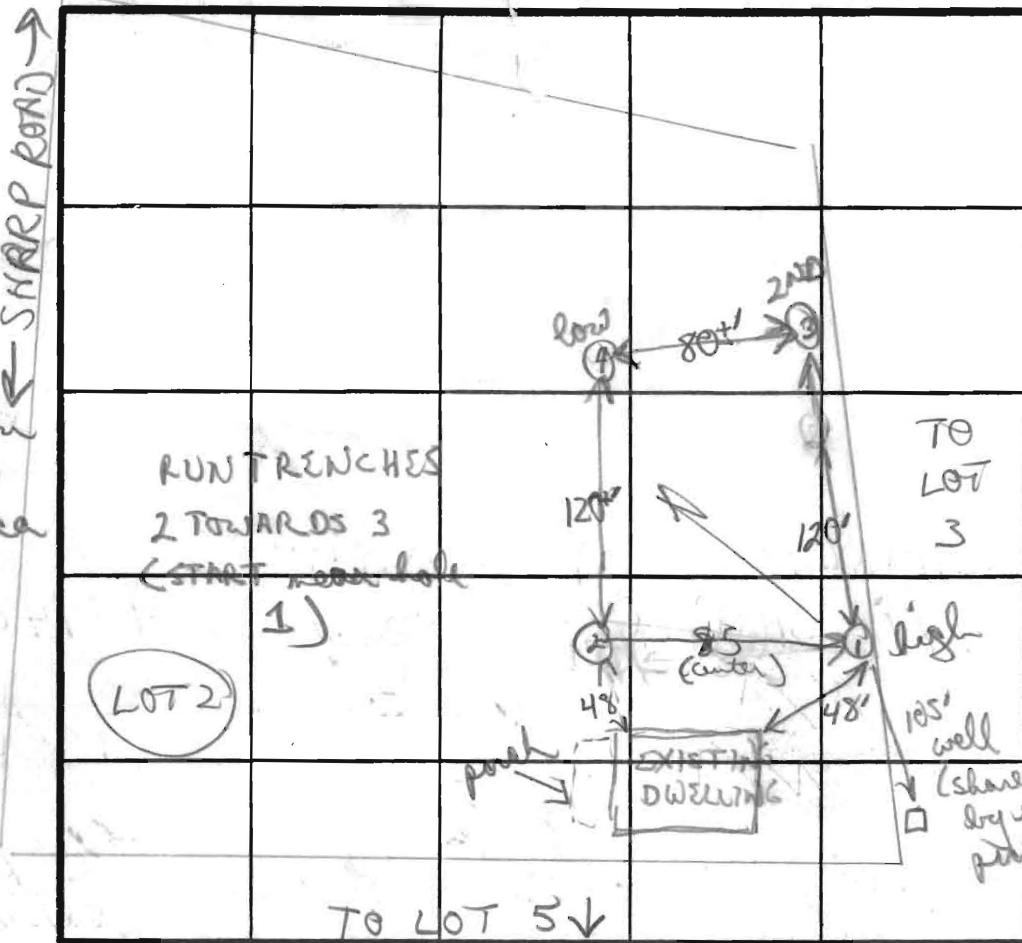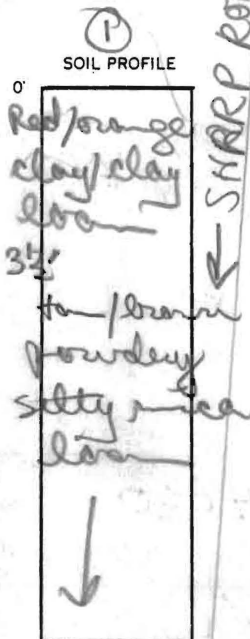

③

AP zone 34'

red/orange clay 3'

clay loam 4 1/2'

brown/red sandy mica loam w/ few small scattered rock frags

↓

12'D

Red orange clay/clay loam 4'

brown sandy/mica loam - 7'

to grey/brown sandy/silty mica loam

12'D

DATE	TEST NO.	DEPTH	PRE-WET		TEST - 1" DROP		TIME
			START	STOP	START	STOP	
11/19/86	①	4 1/2' S	143	145	143	148	3min
		12'D	bottom (see profile)				
	②	5' S	150	155	155	200	5min
		12'D	bottom (see profile)				
	④	4 1/2'	200	203	203	208	5min
		12 1/2'D	(H ₂ O at 11 1/2')				
	③	4 1/2' S	210	219	219	244	25min
		12'D	bottom (see profile)				

REMARKS

Repair to existing house, H₂O only in low hole

AP zones, clay/sands to 4-5'; sandy/silty mica loams

TYPE OF SOIL

TESTED BY

B Nyman

ALSO PRESENT


Mr Sharp

EH-12-1079


H₂O 11 1/2'D

$$1' = 100''$$

CURVE	R
455-750	2
504-788	91
766-776	

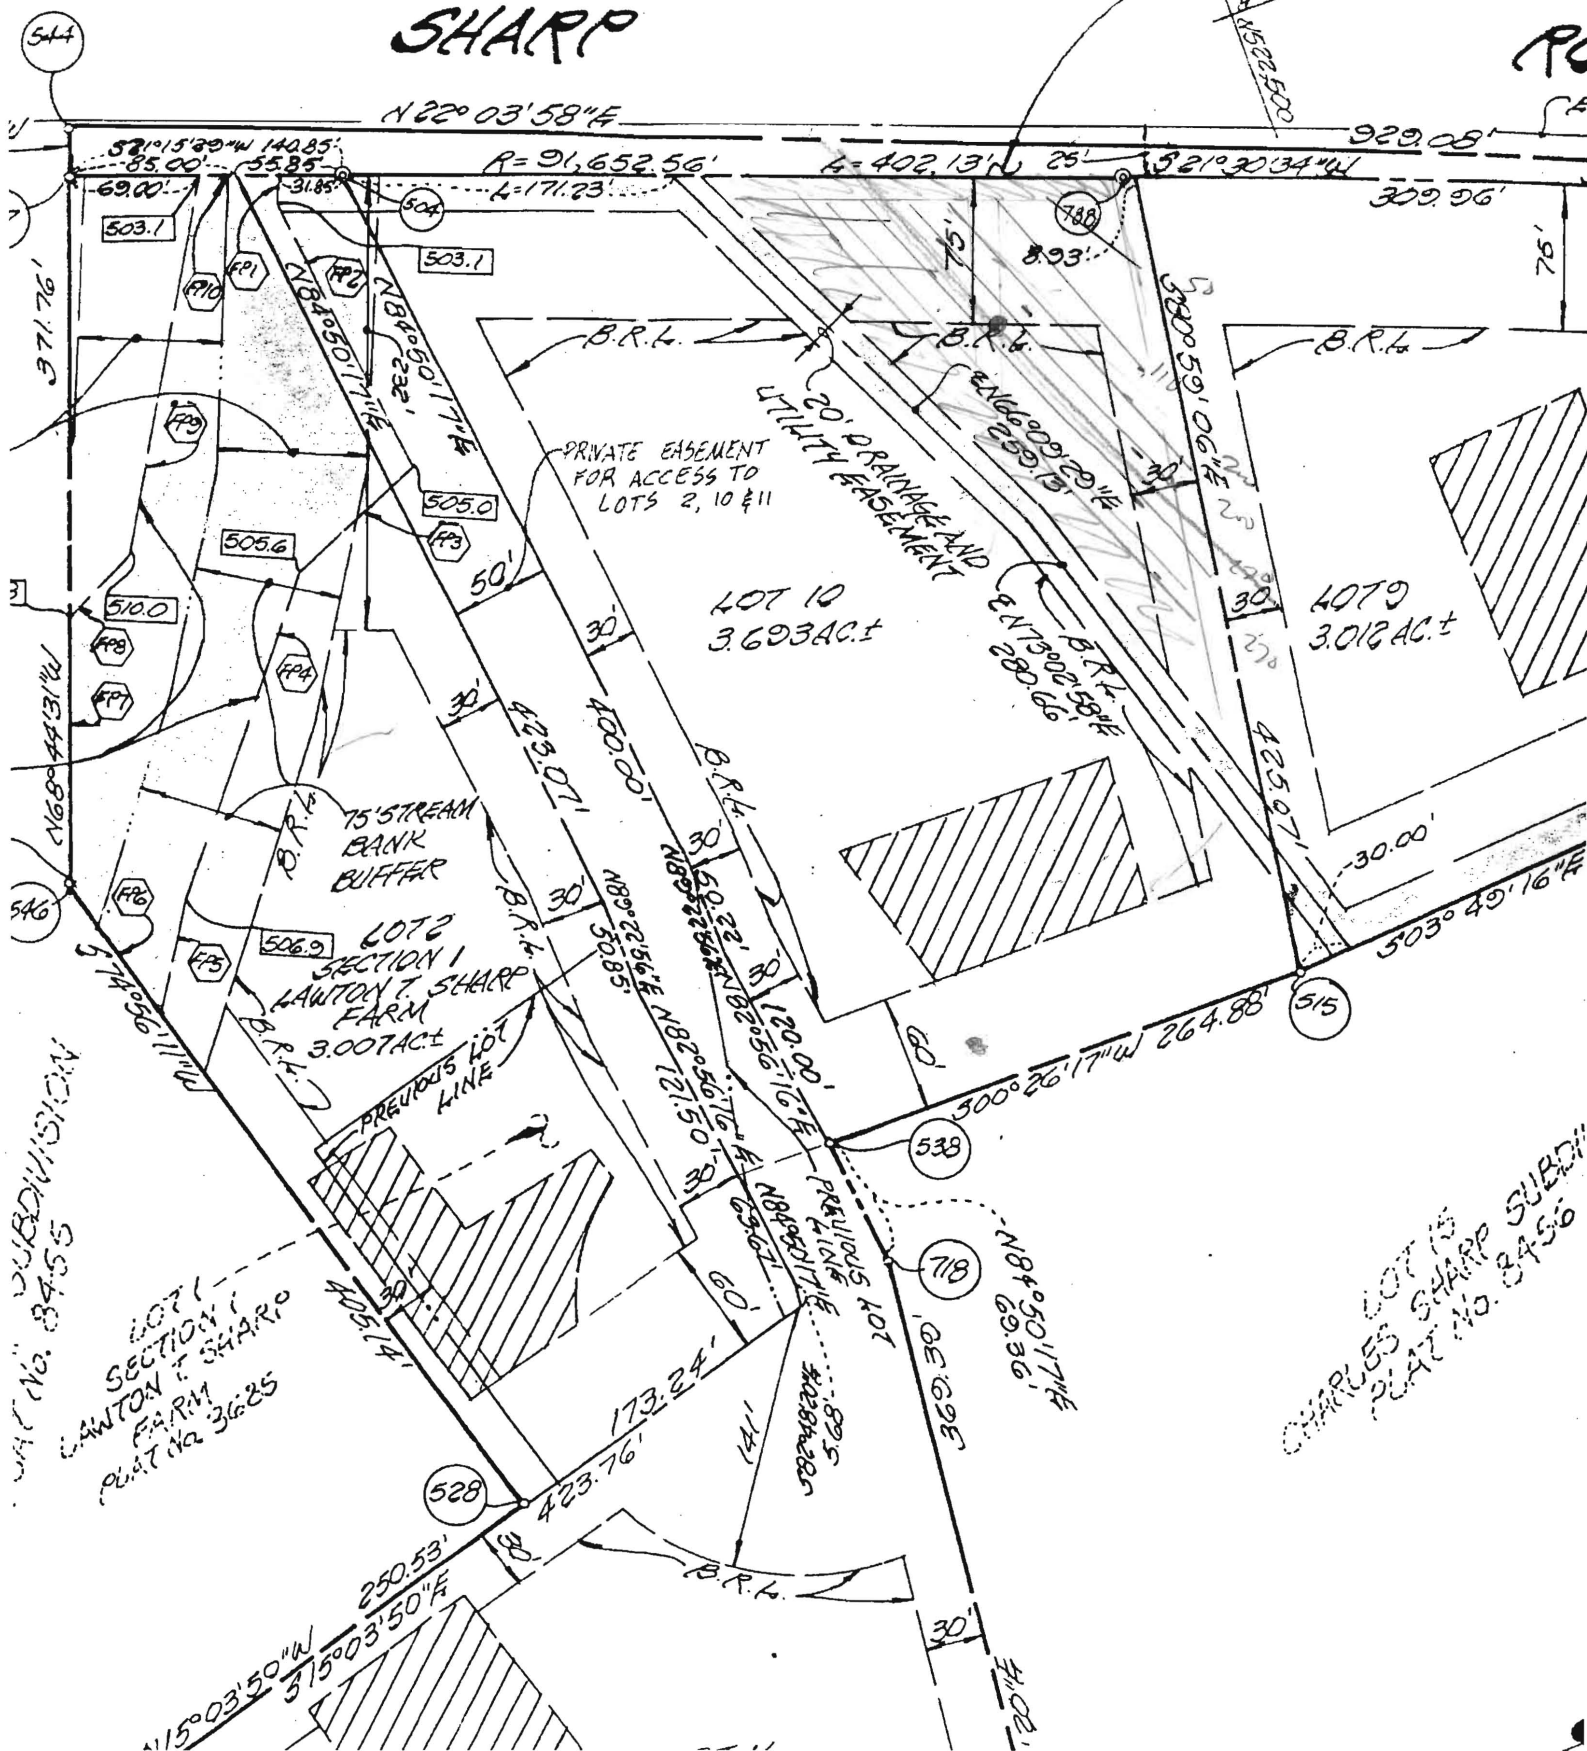

LOT 10

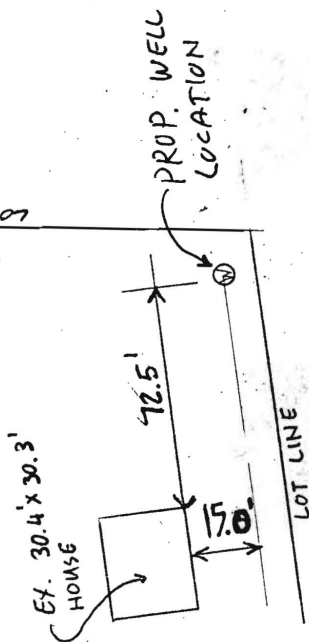


NOT TO SCALE

N 44° 04' 31" E
214.34'

(515)

(923)

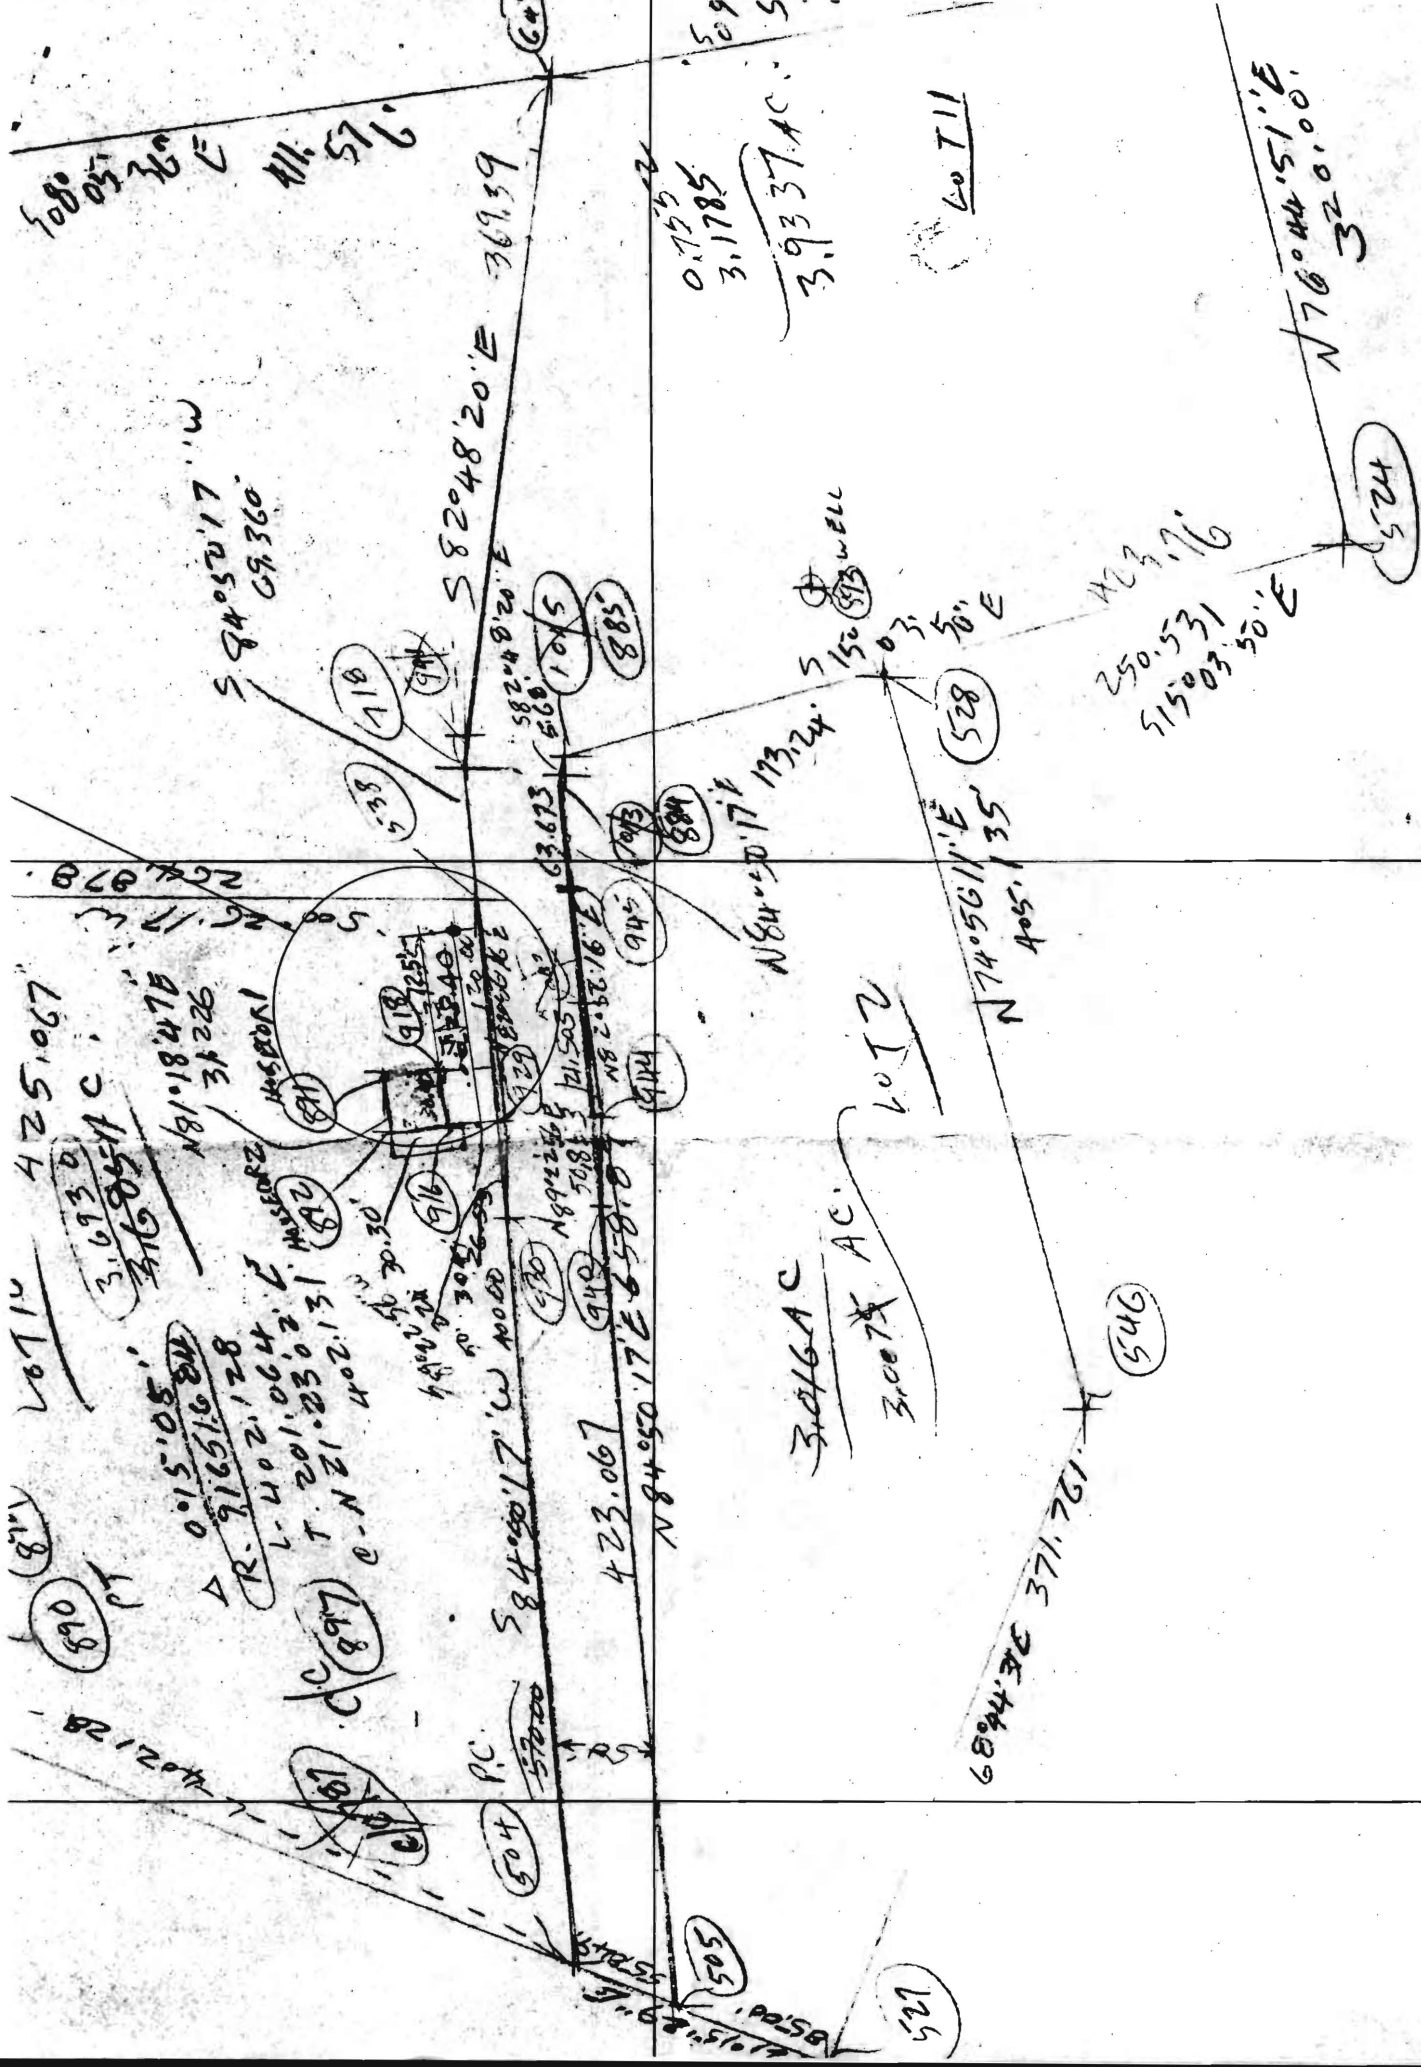

LAND DEDICATED TO HOWARD COUNTY, MARYLAND
FOR THE PURPOSES OF A PUBLIC ROADWAY
AREA: 0.999 AC ±

455-535	2147
504-788	91652
782-776	175

SHARP

N 22°05'50"E

ROAD

