

2/4/04

see approved water and
sewer plan for well site
adjustment

LIAM AND ELIZABETH R
PARCEL 363 LOT 1
LOST WOODS ESTATES
PLAT #1418
ZONED RG-DEO

566°10'27"E 40608.43

MID-2

CHE

ied)

9A

$$3.6 \pm$$

32

54

Ba


PEDDICORD I PROPER

PARCEL 268

NEOT

47,98



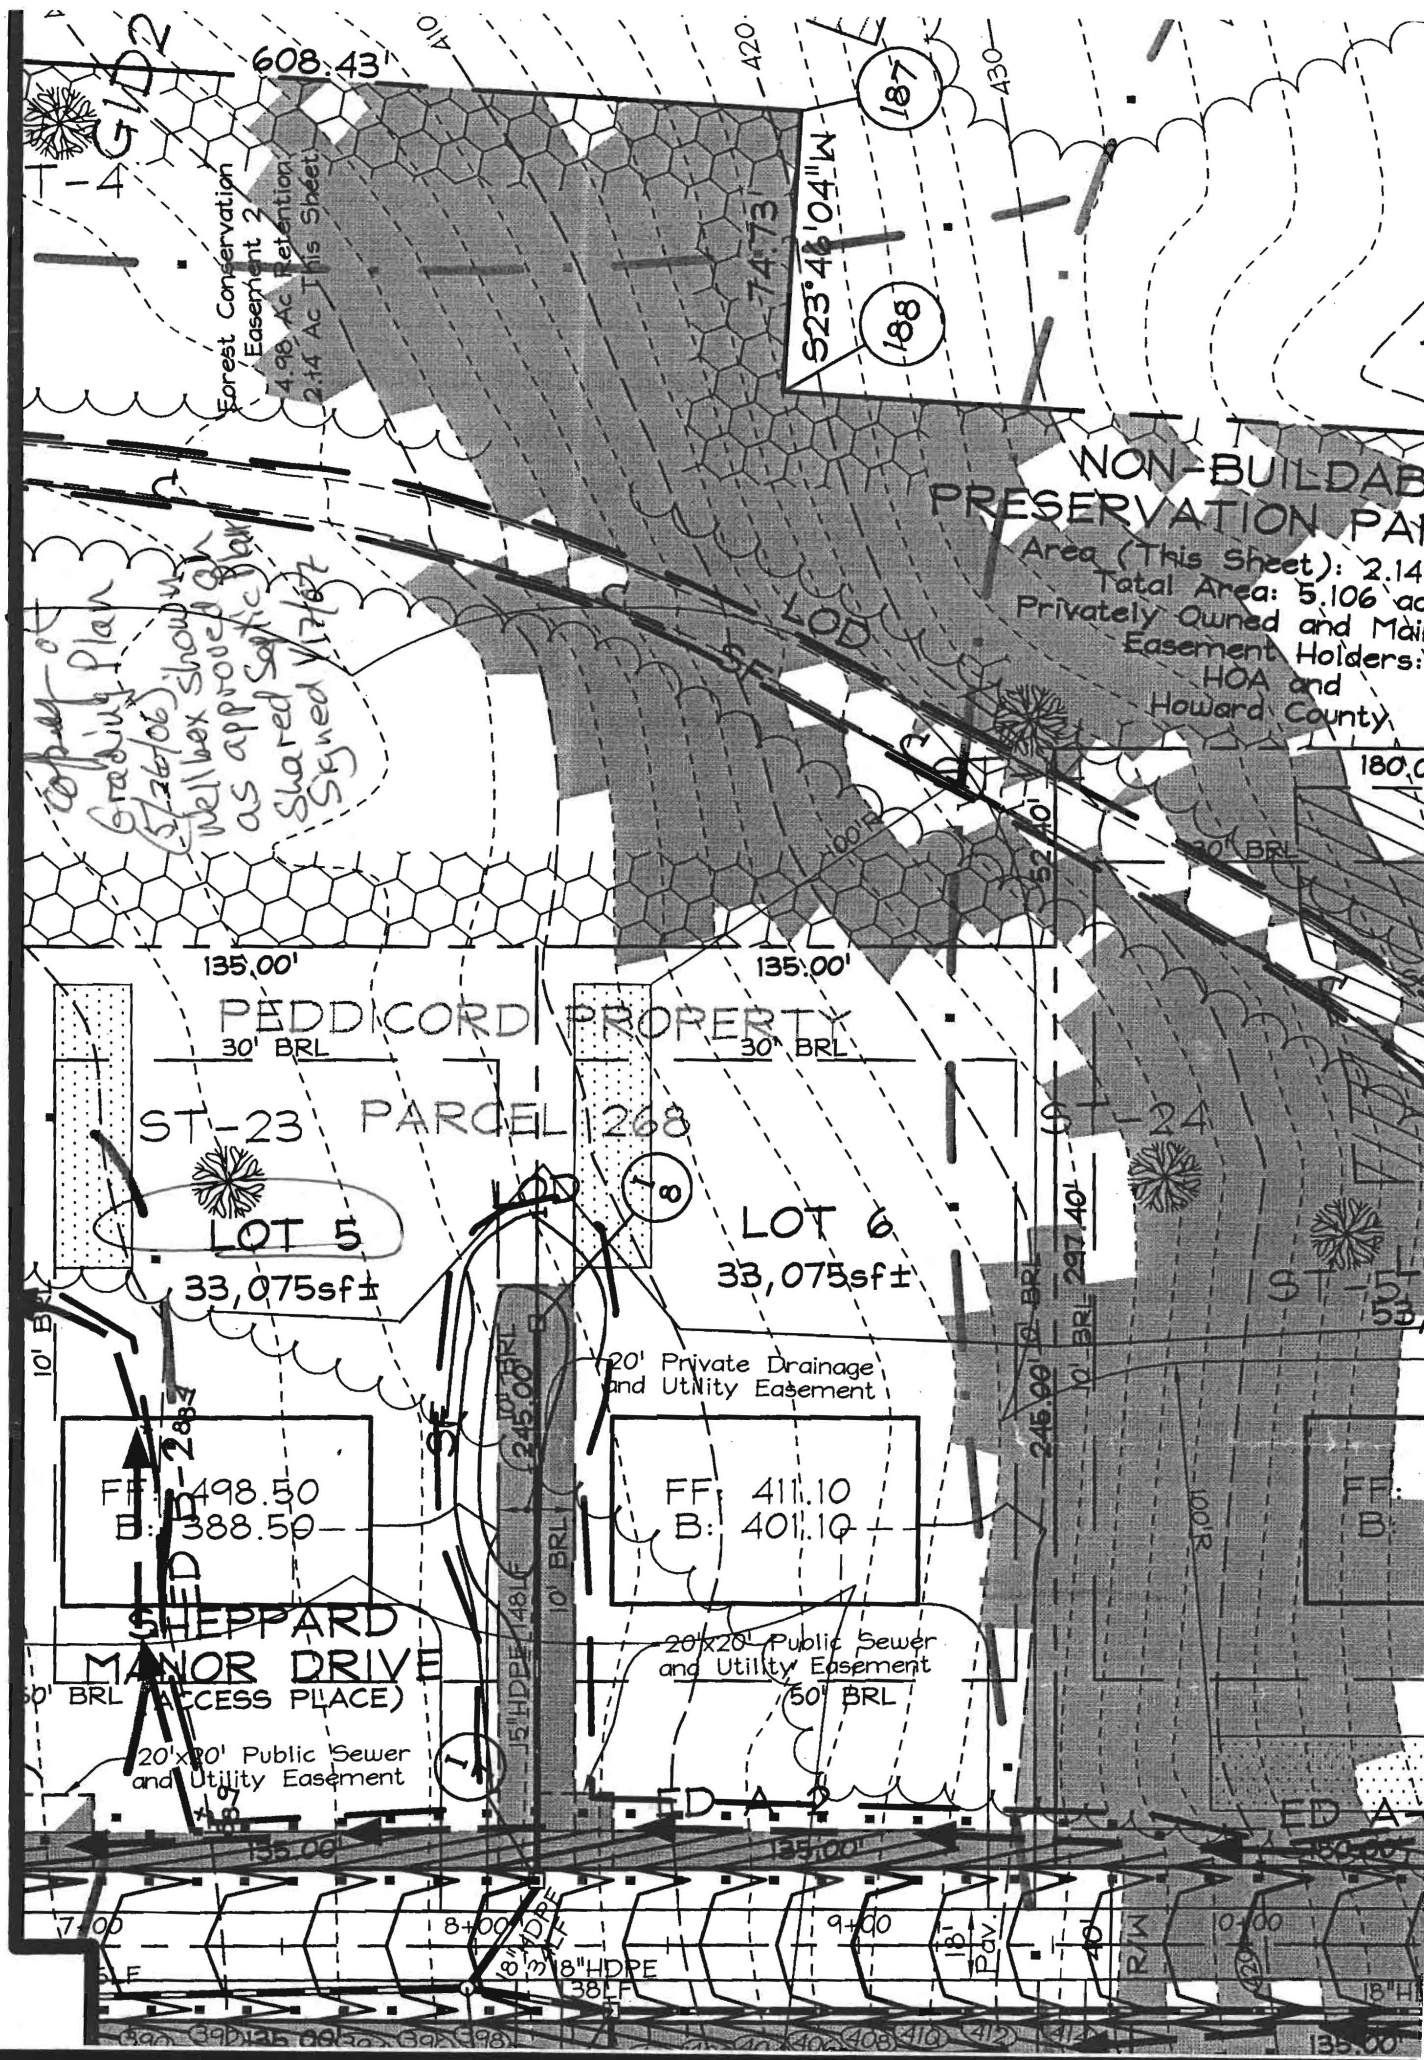


N 575,0

SERVATION PARCEL 'A'
Area (This Sheet): 4.597 ac.±
Total Area: 5.106 ac.±
Privately Owned and Maintained
Easement Holders: HOA and
Howard County, Maryland


Easement 2
4.99 Ac Retention
4.48 Ac This Sheet

Natural Conservation
Stormwater Management
Credit Easement

Copy Plat # 20013

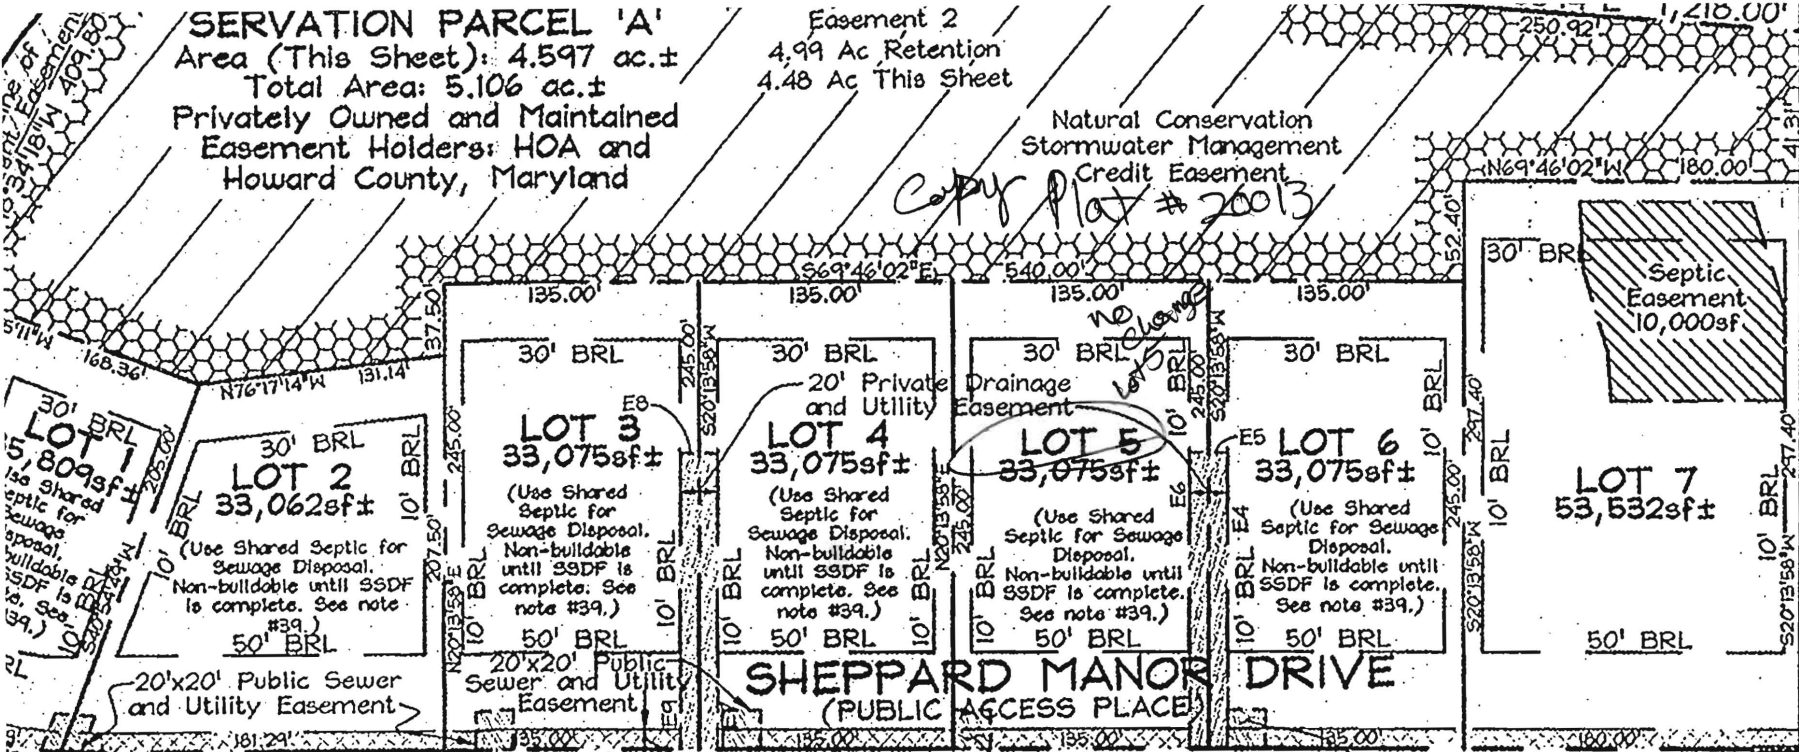

SEE SHEET 3 of 3

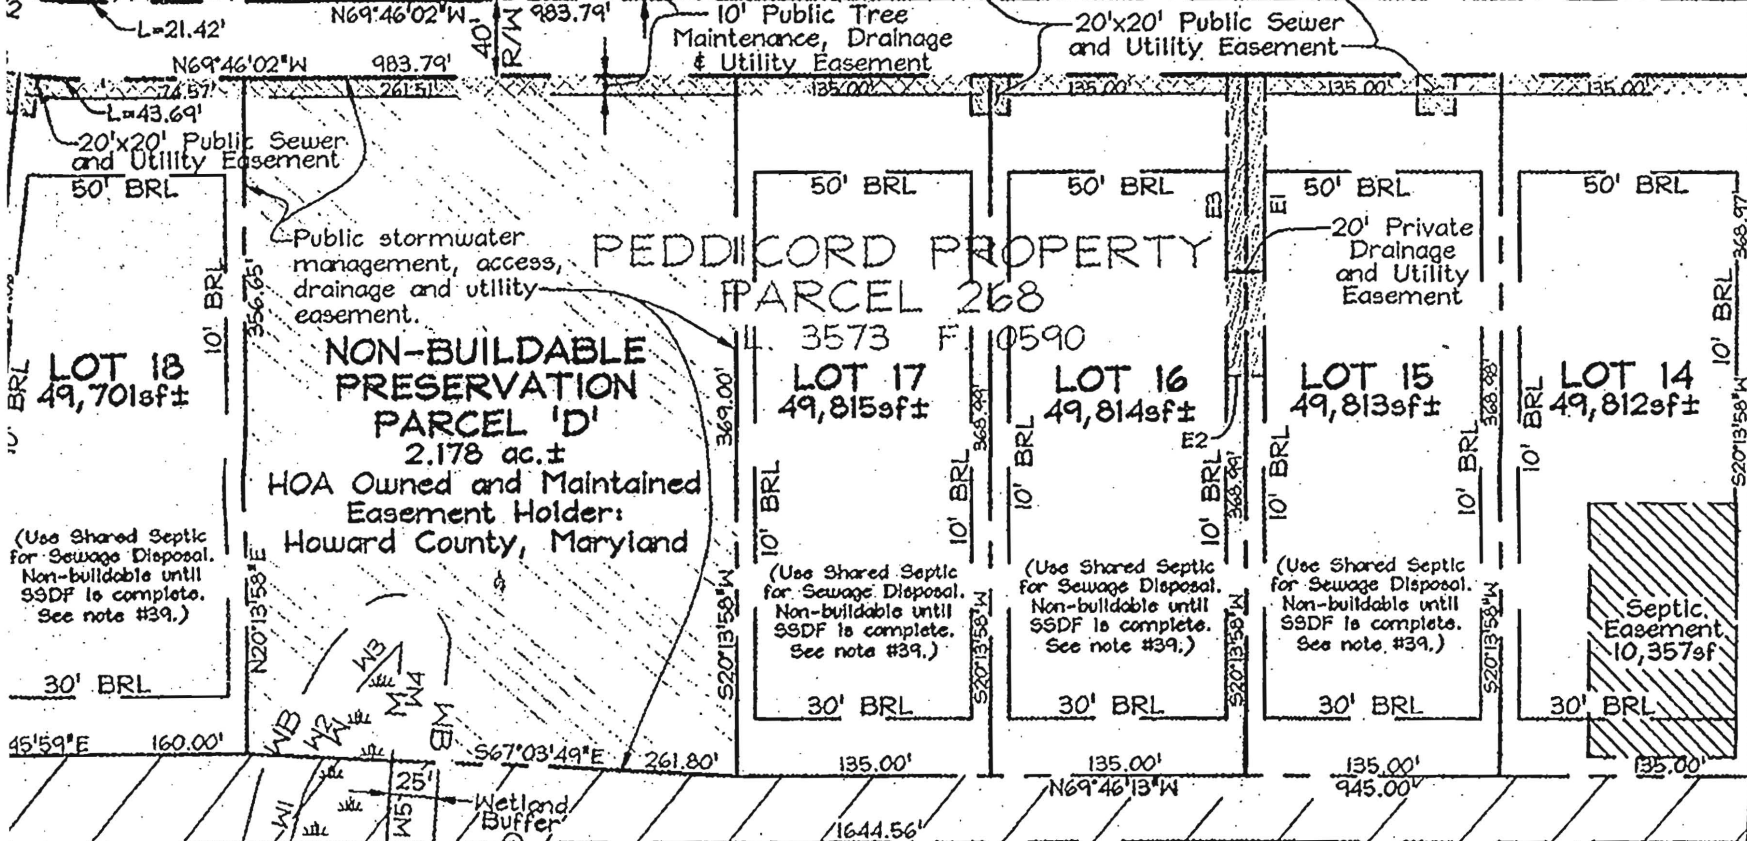

MATCHLINE

N 575.0