


(A) - Prop. 4 Bedroom House
F.F.E. = 514.6'
B'smt. Elev. = 504.6'
Inv. Elev. = 503.1'

(B) - Prop. Septic Tank
Ex. Elev. = 505.6'
Inv. In = 502.9'
Inv. Out = 502.6'

(C) - Prop. Dist. Box
Ex. Elev. = 504.4'
Inv. Elev. = 499.7'


(D) - Prop. Trenches
Inv. Elev. = 499.4'
Length to be determined
at time of septic permit
issuance.

Approved Septic System Plan
Howard County Health Department

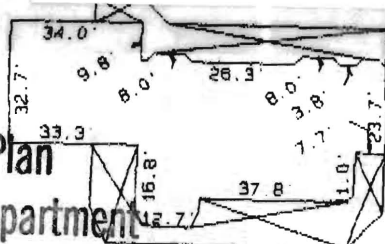

Signature *W. J. Day*

Date *4/17/01*

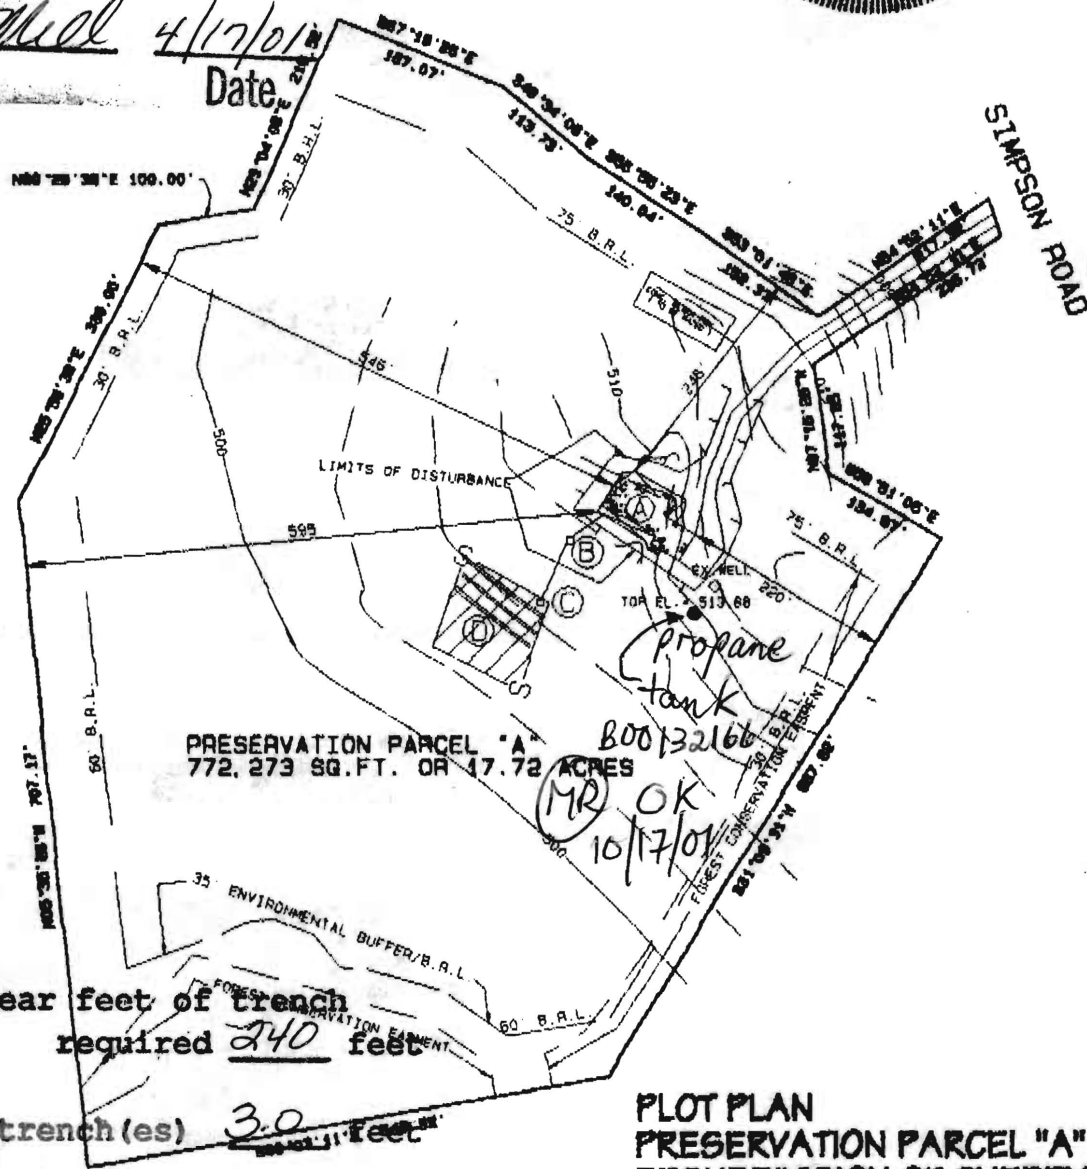

Total linear feet of trench required 240 feet

Width of trench(es) 3.0 feet

Depth of trench(es) 6.5 feet

Depth of stone required below distribution pipe 2.0 feet

PLOT PLAN
PRESERVATION PARCEL "A"
RESUBDIVISION OF CHERRY BRAE
LOT 4
SITUATED ON SIMPSON ROAD
ELECTION DISTRICT No. 5
HOWARD COUNTY, MARYLAND
SCALE: 1" = 200' MARCH 2001

I CERTIFY THIS PLAT TO BE CORRECT; IT IS THE RESULT OF AN ACTUAL FIELD SURVEY, BASED ON DATA FOUND AMONG THE LAND RECORDS OF HOWARD COUNTY, MARYLAND, AS REFERENCED HEREON.

REFERENCE
PLAT No. 14484

JOB NO.

RAYMOND J. DAY
LAND SURVEYOR
65 DRIFTWOOD DRIVE
SWANTON, MARYLAND 21561
301-387-8573