

6/21/01
Layout 11:00

6/22/01
C.O. Final
> 1:00

ISSUE DATE: 6/7/2001

APPROVAL DATE: 6/22/01

PERMIT

INDEXED

P 515283

A 511437-A

ON-SITE SEWAGE DISPOSAL SYSTEM HOWARD COUNTY HEALTH DEPARTMENT BUREAU OF ENVIRONMENTAL HEALTH

05-434440

Barnard Brothers Construction

IS PERMITTED TO INSTALL ☒ ALTER ☐

ADDRESS: 1612 Brittle Branch Way, Woodbine PHONE NUMBER: 410-489-7621

SUBDIVISION: Cherry Brae

LOT NUMBER: RP A (charlotte #4)

11925 Simpson Road
ADDRESS: 6321 Golden Harvest Court

PROPERTY OWNER: Thomas Stanton
11925 Simpson Road

SEPTIC TANK CAPACITY (GALLONS): 1250

(former owner of Cherry Brae Mining
was George J. Simpson (deceased))

PUMP CHAMBER CAPACITY (GALLONS): N/A

NUMBER OF BEDROOMS: 4

SQUARE FEET PER BEDROOM: 180

LINEAR FEET OF TRENCH REQUIRED: 240

Start trenches 3.5' below any fill.

TRENCHES:	Trench to be 3.0 feet wide. Inlet 4.5 feet below original grade. Bottom maximum depth 6.5 feet below original grade. Effective area begins at 4.5 feet below original grade. 2.0 feet of stone below distribution pipe.
LOCATION:	Begin trenches at the high end of the staked septic area. Run trenches on contour.
NOTES:	

PLANS APPROVED: Amy Mc Millen

5/22/01 OK (BB)

DATE: 4-17-01

NOTE: PERMIT VOID AFTER 2 YEARS

NOTE: CONTRACTOR RESPONSIBLE FOR SCHEDULING A PRE-CONSTRUCTION INSPECTION FOR ALL INSTALLATIONS

NOTE: WATERTIGHT SEPTIC TANKS REQUIRED

NOTE: ALL PARTS OF SEPTIC SYSTEM SHALL BE 100 FEET FROM ANY WATER WELL

NOTE: MANHOLE RISERS REQUIRED ON ALL SEPTIC TANKS AND PUMP CHAMBERS

CLERK, BUREAU OF ENVIRONMENTAL HEALTH


AND RETURNED 10/17/01

NEITHER THE HOWARD COUNTY COUNCIL NOR THE HEALTH DEPARTMENT IS RESPONSIBLE FOR THE SUCCESSFUL OPERATION OF ANY SYSTEM
PERMITTEE RESPONSIBLE FOR OBTAINING FINAL APPROVAL ON THIS PERMIT
CALL 410-313-2640 FOR INSPECTION OF SEPTIC SYSTEM

NOV 6 2001
46 TANK

P515283

NOT TO SCALE

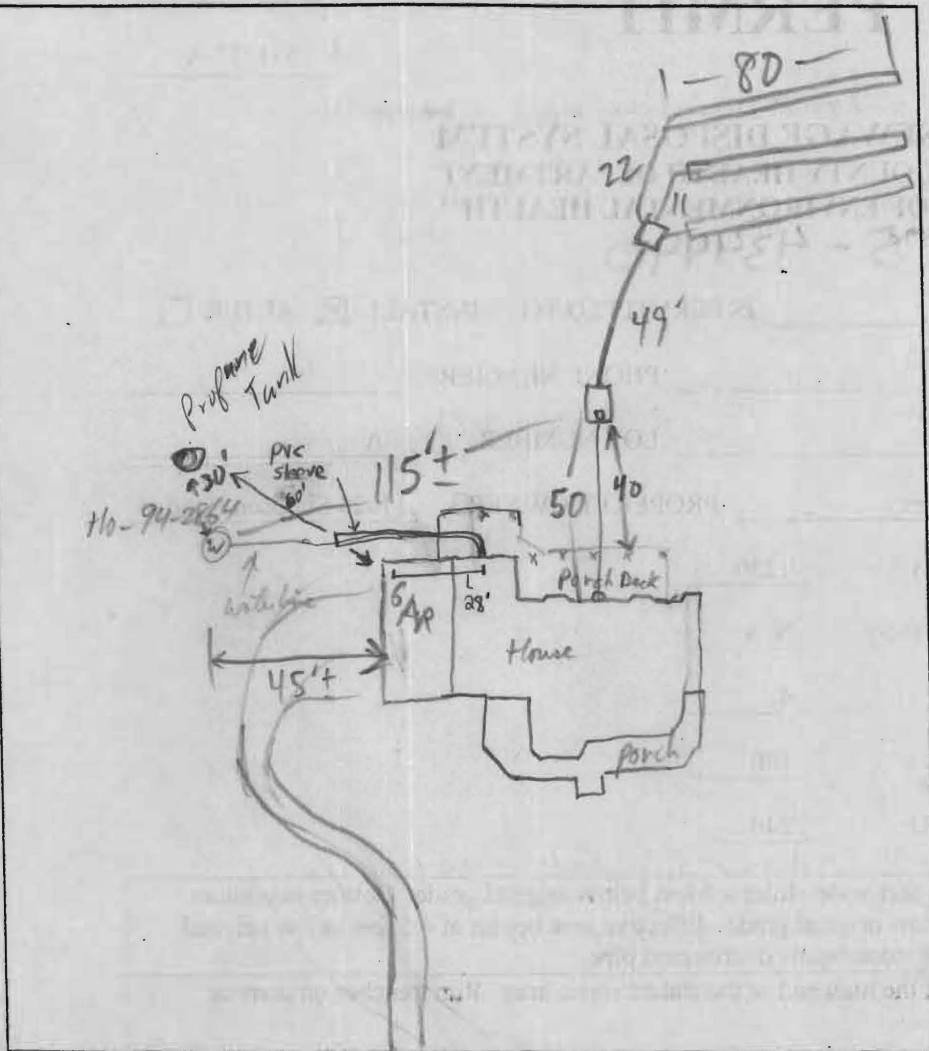

TRENCH DATA

TRENCH WIDTH 3
TRENCH INLET DEPTH 4.5
TRENCH BOTTOM DEPTH 6.5
DEPTH OF STONE 2
NUMBER OF TRENCHES 3
TOTAL TRENCH LENGTH 240
ABSORBENT AREA 720
DISTRIBUTION BOX LEVEL ☒
BAFFLE IN DISTRIBUTION BOX ☒

SEPTIC TANK DATA

SEPTIC TANK 1500 TS GALLONS
MANHOLE RISER ☒
6 INCH INSPECTION PORT ☒

PUMP CHAMBER DATA

PUMP CHAMBER
GALLONS X
MANHOLE RISER X
ALARM X
PUMP PERFORMANCE TEST X

PRE-CONSTRUCTION INSPECTION: boards show site was graded so OK to lay Trenches parallel to

field and set inlet at whatever depth gets into the good nice loam soils. 6/21/01

INSPECTION COMMENTS: Septic Tank set, Baffle installed, House Connection OK, OK to Cover Septic Tank

6/22/01 OK TO COVER ALL (MR)


INSPECTOR

M. Rifkin

DATE SYSTEM APPROVED

6/22/01


CONCRETE BLOCK
FOUNDATION

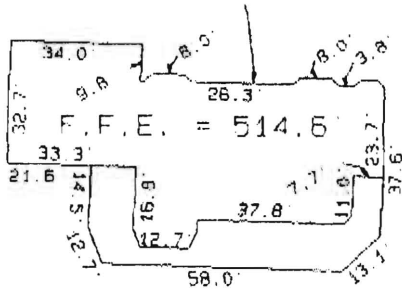

HOUSE DETAIL
(N.T.S.)



5/23/01

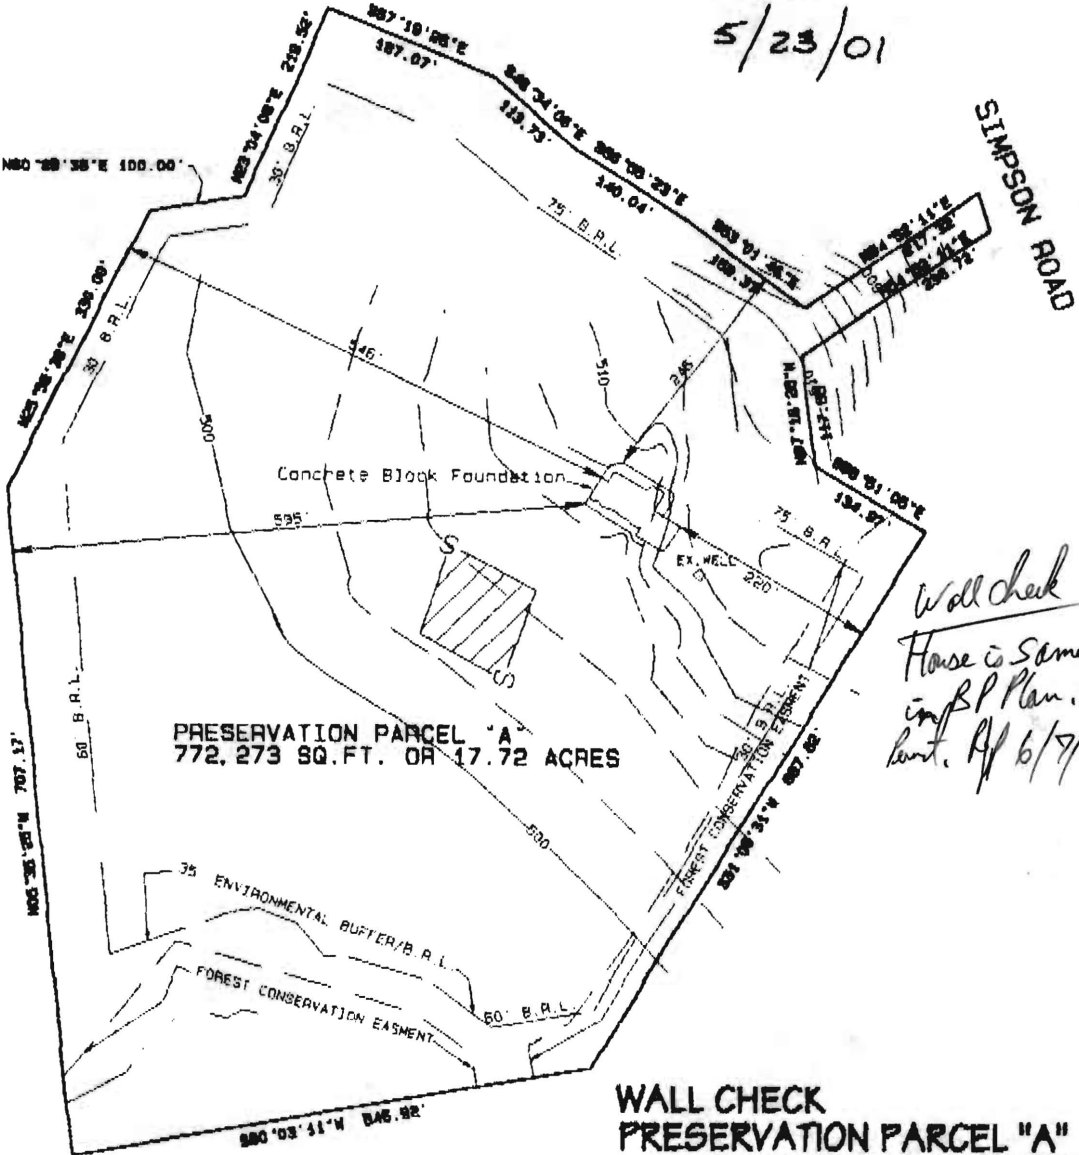

Wall check
House is same as
in P.P. Plan. OK to be
built. Rf 6/7/01

Note: Foundation and footings are in place.

WALL CHECK
PRESERVATION PARCEL "A"
RESUBDIVISION OF CHERRY BRAE
LOT 4
11925 SIMPSON ROAD
ELECTION DISTRICT No. 5
HOWARD COUNTY, MARYLAND
SCALE: 1" = 200' MAY 2001

I CERTIFY THIS PLAT TO BE CORRECT; IT IS THE RESULT OF AN
ACTUAL FIELD SURVEY, BASED ON DATA FOUND AMONG THE LAND
RECORDS OF HOWARD COUNTY, MARYLAND, AS
REFERENCED HEREON.

REFERENCE
PLAT No. 14484

JOB NO.

RAYMOND J. DAY
LAND SURVEYOR
65 DRIFTWOOD DRIVE
SWANTON, MARYLAND 21561
301-387-8573