

APPLICATION

PERCOLATION TESTING

HOWARD COUNTY HEALTH DEPARTMENT
BUREAU OF ENVIRONMENTAL HEALTH
P.O. BOX 476 ELLICOTT CITY, MARYLAND 21043
TELEPHONE 461-9933

A _____

P _____

DISTRICT _____

DATE _____

TO: THE COUNTY HEALTH OFFICER
ELLICOTT CITY, MARYLAND

I HEREBY APPLY FOR THE NECESSARY TEST IN ORDER TO CONSTRUCT (OR RECONSTRUCT) A SEWAGE DISPOSAL SYSTEM.

PROPERTY OWNER Lambert Cissel

ADDRESS 3425 Hipsley Mill Road, Woodbine, MD 21797 PHONE (410) 442-5671

PROSPECTIVE BUYER Developer, Land Marketing Consultants, Inc., Timothy W. Feaga

ADDRESS 3243 Bethany Lane, Ellicott City, MD 21042 PHONE (410) 313-8808

PROPERTY LOCATION:

SUBDIVISION Cissel Property

LOT NO 9

ROAD AND DESCRIPTION Intersection of Hardy & St. Michael's Road

TAX MAP 7 PARCEL # 394, 4, 341, 144

SIZE OF LOT 1 Acre

TYPE BLDG _____

(SINGLE FAMILY DWELLING OR COMMERCIAL)

THE SYSTEM INSTALLED UNDER THIS APPLICATION IS ACCEPTABLE ONLY UNTIL PUBLIC FACILITIES BECOME AVAILABLE. I FULLY UNDERSTAND THE FEE CONNECTED WITH THE FILING OF THIS PERC TEST APPLICATION IS NON-REFUNDABLE UNDER ANY CIRCUMSTANCES. I ALSO AGREE TO COMPLY WITH ALL M.O.S.H.A. REQUIREMENTS IN TESTING THIS LOT.

Willis Lambert Cissel JR
(SIGNATURE OF APPLICANT)

APPROVED BY _____ FOR _____ DATE _____

REJECTED BY _____ FOR _____ DATE _____

HOLD PENDING FURTHER TESTS _____ DATE _____

REASONS FOR REJECTION OR HOLDING _____

THIS IS NOT A PERMIT

COUNTY #

SOIL PROFILE
603

0' dark orange red siltm

4.0' lgt pink siltm
micaceous
25% Saprolite

1.0'

604

no distinct clay layers
orange brown siltm
30% shale throughout

0.0' refusal


477

beigh siltm
5% shale

4.0' brn siltm
15% shale

8.0' pink siltm
15% rock

12.0'

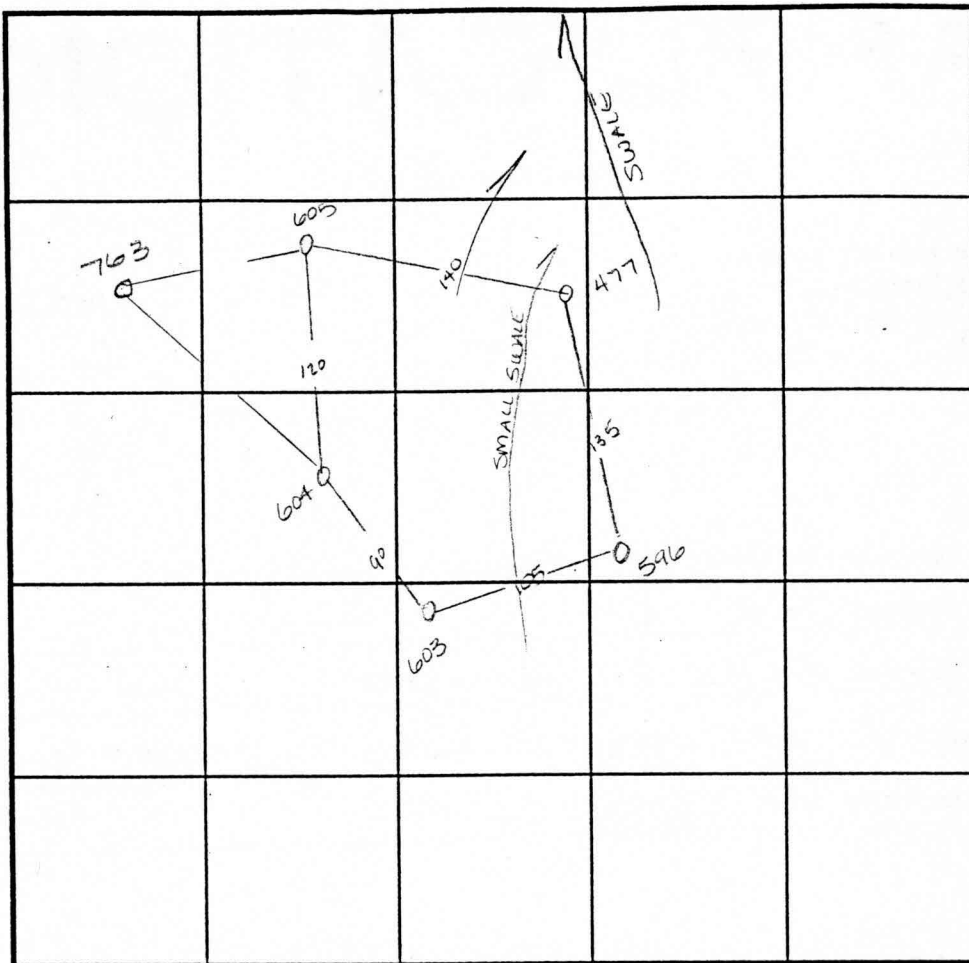SOIL PROFILE
596

0' tan beigh siltm

4.0' lgt brown siltm
25% shale

16.0' >50% rock

refusal at 11.5

763

3.0' orange brown siltm

6.0' dark red orange siltm
>50% rock

INDICATE NORTH - NAME ADJOINING ROADWAY AS BASE LINE.

Handy Road

DATE	TEST NO.	DEPTH	PRE-WET		TEST - 1" DROP		TIME
			START	STOP	START	STOP	
8-20-96	605	Insufficient	depth to bedrock -				F
		> 50% rock	throughout				
	603	Visual	to 11.0 — see profile				OK
	604	2.5 V10.0	12:08 ³⁰	12:10	12:10	12:13	3min
	477	3.0 V12.0	12:55	12:56	12:56	12:57	1min ✓
	596	4.0 V11.5	12:42 ³⁰	12:46	12:46	12:55	9min
8-28-96	763	Visual	only see profile —				F
		Insufficient	depth to bedrock				

REMARKS

TYPE OF SOIL

TESTED BY Amy McMullen ALSO PRESENT Tim Feaga

TRENCH DESIGN DATA: AVERAGE PERCOLATION TIME _____ TRENCH WIDTH _____

INLET DEPTH _____ MAXIMUM BOTTOM DEPTH _____ SQ. FT./BEDROOM _____

APPLICATION

PERCOLATION TESTING

HOWARD COUNTY HEALTH DEPARTMENT
BUREAU OF ENVIRONMENTAL HEALTH
PO BOX 476 ELLICOTT CITY, MARYLAND 21043
TELEPHONE 461-9933

A _____

P _____

DISTRICT _____

DATE _____

TO: THE COUNTY HEALTH OFFICER
ELLICOTT CITY, MARYLAND

I HEREBY APPLY FOR THE NECESSARY TEST IN ORDER TO CONSTRUCT (OR RECONSTRUCT) A SEWAGE DISPOSAL SYSTEM.

PROPERTY OWNER Lambert Cissel

ADDRESS 3425 Hipsley Mill Road, Woodbine, MD 21797 PHONE (410) 442-5671

PROSPECTIVE BUYER Developer, Land Marketing Consultants, Inc., Timothy W. Feaga

ADDRESS 3243 Bethany Lane, Ellicott City, MD 21042 PHONE (410) 313-8808

PROPERTY LOCATION:

SUBDIVISION Cissel Property LOT NO 9

ROAD AND DESCRIPTION Intersection of Hardy & St. Michael's Road

TAX MAP 7 PARCEL # 394, 4, 341, 144

SIZE OF LOT 1 Acre TYPE BLDG _____
(SINGLE FAMILY DWELLING OR COMMERCIAL)

THE SYSTEM INSTALLED UNDER THIS APPLICATION IS ACCEPTABLE ONLY UNTIL PUBLIC FACILITIES BECOME AVAILABLE. I FULLY UNDERSTAND THE

FEE CONNECTED WITH THE FILING OF THIS PERC TEST APPLICATION IS NON-REFUNDABLE UNDER ANY CIRCUMSTANCES. I ALSO AGREE TO COMPLY

WITH ALL M.O.S.H.A. REQUIREMENTS IN TESTING THIS LOT. Willis Lambert Cissel JR
(SIGNATURE OF APPLICANT)

APPROVED BY _____ FOR _____ DATE _____

REJECTED BY _____ FOR _____ DATE _____

HOLD PENDING FURTHER TESTS _____ DATE _____

REASONS FOR REJECTION OR HOLDING _____

THIS IS NOT A PERMIT

COUNTY #

SOIL PROFILE

478

tan
SiClmorange
red
SiLmpink
SiSaLm
micaceous
10%
shale
saprolite

479


tan
orange
SiClm
orange
brn
SiClmmottled
pink
SiLm
micaceous
25%
shale
water

606

dark
red brn
SiClmdark
brown
SiLm
10%
shale20%
shale
lgt white
tan
SiSaLm
refusal

SOIL PROFILE

728

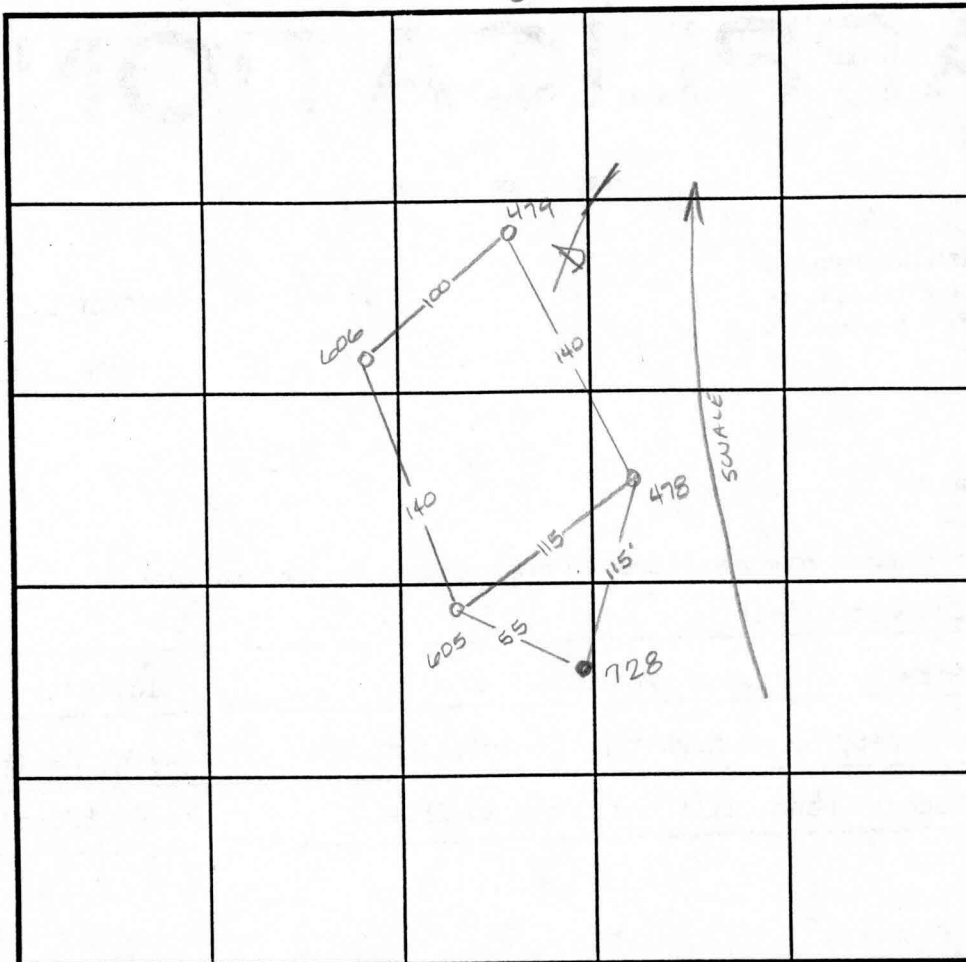orange
brn
SiClmpink
SiLm
25%very
decayed
shale

INDICATE NORTH - NAME ADJOINING ROADWAY AS BASE LINE.

Hardy Road

DATE	TEST NO.	DEPTH	PRE-WET		TEST - 1" DROP		TIME
			START	STOP	START	STOP	
8-20-96	605	Insufficient depth to bedrock					—
		refusal at 8.0 & >50% R _v					F
	478	3.0 / 12.0	12:55	12:56	12:56	12:57	1min ✓
	479	Insufficient depth to water					
		table - see profile					F
	606	3.5 / 11.0	1:04 ³⁰	1:06 ³⁰	1:06 ³⁰	1:11	4 1/2 min ✓
3-10-97	728	Visual to 12.0 - see profile					OK ✓

REMARKS

TYPE OF SOIL

TESTED BY

Amy McMullen

ALSO PRESENT

Tim Feaga

TRENCH DESIGN DATA: AVERAGE PERCOLATION TIME

TRENCH WIDTH

INLET DEPTH

MAXIMUM BOTTOM DEPTH

SQ. FT./BEDROOM


P. 98.26


APPROVED
HOWARD
COUNTY

HARDY


(LOCAL ROAD)

P. 22

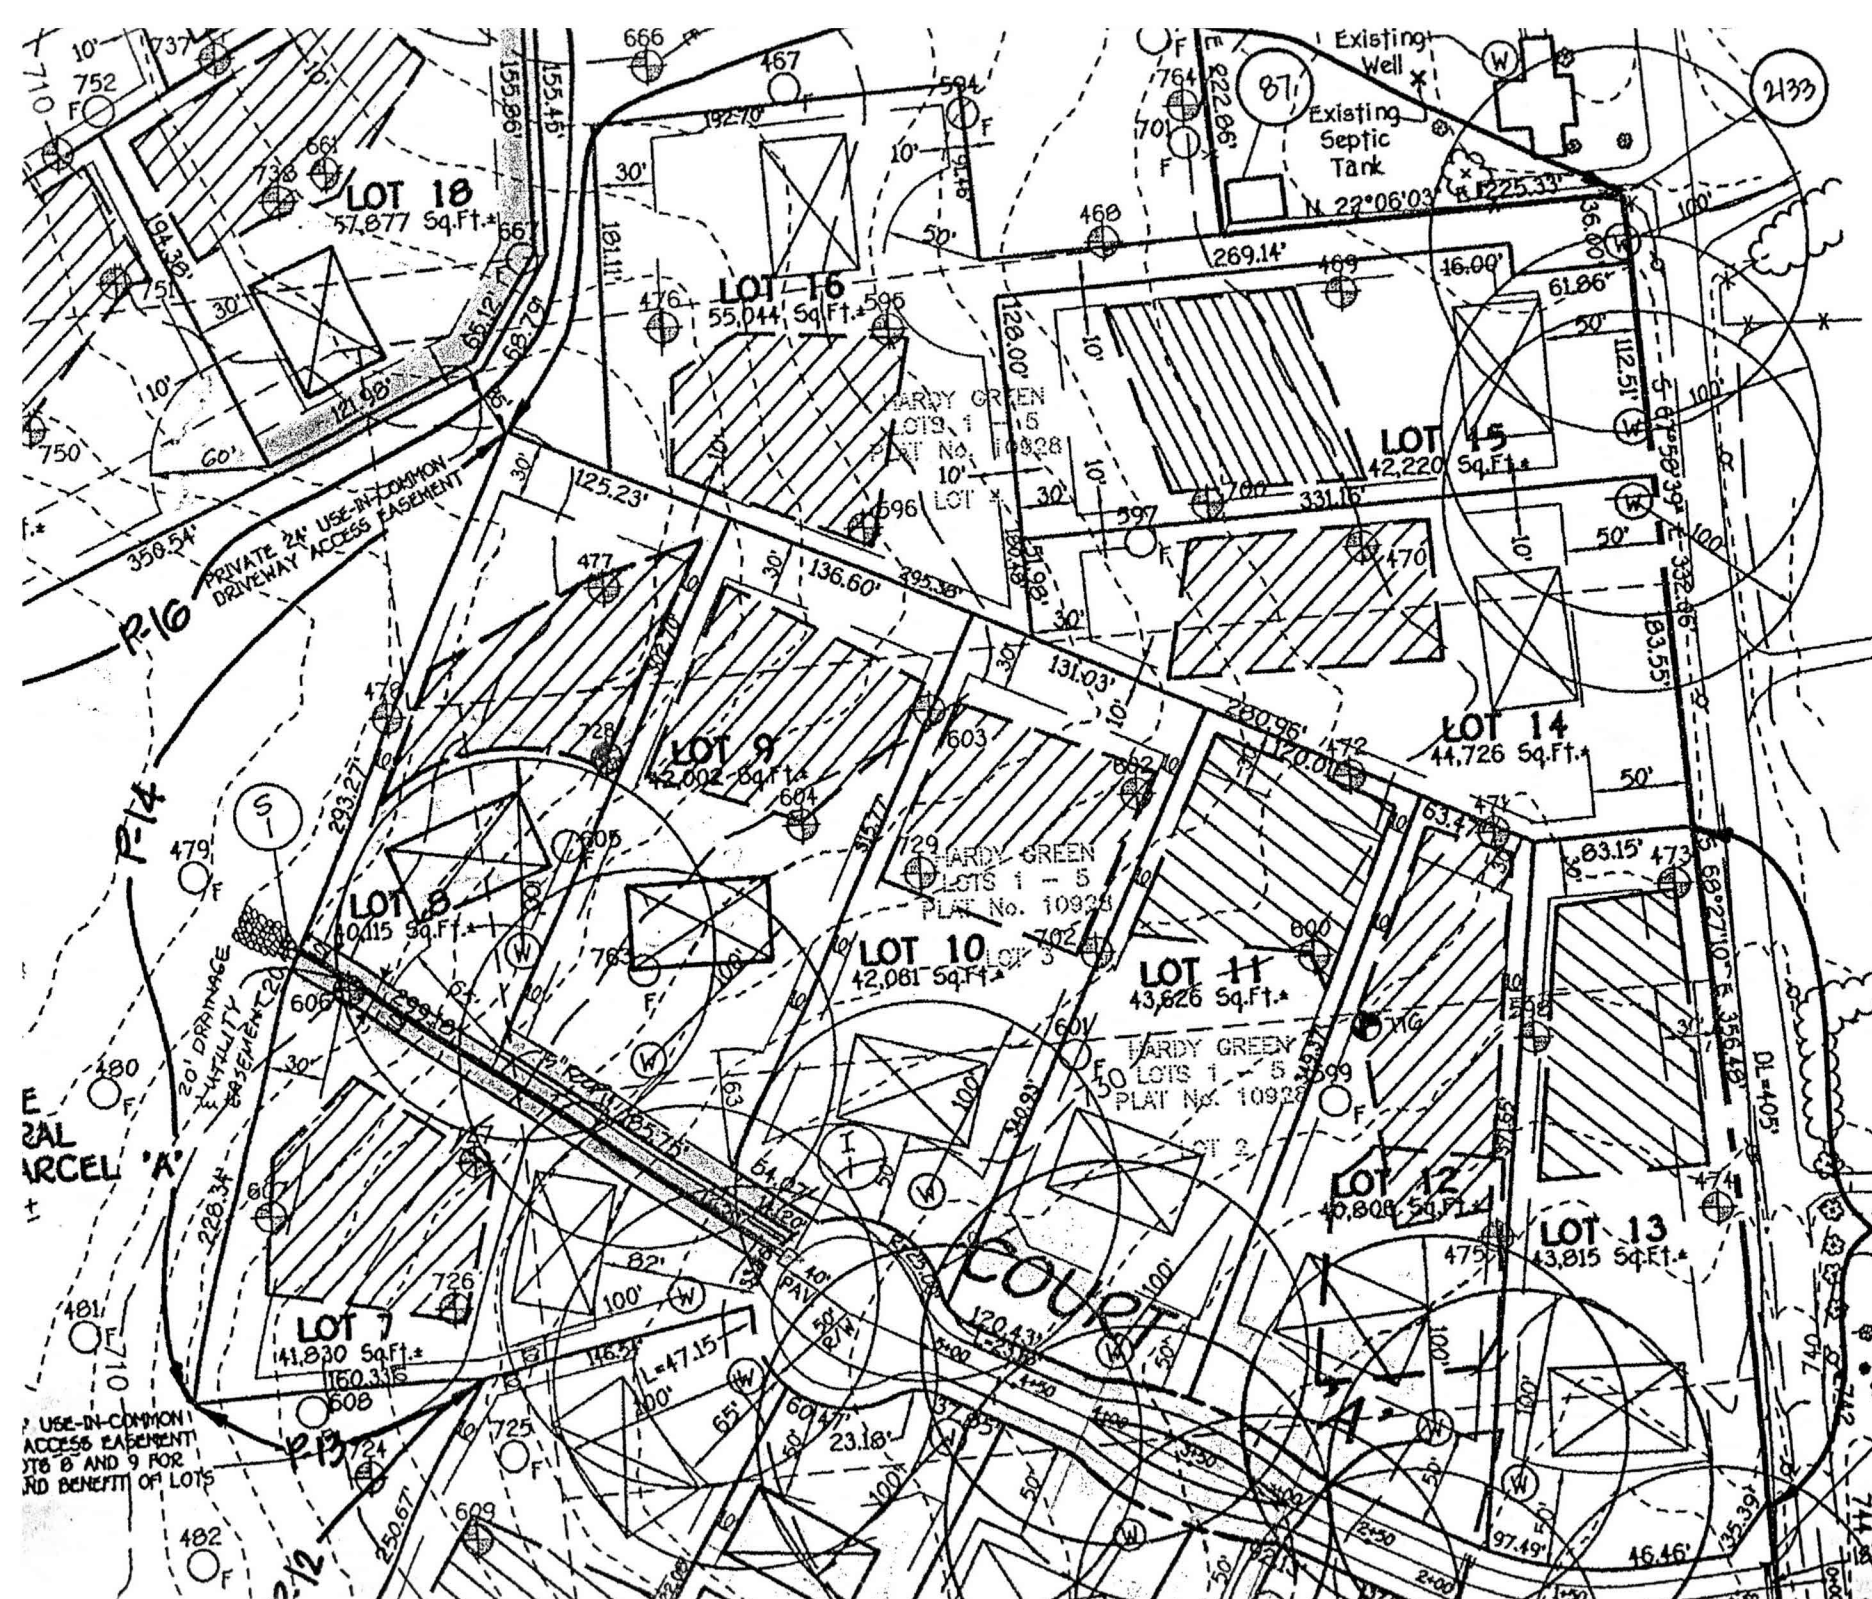

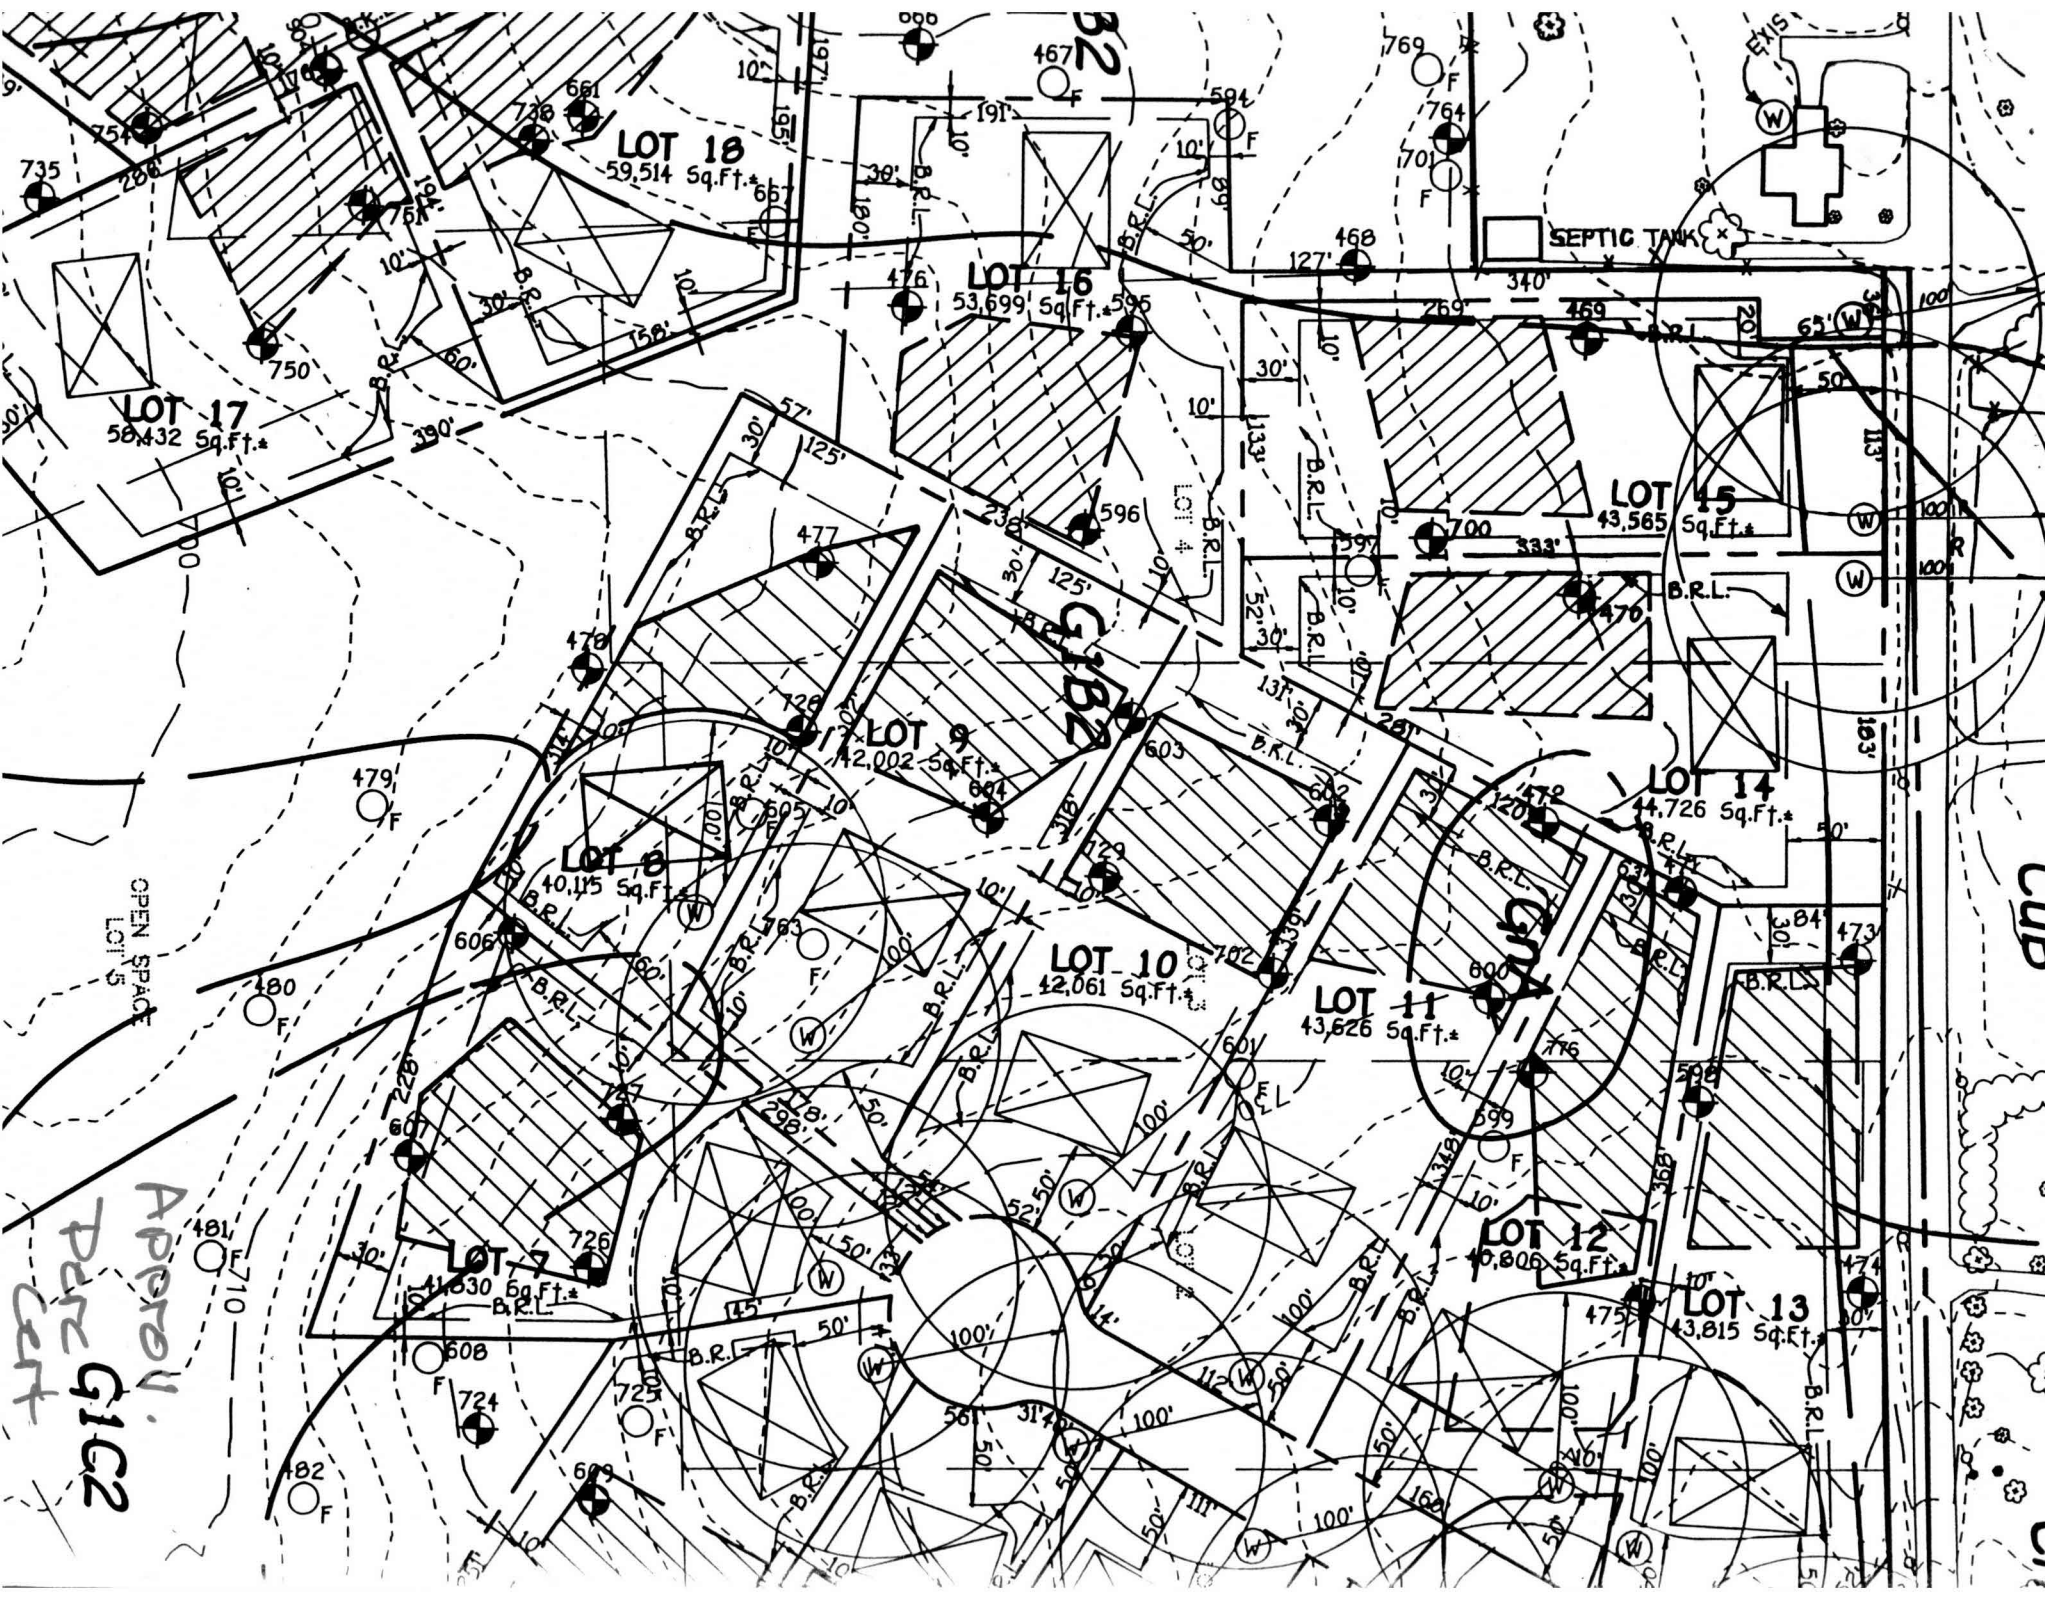

Approved.
Per GIC2
cat

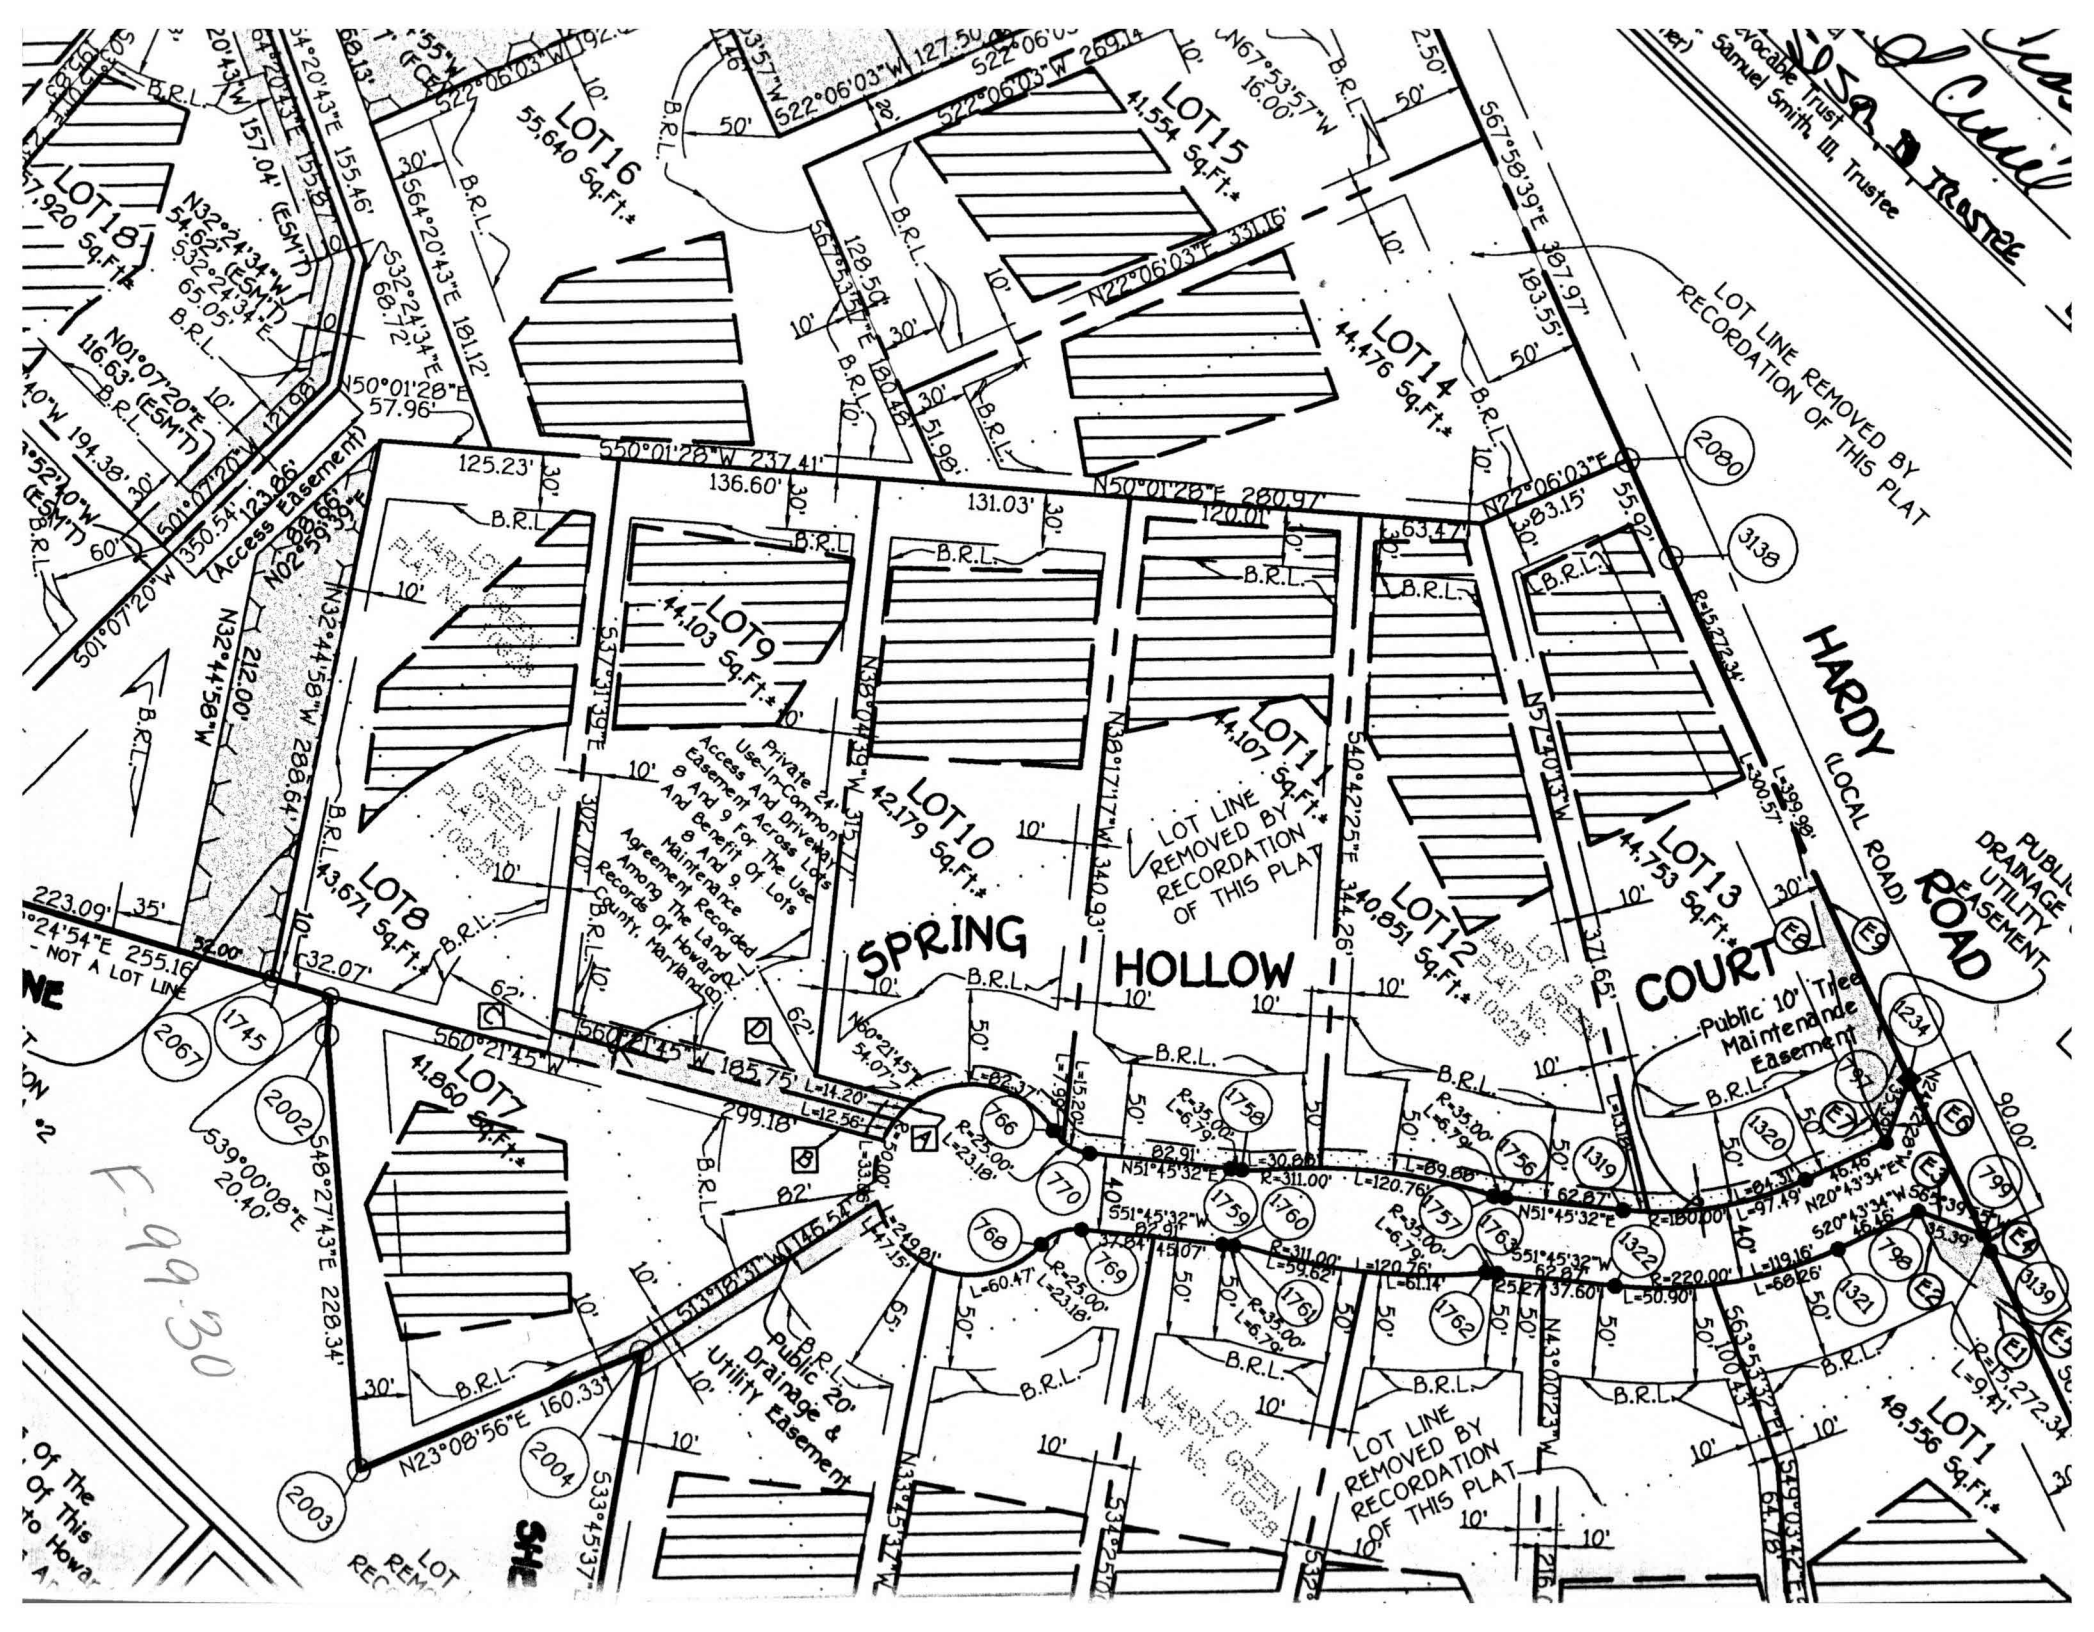

Available Trust
Samuel Smith, III, Trustee

LOT LINE REMOVED BY
RECORDATION OF THIS PLAT

HARDY
(LOCAL ROAD)

PUBLIC
DRAINAGE
UTILITY
EASEMENT

COURT

HOLLOW

SPRING

99-30

of The
of This
to How