APPLICATION

		PI	ERCOLATION TEST	IING	Α	
					P	
	HEALTH DEPARTI				DISTRICT	
3525-H ELLICOTT TELEPHONE: 410		ICOTT CITY, MARYLAND 210	043		DATE	
: THE COUNTY HEA ELLICOTT CITY, MA						
I HEREBY APPLY F	OR THE NECESSAR	RY TEST PRIOR TO APPLICA	TION FOR PERMIT TO	CONSTRUCT (OR RECONST	RUCT) A SEWAGE DISPOSAL S'	YSTEM.
OPERTY OWNER	Clifford and	d Betty Harrison				
ADDRESS	3155 Rout	te 32, West Friendshij	p, MD 21794	PHONE	410-442-2196	
GENT OR PROSPECT	TIVE BUYER	Heritage Land	Development			
ADDRESS		shington Rd., Suite 22	O, Glenwood, MI	21738 PHONE _	410-489-7900	
ROPERTY LOCATION						
NOT ENTITION					v G	\
				LOT NO.	X)
UBDIVISION	1-20-1-				X)
	TION O	Off of Route 32, South	of Rosemary Lan		¥ (<u>)</u>	
	TION O	Off of Route 32, South	of Rosemary Lan		¥ ©)
OAD AND DESCRIPT	22	PARCEL #	of Rosemary Lan		¥ ())
OAD AND DESCRIPT			* *		SFD SFD	COMMERCIAL
OAD AND DESCRIPT AX MAP NO.	22 1 Acre	PARCEL#	17	TYPE OF BLDG.	(SINGLE FAMILY DWELLING OR	
OAD AND DESCRIPT AX MAP NO. IZE OF LOT THE SYSTEM INSTALL	22 1 Acre LED UNDER THIS A	PARCEL #PARCEL #	17 LE ONLY UNTIL PUBLI	TYPE OF BLDG.	(SINGLE FAMILY DWELLING OR	THE
AX MAP NO. SIZE OF LOT THE SYSTEM INSTAL	22 1 Acre LED UNDER THIS A	PARCEL #PARCEL #	17 LE ONLY UNTIL PUBLI	TYPE OF BLDG.	(SINGLE FAMILY DWELLING OR	THE
OAD AND DESCRIPT AX MAP NO. LIZE OF LOT THE SYSTEM INSTALE FEE CONNECTED WIT	22 1 Acre LED UNDER THIS A	PARCEL #PARCEL #	17 LE ONLY UNTIL PUBLI	TYPE OF BLDG.	(SINGLE FAMILY DWELLING OR	THE
AX MAP NO. SIZE OF LOT THE SYSTEM INSTAL	22 1 Acre LED UNDER THIS A	PARCEL # PARCEL # APPLICATION IS ACCEPTABLE THIS PERC TEST APPLICATION	17 LE ONLY UNTIL PUBLI	TYPE OF BLDG.	(SINGLE FAMILY DWELLING OR	THE
AX MAP NO. IZE OF LOT HE SYSTEM INSTALI EE CONNECTED WITH ALL M.O.S.H.A.	22 1 Acre LED UNDER THIS A	PARCEL # PARCEL # APPLICATION IS ACCEPTABLE THIS PERC TEST APPLICATION	17 LE ONLY UNTIL PUBLI	TYPE OF BLDG.	(SINGLE FAMILY DWELLING OR	THE
OAD AND DESCRIPT AX MAP NO. IZE OF LOT THE SYSTEM INSTALI THE CONNECTED WITH ALL M.O.S.H.A. APPROVED BY	22 1 Acre LED UNDER THIS A	PARCEL # PARCEL # APPLICATION IS ACCEPTABLE THIS PERC TEST APPLICATION	17 LE ONLY UNTIL PUBLI	TYPE OF BLDG.	(SINGLE FAMILY DWELLING OR LABLE. I FULLY UNDERSTAND ANCES. I ALSO AGREE TO COM TE OF AMPLICANT)	THE
OAD AND DESCRIPT AX MAP NO. LIZE OF LOT THE SYSTEM INSTALL EEE CONNECTED WITH WITH ALL M.O.S.H.A. APPROVED BY DISAPPROVED BY	22 1 Acre LED UNDER THIS A TH THE FILING OF T	PARCEL # PARCEL # APPLICATION IS ACCEPTABLE THIS PERC TEST APPLICATION	17 LE ONLY UNTIL PUBLI ON IS NON-REFUNDA	TYPE OF BLDG.	(SINGLE FAMILY DWELLING OR LABLE. I FULLY UNDERSTAND ANCES. I ALSO AGREE TO COM RE OF AMPLICANT) DATE	THE
OAD AND DESCRIPT AX MAP NO. LIZE OF LOT THE SYSTEM INSTALE FEE CONNECTED WIT	22 1 Acre LED UNDER THIS A TH THE FILING OF T REQUIREMENTS I	PARCEL #PARCEL #	17 LE ONLY UNTIL PUBLI ON IS NON-REFUNDA	TYPE OF BLDG.	(SINGLE FAMILY DWELLING OR LABLE. I FULLY UNDERSTAND ANCES. I ALSO AGREE TO COM RE OF AMPLICANT) DATE	THE

THIS IS NOT A PERMIT

SITE DEVELOPMENT PLAN/FINAL PLAT - TITLE OR I.D. #

TO:

FILE						0'	SOIL PROFILE
						oreija (1932) Anto A	
							erstaller erstaller erstaller
		100	× 100 %	problem at an	5 mm	Sorting Str	energy per
	AND THE RESERVE OF THE PARTY OF						
		INDICATE	NORTH - NAME ADJO	INING ROADWAY AS I	BASE LINE.		Lonen J
	DATE	INDICATE TEST NO.	NORTH - NAME ADJOI		BASE LINE. E-WET	TEST - :	1" DROP STOP
	DATE 6-22-01		DEPTH	PRE	-WET	START	
		TEST NO.	DEPTH	START	S-WET STOP	START	STOP
		TEST NO.	DEPTH 2.0/ S	START	STOP	START	STOP
		TEST NO. (125)	DEPTH 2.0/5 2.5/5	START	STOP	START	STOP
		TEST NO. (125)	DEPTH 2.0/5 2.5/5	START	STOP	START	STOP
	6-22-01	TEST NO. (125)	DEPTH 2.0/5 2.5/5	START	STOP	START	STOP
	6-22-01	TEST NO. (125)	DEPTH 2.0/5 2.5/5	START	STOP	START	STOP
	6-22-01	TEST NO. (125)	DEPTH 2.0/5 2.5/5	START	STOP	START 11', 23 2 12', 202	STOP
	6-22-01	TEST NO. (125)	DEPTH 2.0/5 2.5/5	PRE START 11:203 12:193	STOP	START 11', 23 2 12', 202	STOP

APPLICATION

PERCOLATION TESTING

A 514944

P

DISTRICT

DATE 22301

HOWARD COUNTY HEALTH DEPARTMENT BUREAU OF ENVIRONMENTAL HEALTH


3525-H ELLICOTT MILLS DRIVE/ELLICOTT CITY, MARYLAND 21043

TELEPHONE: 410-313-2640

TO: THE COUNTY HEALTH OFFICER ELLICOTT CITY, MARYLAND

I HEREBY APPLY FO	OR THE NECESSARY 1	EST PRIOR TO APPLICA	ATION FOR PERMIT TO CO	NSTRUCT (OR RECONSTRU	ICT) A SEWAGE DISPOSAL SYSTEM.
PROPERTY OWNER	Clifford and E	Betty Harrison			
ADDRESS	3155 Route	32, West Friendsh	ip, MD 21794	PHONE	410-442-2196
AGENT OR PROSPECT	IVE BUYER	Heritage Land	Development		
ADDRESS	3060 Washii	ngton Rd., Suite 22	20, Glenwood, MD 2	1738 PHONE	410-489-7900
PROPERTY LOCATION					
SUBDIVISION	Harrisa	n Property	-	LOT NO	X
ROAD AND DESCRIPT	ION Off o	of Route 32, South	of Rosemary Lane 3	3/4 of a mile	
			14.		
TAX MAP NO.	22	PARCEL #	17		
SIZE OF LOT 3	3 Acres			TYPE OF BLDG.	SFD
FEE CONNECTED WITH		PERC TEST APPLICATION			BLE. I FULLY UNDERSTAND THE CES. I ALSO AGREE TO COMPLY
THE MICOLINA	KEQOINEINENTO IN TE	511114 THIS 2511		(SIGNATURE O	FAPPLICANT)
APPROVED BY			FOR		DATE
DISAPPROVED BY			FOR		DATE
OLD PENDING FURT	HER TESTS				
REASONS FOR REJEC	TION OR HOLDING				
PERCOLATION TEST P	PLAT/PRELIMINARY P	LAT - TITLE OR I.D. #	*		DATE
SITE DEVELOPMENT F	PLAN/FINAL PLAT - TI	TLE OR I.D. #			DATE

THIS IS NOT A PERMIT

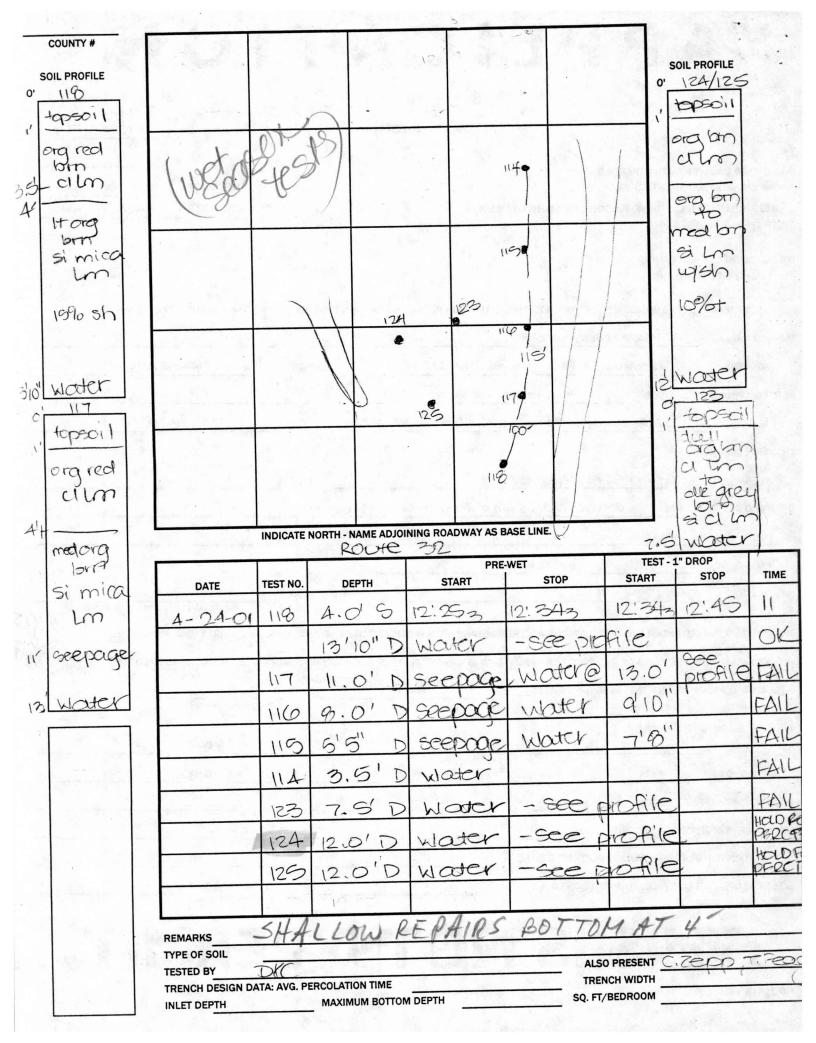

COUNTY # SOIL PROFILE SOIL PROFILE topsoil red bin alm 3 Simica 159/of Sapr Sh INDICATE NORTH - NAME ADJOINING ROADWAY AS BASE LINE. PRE-WET TEST - 1" DROP DATE TEST NO. DEPTH START STOP START STOP TIME 6-22-011121 A 2.05 10:06 10:11 10:11 1121 B 2.0'5 10'.07 10:073 10:072 10:09 1344 2.0'5 10:072 10:183 10:182 10:30 12 136 3,05 10:113 10:16 10:16 10:23 -see LOUBIN profile REMARKS __ TYPE OF SOIL ___ TESTED BY __ DKC ALSO PRESENT C. Zepp T. Feaga TRENCH DESIGN DATA: AVERAGE PERCOLATION TIME ______ TRENCH WIDTH _____ INLET DEPTH MAXIMUM BOTTOM DEPTH SQ FT/BEDROOM

APPLICATION

PERCOLATION TESTING HOWARD COUNTY HEALTH DEPARTMENT **BUREAU OF ENVIRONMENTAL HEALTH** DISTRICT 3525-H ELLICOTT MILLS DRIVE/ELLICOTT CITY, MARYLAND 21043 DATE TELEPHONE: 410-313-2640 TO: THE COUNTY HEALTH OFFICER ELLICOTT CITY, MARYLAND I HEREBY APPLY FOR THE NECESSARY TEST PRIOR TO APPLICATION FOR PERMIT TO CONSTRUCT (OR RECONSTRUCT) A SEWAGE DISPOSAL SYSTEM. Clifford and Betty Harrison ADDRESS 3155 Route 32, West Friendship, MD 21794 PHONE 410-442-2196 AGENT OR PROSPECTIVE BUYER Heritage Land Development ADDRESS 3060 Washington Rd., Suite 220, Glenwood, MD 21738 PHONE 410-489-7900 PROPERTY LOCATION: SUBDIVISION Harrison Properti Off of Route 32, South of Rosemary Lane 3/4 of a mile TAX MAP NO. SIZE OF LOT 20 Acres THE SYSTEM INSTALLED UNDER THIS APPLICATION IS ACCEPTABLE ONLY UNTIL PUBLIC FACILITIES BECOME AVAILABLE. I FULLY UNDERSTAND THE FEE CONNECTED WITH THE FILING OF THIS PERC TEST APPLICATION IS NON-REFUNDABLE UNDER ANY CIRCUMSTANCES. I ALSO AGREE TO COMPLY WITH ALL M.O.S.H.A. REQUIREMENTS IN TESTING THIS LOT. APPROVED BY DISAPPROVED BY HOLD PENDING FURTHER TESTS


THIS IS NOT A PERMIT

REASONS FOR REJECTION OR HOLDING


PERCOLATION TEST PLAT/PRELIMINARY PLAT - TITLE OR I.D. #

SITE DEVELOPMENT PLAN/FINAL PLAT - TITLE OR I.D. #

						G - 070/m 1/2		
Υ#								
OFILE						Activity and a second second	SOIL PROFILE	
3			102	35	31-1	0'		
110	100 101		102	35	• 104			
oil	€-3d	-115-	10 5	-00	• • • • • • • • • • • • • • • • • • • •			
org				ises				
33							1.5	10 TE
401	190					A STANISH	Lavores - Cal	
1 1	196			1210	•112	100		
1 10								
nog							Land of the	178
nica							10 m	YS.
2				122 0	•113			
a de che la	Service Department			. 185	PRES. 77 (1) 18			
						100	Marie Pr	an Post
						Section 1		Sil.
ter								J
40	10.700				a de la			
					SALL II.	THE SAME		all the same
	1 10							
		INDICATE	NORTH - NAME ADJOI	NING ROADWAY AS E	BASE LINE.		All DROP	1
				PRE	BASE LINEWET STOP	TEST START	- 1" DROP	" TIM
	DATE	TEST NO.	DEPTH	PRE START	-WET			etre
	DATE 4-2A-01	TEST NO.		PRE	-WET			FA
		TEST NO.	DEPTH 5.0' D	START W. CUTCV	-WET			FA
		TEST NO.	DEPTH 5.0' D 7.5' D	START Woder Woder	-WET			FA
		TEST NO.	DEPTH 5.0' D	start Woter Water	STOP	START	STOP	FA
		TEST NO. 113 112 104	DEPTH 5.0' D 7.5' D 6.5' D	start Woter Water	STOP	START	STOP	FA
		TEST NO.	DEPTH 5.0' D 7.5' D	START Woder Woder	STOP		STOP	FA
		TEST NO. 113 112 104	DEPTH 5.0' D 7.5' D 6.5' D	start Woter Water	STOP	START	STOP	FA
		TEST NO. 113 112 104	DEPTH 5.0' D 7.5' D 6.5' D	start Woter Water	STOP	START	STOP	FA
	A-2A-01	TEST NO. 113 112 104	DEPTH 5.0' D 7.5' D 6.5' D	start Woter Water	STOP	START	STOP	FA
		TEST NO. 113 112 104	DEPTH 5.0' D 7.5' D 6.5' D	start Woter Water	STOP	STOFILE	STOP	FA FA
	REMARKS TYPE OF SOIL TESTED BY	TEST NO. 113 112 104 103	DEPTH 5.0' D 7.5' D 6.5' D	start Woter Water	STOP	START	STOP	TIM FA FA FA FA

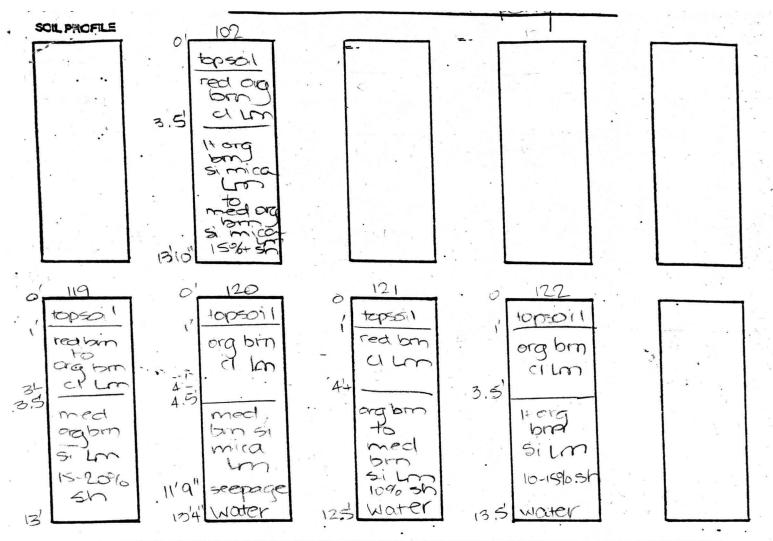

DATE	TEST NO.	DEPTH	PRE- START	WET STOP	TEST - 1	STOP	TIME
4-24-01	102	4.0' 5	12', 34	12:3603	12/36=	12:40	4
		13'10"D	Water	-see	profile		OK
	101	10.0	WOJO	Clay	10:5'-m	iothess	FAIL
	100	3.00	Refusa				FAIL
	119.	13.00	visual	-see.	profile		OK
	120	11'9" D	sæpaa	Water	13'4"	sco. profile	FAIL
	121	12.6' D	Water	- see	Diofile		HOLD FOR PE
=	122	13.5'D	Madel	-see	profile		OK
				/			
	-		1				
,							
					3. 1		

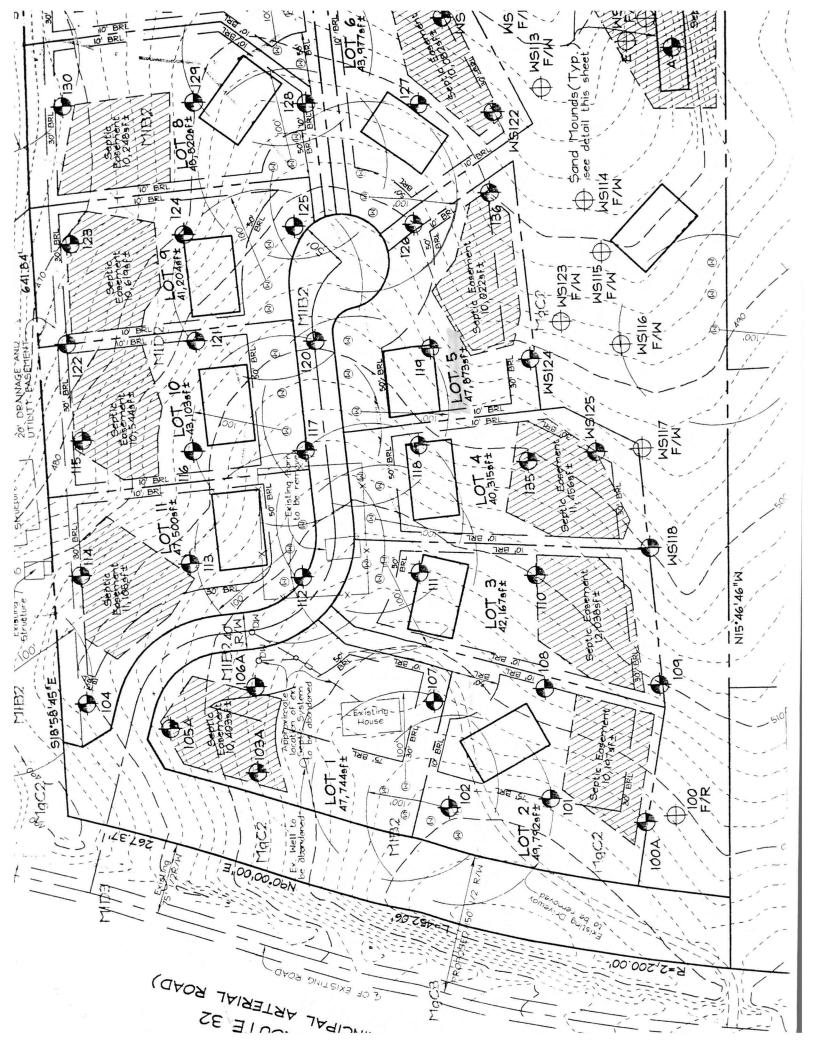

105' BRL 33 103.741/ 3. 330.57 SWM Access drive /Prop. 24" HDPE PON. ACCESS PLACE) 8+08.75 Bollards (typ.) 493.75 Private 24' Use-in Easment fot Lots 7 \$ 8 ccess SWM Access Edsement

42,145sf± 4-4 ON DE 100 501 LOT 5 41,1239f± BRL 10' BRL Septic Septic Easement 269.16 30' BRL Noway 136 WS/12 F/W 263.04 WS122 WS124/ Atoploth WS113 F/W 57,73 BRL WSI23 F/W

