


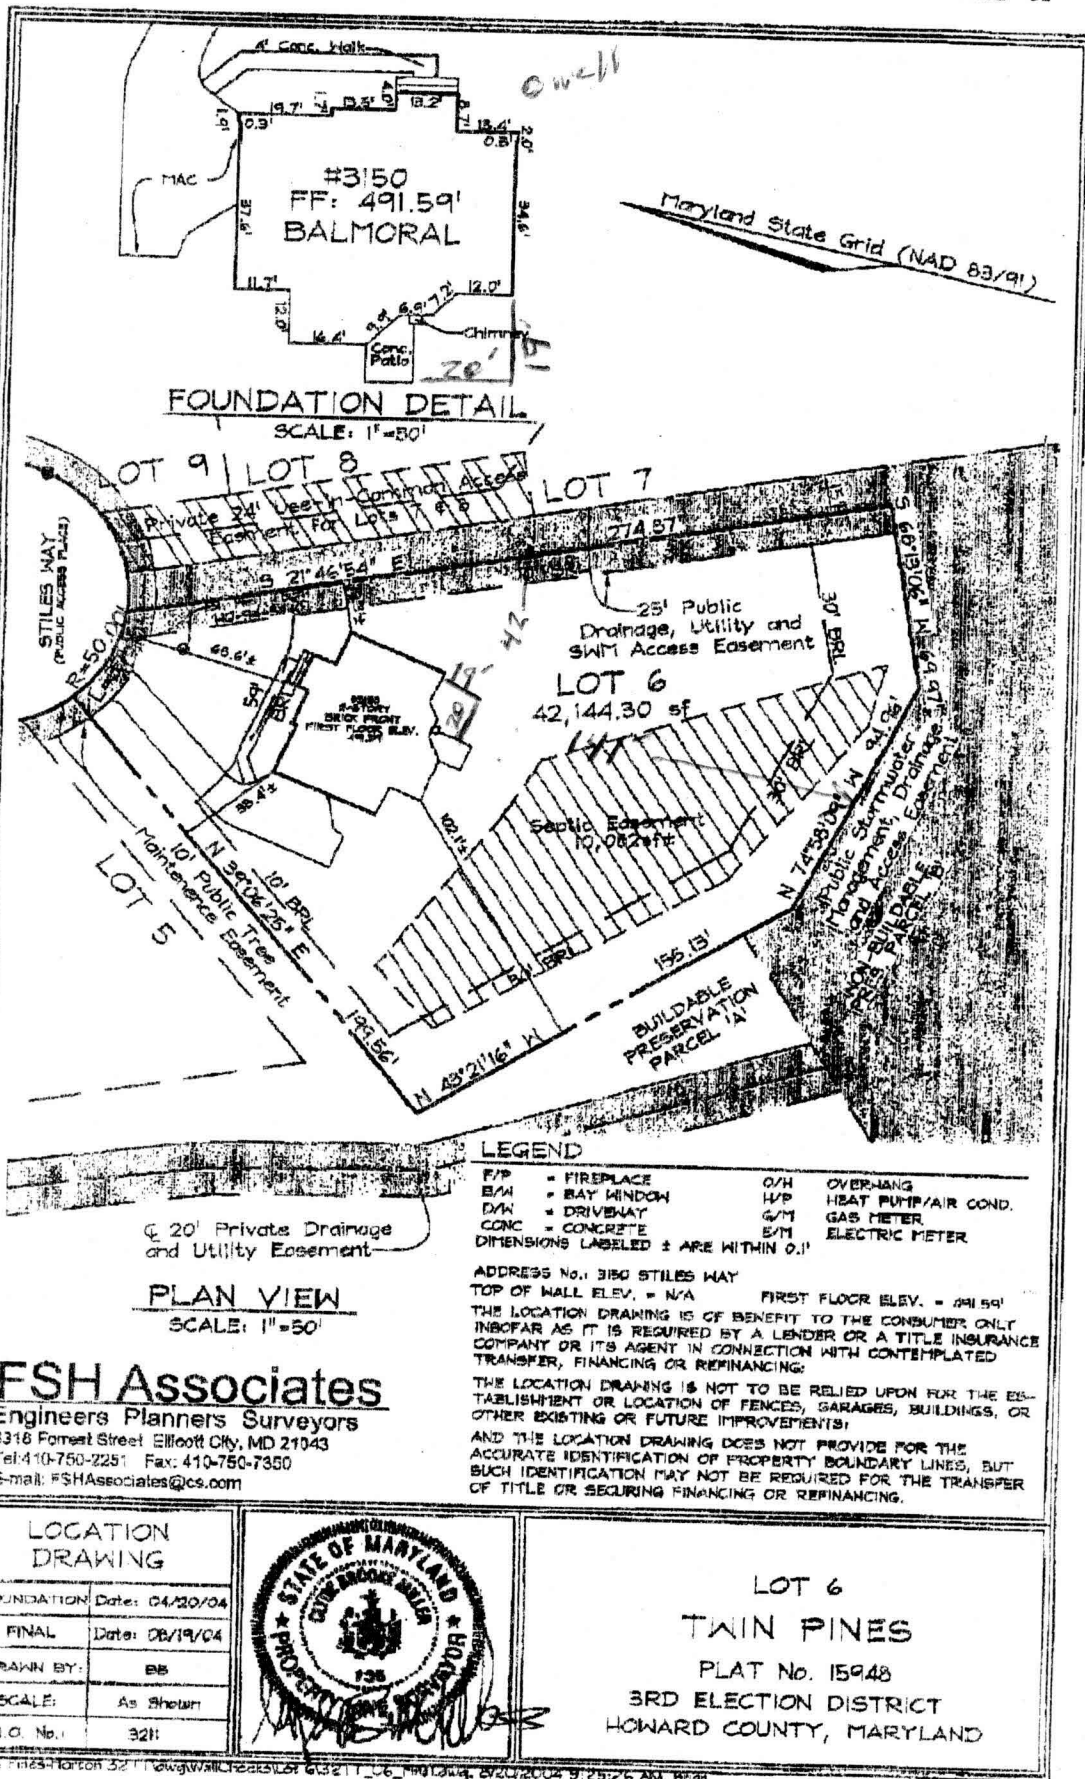

APPROVED

WALK-THRU BUILDING PERMIT

BP# 600153279 A# 515249-J

APP. SAN CFD DATE: 4/21/05

DESC. OF WORK: Deck

OWNER/ DEVELOPER


D.R. Horton
1370 Piccard Drive, Suite 230
Rockville, Maryland 20850
Tel: (301)-670-6144

Approved Septic System Plan
Howard County Health Department

Kacie Norman
Signature

1/15/09
Date

Maryland State Grid (NAD 83/91)

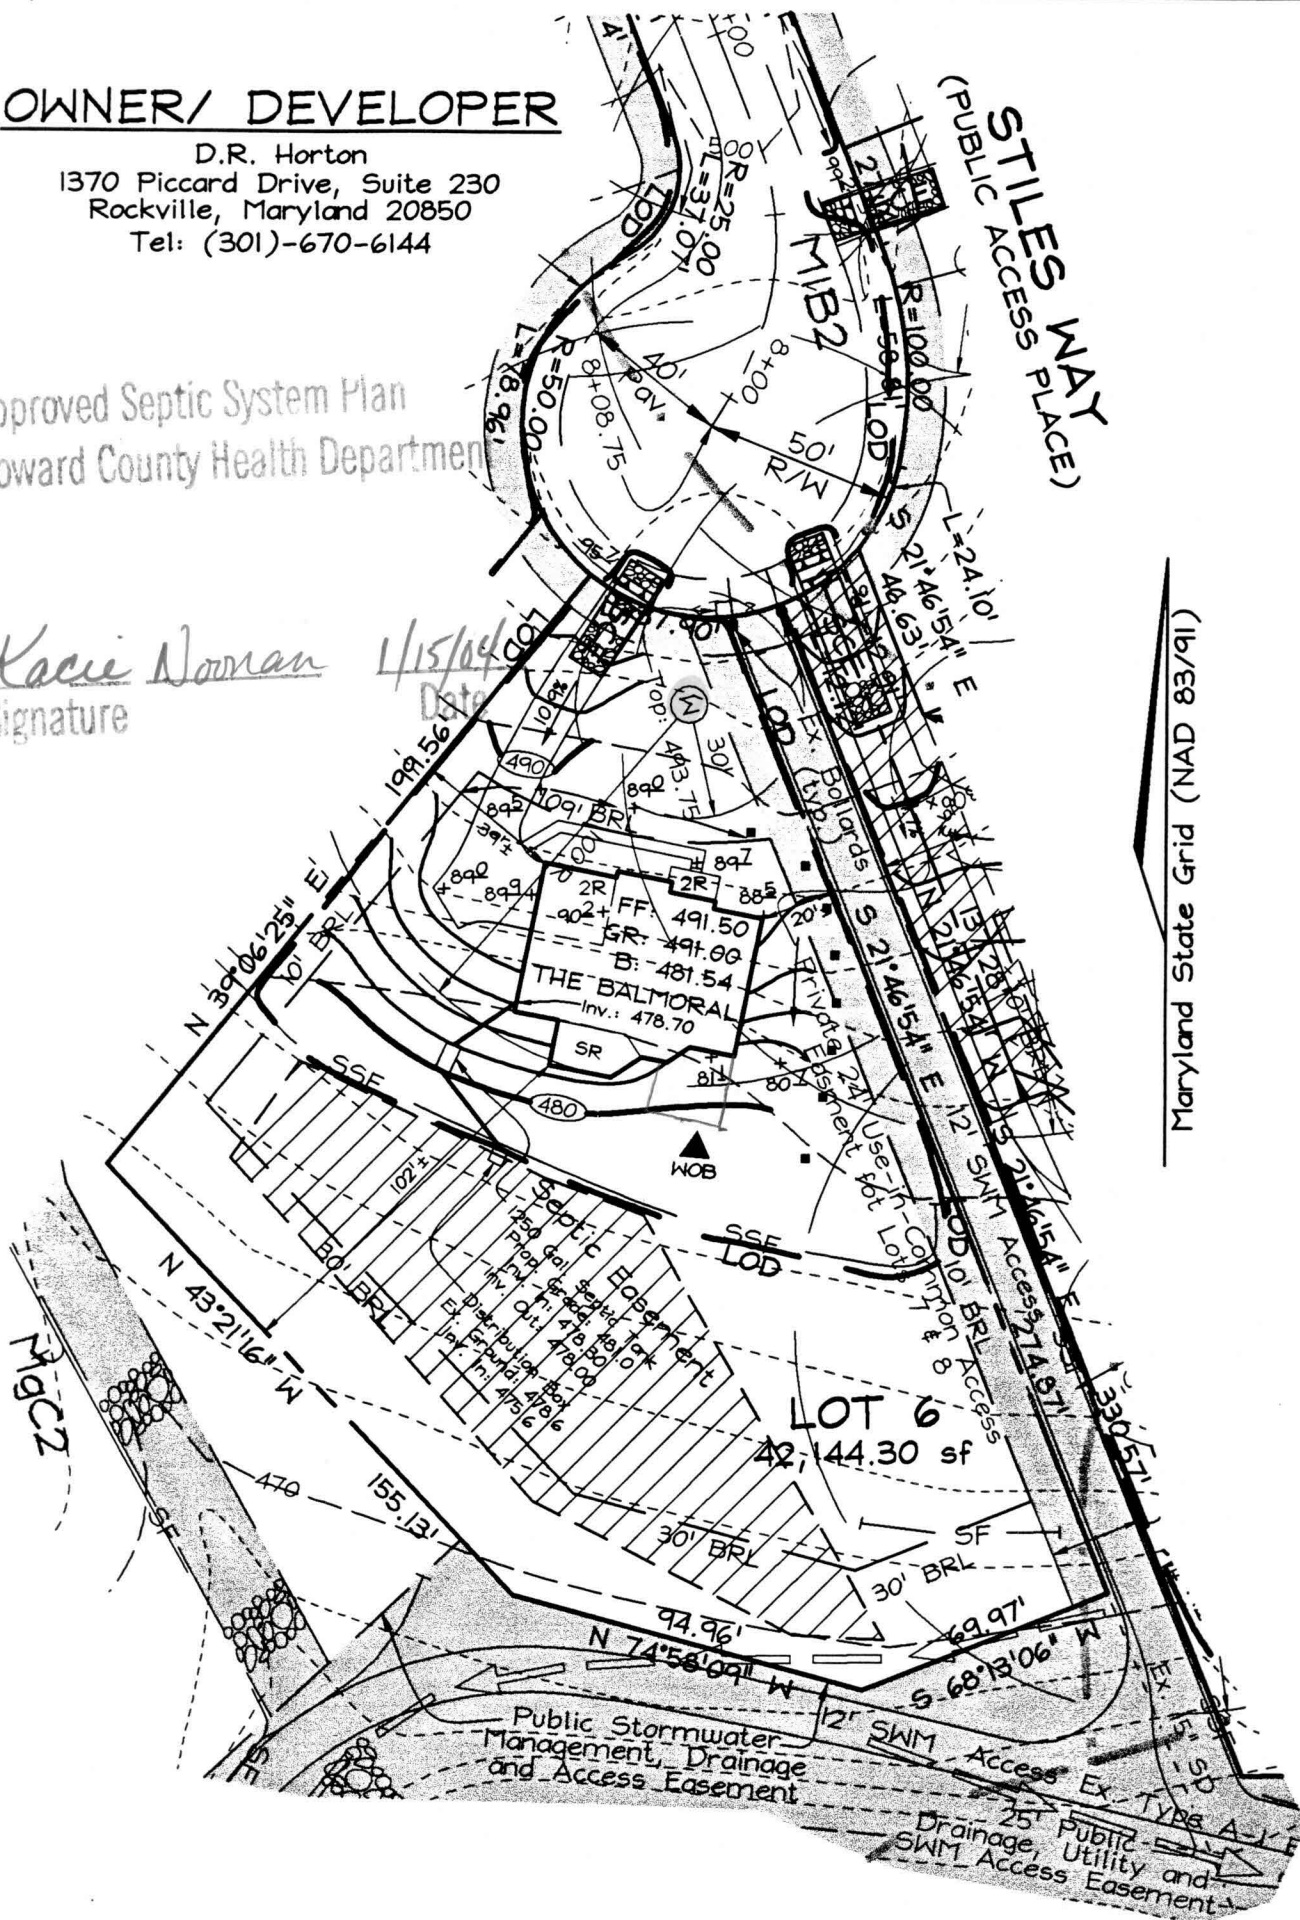

FSH Associates

Engineers Planners Surveyors
8318 Forrest Street Ellicott City, MD 21043
Tel: 410-750-2251 Fax: 410-750-7350
E-mail: FSHAssociates@cs.com

Note: 1. See Approved Grading Plan GP-04-47 for Entire Site.
2. The existing well shown on this plan (identified with the attached well tag number: HO-94-3640) has been field located by C. B. Miller professional surveyor and is accurately shown.

DESIGN BY: PS
DRAWN BY: Slim
CHECKED BY: ZYF
SCALE: 1"=50'
DATE: Jan. 14, 2004
W.O. No.: 3211
SHEET No.: 1 OF 1

LOT RESITE
LOT 6
TWIN PINES

TAX MAP 22, GRID 8
3RD ELECTION DISTRICT

PARCEL 17
HOWARD COUNTY, MARYLAND